


O.D.O.T. DISTRICT 2 SURVEY OFFICE (USE ONLY)


PERSONNEL _____ REFERENCE NO. 38 SHEET 17 OF 21
 NOTES RHOADES DATE 3/29/17 ROUTE US 20
 H.C. O'DONNELL WEATHER CLEAR COUNTY FULTON
 R.C. HELDMAN TEMP. 52° TOWNSHIP ROYALTON
 SECTION 21
 T 9 S R 3 E

TYPE MONUMENT _____ MAG/WASHER _____
 ON SURFACE - ~~BELOW~~ _____ ON _____
 LEFT - ☉ PAV'T - ~~RIGHT~~ _____ 1' _____
 _____ TO _____ EDGE PAVEMENT
 S.L.M. 991+78.85

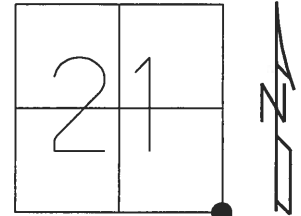

GRID: NORTHING: 733892.933 EASTING: 1543587.172


RECORD:
 SET P.K. NAIL
 8/6/87
 FD P.K. NAIL
 5/9/08, DCH
 RESET MAG/WASHER
 8/3/09, DCH
 FD MAG/WASHER
 REF38
 9-22-15, JFO
 SET MAG/WASHER
 6-25-18, JLL

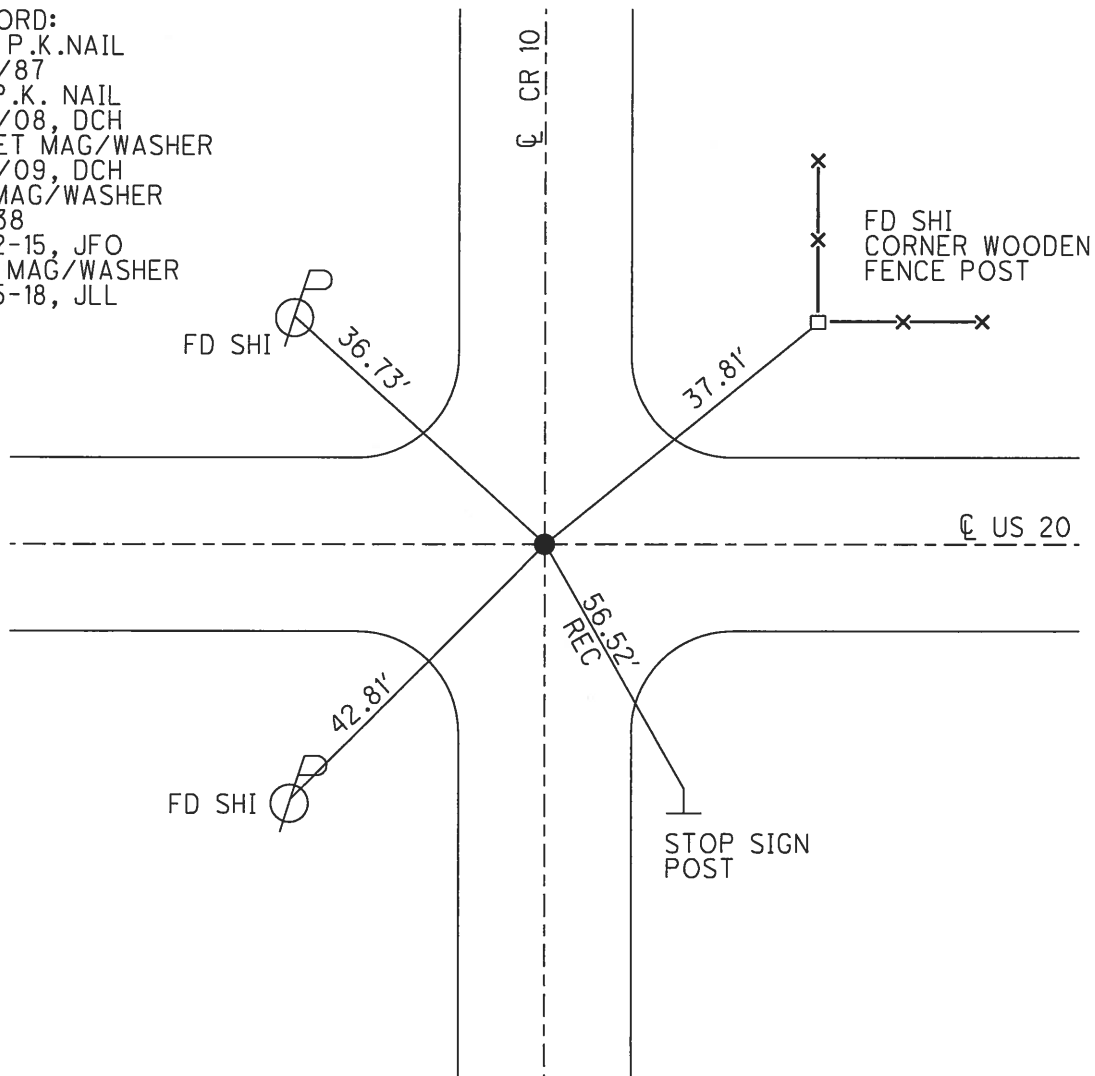

O.D.O.T. DISTRICT 2 SURVEY OFFICE (USE ONLY)

PERSONNEL _____ REFERENCE NO. 38 SHEET 13 OF 17
 NOTES ROUSOS DATE 6/2/09 ROUTE US 20
 H.C. HOMAN WEATHER CLOUDY COUNTY FULTON
 R.C. ROUSOS TEMP. 57° TOWNSHIP ROYALTON
 _____ SECTION 21
 _____ T 9 S R 2 E

TYPE MONUMENT P.K.NAIL
 ON SURFACE - ~~BELOW~~ ON _____
 LEFT - ☉ PAV'T - RIGHT ON _____
 _____ TO _____ EDGE PAVEMENT
 S.L.M. 991+78.85

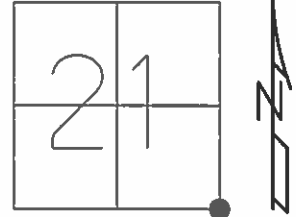


GRID: NORTHING: 733892.914 EASTING: 1543587.103

SET P.K.NAIL
 TO SURFACE
 8/6/87

FD P.K. NAIL
 5/9/08 DCH

RESET MAG/WASHER
 8/3/09 DCH

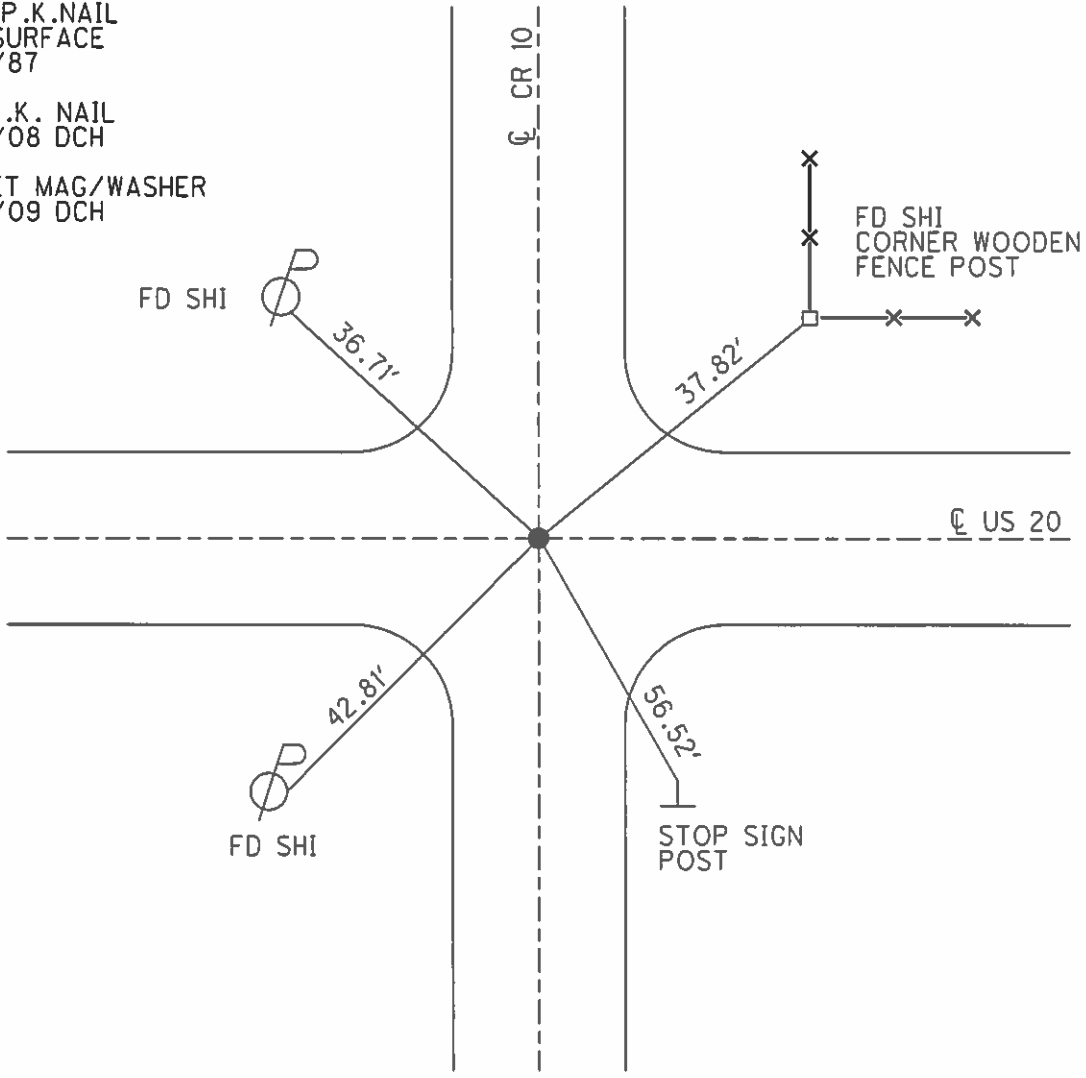

O.D.O.T. DISTRICT 2 SURVEY OFFICE

PERSONNEL

REFERENCE NO. 38

SHEET 9 OF 12

NOTES J. Householder

H.C. D. Curtis

R.C. R. Michalak

DATE March 21, 1986

WEATHER P. Cloudy

TEMP. 25°

ROUTE U.S. 20

COUNTY Fulton

TOWNSHIP Royalton

SECTION 21

T ___ R ___


TYPE MONUMENT P.K. Nail

ON SURFACE - BELOW Surface


LEFT - & PAW'T. - RIGHT

TO EDGE PAVEMENT

S.L.M. 997 + 62

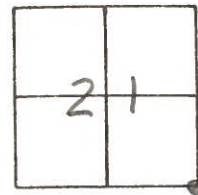

SET P.K. NAIL TO SURFACE
8-6-87

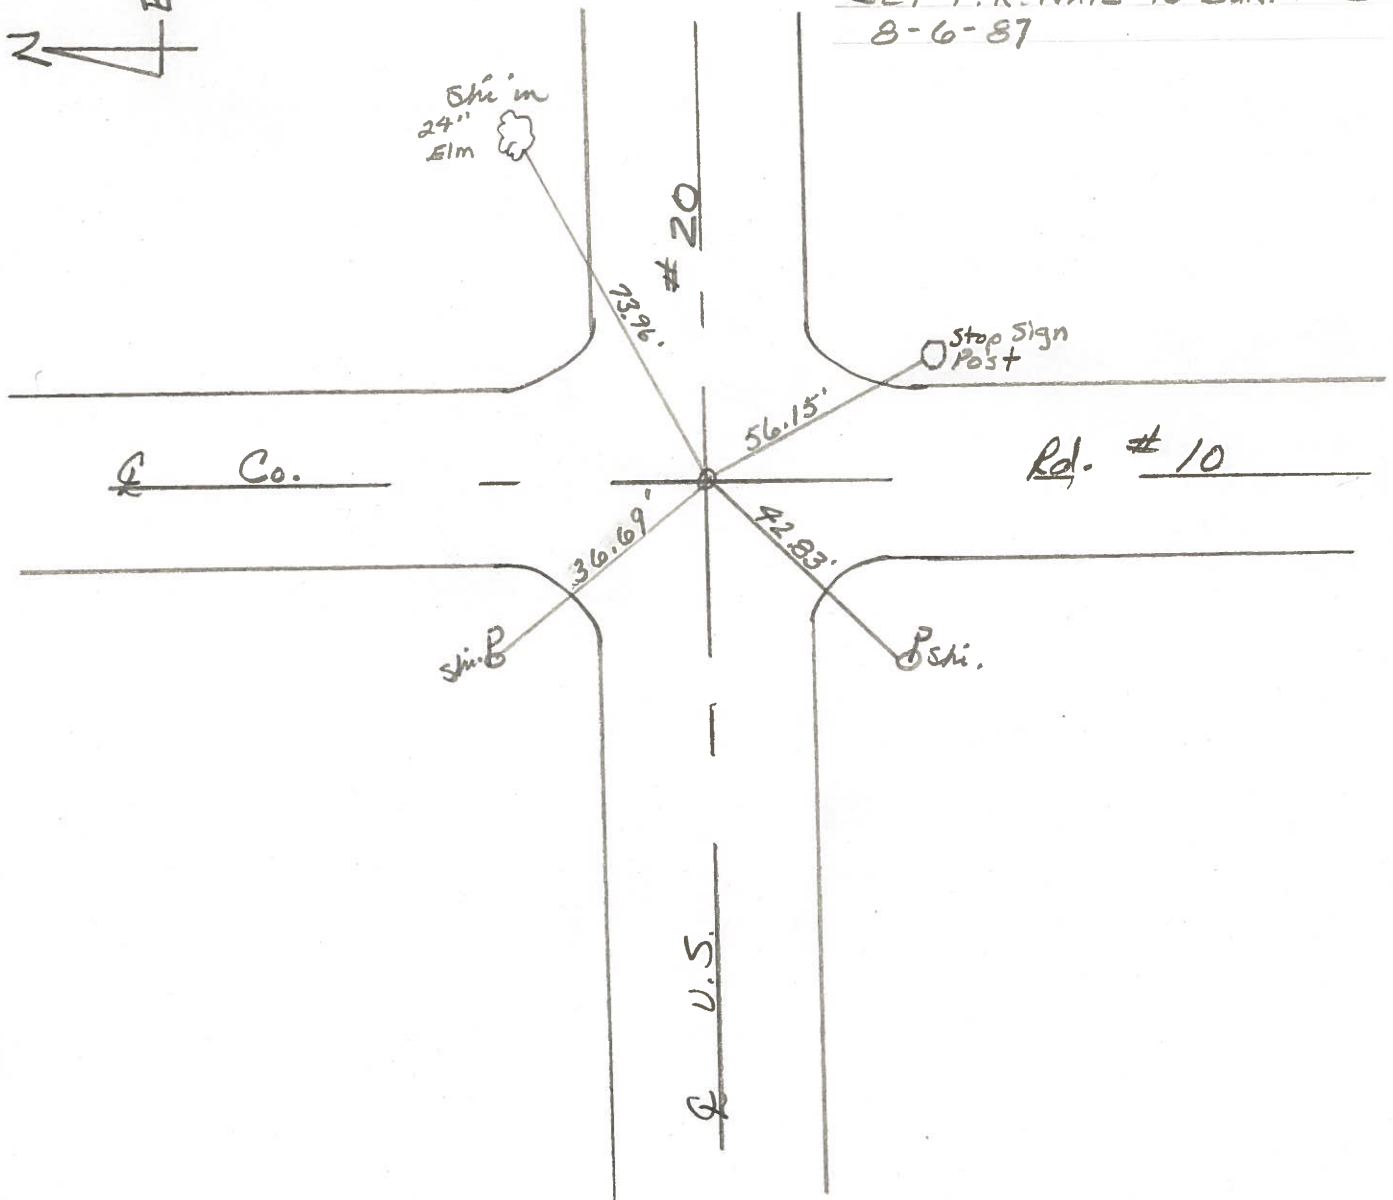

O.D.O.T. DISTRICT 2 SURVEY OFFICE

SHEET 11 OF 13

County FULTON ~~S.R.~~ U.S. 20

Date 3-12-80

Township ROYALTON

Weather CLOUDY


Section 21

Temp. +30°

~~T9N5~~ R3E

Personnel BOWERS

MEAD

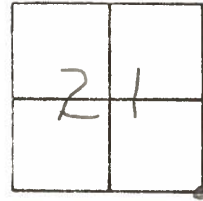


#38

OK 9/19/83
CLOUDY +75°
S.W.H.


SHI. IN SW/SIDE
24" ELM



P.K. NAIL
RE-SET P.K.
8-25-80
SMITH

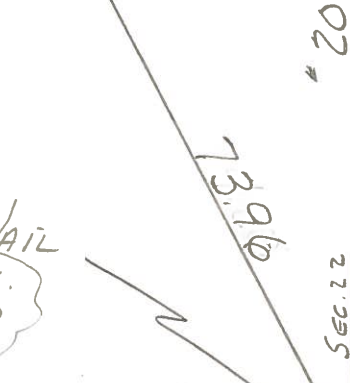


SEC. 22
SEC. 27

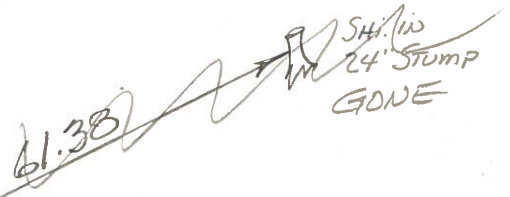


SEC. 22
SEC. 21

SEC. 27
SEC. 28

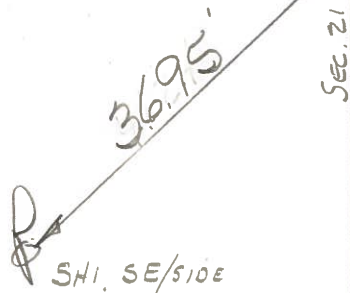

SEC. 21
SEC. 28

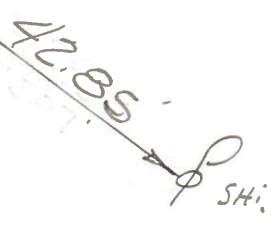

U.S.

PERSONNEL	TITLE	PERSONNEL	TITLE	COUNTY	Fulton	DATE	JUNE 18, 19
Tomsic		Boyle		S. R.	U. S. 20	WEATHER	
Neuser				SEC.	Royalton TWP	TEMP.	
Granata							
Vandy							

DESCRIPTION LEFT CENTER LINE RIGHT JOB NO.

