

O.D.O.T. DISTRICT 2 SURVEY OFFICE (USE ONLY)


PERSONNEL _____ REFERENCE NO. 39 A SHEET 19 OF 21

NOTES RHOADES DATE 3/29/17 ROUTE US 20
 H.C. O'DONNELL WEATHER CLEAR COUNTY FULTON
 R.C. HELDMAN TEMP. 52° TOWNSHIP ROYALTON
 SECTION 22
 T 9 S R 3 E


TYPE MONUMENT _____ MAG/WASHER _____
 ON SURFACE - ~~BELOW~~ _____ ON _____
~~LEFT~~ - ☉ PAV'T - ~~RIGHT~~ _____ ON _____
 _____ TO _____ EDGE PAVEMENT

S.L.M. 1031+65.61

GRID: NORTHING: 733890.802 EASTING: 1547573.930

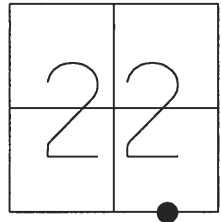


RECORD:
 SET P.K.NAIL
 8/6/87
 DNF P.K. NAIL
 5/12/08, DCH
 RESET MAG/WASHER
 8/3/09, DCH
 FD MAG/WASHER
 REFA39
 9-24-15, JFO
 SET MAG/WASHER
 6-25-18, JLL

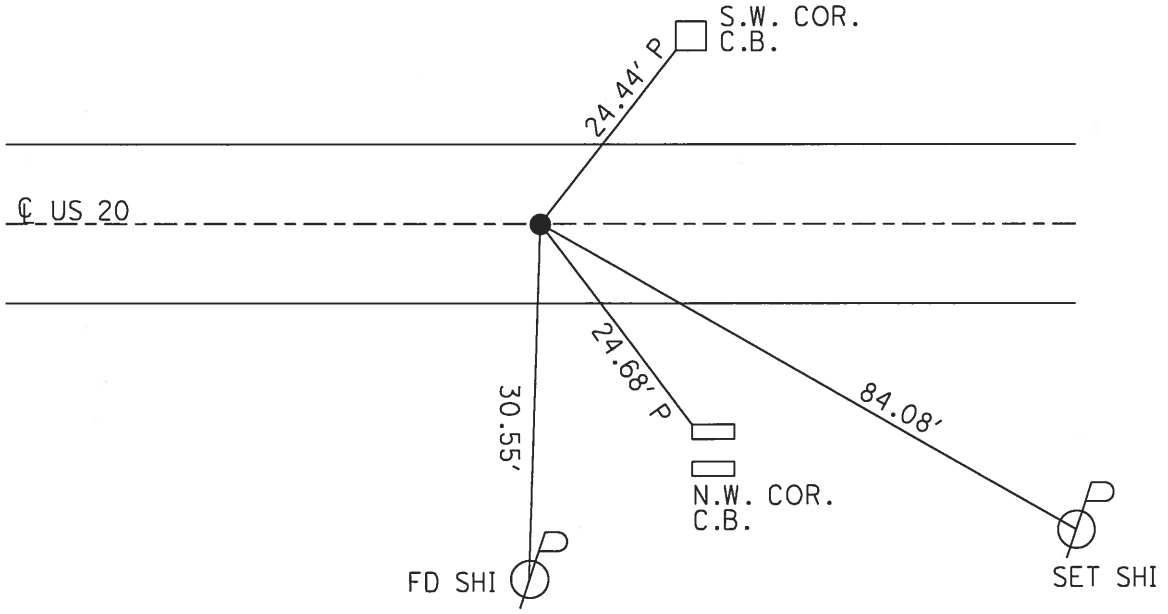

O.D.O.T. DISTRICT 2 SURVEY OFFICE (USE ONLY)

PERSONNEL _____ REFERENCE NO. 39 A SHEET 15 OF 17
 NOTES ROUSOS DATE 6/5/09 ROUTE US 20
 H.C. HOMAN WEATHER CLOUDY COUNTY FULTON
 R.C. ROUSOS TEMP. 57° TOWNSHIP ROYALTON
 _____ SECTION 22
 _____ T9S R2E


TYPE MONUMENT P.K. / WASHER
 ON SURFACE - ~~BELOW~~ ON _____
 LEFT - ☉ PAV'T - RIGHT ON _____
 _____ TO _____ EDGE PAVEMENT
 S.L.M. 1031+65.56
 GRID: NORTHING: 733890.796 EASTING: 1547573.864

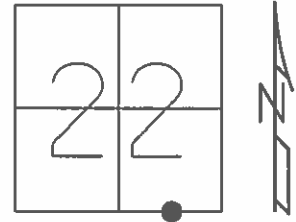

SET P.K. NAIL
 TO SURFACE
 8/6/87

 DNF P.K. NAIL
 5/12/08 DCH

 RESET MAG/WASHER
 8/3/09 DCH

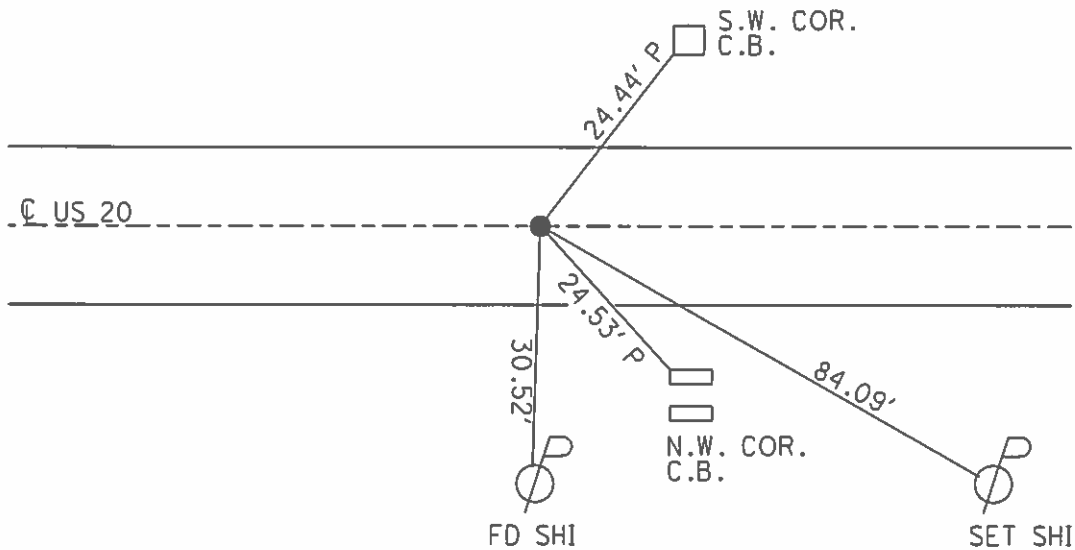

O.D.O.T. DISTRICT 2 SURVEY OFFICE

PERSONNEL

REFERENCE NO. 39-A

SHEET 11 OF 12

NOTES J. Haushalter

H.C. D. Curtis

R.C. R. Michalak

DATE March 21, 1986

WEATHER P. Cloudy

TEMP. 25°

ROUTE U.S. 20

COUNTY Fulton

TOWNSHIP Royalton

SECTION 22

T ___ R ___


TYPE MONUMENT P.K. Nail

ON SURFACE - BELOW Surface

LEFT - & PAV'T. - RIGHT

TO ___ EDGE PAVEMENT

S.L.M. 1037 + 48

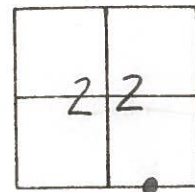

SET P.K. NAIL TO SURFACE
8-6-87



County FULTON ~~S.R.~~ U.S. 20

Date 3-12-80

Township ROYALTON


Weather CLOUDY

Section 22

Temp. +30°


T9N, R3E

Personnel BOWERS

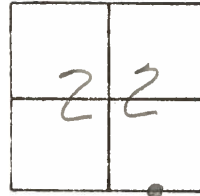

39-A

S 1/4 S.E. 1/4
SEC. 22

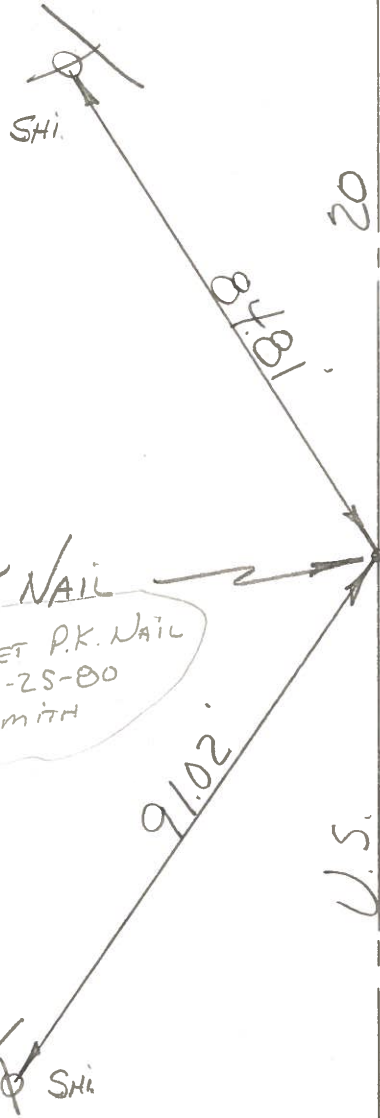

P.K. NAIL
RE-SET P.K. NAIL
8-25-80
SMITH

GONE
DUPLEX W. SIDE
SIGN POST

PERSONNEL	TITLE	PERSONNEL	TITLE	COUNTY	Fulton	DATE	JUNE 18, 1973
Tomsic		Boyle		S. R.	U.S. 20	WEATHER	
Neuser				SEC.	Royalton TWP	TEMP.	
Granata							
Vandy							

DESCRIPTION	LEFT	CENTER LINE	RIGHT	JOB NO.
-------------	------	-------------	-------	---------

