


O.D.O.T. DISTRICT 2 SURVEY OFFICE (USE ONLY)

PERSONNEL _____ REFERENCE NO. 42 A SHEET 3 OF 28
 NOTES RHOADES DATE 4/11/17 ROUTE US 20
 H.C. O'DONNELL WEATHER CLOUDY COUNTY FULTON
 R.C. HELDMAN TEMP. 56° TOWNSHIP ROYALTON
 _____ SECTION 23
 _____ T 9 S R 3 E

TYPE MONUMENT _____ P.K. SHANK _____
 ON SURFACE - ~~BELOW~~ _____ ON _____
 LEFT - ☉ PAV'T - ~~RIGHT~~ _____ 1.7' _____
 _____ TO _____ EDGE PAVEMENT
 S.L.M. 1044+93.04

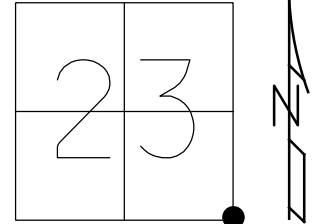

GRID: NORTHING: 733893.279 EASTING: 1554206.288

42 TO 42A = 2.67'

