
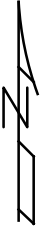



O.D.O.T. DISTRICT 2 SURVEY OFFICE (USE ONLY)

PERSONNEL \_\_\_\_\_ REFERENCE NO. 46A SHEET 12 OF 28  
 NOTES RHOADES DATE 4/11/17 ROUTE US 20  
 H.C. O'DONNELL WEATHER CLOUDY COUNTY FULTON  
 R.C. HELDMAN TEMP. 56° TOWNSHIP AMBOY  
 \_\_\_\_\_ SECTION 20  
 \_\_\_\_\_ T 9 S R 4 E

TYPE MONUMENT \_\_\_\_\_ P.K./WASHER \_\_\_\_\_  
 ON SURFACE - ~~BELOW~~ \_\_\_\_\_ ON \_\_\_\_\_  
~~LEFT~~ - ☉ PAV'T - ~~RIGHT~~ \_\_\_\_\_ ON \_\_\_\_\_  
 \_\_\_\_\_ TO \_\_\_\_\_ EDGE PAVEMENT  
 S.L.M. 1236+84.35  
 GRID: NORTHING: 733718.067 EASTING: 1568080.688

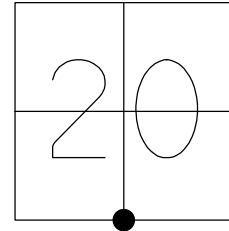

RECORD:  
 S 1/4 CORNER SEC 23  
 SET P.K./WASHER  
 6-21-01, BVD  
 FD P.K./WASHER  
 REFA46  
 10-14-15, JFO  
 SET MAG/WASHER  
 6-26-18, JFO

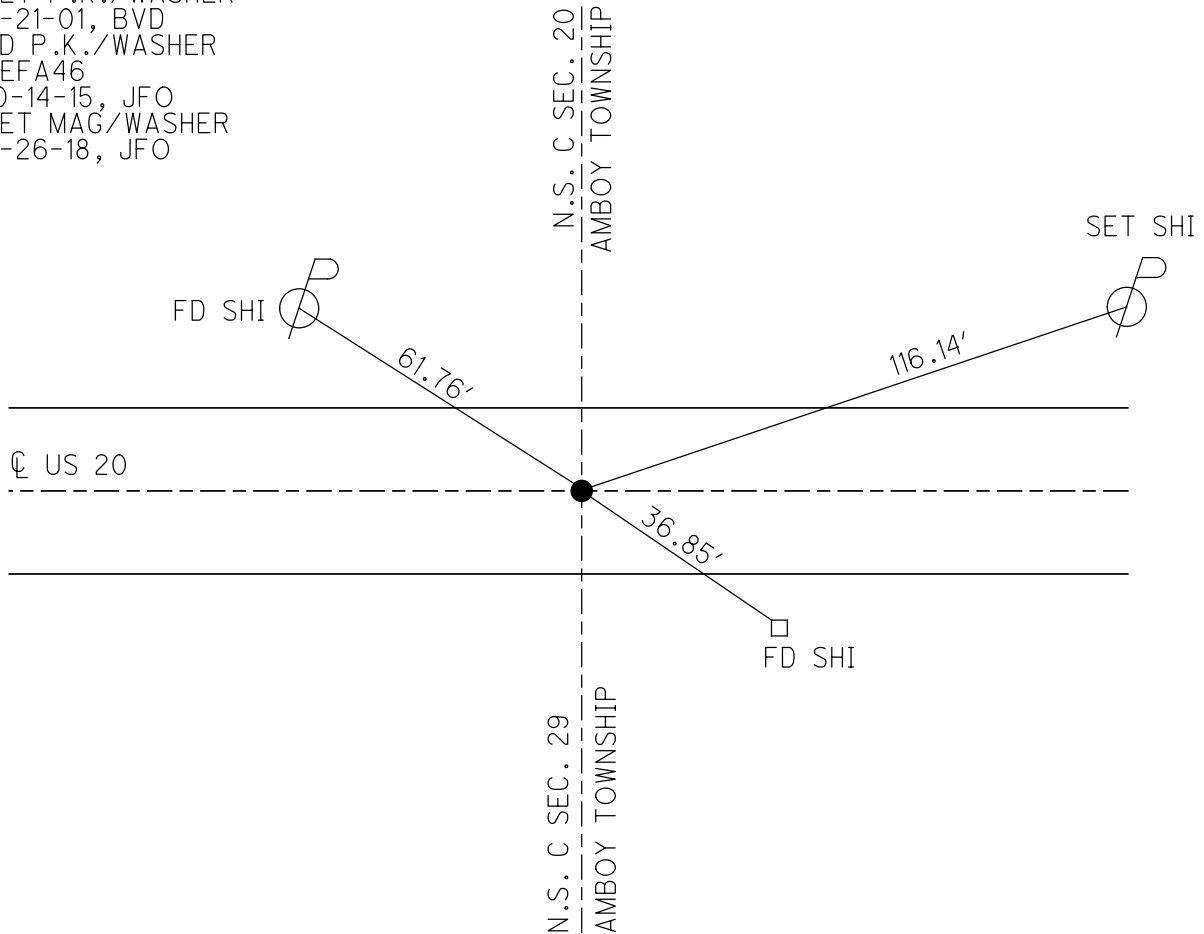

O.D.O.T. DISTRICT 2 SURVEY OFFICE

PERSONNEL

REFERENCE NO. 46 A

SHEET 11 OF 27

NOTES HUSS

DATE 7/24/00

ROUTE US 20

H.C. ROUSOS

WEATHER PT.CLOUDY,FAIR

COUNTY FULTON

R.C. CORDES

TEMP. 74°

TOWNSHIP AMBOY

VAN DUSEN

SECTION 20

T 9 S R 4 E


TYPE MONUMENT R.R.SPIKE

~~ON SURFACE~~ - BELOW 2"


LEFT - C PAV'T - RIGHT ON  
11.4' TO RT EDGE PAVEMENT

S.L.M. 1244+11

Grid: Northing: \_\_\_\_\_ Easting: \_\_\_\_\_

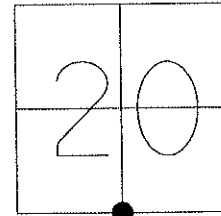

RECORD:  
S  $\frac{1}{4}$  CORNER SEC 23  
SET P.K./WASHER  
6/21/01, BVD

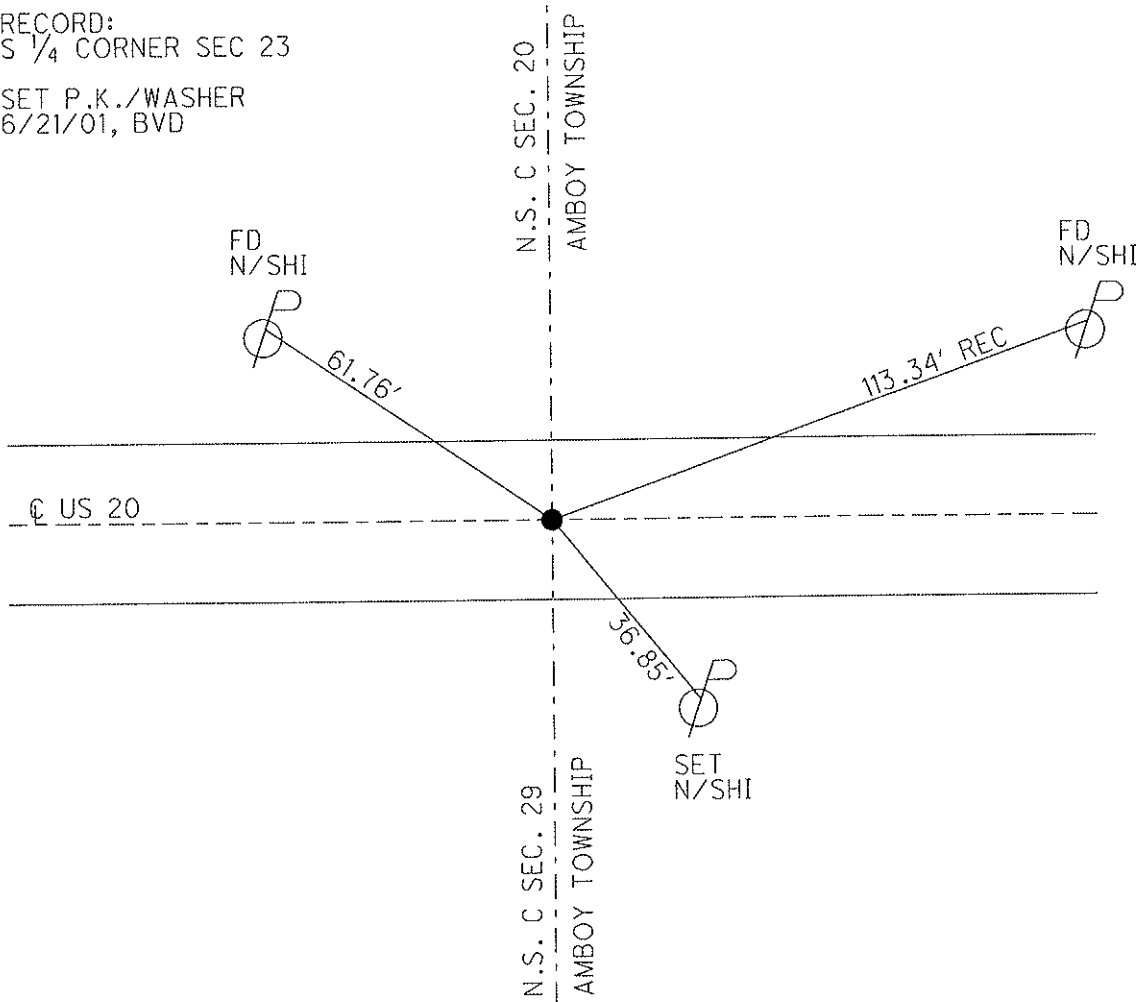

O.D.O.T. DISTRICT 2 SURVEY OFFICE

PERSONNEL

REFERENCE NO. 46-A

SHEET 12 OF 26

NOTES Hoss

H.C. Rousos

DATE 7-24-00

ROUTE US 20

R.C. CORDES

WEATHER Pt. Cldy-Fair

COUNTY FULTON

VAN DUSEN P

TEMP. +74°F

TOWNSHIP AMBOY

SECTION 20

T9 S R 4 E


TYPE MONUMENT RR Spk.

~~ON SURFACE~~ - BELOW 2" Deep


~~PAV'T~~ - PAV'T - ~~PAV'T~~ on E Pavt.

11.4 TO RT. EDGE PAVEMENT

S.L.M. 1244711

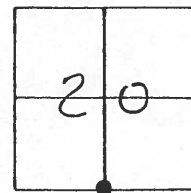

SET PK & WASHER  
6-22-01  
BUD

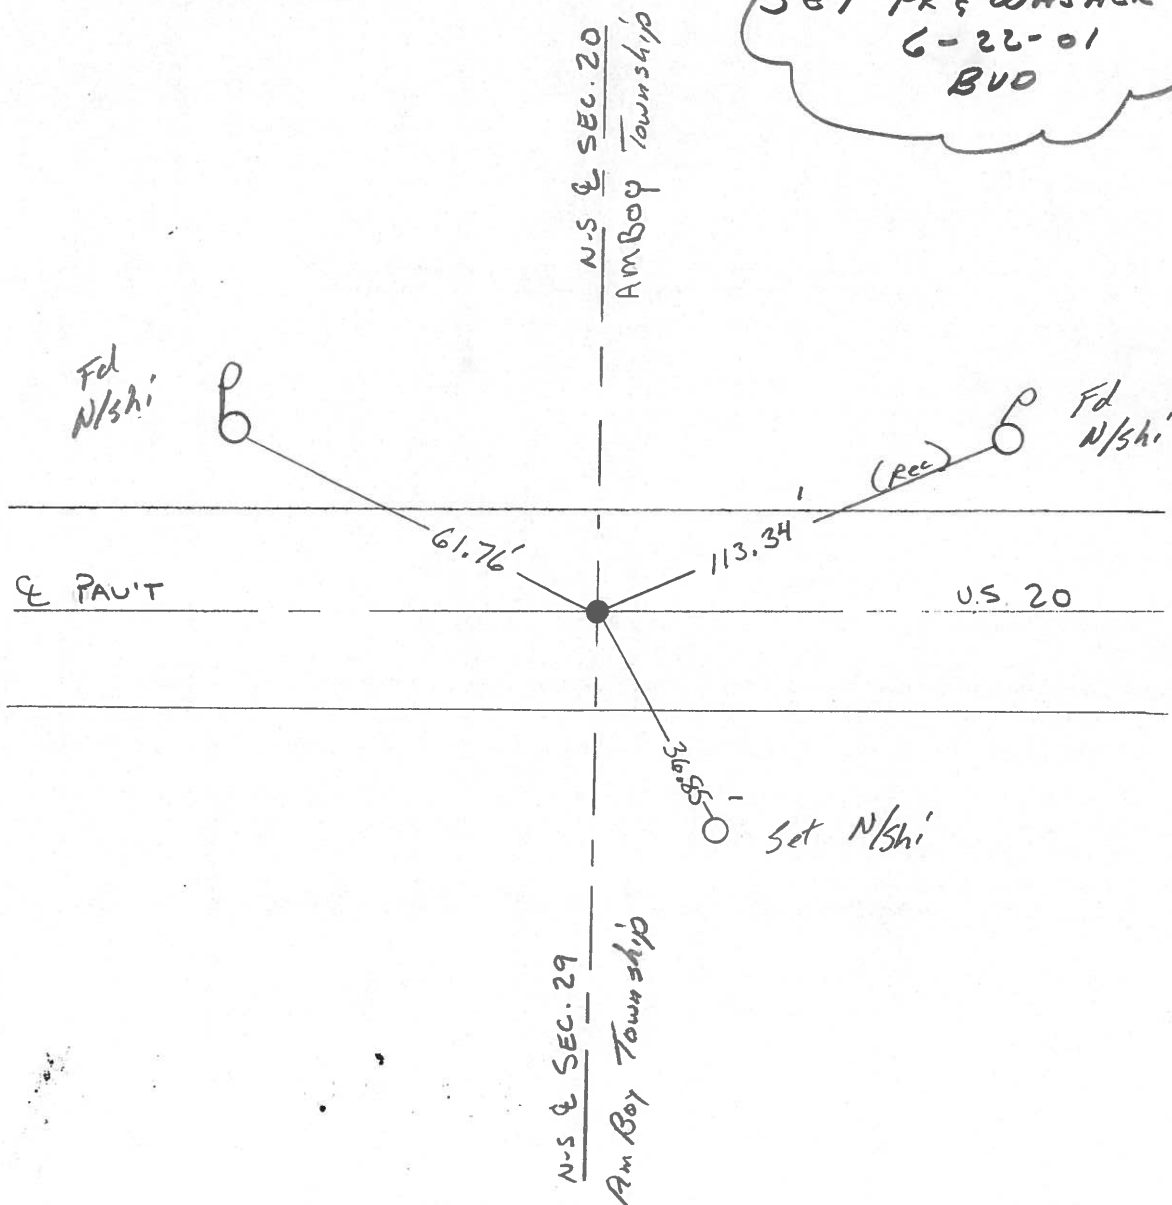

# O.D.O.T. DISTRICT 2 SURVEY OFFICE

PERSONNEL \_\_\_\_\_

REFERENCE NO. 46-A SHEET 11 OF \_\_\_\_\_

NOTES D. CURTIS

H.C. J. HOUSEHOLDER DATE 4-24-86

R.C. R. MICHALAK WEATHER MILD

TEMP. 55°

ROUTE U.S. #20

COUNTY FULTON

TOWNSHIP AMBOY

SECTION 20

T. \_\_\_\_\_ R. \_\_\_\_\_

TYPE MONUMENT R.R. SPK.



ON SURFACE - BELOW 2" deep

LEFT- & PAV'T. - RIGHT \_\_\_\_\_

TO \_\_\_\_\_ EDGE PAVEMENT 11.8' To N. EDGE

11.4' To S. EDGE

S.L.M. 1243 + 66

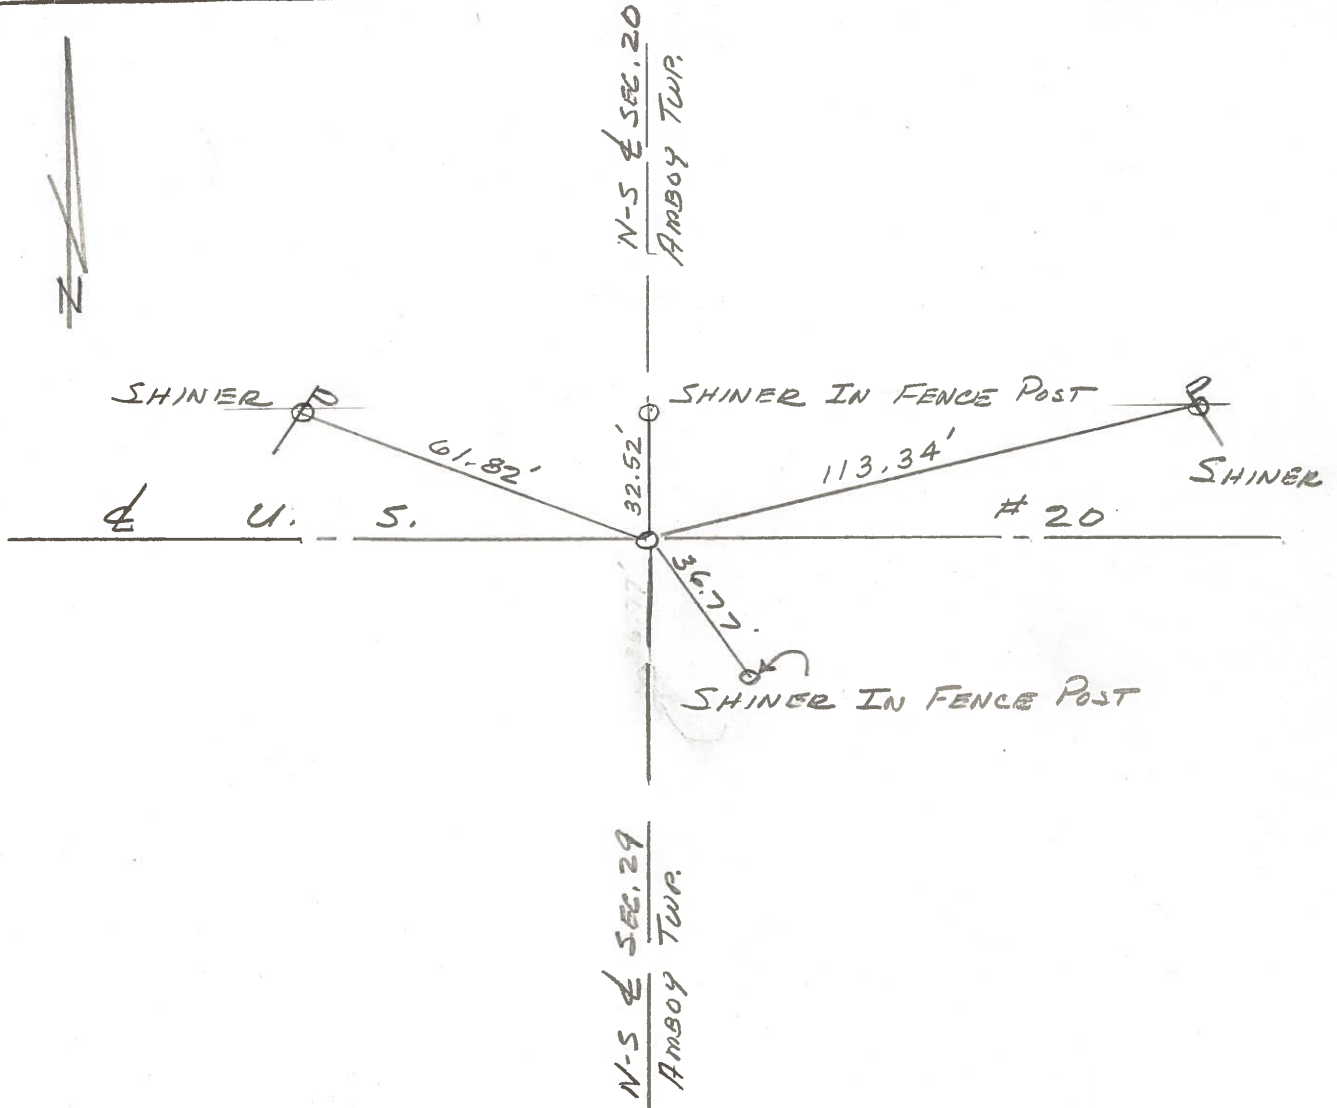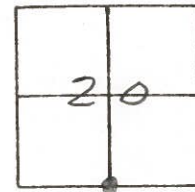

Q.D.O.T. DISTRICT 2 SURVEY OFFICE

Sht. 12 of

County FULTON S.R. US-20

Date 9 MAY 1979

Township AMBOSY


Weather WARM

Section 20

Temp. 80°


T\_N, R\_E

Personnel J. STONE  
R. MICHALAK  
P. NEUSER  
F. CURTIS  
D. GRANATA

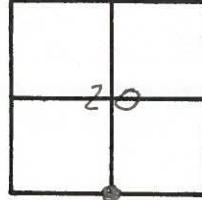

Ref. No. **46 A**

5 1/4 Cor. Sec. 20

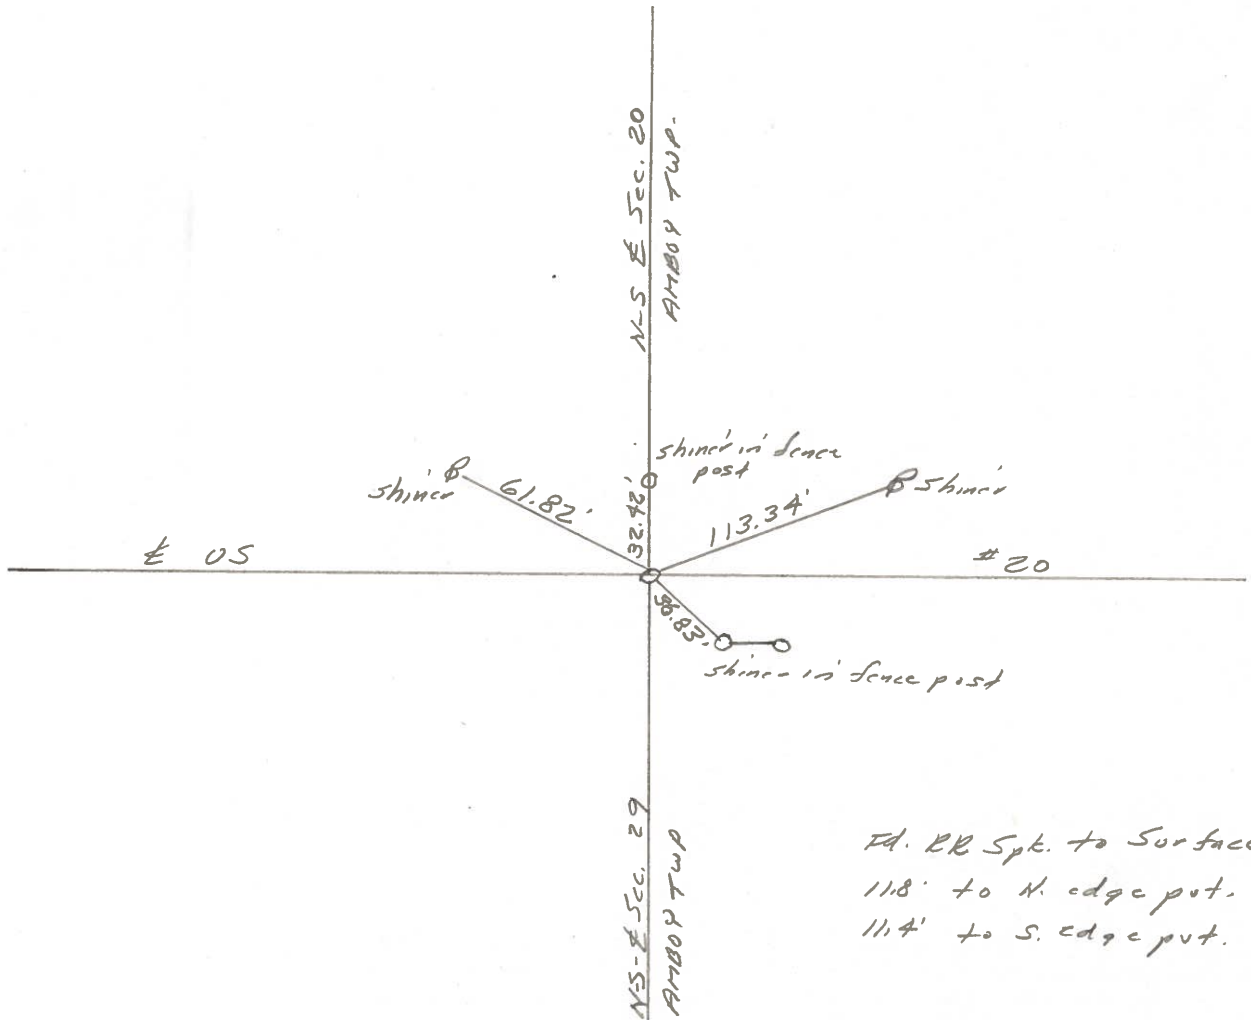

PERSONNEL	TITLE	PERSONNEL	TITLE
Tompic			
Neuser			
Granata			

COUNTY Fulto DATE M 01  
 S. R. U.S. WEATHER \_\_\_\_\_  
 SEC. Am Boy P. TEMP. \_\_\_\_\_

DESCRIPTION \_\_\_\_\_ LEFT \_\_\_\_\_ CENTER LINE \_\_\_\_\_ RIGHT \_\_\_\_\_ JOB NO. \_\_\_\_\_

