



O.D.O.T. DISTRICT 2 SURVEY OFFICE (USE ONLY)

PERSONNEL	REFERENCE NO.	<u>47</u>	SHEET	<u>14</u>	OF	<u>28</u>
NOTES	RHOADES	DATE	<u>4/11/17</u>	ROUTE	<u>US 20</u>	
H.C.	<u>O'DONNELL</u>	WEATHER	<u>CLOUDY</u>	COUNTY	<u>FULTON</u>	
R.C.	<u>HELDMAN</u>	TEMP.	<u>56°</u>	TOWNSHIP	<u>AMBOY</u>	
				SECTION	<u>20</u>	
				T	<u>9</u>	S
				R	<u>4</u>	E

TYPE MONUMENT _____ P.K./WASHER _____
 ON SURFACE - ~~BELOW~~ _____ ON _____
~~LEFT~~ - C PAV'T - RIGHT _____ 1.3' _____
11.7' TO RT EDGE PAVEMENT _____
 S.L.M. _____ 1262+59.85 _____
 GRID: NORTHING: 733709.917 EASTING: 1570656.173

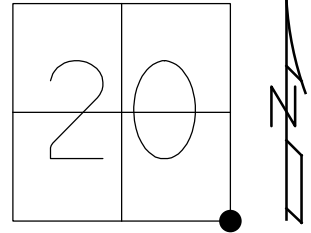

RECORD:
 SET P.K./WASHER
 6-22-01, BVD
 FD P.K./WASHER
 REF 47
 10-14-15, JFO
 SET MAG/WASHER
 6-26-18, JFO

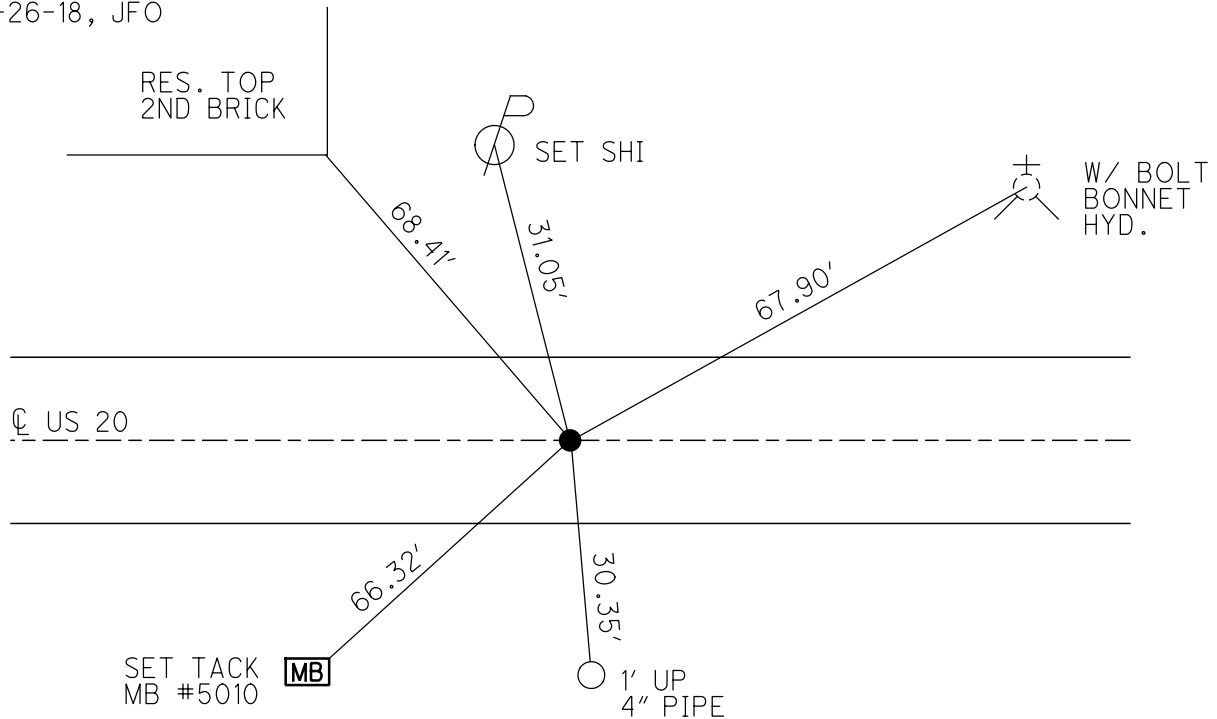

O.D.O.T. DISTRICT 2 SURVEY OFFICE

PERSONNEL

NOTES HUSS
H.C. CORDES
R.C. KARGER

REFERENCE NO. 47

DATE 7/24/00
WEATHER PT.CLOUDY,FAIR
TEMP. 76°

SHEET 13 OF 27

ROUTE US 20
COUNTY FULTON
TOWNSHIP AMBOY
SECTION 20
T 9 S R 4 E



TYPE MONUMENT LG.R.R.SPIKE

~~ON SURFACE~~ - BELOW 2"

~~LEFT~~ - C PAV'T - RIGHT 0.3'
11.7' TO RT EDGE PAVEMENT

S.L.M. 1269+98

Grid: Northing: _____ Easting: _____

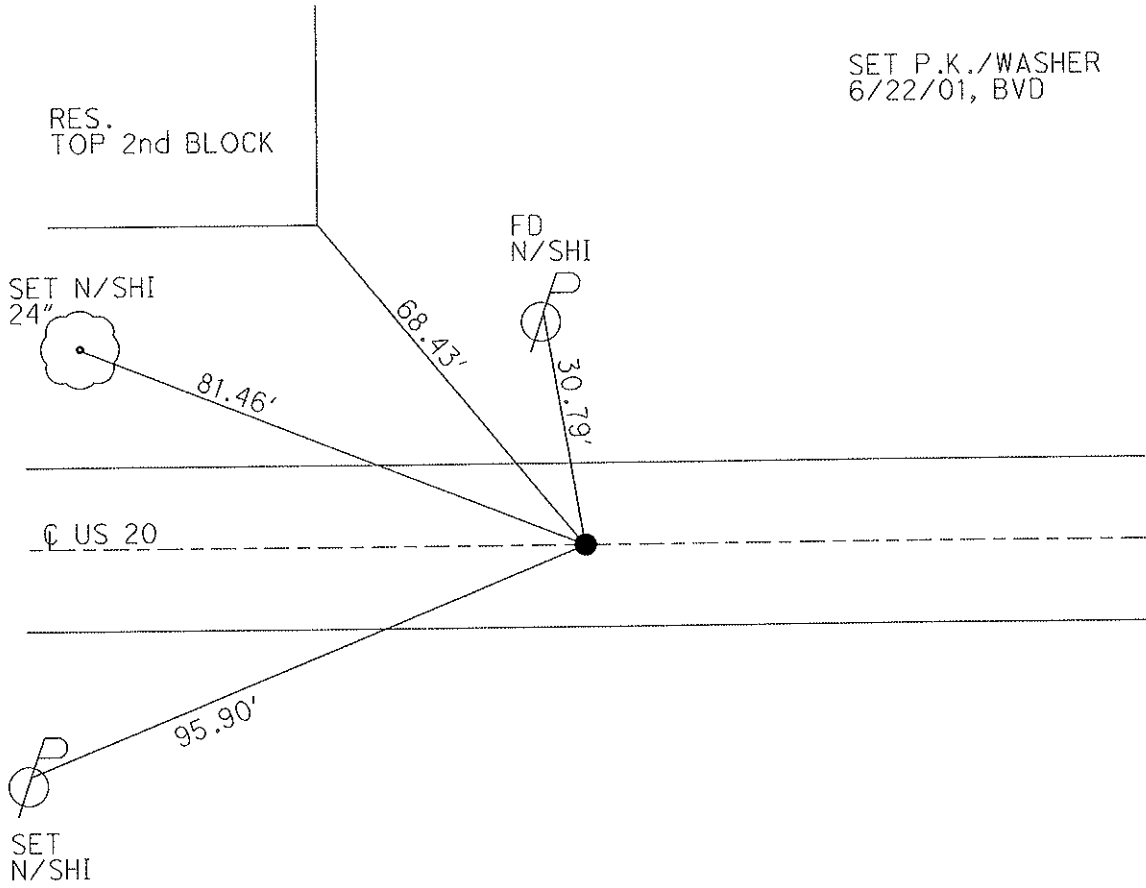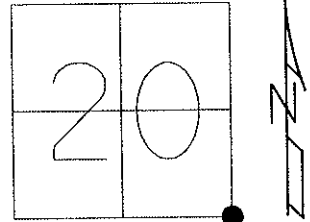

O.D.O.T. DISTRICT 2 SURVEY OFFICE

PERSONNEL _____

REFERENCE NO. 47

SHEET 14 OF 26

NOTES Huss

H.C. Cordes

R.C. Karger

DATE 7-24-00

WEATHER Pt Cldy - Fair

TEMP. 76° F

ROUTE US 20

COUNTY FULTON

TOWNSHIP Amboy

SECTION 20

T 9 S R 4 E


TYPE MONUMENT Lg RR Spk.

ON SURFACE - BELOW 2" Deep


LEFT - CL PAV'T. - RIGHT 0.3' Rt of CL

11.7' TO RT. EDGE PAVEMENT

S.L.M. 1269 + 98

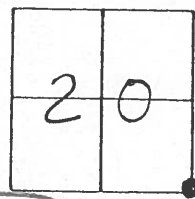

SET PK & WASHER
 6-22-01
 BVD

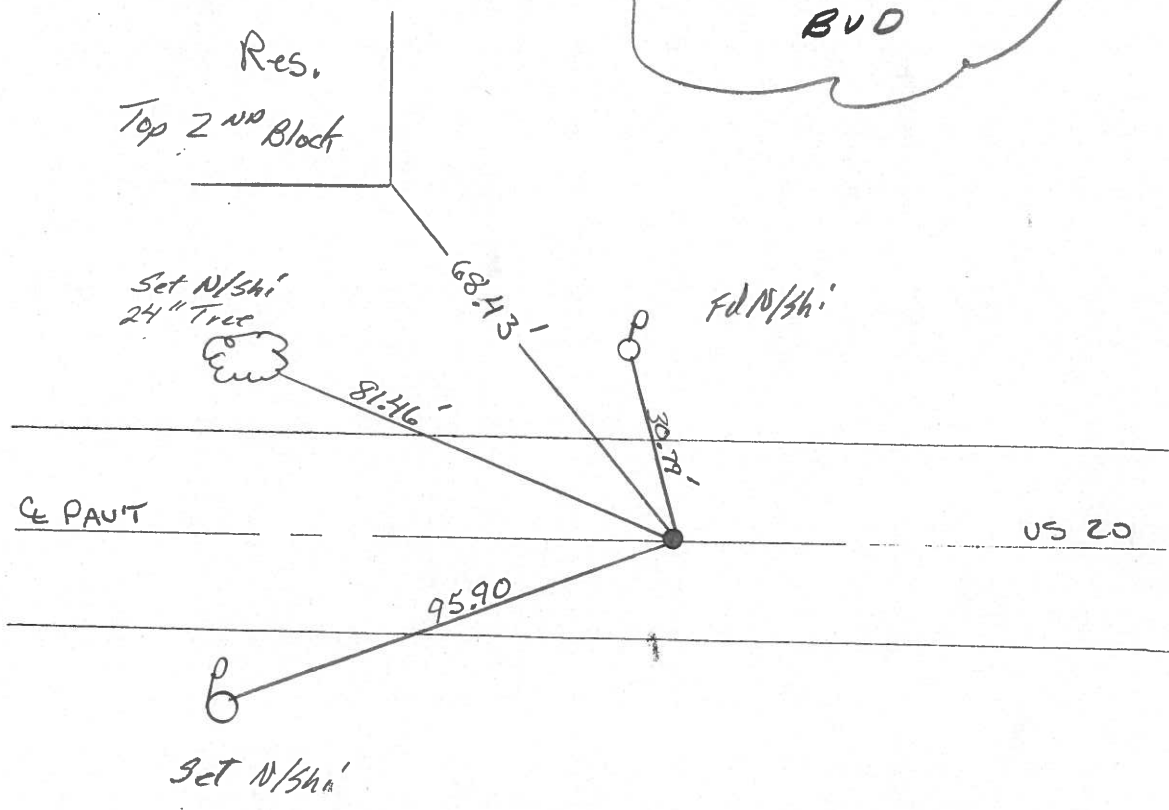

O.D.O.T. DISTRICT 2 SURVEY OFFICE

PERSONNEL _____

REFERENCE NO. 47

SHEET 13 OF _____

NOTES 1. Stone

H.C. D. Curtis

R.C. J. Household

DATE 2 May 86

WEATHER Cool

TEMP. 370

ROUTE US #20

COUNTY Fulton

TOWNSHIP Amboy

SECTION 20

T _____ R _____


TYPE MONUMENT Small Spk

ON SURFACE - BELOW 2" deep


LEFT- & PAW'T. - RIGHT _____

TO _____ EDGE PAVEMENT

S.L.M. 1269+42

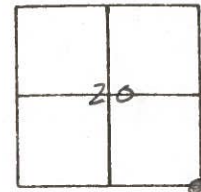

OK 8/27/86 IRS

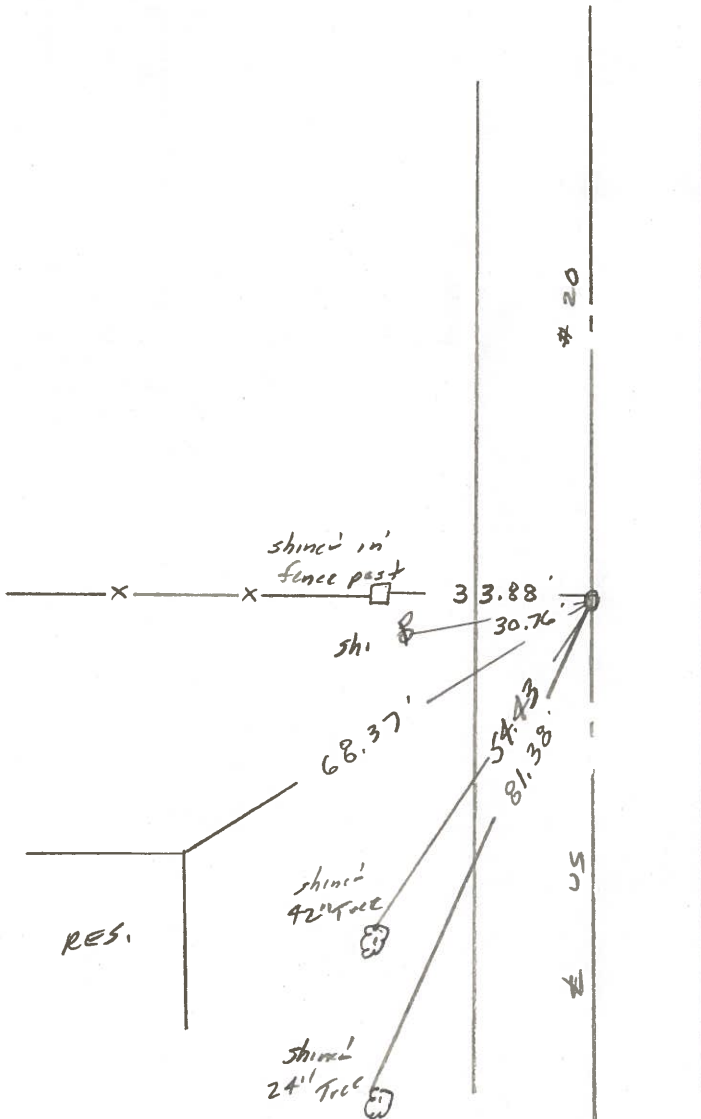

Q.D.O.T. DISTRICT 2 SURVEY OFFICE

Sht. 14 of

County FULTON S.R. 05-20

Date 9 MAY 1979

Township AMBOY


Weather WARM

Section 20

Temp. 80°


T_N, R_E

Personnel I. STONE
R. MICHALAK
P. NEUSER
D. CURTIS
D. GRANATH

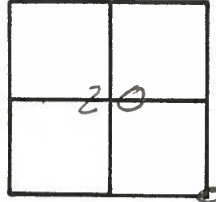

REF. NO. **47**

SE COR. SEC. 20

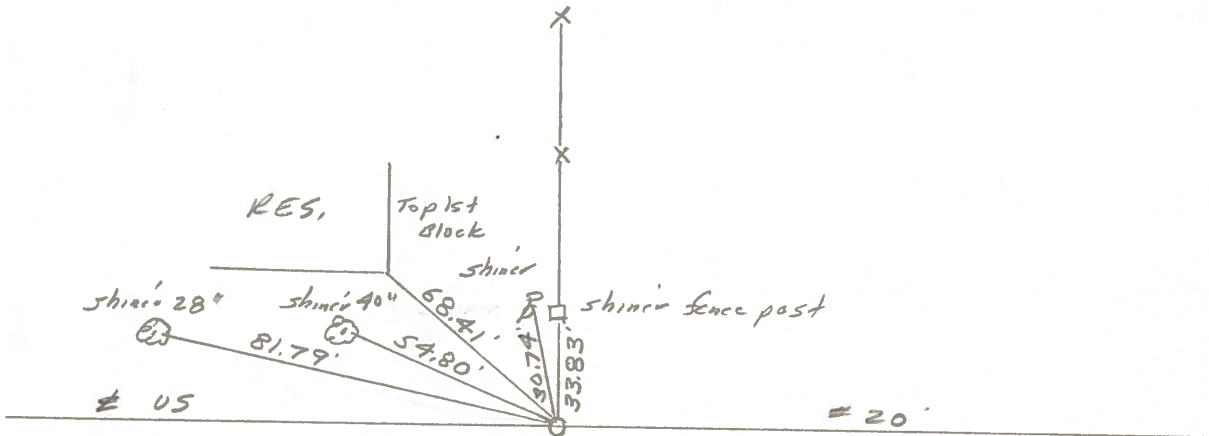

Fd. RR Spk. To Surface
 12.3' to N. edge post,
 11.7' to S. edge post.

PERSONNEL	TITLE	PERSONNEL	TITLE	COUNTY	DATE	WEATHER	TEMP.
Tomsic				Fulton	Aug. 29, 1973		
Granata				U.S. 20			
Vandy				AnnBoy Twp			
Boyle							

DESCRIPTION _____ LEFT _____ CENTER LINE _____ RIGHT _____ JOB NO. _____

