


O.D.O.T. DISTRICT 2 SURVEY OFFICE (USE ONLY)

PERSONNEL _____ REFERENCE NO. 48 SHEET 15 OF 28


NOTES RHOADES DATE 4/11/17 ROUTE US 20
 H.C. O'DONNELL WEATHER CLOUDY COUNTY FULTON
 R.C. HELDMAN TEMP. 56° TOWNSHIP AMBOY
 _____ SECTION 21
 _____ T 9 S R 4 E

TYPE MONUMENT _____ P.K./WASHER _____
 ON SURFACE - ~~BELOW~~ _____ ON _____
 LEFT - ☉ PAV'T - ~~RIGHT~~ _____ 1' _____
 _____ TO _____ EDGE PAVEMENT _____
 S.L.M. _____ 1276+13.90 _____

GRID: NORTHING: 733726.623 EASTING: 1572010.117

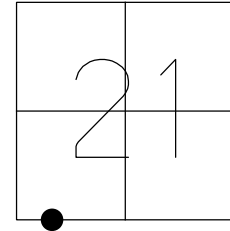



RECORD:
 SET P.K./WASHER
 6-22-01, BVD
 FD P.K./WASHER
 REF48
 10-14-15, JFO
 SET MAG/WASHER
 6-26-18, JFO

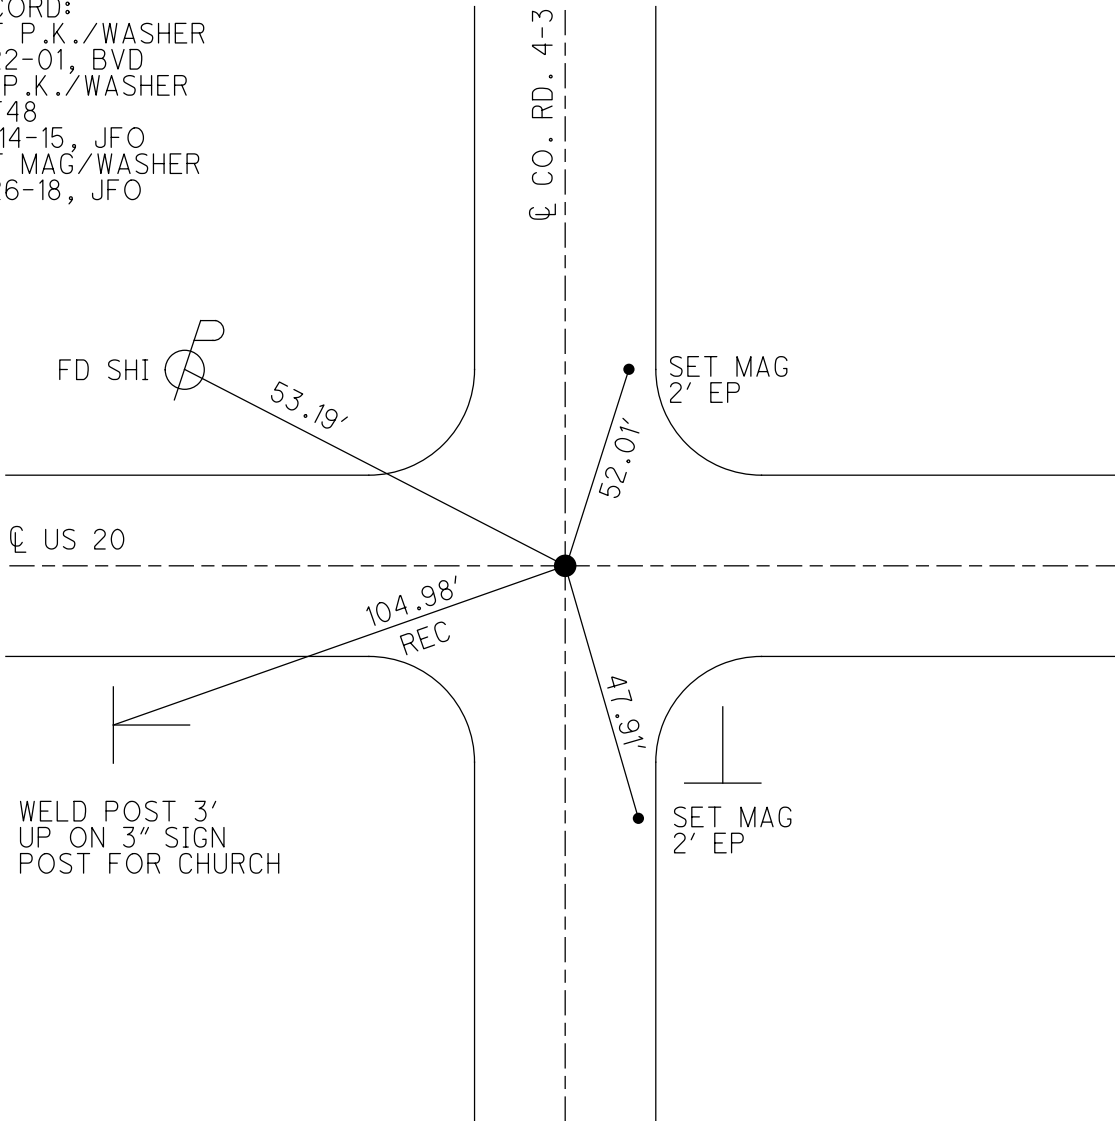

O.D.O.T. DISTRICT 2 SURVEY OFFICE

| | | |
|--------------------|---------------------------------|------------------------------|
| PERSONNEL | REFERENCE NO. <u>48</u> | SHEET <u>14</u> OF <u>27</u> |
| NOTES <u>HUSS</u> | DATE <u>7/24/00</u> | ROUTE <u>US 20</u> |
| H.C. <u>CORDES</u> | WEATHER <u>PT. CLOUDY, FAIR</u> | COUNTY <u>FULTON</u> |
| R.C. <u>KARGER</u> | TEMP. <u>76°</u> | TOWNSHIP <u>AMBOY</u> |
| | | SECTION <u>21</u> |
| | | T <u>9</u> S R <u>4</u> E |

TYPE MONUMENT P.K./WASHER
 ON SURFACE - ~~BELOW~~ ON
 LEFT - C PAV'T - RIGHT ON
TO EDGE PAVEMENT
 S.L.M. 1283+65
 Grid: Northing: _____ Easting: _____

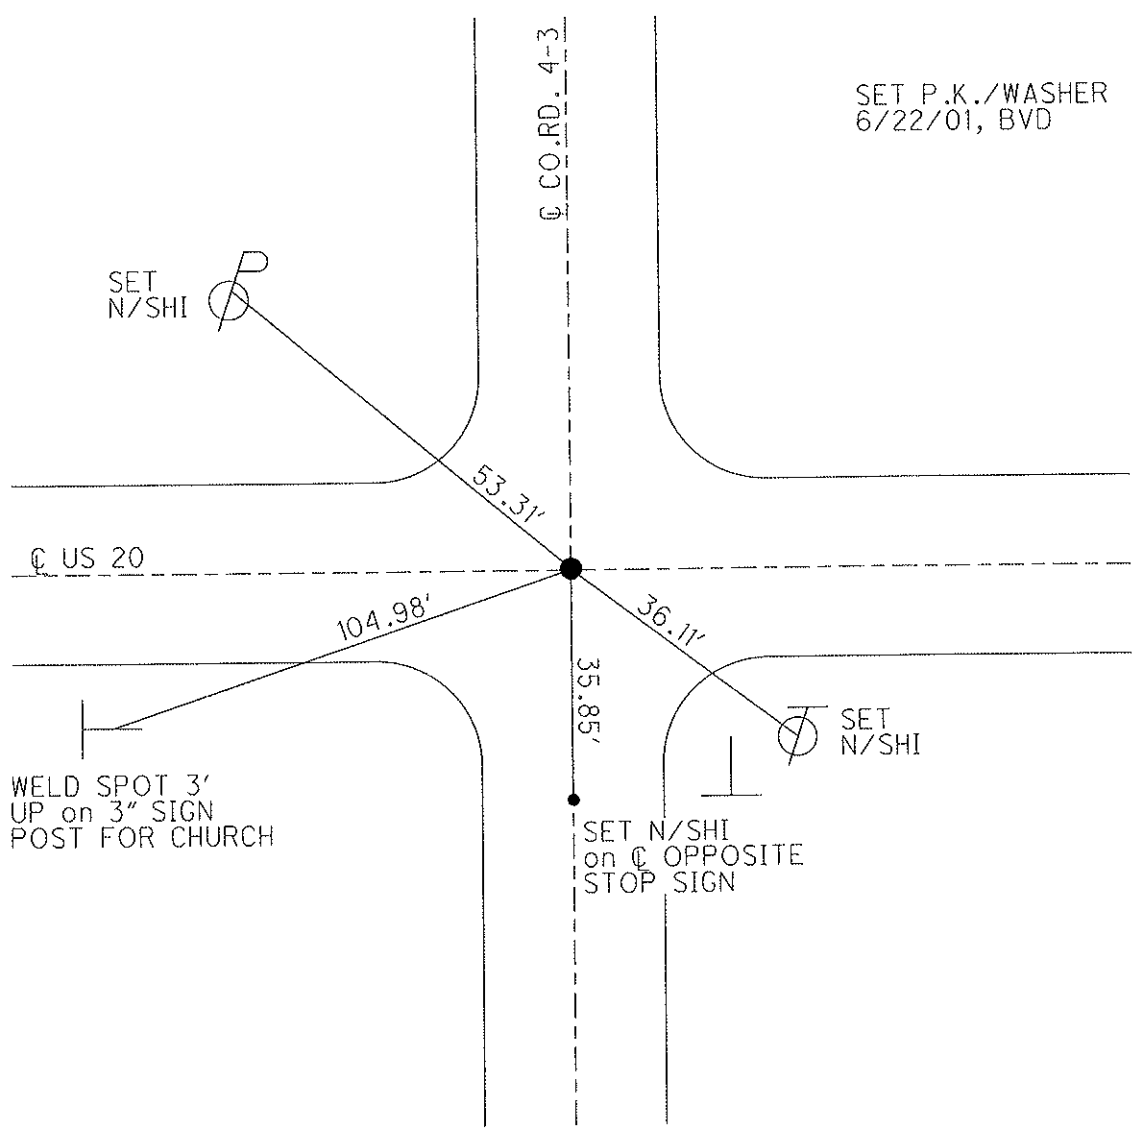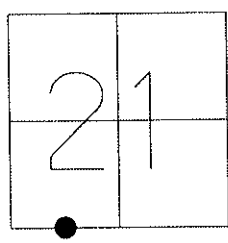

O.D.O.T. DISTRICT 2 SURVEY OFFICE

PERSONNEL

REFERENCE NO. 48

SHEET 15 OF 26

NOTES Huss

H.C. Cords

R.C. Karsen

DATE 7-24-00

WEATHER Pt. Cldy - Fair

TEMP. +76°F

ROUTE U.S. 20

COUNTY FULTON

TOWNSHIP AMBOY

SECTION 21

T. 5 S. R. 4 E


TYPE MONUMENT PK/W

ON SURFACE - BELOW Surface


LEFT - & PAV'T. - RIGHT & Pavt.

TO EDGE PAVEMENT

S.L.M. 1283+65

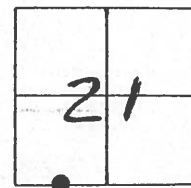

SET PK & WASHER
6-22-01
BUD

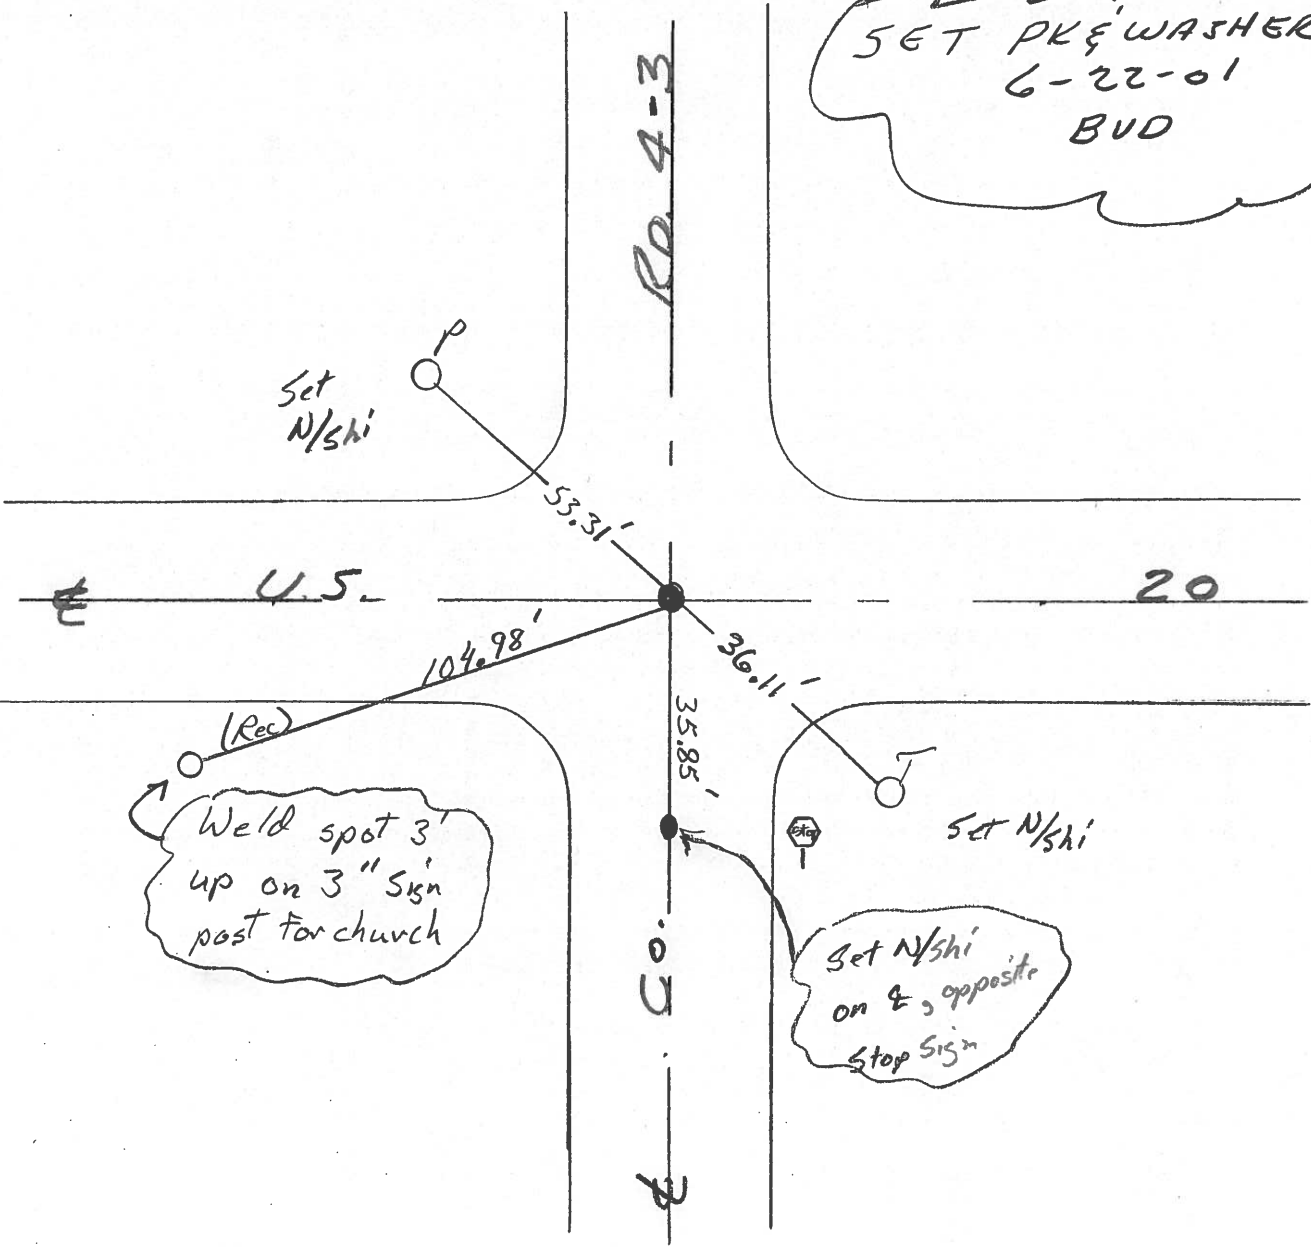

O.D.O.T. DISTRICT 2 SURVEY OFFICE

PERSONNEL _____

REFERENCE NO. 48

SHEET 17 OF _____

NOTES 1. Stone

H.C. D. Curtis

R.C. J. Householder

DATE 2 May 86

WEATHER Cool

TEMP. 370

ROUTE US#20

COUNTY Fulton

TOWNSHIP Amberg

SECTION 21

T. _____ R. _____


TYPE MONUMENT PK Nail

ON SURFACE - BELOW Surface


LEFT - \odot PAV'T. - RIGHT _____

TO _____ EDGE PAVEMENT

S.L.M. 1282 +96

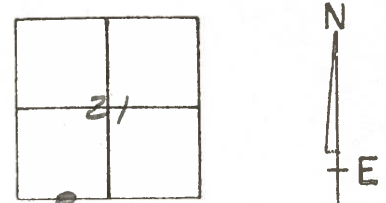

OK 8/27/86 1RS

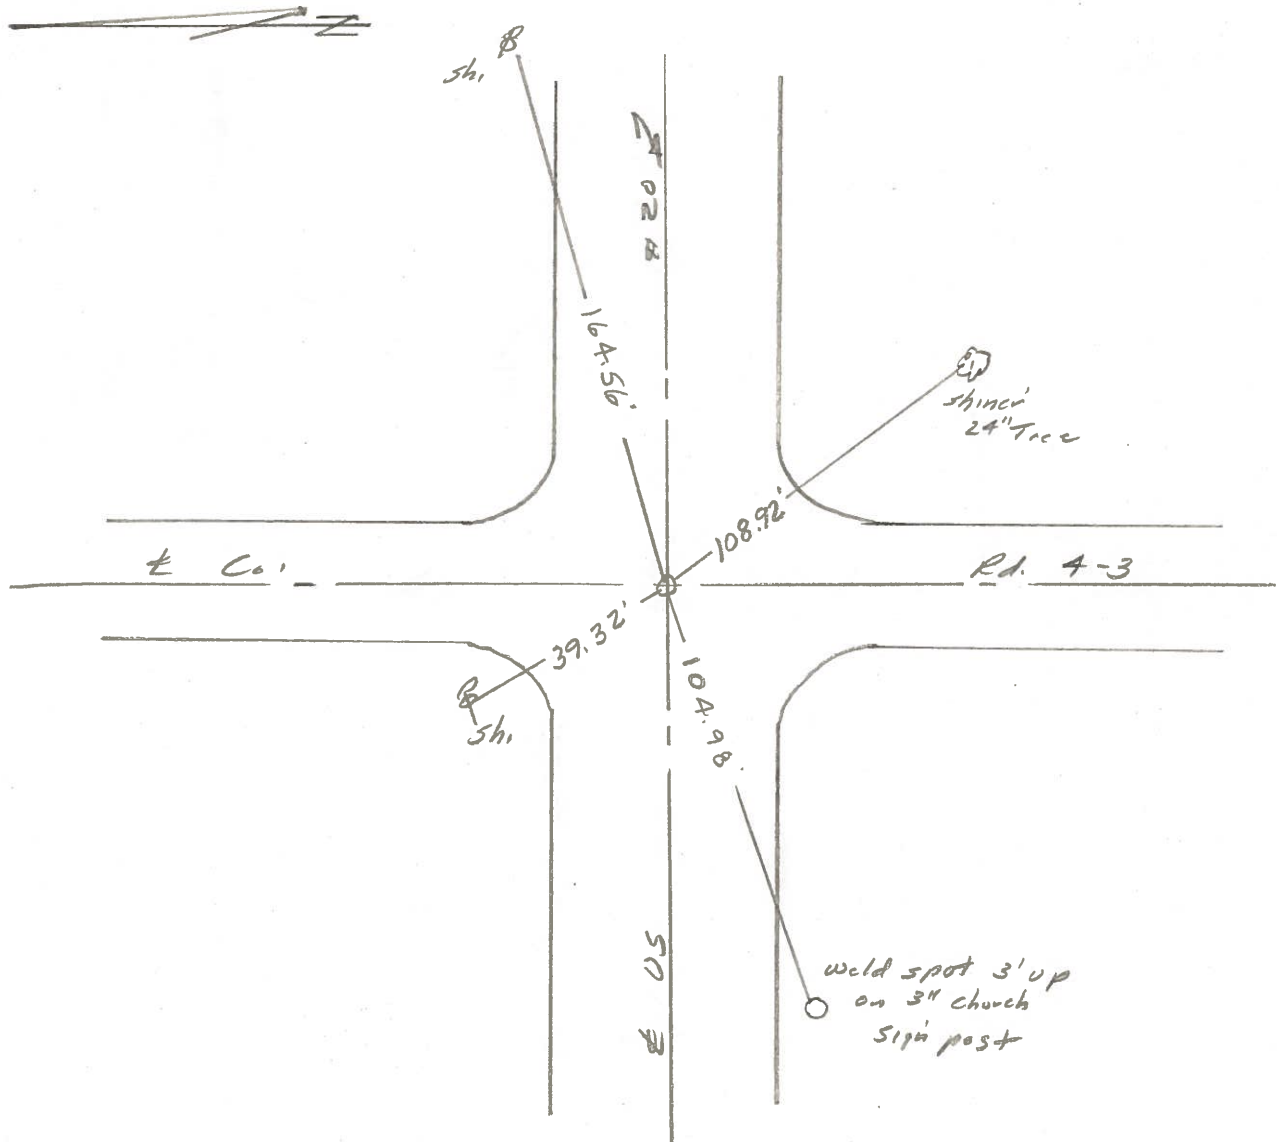

County FULTON S.R. US-20

Township AMBOY

Section 21

T_N, R_E

Personnel J. STONE

B. MICHALAK

P. NEUSER


D. CURTIS

D. GRANATA

Date 7 MAY 1979


Weather WARM

Temp. 80°

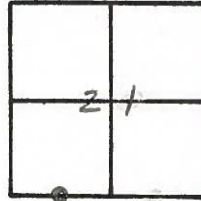

Ref. No. 48

1/4 1/4 Cor. Sec. 21

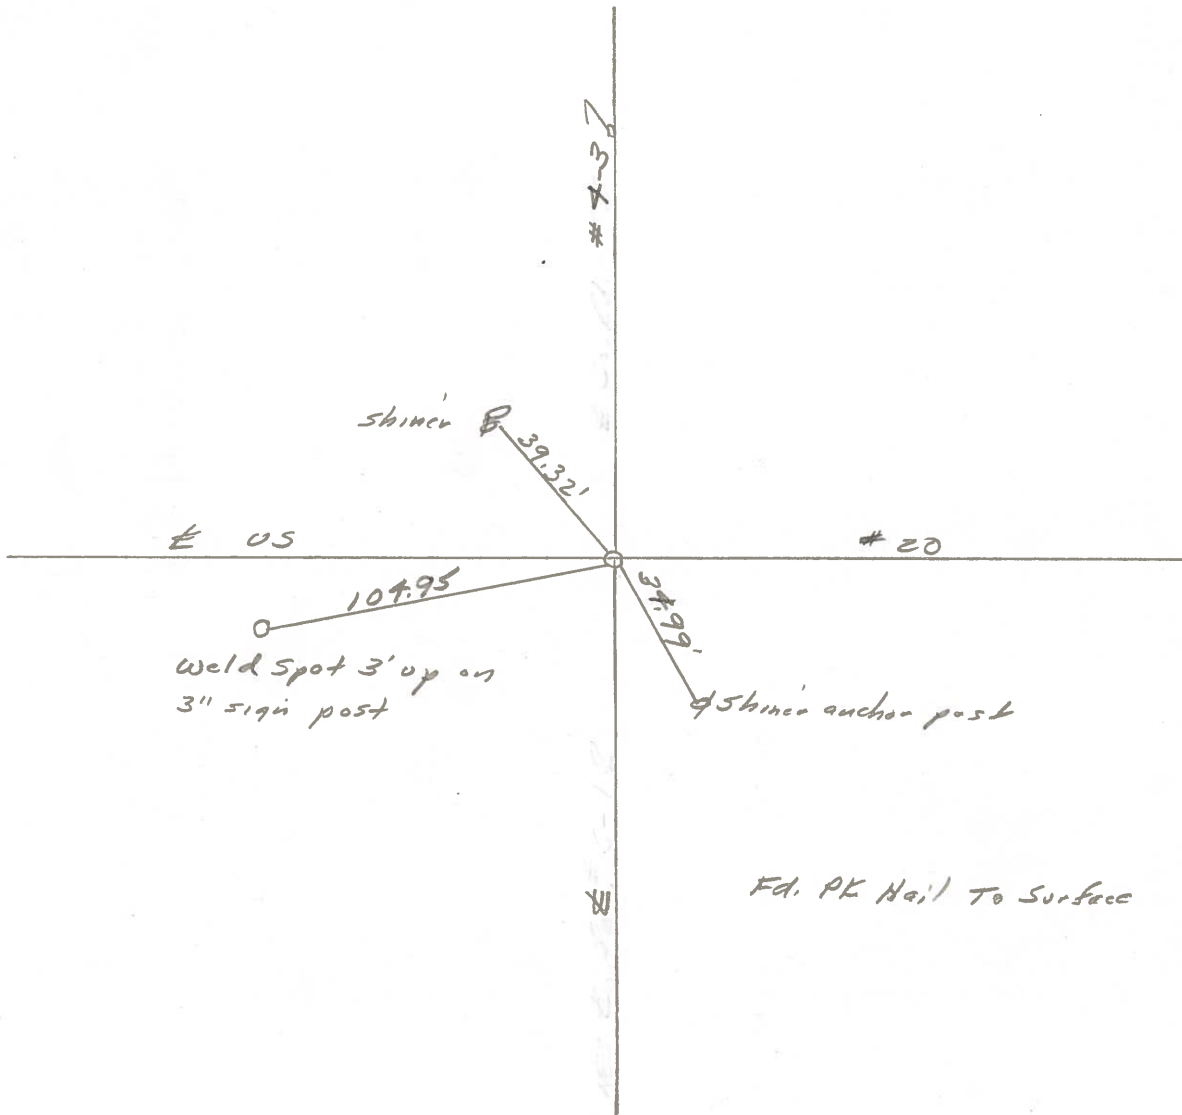

| PERSONNEL | TITLE | PERSONNEL | TITLE | COUNTY | DATE | WEATHER | TEMP. |
|----------------|-------|-----------|-------|-----------------------|----------------------|---------|-------|
| <u>Tomsic</u> | | | | <u>Fulton</u> | <u>Aug. 29, 1973</u> | | |
| <u>Granata</u> | | | | <u>U.S. 20</u> | | | |
| <u>Vandy</u> | | | | <u>SEC. Amboy Twp</u> | | | |
| <u>Boyle</u> | | | | | | | |

DESCRIPTION LEFT CENTER LINE RIGHT JOB NO.

