


O.D.O.T. DISTRICT 2 SURVEY OFFICE (USE ONLY)


PERSONNEL _____ REFERENCE NO. 51 SHEET 20 OF 28
 NOTES RHOADES _____ DATE 4/12/17 ROUTE US 20
 H.C. O'DONNELL _____ WEATHER CLOUDY COUNTY FULTON
 R.C. HELDMAN _____ TEMP. 46° TOWNSHIP AMBOY
 _____ SECTION 22
 _____ T 9 S R 4 E

TYPE MONUMENT _____ MAG NAIL _____
 ON SURFACE - ~~BELOW~~ _____ ON _____
~~LEFT - C~~ PAV'T - ~~RIGHT~~ _____ ON _____
 _____ 12' TO RT EDGE PAVEMENT _____
 S.L.M. 1368+32.17
 GRID: NORTHING: 733784.790 EASTING: 1581226.925

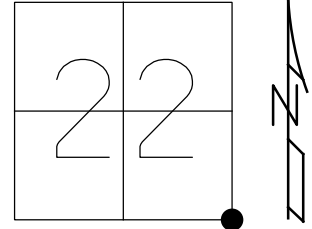

51 TO 51A = 179.95'

RECORD:
 FD P.K. NAIL -
 ASSUMPTION CORPLINE
 FD MAG NAIL
 SET BY OTHERS
 6-22-01, BVD
 FD MAG NAIL
 REF51
 10-14-17
 SET MAG/WASHER
 NEW REF51
 6-25-18, JFO

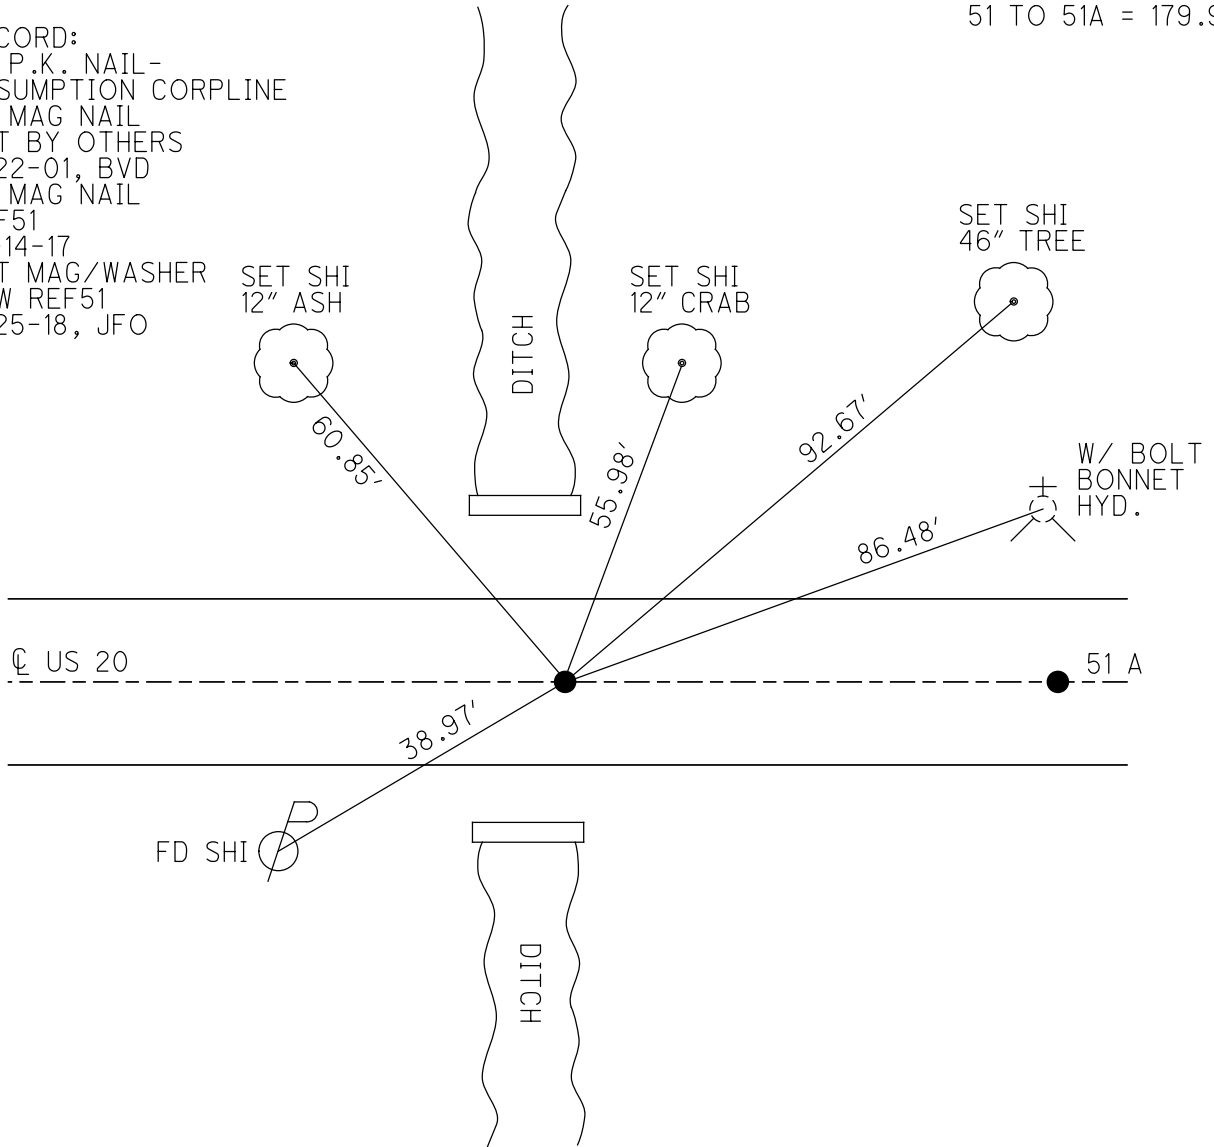

FD SHI

W/ BOLT
 BONNET
 HYD.

O.D.O.T. DISTRICT 2 SURVEY OFFICE

PERSONNEL _____

REFERENCE NO. 51

SHEET 19 OF 27

NOTES KARGER

DATE 7/25/00

ROUTE US 20

H.C. CORDES

WEATHER PT.CLOUDY

COUNTY FULTON

R.C. KARGER

TEMP. 76°

TOWNSHIP AMBOY

SECTION 22,23,26,27

T 9 S R 4 E

TYPE MONUMENT SM.R.R.SPIKE

~~ON SURFACE~~ - BELOW 2"



LEFT - C PAV'T - RIGHT ON

12' TO RT EDGE PAVEMENT

S.L.M. 1376+33

Grid: Northing: _____ Easting: _____

22	23
27	26

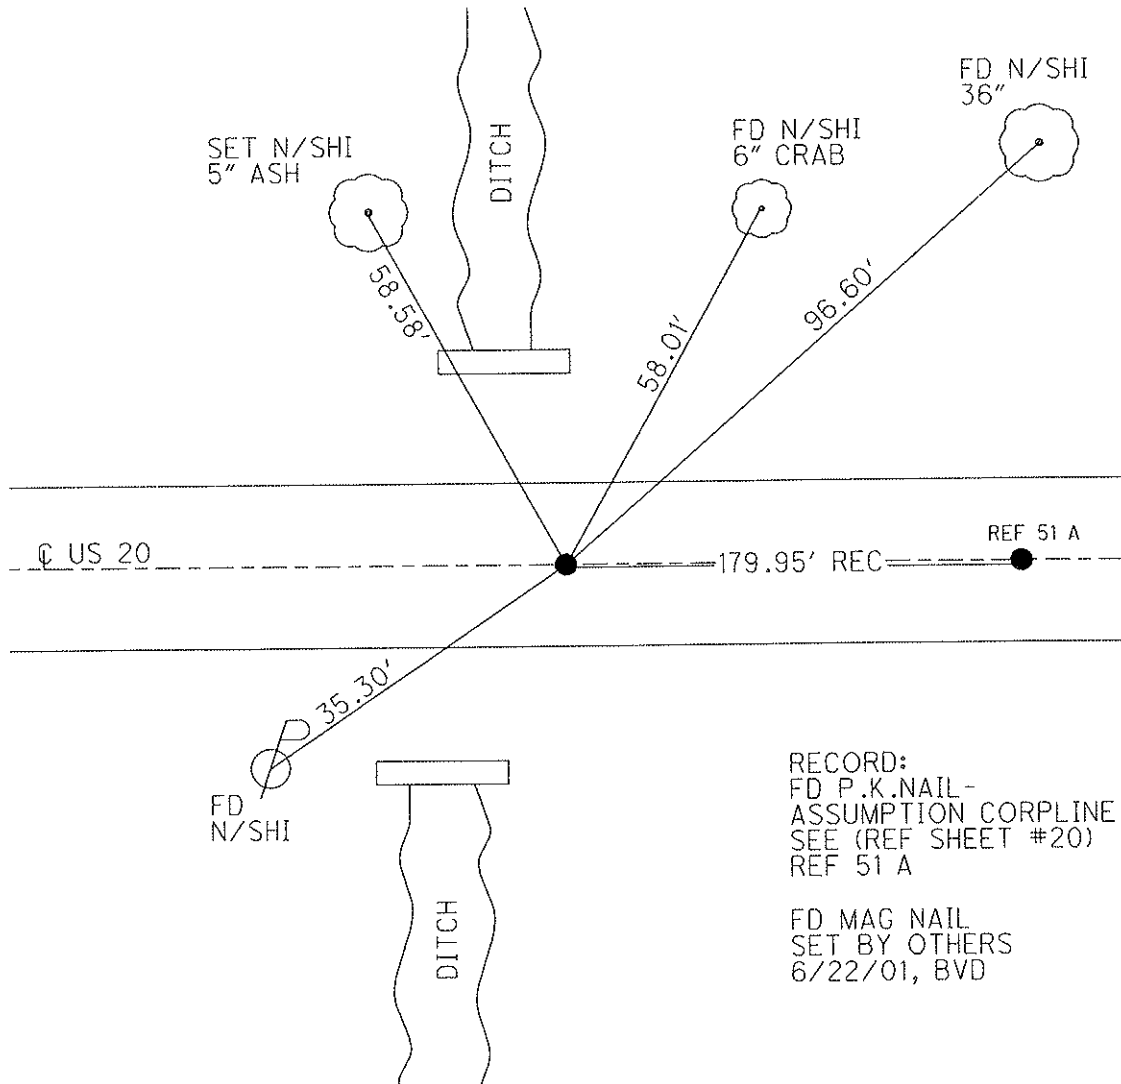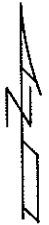

RECORD:
 FD P.K.NAIL -
 ASSUMPTION CORPLINE
 SEE (REF SHEET #20)
 REF 51 A

FD MAG NAIL
 SET BY OTHERS
 6/22/01, BVD

O.D.O.T. DISTRICT 2 SURVEY OFFICE

PERSONNEL _____

REFERENCE NO. 51

SHEET 20 OF 26

NOTES Kansen

H.C. Cordes

R.C. Kansen

DATE 7-25-00

WEATHER Pt-Cldy

TEMP. 76°F

ROUTE US 20

COUNTY FULTON

TOWNSHIP AMBOSY

SECTION 22-23-26-27

T 9 S R 4 E

TYPE MONUMENT Small RR (Bent)

~~ON SURFACE~~ BELOW 2" Deep

~~LEFT~~ PAV'T - RIGHT on E

12' TO RT. EDGE PAVEMENT

S.L.M. 1376+33


22	23
27	26



Record: Fd.

PK Nail - Assumption Corp Line
See (Ref Sheet #20)
REF 51-A

**FD. MARK. NAIL
SET BY OTHERS
6-22-01
BVO**

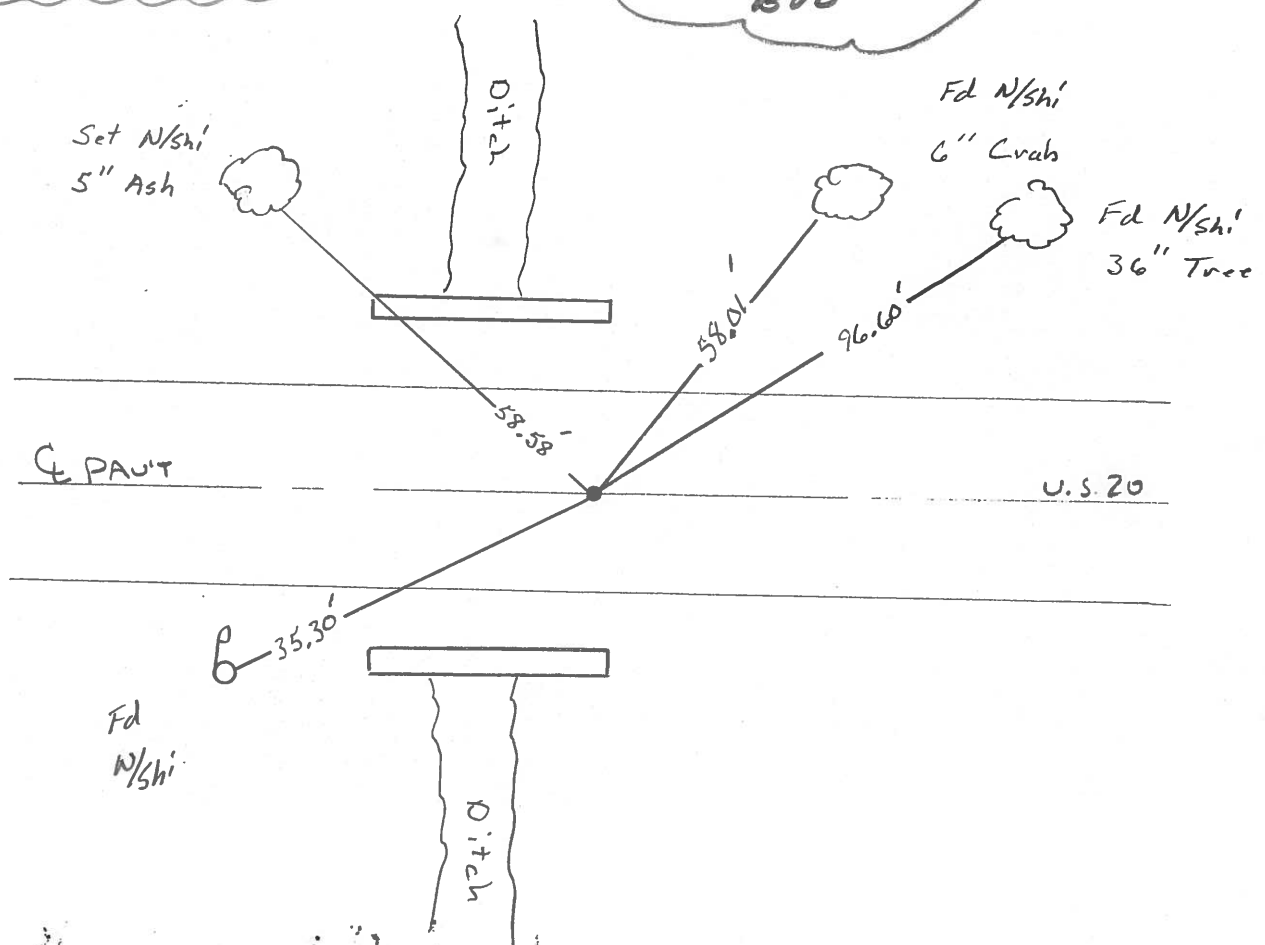

O.D.O.T. DISTRICT 2 SURVEY OFFICE

PERSONNEL _____

REFERENCE NO. 51

SHEET 19 OF _____

NOTES 1. Stone

H.C. D. Curtis

R.C. J. Householder

DATE 2 May 86

WEATHER Cool

TEMP. 38°

ROUTE US #20

COUNTY Fulton

TOWNSHIP Am bog

SECTION 22-23-26-27

T _____ R _____

TYPE MONUMENT 1" I. pin (Bent)

ON SURFACE - BELOW 2" deep

LEFT - & PAV'T. - RIGHT _____


TO _____ EDGE PAVEMENT

S.L.M. 1375+14

22	23
27	26



OK 8/27/86 1RS

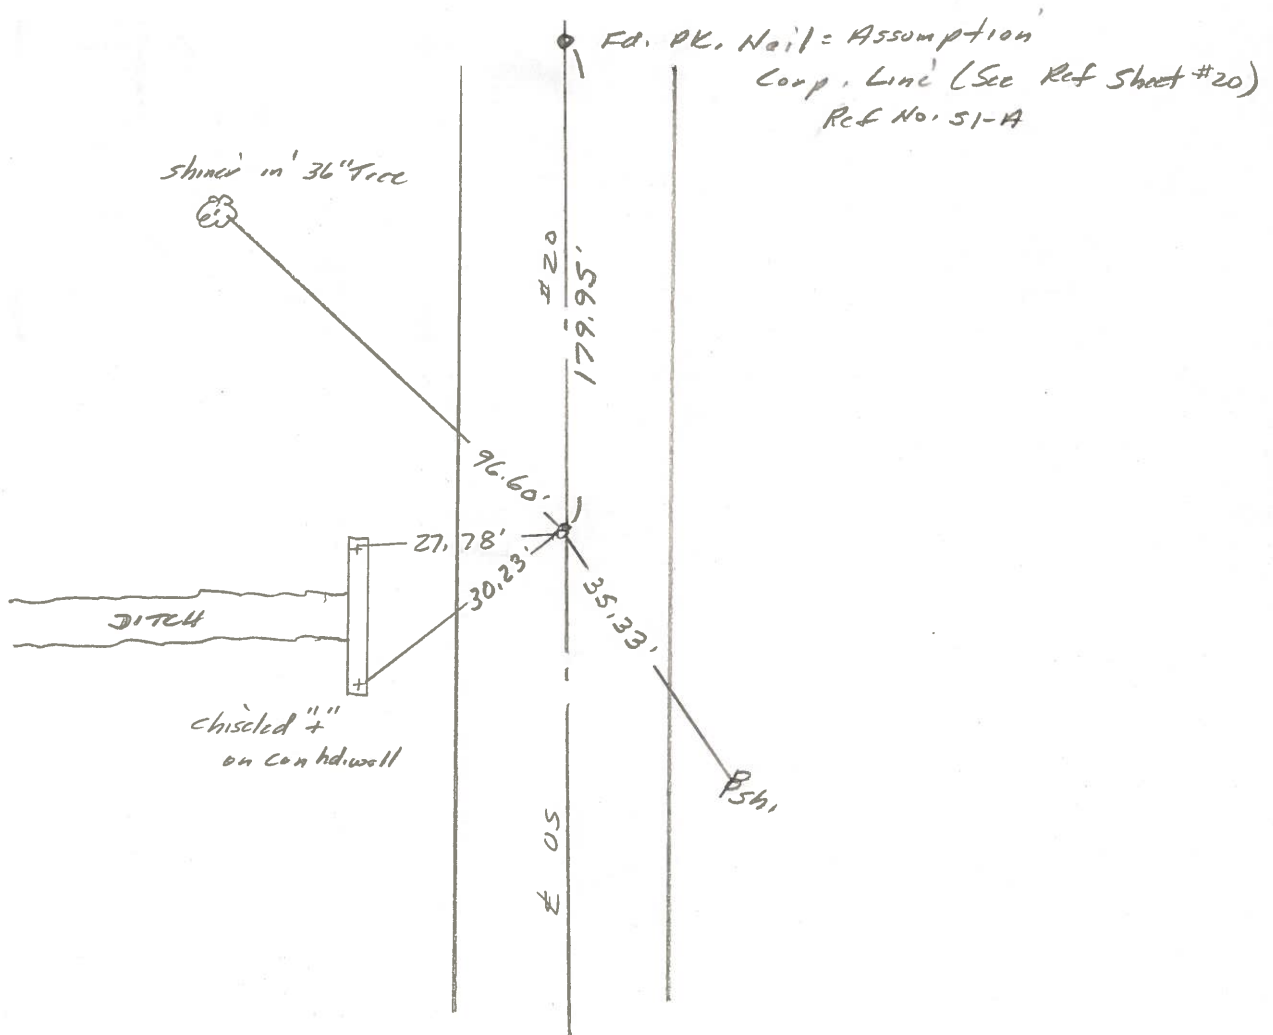

O.D.O.T. DISTRICT 2 SURVEY OFFICE

Sht. 20 of

County Fulton US# 20

Date 14 May 1979

Township Ambony


Weather Fair

Section 22

Temp. 60°

T N, R E

Personnel I. Stone

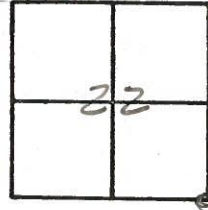

R. Michalak


P. Neuser

J. Curtis

D. Granata

REF. NO. 51


SE Cor. Sec. 22

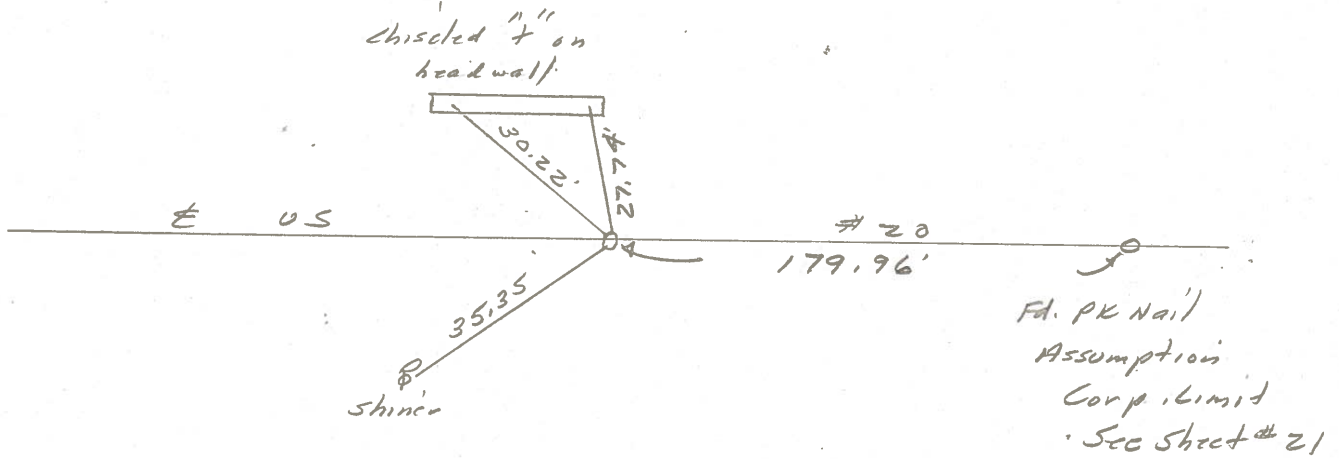

Fd. 1" Iron Pipe To Surface
 12.0' to N. edge put.
 12.2' to S. edge put.

PERSONNEL	TITLE	PERSONNEL	TITLE	COUNTY	DATE	WEATHER	TEMP.
Tomsic				Fulton	Aug, 29, 1973		
Granata				U.S. 20			
Vandy				SEC. Amboy Twp			
Boyle							

DESCRIPTION _____ LEFT _____ CENTER LINE _____ RIGHT _____ JOB NO. _____

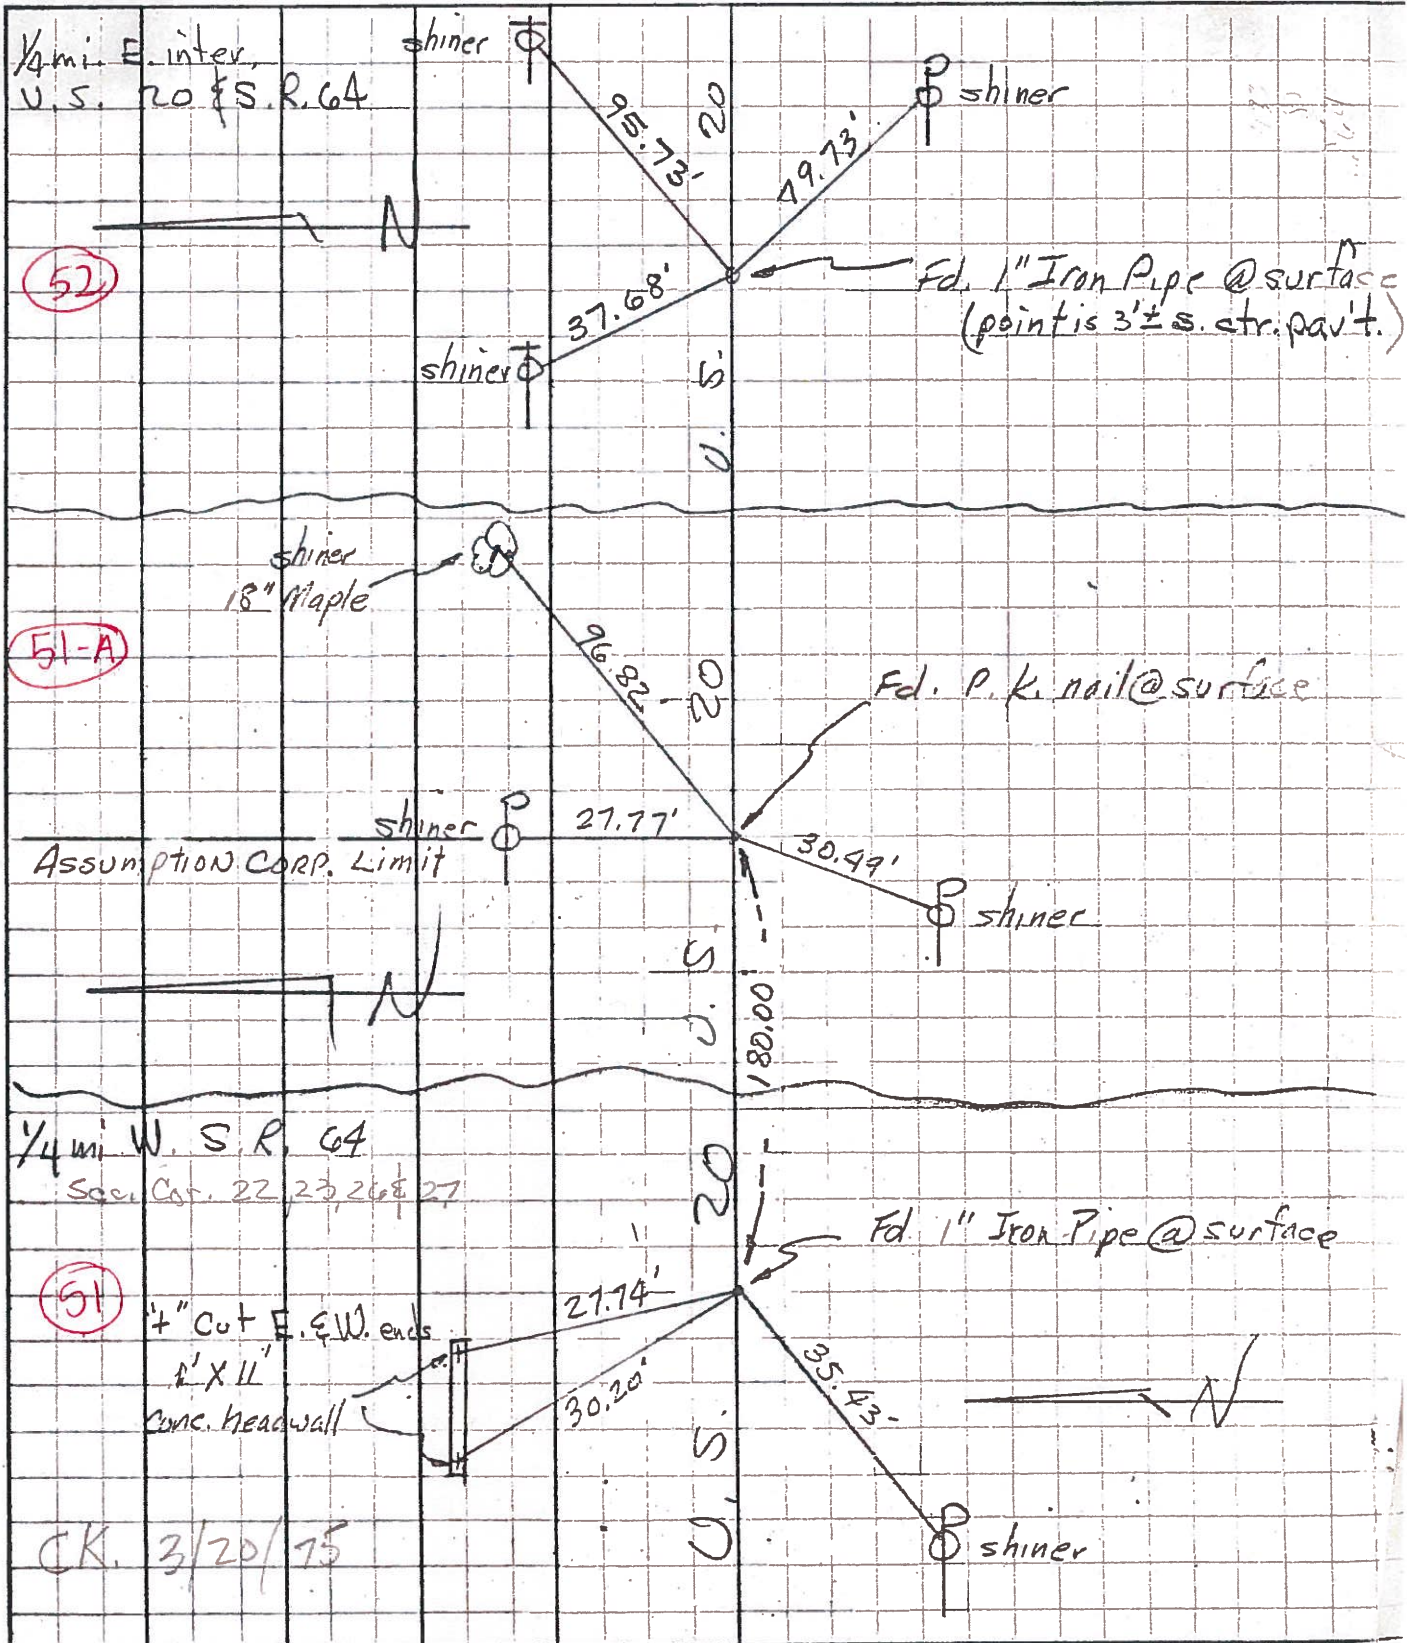

CK. 3/20/75