


O.D.O.T. DISTRICT 2 SURVEY OFFICE (USE ONLY)

PERSONNEL _____ REFERENCE NO. 53 SHEET 24 OF 28
 NOTES RHOADES DATE 4-12-17 ROUTE US 20
 H.C. O'DONNELL WEATHER PT. CLOUDY COUNTY FULTON
 R.C. HELDMAN TEMP. 46° TOWNSHIP AMBOY
 _____ SECTION 23
 _____ T 9 S R 4 E


TYPE MONUMENT _____ P.K./WASHER _____
 ON SURFACE - ~~BELOW~~ _____ ON _____
~~LEFT~~ - ☉ PAV'T - RIGHT _____ 5.3' _____
 _____ TO _____ EDGE PAVEMENT _____
 S.L.M. _____ 1402+97.51 _____

GRID: NORTHING: 733666.693 EASTING: 1586490.841

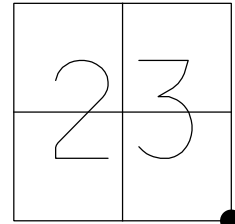

53 T 53A = 20.01'

RECORD:
 SET P.K./WASHER
 6-22-01, BVD
 FD P.K./WASHER
 REF53
 10-14-15, JFO
 SET MAG/WASHER
 6-25-18, JFO

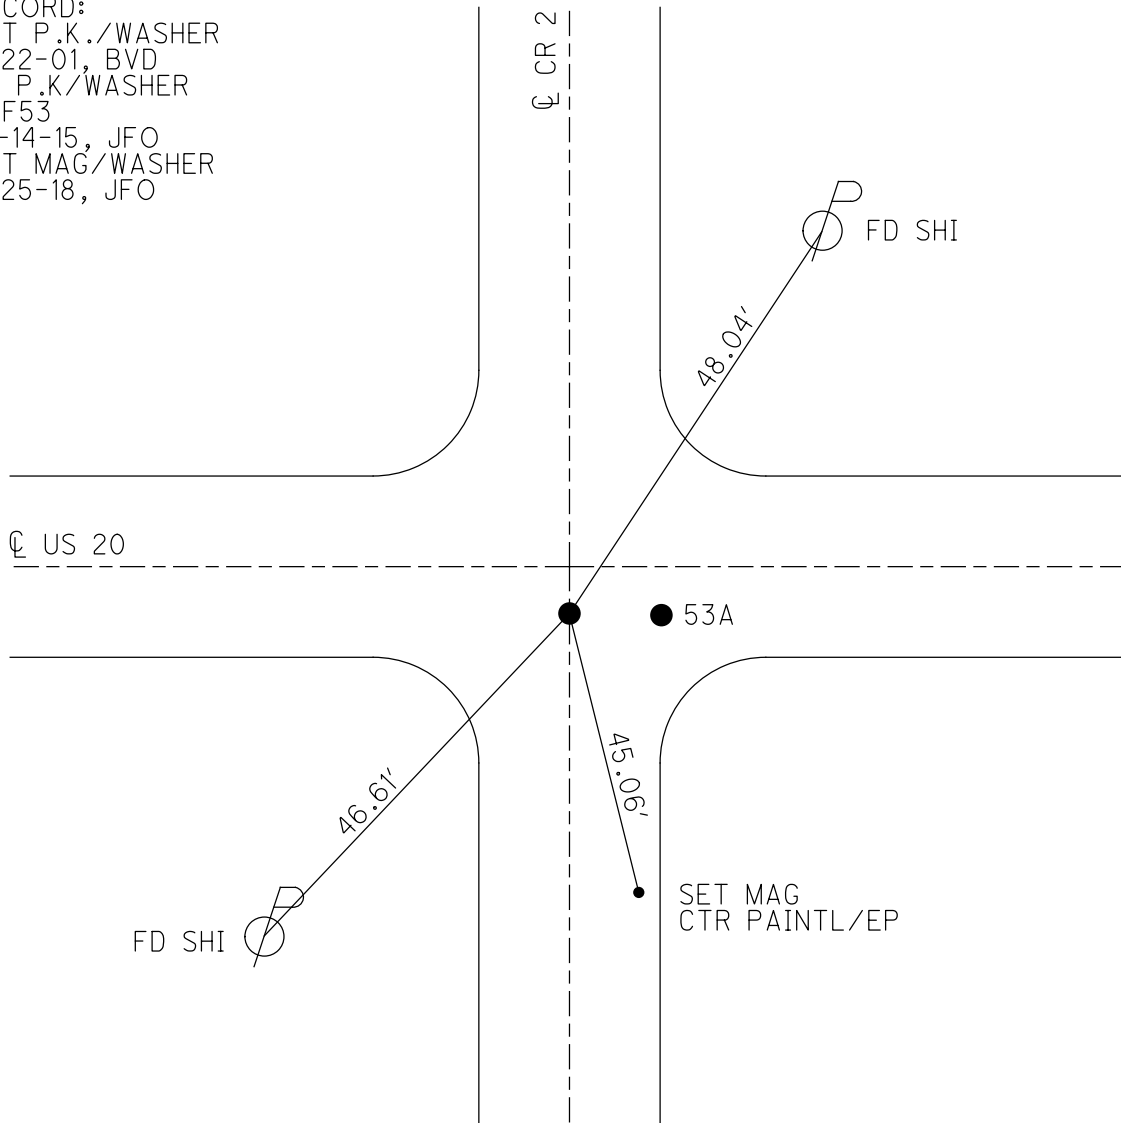

O.D.O.T. DISTRICT 2 SURVEY OFFICE

PERSONNEL _____

REFERENCE NO. 53

SHEET 23 OF 27

NOTES KARGER

DATE 7/25/00

ROUTE US 20

H.C. CORDES

WEATHER SUNNY

COUNTY FULTON

R.C. KARGER

TEMP. 76°

TOWNSHIP AMBOY

SECTION 23,24,25,26

T 9 S R 4 E

TYPE MONUMENT R.R. SPIKE

~~ON SURFACE~~ - BELOW 2"


~~LEFT~~ - C PAV'T - RIGHT 5.3'

TO EDGE PAVEMENT

S.L.M. 1429+34

Grid: Northing: _____ Easting: _____

23	24
26	25

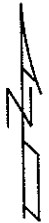

SET P.K./WASHER
6/22/01, BVD

CR 2

US 20

FD
N/SHI


49.66'

53 A

DISTANCE 53-53A=20.01'

46.63'

FD
N/SHI

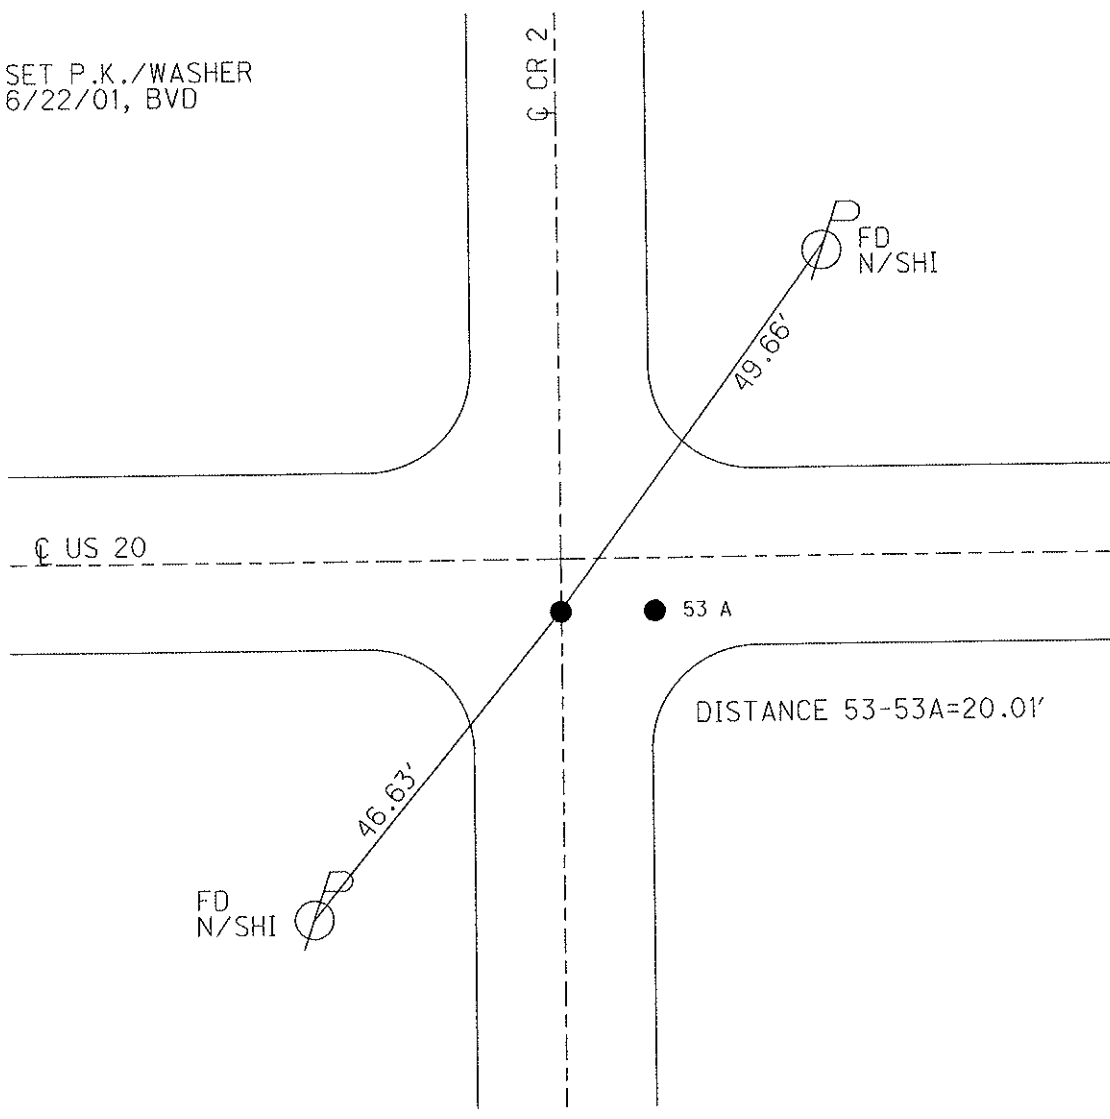

O.D.O.T. DISTRICT 2 SURVEY OFFICE

PERSONNEL

REFERENCE NO. 53

SHEET 24 OF 26

NOTES Karger

H.C. Cordes

R.C. Karger

DATE 7-25-00

WEATHER Sunny

TEMP. 76°F

ROUTE US 20

COUNTY FULTON

TOWNSHIP Amboy

SECTION 23-24-25-26

T 9 S R 4 E

TYPE MONUMENT RR Spk, (Shank)


~~ON SURFACE~~ - (BELOW) (A) 2" Deep (B) Surface

~~DEPTH~~ (RIGHT) (A) 5.3' Rt.

TO EDGE PAVEMENT

S.L.M. (A) 1429 + 34 (B) 1429 + 54

23	24
24	25

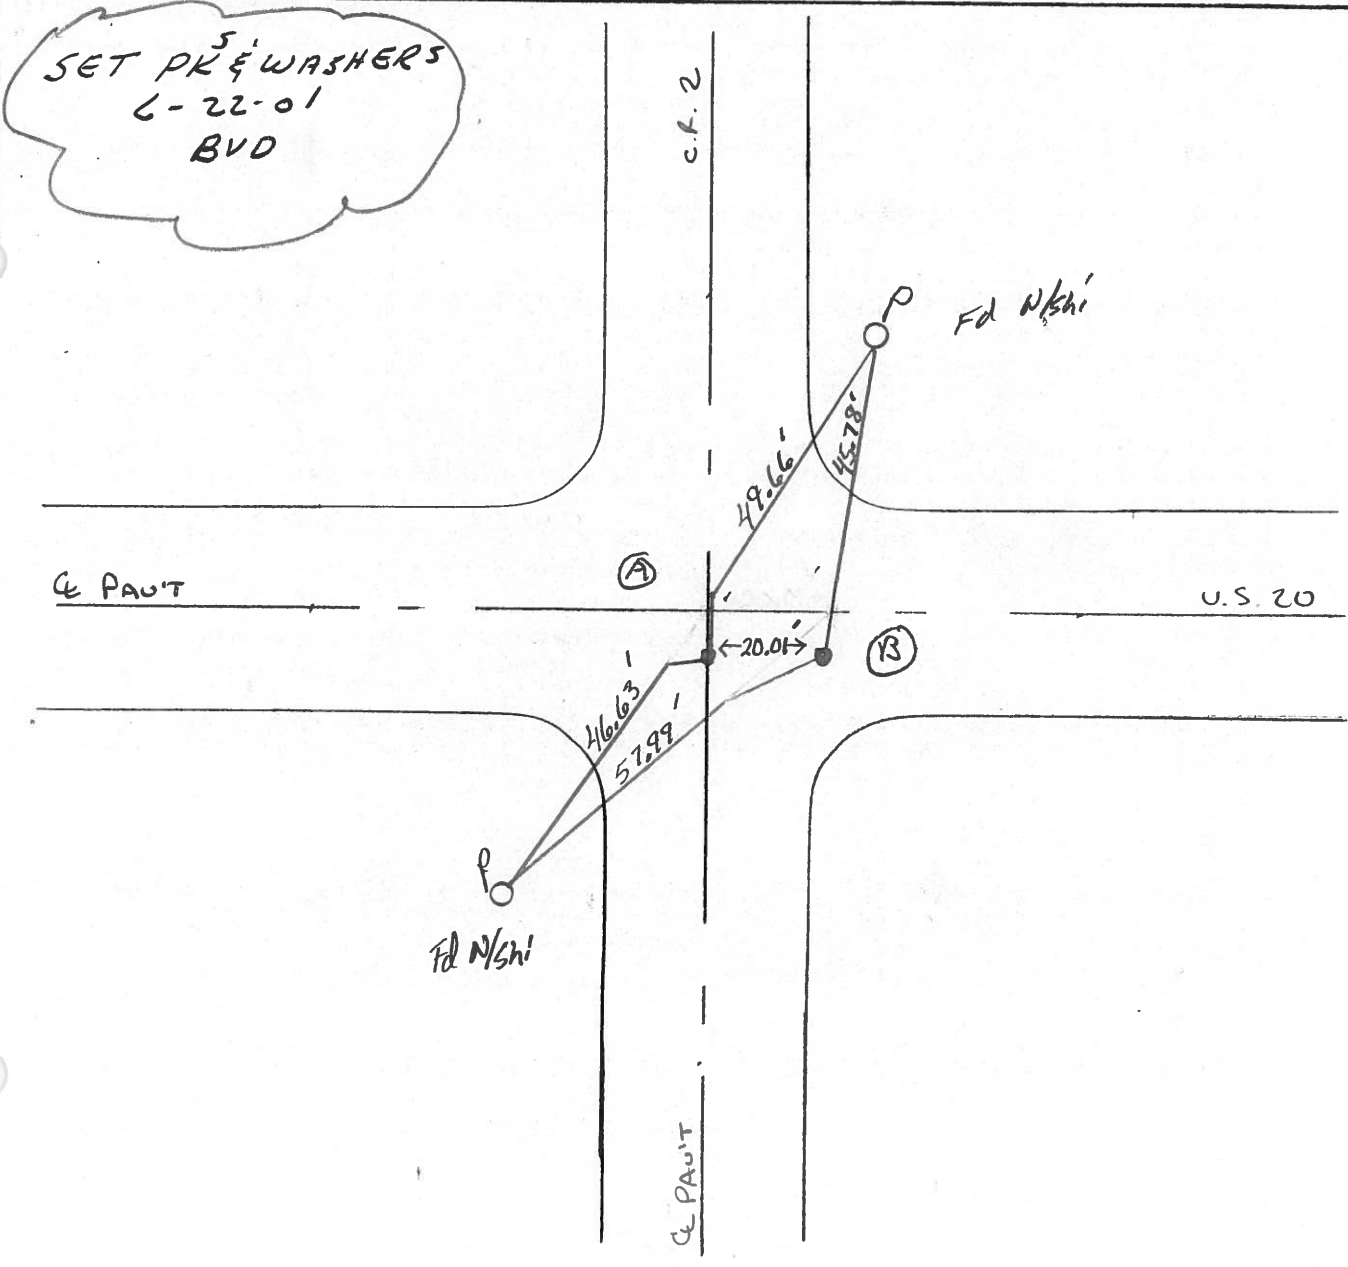

O.D.O.T. DISTRICT 2 SURVEY OFFICE

PERSONNEL

REFERENCE NO. 53

SHEET 23 OF

NOTES 1. Stone

H.C. D. Curtis

R.C. J. Haushalter

DATE 2 May 86

WEATHER Cool

TEMP. 44°

ROUTE US #20

COUNTY Fulton

TOWNSHIP Amboy

SECTION 23-24-25-26

T. R.

TYPE MONUMENT RR Spk.

ON SURFACE - BELOW 2" deep

LEFT - PAV'T. - RIGHT


TO EDGE PAVEMENT

S.L.M. 1427 + 79

23	24
26	25



OK 8/27/86 IRS

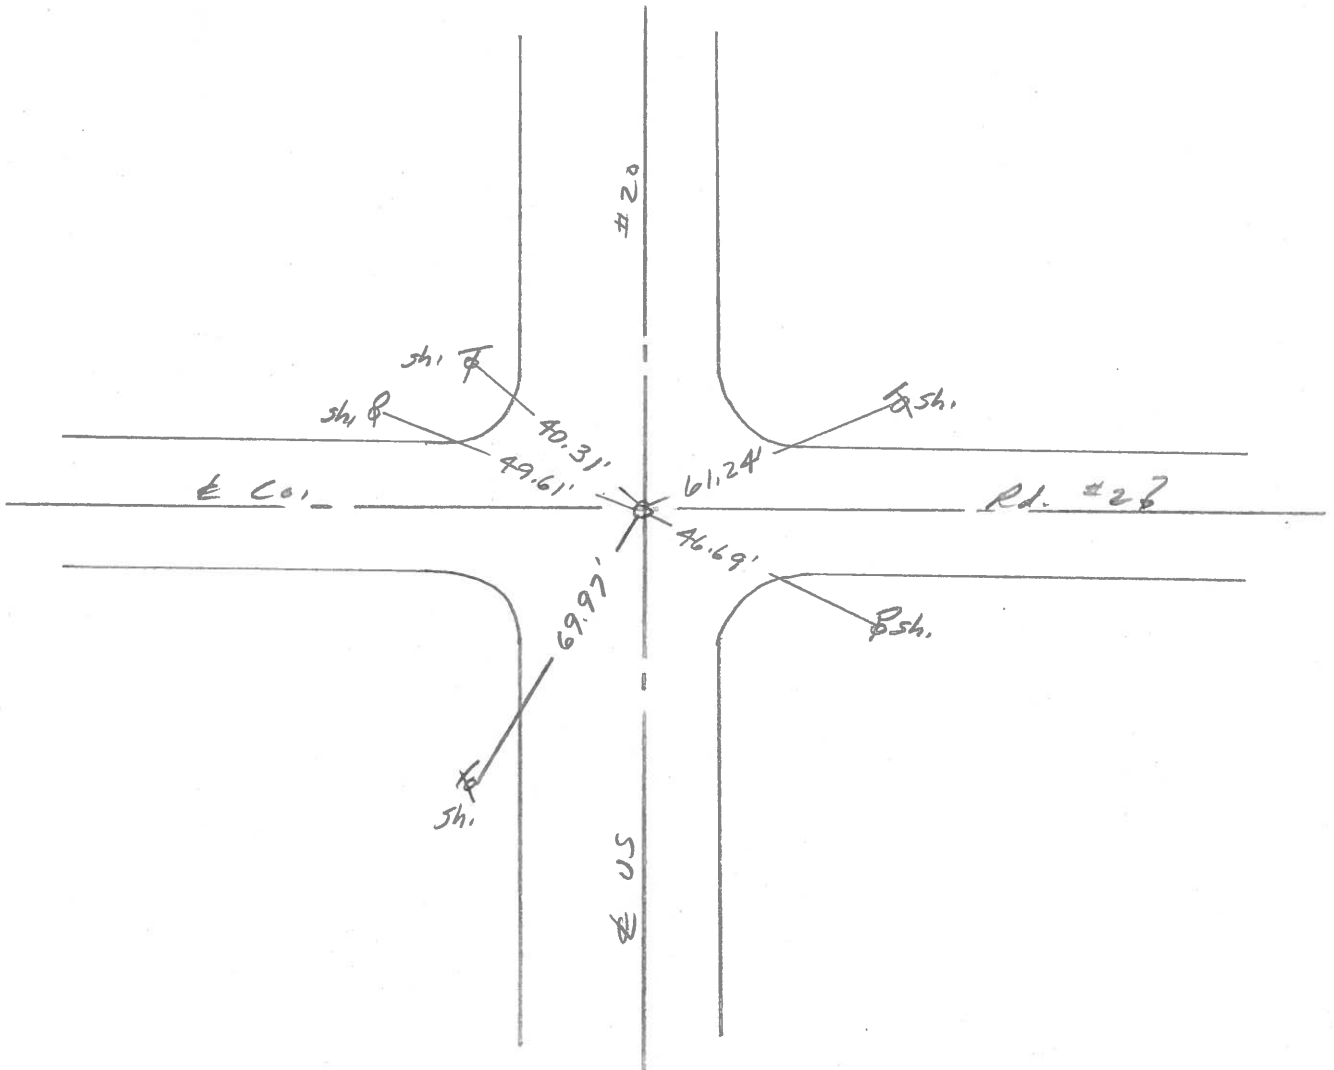

O.D.O.T. DISTRICT 2 SURVEY OFFICE

Sht. 24 of

County Fulton US # 20

Township Ambay

Section 23

T N, R E

Personnel L. Stone

R. Michalak

P. Neuse


D. Curtis

D. Granta

Date 14 May 1979


Weather Fair

Temp. 65°

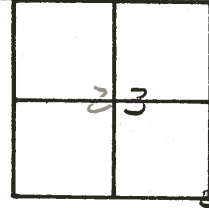

REF. NO. 53

SE Cor, Sec. 23

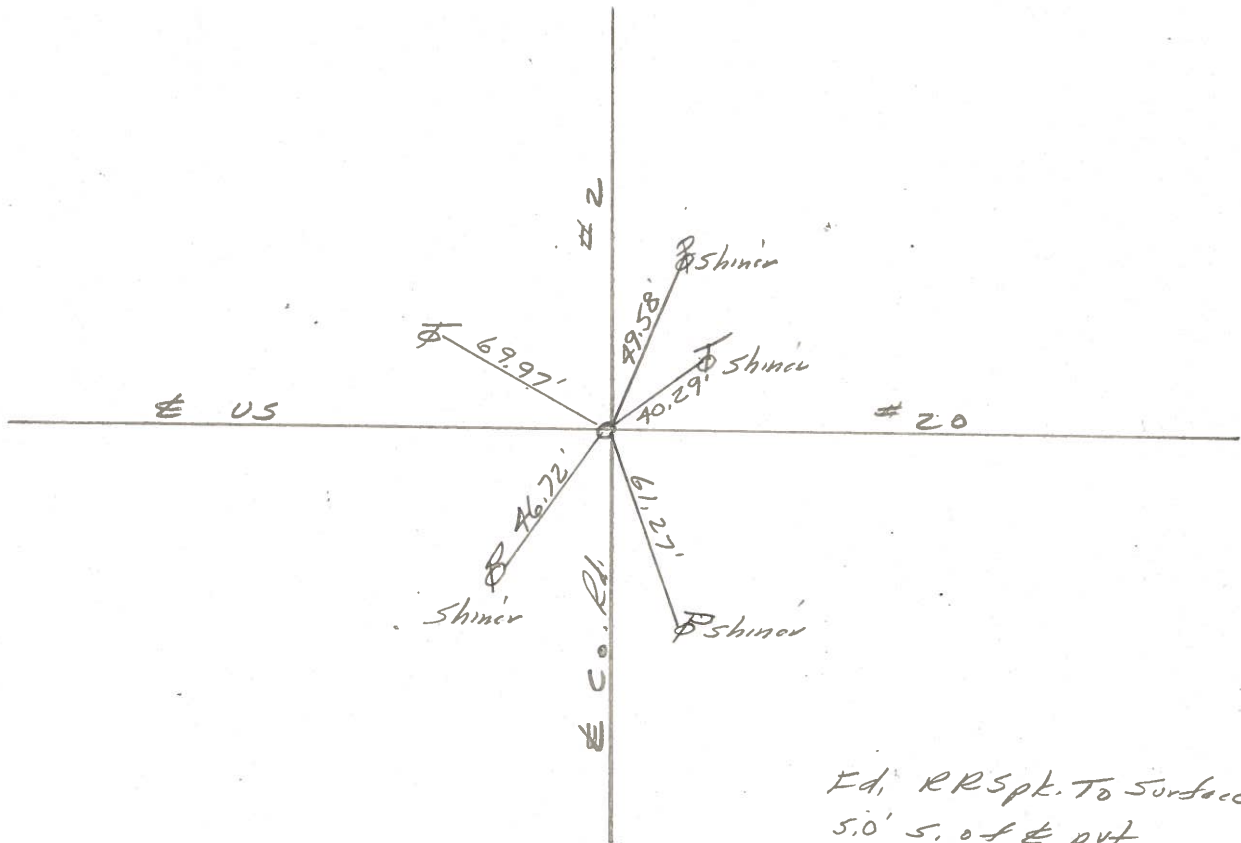

PERSONNEL TITLE PERSONNEL TITLE
 Tomasic _____
 Neuser _____
 Granata _____

COUNTY Fulton DATE MAR. 20, 1975
 S. R. U.S. 20 WEATHER _____
 SEC. AMBURY TWP. TEMP _____

DESCRIPTION LEFT CENTER LINE RIGHT JOB NO.

