

3-18-88
PB & GW

ODOT (D-2)

1988 TWO-LANE RESURFACING PROGRAM

PRIORITY NO. 10-A

PART 1 OF 1

SHEET 1 OF 3

COUNTY FULTON

ROUTE SR 2 DA (Oak Street) SECTION 0.11

BEGIN LOG (SLM) 0.11

TERMINII Jct Fulton St. (Butt)

END LOG (SLM) 0.51

TERMINII Jct SR 108 (Shoop) (Butt)

TOTAL LENGTH 0.40

MILES

MUNICIPALITY Wauseon

BEGIN LOG (SLM) 0.11 END LOG (SLM) 0.51

MUNICIPALITY _____

BEGIN LOG (SLM) _____ END LOG (SLM) _____

PROPOSED WORK:

PAVEMENT Mill existing Paved Surface SHOULDER _____

& Resurface with 1 1/2" 404

OTHER _____

EXISTING DATA:

SLM <u>0.11</u>	TO <u>0.51</u>	; PAV'T	WIDTH <u>20'</u>	(type <u>404</u>)	, SHLD	WIDTH _____	(type <u>Curb</u>)
SLM _____	TO _____	; PAV'T	WIDTH _____	(type _____)	, SHLD	WIDTH _____	(type _____)
SLM _____	TO _____	; PAV'T	WIDTH _____	(type _____)	, SHLD	WIDTH _____	(type _____)
STRUCTURES:

STR. NO. _____	, WIDTH _____	, LENGTH _____	, PROP. WORK _____
STR. NO. _____	, WIDTH _____	, LENGTH _____	, PROP. WORK _____
RAILROAD CROSSING:

NAME _____	STATION _____	NO. TRACKS _____	LENGTH ALONG C L _____	(no work)
NAME _____	STATION _____	NO. TRACKS _____	LENGTH ALONG C L _____	ft
NAME _____	STATION _____	NO. TRACKS _____	LENGTH ALONG C L _____	ft

MISCELLANEOUS:

NO. RAISED PAVEMENT MARKERS; EDGE OF PAVEMENT _____, CENTERLINE _____


NO. MAILBOX APPROACHES _____, AVERAGE AREA _____

REMARKS:

COUNTY Fulton

ROUTE SR 2 DA (Oak St.) SECTION 0.11

[illegible]

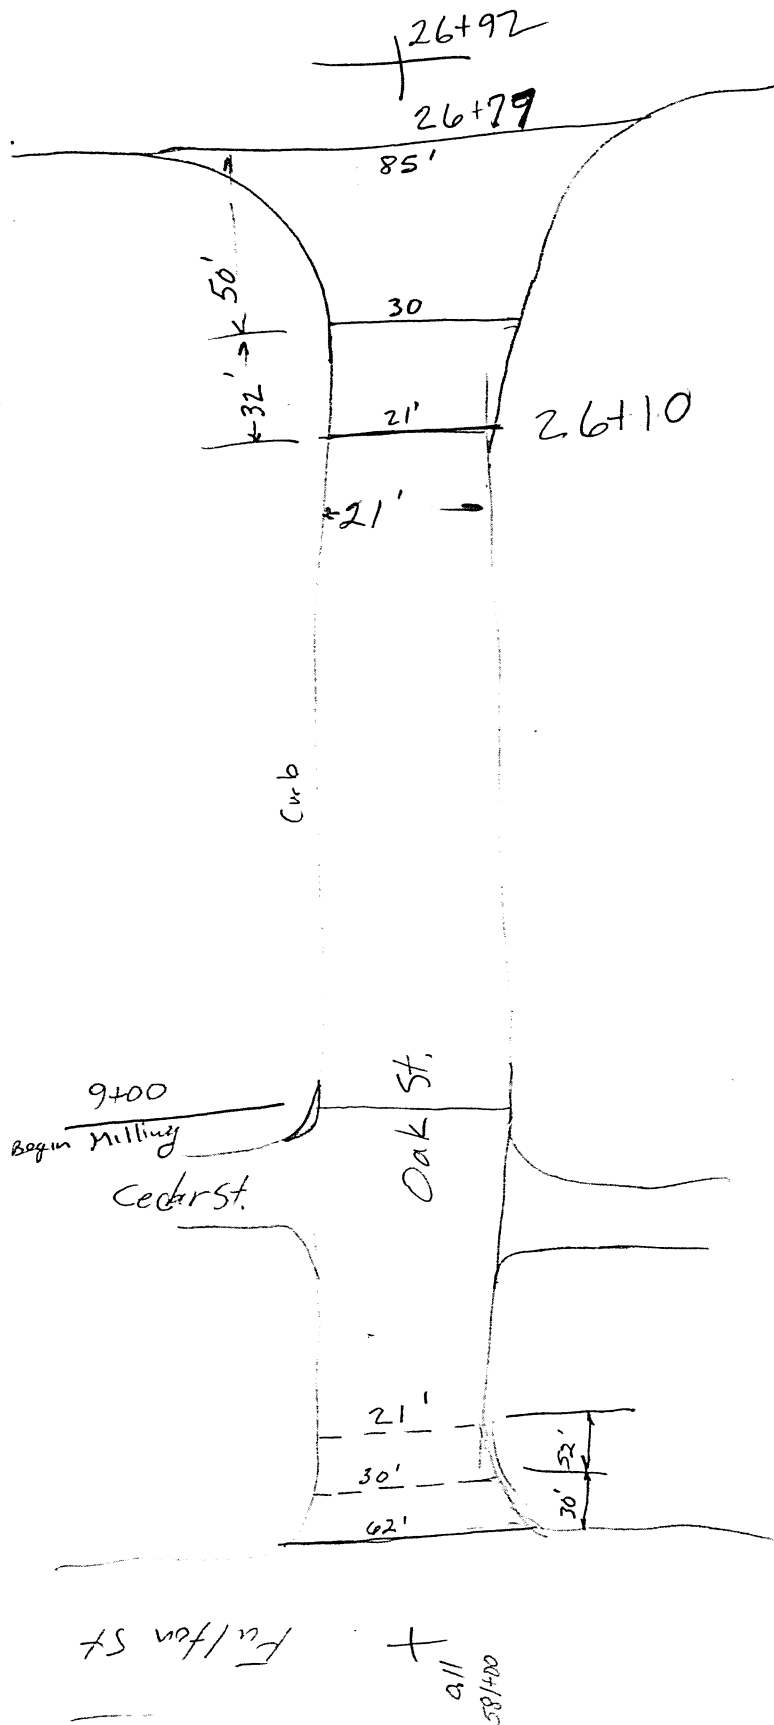

ROUTE SR 2DA (Oak St.) SECTION 0.11

R = Raise F = Feather

[illegible]