


PERSONNEL	TITLE	PERSONNEL	TITLE	COUNTY	DATE
Deputy		Parish		Fulmer	
Inspector				S. R. 40. A	WEATHER Full
Patrolman				SEC. 100.000	TEMP. 46°
Recorder					

DESCRIPTION *Highway* *SR 64* *SR 64* *SR 64* JOB NO.

LEFT CENTER LINE RIGHT

27+10.97

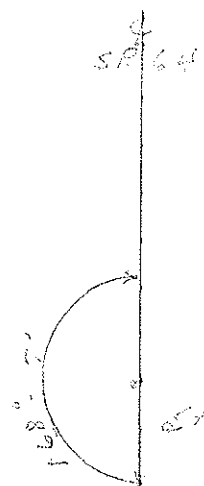


Iron Pin Intersection  
St Clair St & SR 64 Main St

27+26.54




Iron Pin  
Intersection Garfield St  
& S.R. 64 Main St

27+93.05

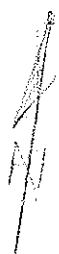

Iron Pin 2" Below Surface

20+65.70

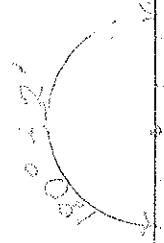

Iron Pipe on S.R. 64 Main St

13+20.00  
(S.L.M. Sta.)

S.R. 20. A Brass NAIL

