


PERSONNEL	TITLE	PERSONNEL	TITLE	COUNTY	DATE
Stone				Fulton	21 March 73
Michalak				#64	WEATHER Cool
Danno				SEC. SWANTON	TEMP. 38°
Curtis					

DESCRIPTION: References to Control Points JOB NO. _____

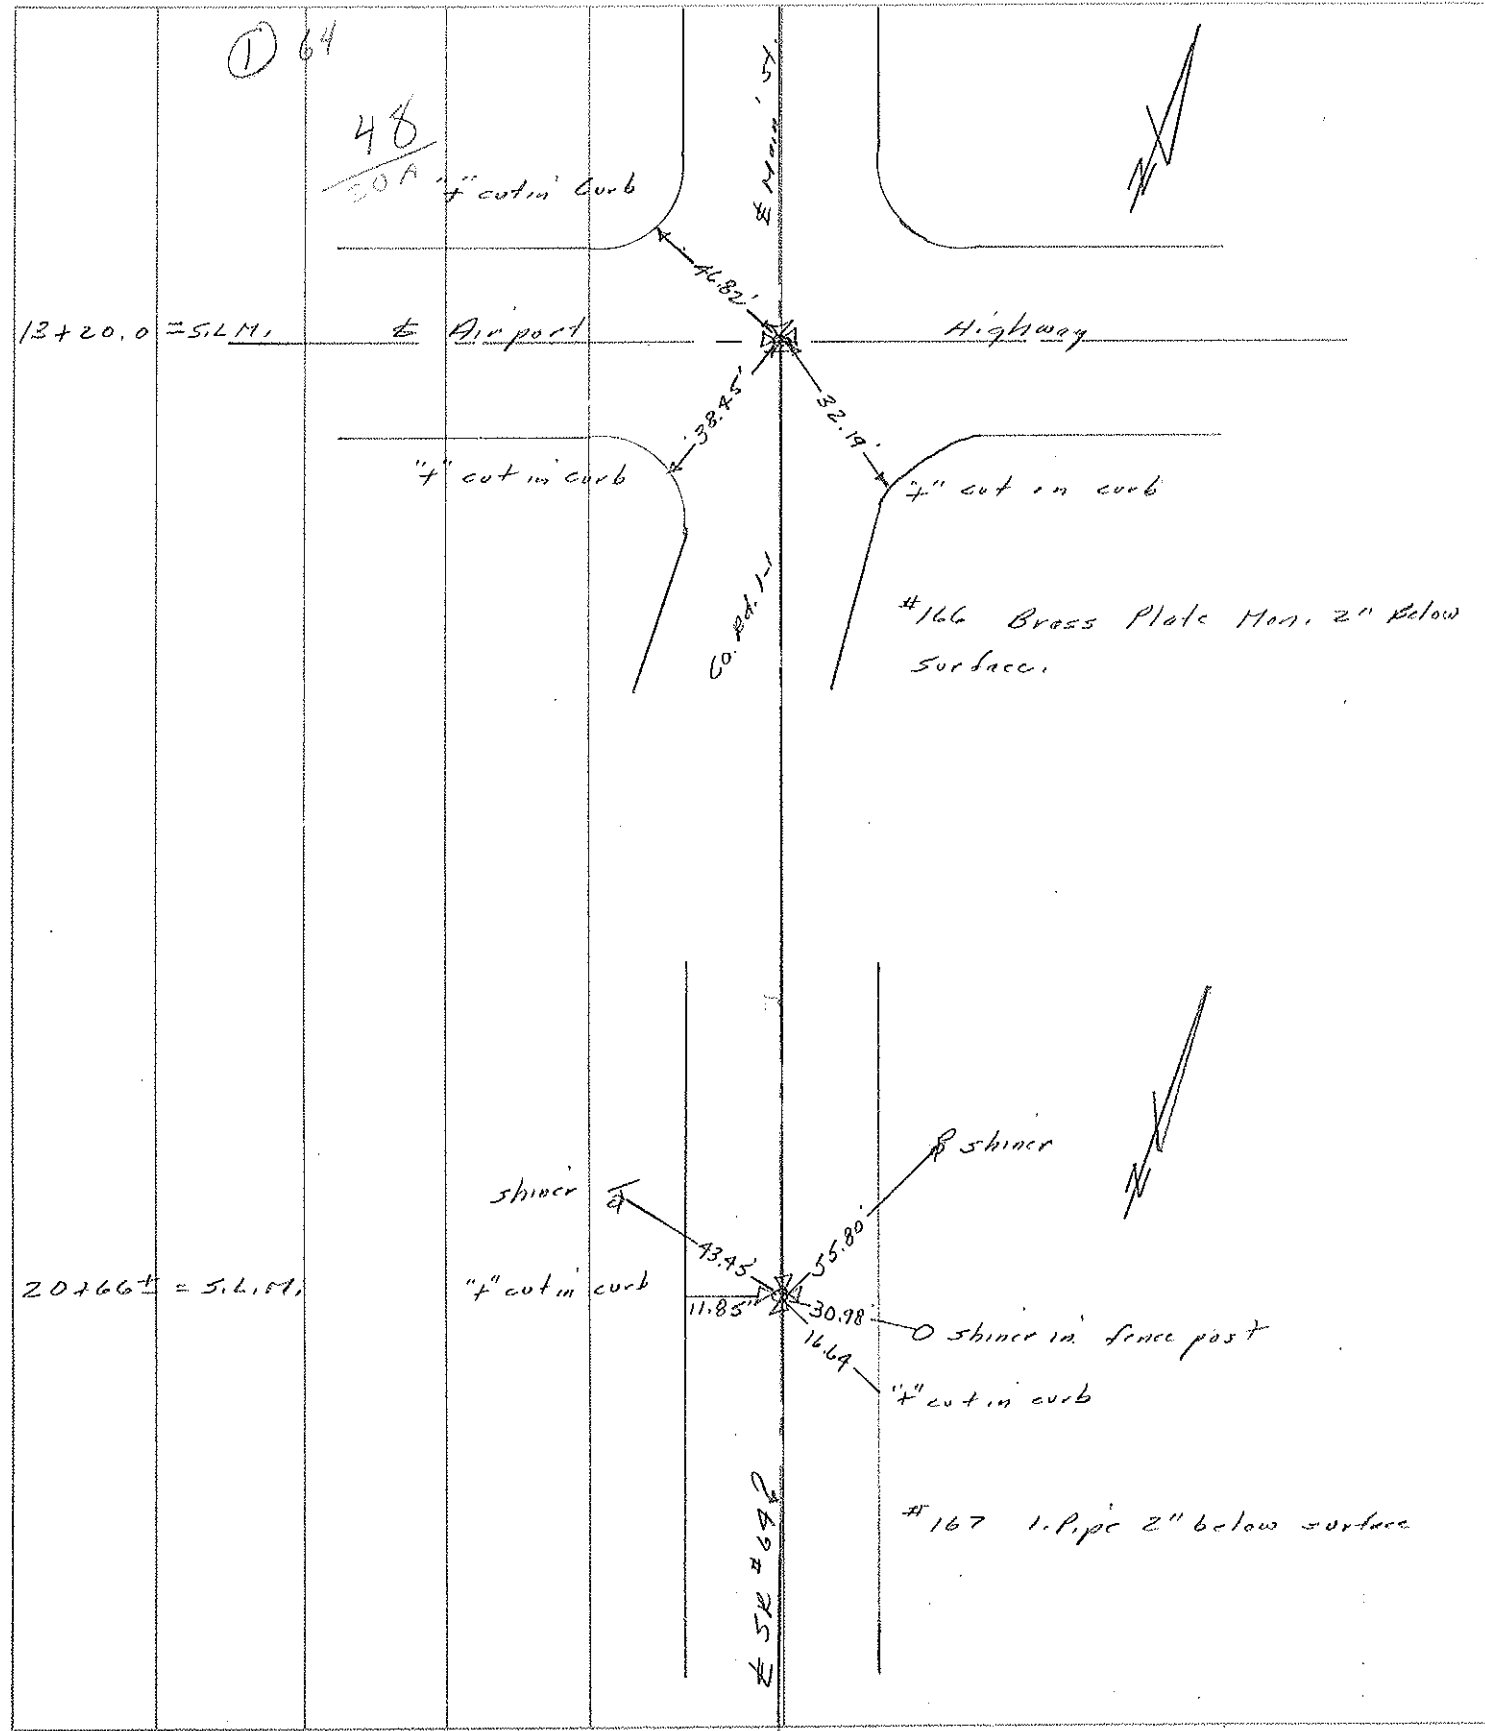


PERSONNEL	TITLE	PERSONNEL	TITLE	COUNTY	DATE
Deputy		Parish		Fulton	
Inspector				S. R. 40th	WEATHER Full
Patrolman				SEC. 1000000	TEMP. 46°
Recorder					

DESCRIPTION *Plumbing* *Plumbing* *Plumbing* JOB NO.


LEFT CENTER LINE RIGHT

27+10.97

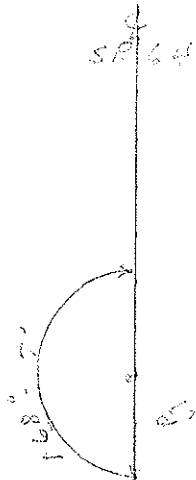

Iron Pipe Intersection
St Clair St & SR 64 Main St

27+26.5

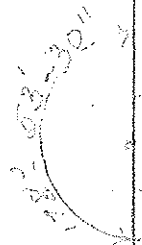


Iron Pipe
Intersection Garfield St
& S.R. 64 Main St


27+93.05



Iron Pipe 3" Below Surface

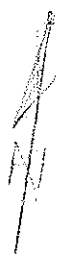

20+65.70

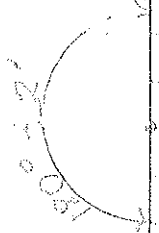

Iron Pipe on S.R. 64 Main St



13+20.00
(S.L.M. Sta.)

S.R. 20th Brass Nona

PERSONNEL	TITLE	PERSONNEL	TITLE	COUNTY	DATE	WEATHER	TEMP.
Denno				Fulton	June 3, 1966	Cloudy	70°
Granata				S. R. 64			
Curtis				SEC.			
Omey							

DESCRIPTION Monument References S.R. 64 Swanton JOB NO. _____

