


O.D.O.T. DISTRICT 2 SURVEY OFFICE (USE ONLY)

PERSONNEL _____ REFERENCE NO. 11 SHEET 11 OF 22


NOTES CANTERBURY DATE 8-13-03 ROUTE SR 64
 H.C. NUHFER WEATHER FAIR COUNTY FULTON
 R.C. BRUMBAUGH TEMP. 78° TOWNSHIP FULTON
 _____ SECTION 1
 _____ T 7 N R 8 E

TYPE MONUMENT MONBOX
 ON SURFACE - ~~BELOW~~ ON _____
 LEFT - ☉ PAV'T - RIGHT ON _____
 _____ TO _____ EDGE PAVEMENT
 S.L.M. 51+64

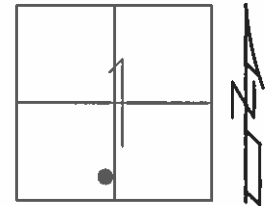

GRID: NOTHING: 703973.282 EASTING: 1587690.216

RECORD:
 FD STONE W/"X" CUT
 24" DOWN
 7/18/88
 FD MONBOX
 9/23/03, MRC
 FD MONBOX W/STRATS
 REF11
 7/26/16, JFO

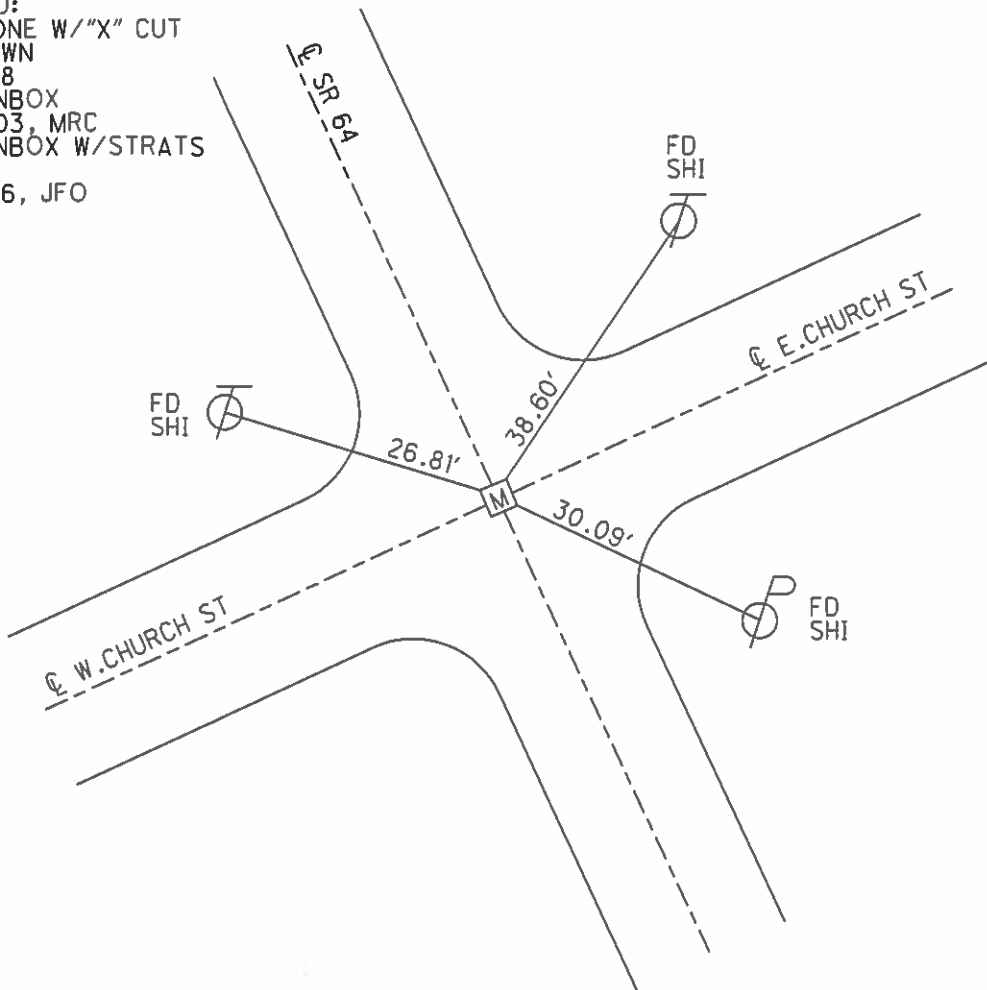

O.D.O.T. DISTRICT 2 SURVEY OFFICE

PERSONNEL

REFERENCE NO. 1- I

SHEET 9 OF 18

NOTES CANTERBURY

H.C. NUHFER

R.C. BRUMBAUGH

DATE 8-13-03

WEATHER FAIR

TEMP. +78°

ROUTE SR 64

COUNTY FULTON

TOWNSHIP FULTON

SECTION 1

T 7 N R 8 E

TYPE MONUMENT Mon. Box


ON SURFACE - BELOW SURFACE

LEFT- & PAV'T. - RIGHT & BOTH

TO EDGE PAVEMENT

S.L.M. 51+64



SWANTON	
CORP	

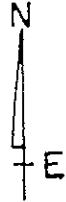

NOTE:

Fpd. STONE WITH DEEP
 + CUT IN 17" 29" DEEP 7-18-88
 USED CTR. OF 12" L10.

ROUND MON BOX
 9-23-03
 M.R.C.

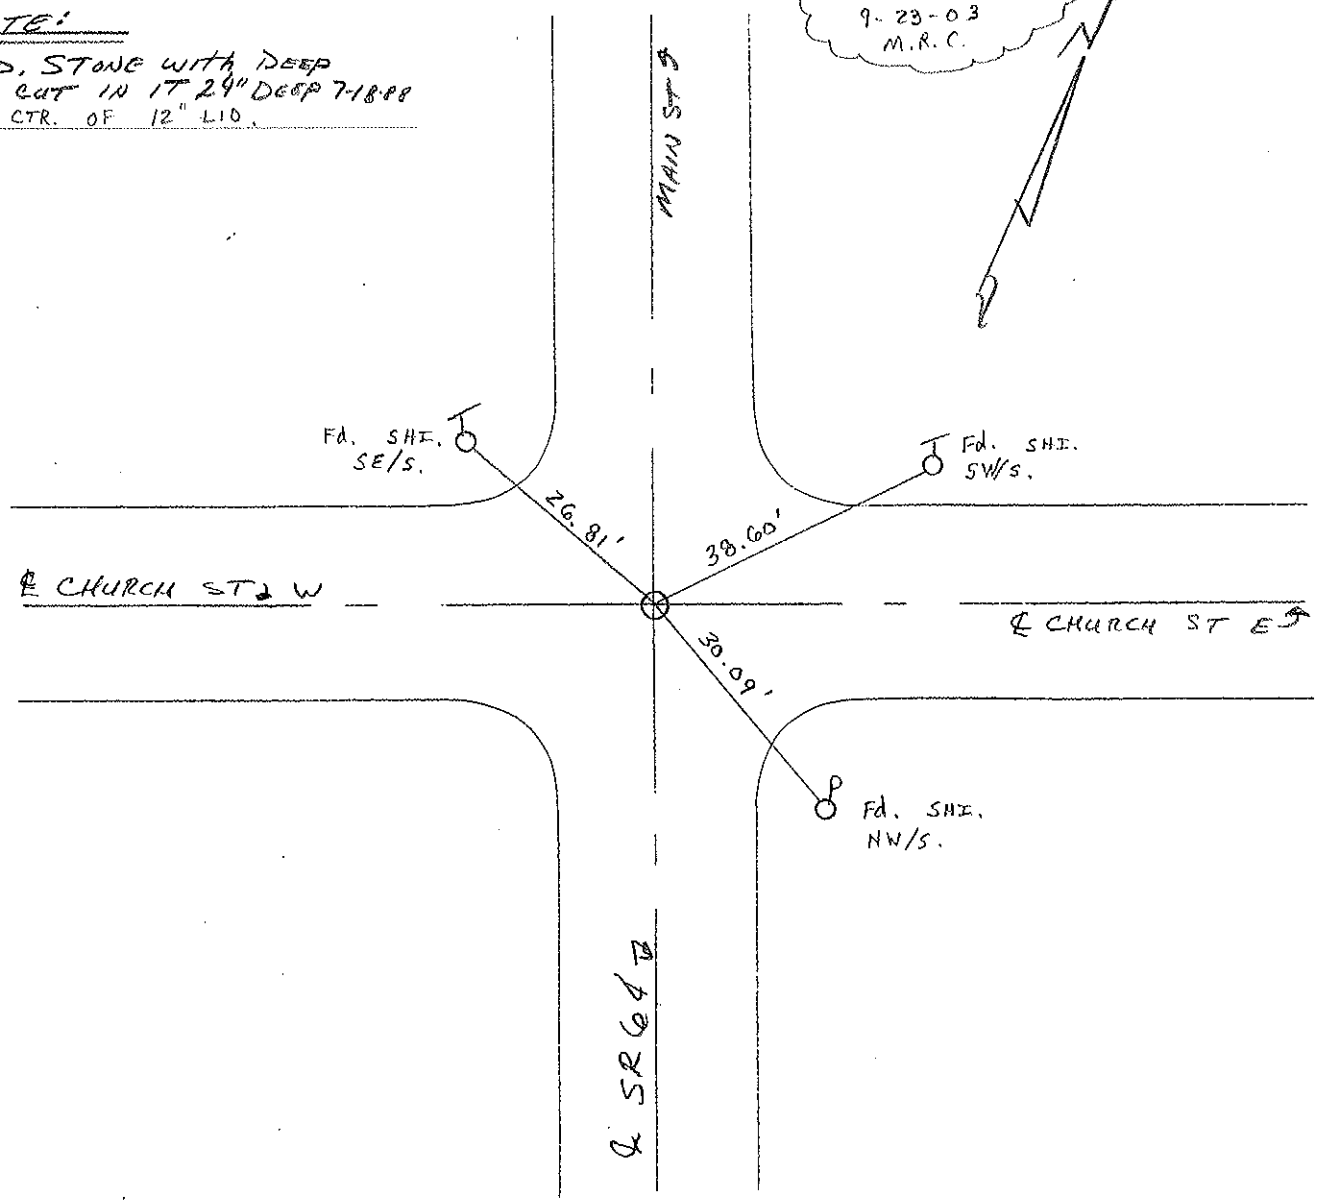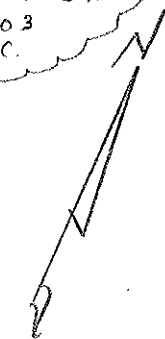

O.D.O.T. DISTRICT 2 SURVEY OFFICE

PERSONNEL _____

REFERENCE NO. 11

SHEET 7 OF 16

NOTES 1. Stone

H.C. D. Curtis

R.G. J. Householder

DATE 1 April 88

WEATHER Cloudy

TEMP. 50°

ROUTE SR #64

COUNTY Fulton

TOWNSHIP Fulton

SECTION _____

T _____ R _____

TYPE MONUMENT Man. Box


ON SURFACE - BELOW Surface

LEFT - & PAV'T. - RIGHT _____

_____ TO _____ EDGE PAVEMENT

S.L.M. 51+64

SW	ANTON
CO	OP

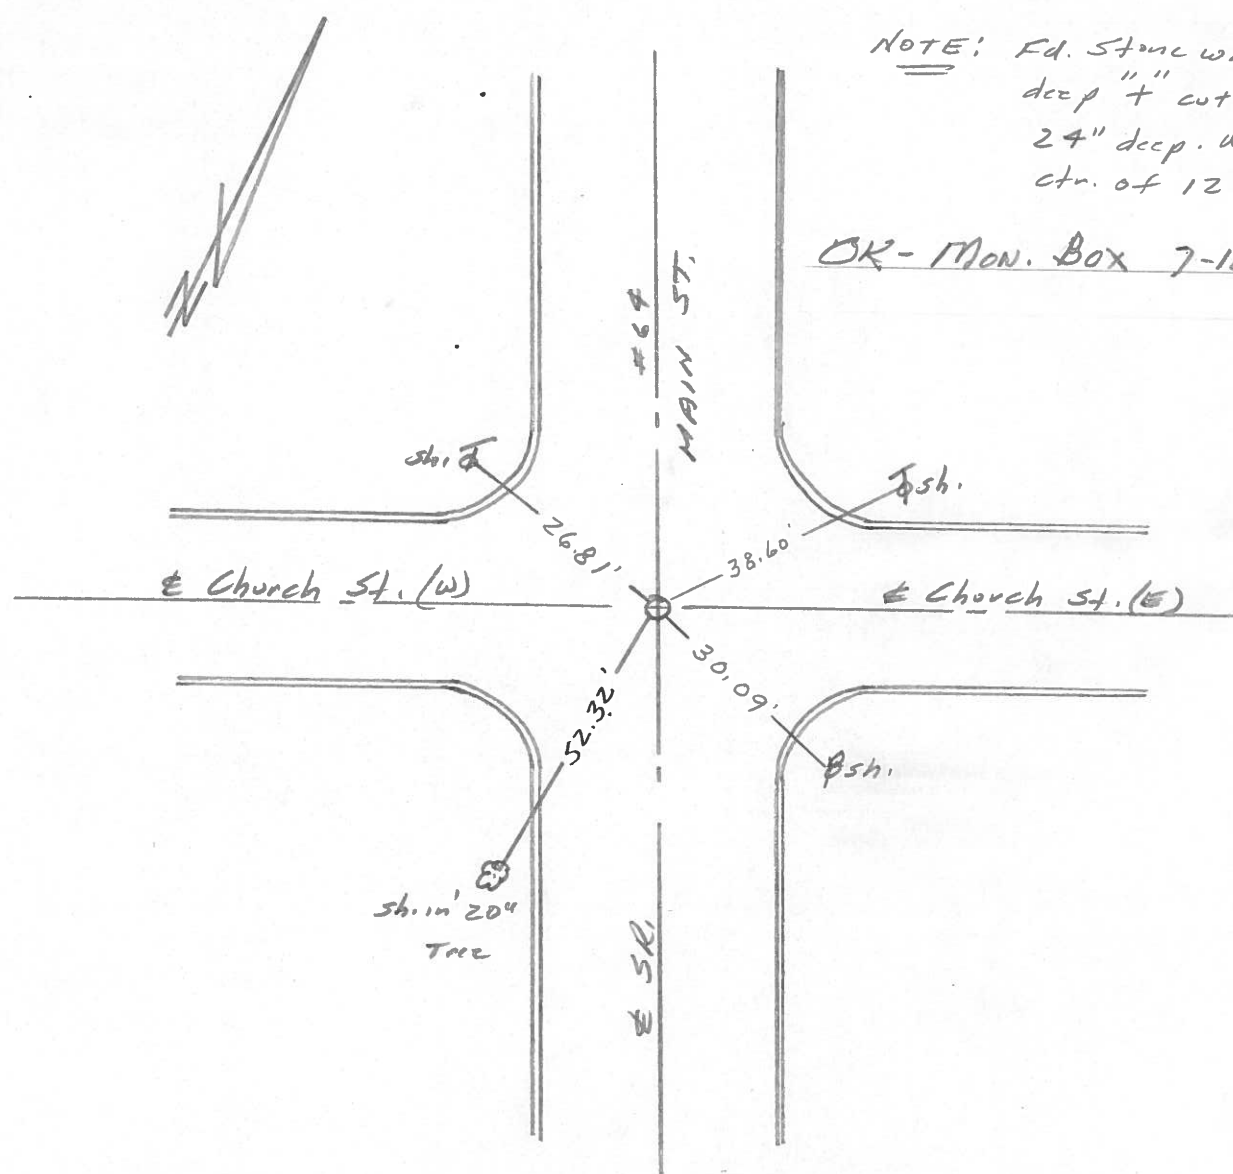


NOTE: Ed. Stone with deep "t" cut in it 24" deep. We used ctr. of 12" lid

OK - Mon. Box 7-18-88

PERSONNEL	TITLE	PERSONNEL	TITLE	COUNTY	DATE
<u>S. Jone</u>				<u>Fulton</u>	<u>22 March 73</u>
<u>Michalak</u>				S. R. <u>#64</u>	WEATHER <u>Co.</u>
<u>Danno</u>				SEC. <u>Sweaton</u>	TEMP. <u>330</u>
<u>Curtis</u>					

DESCRIPTION References to Control Points JOB NO. _____

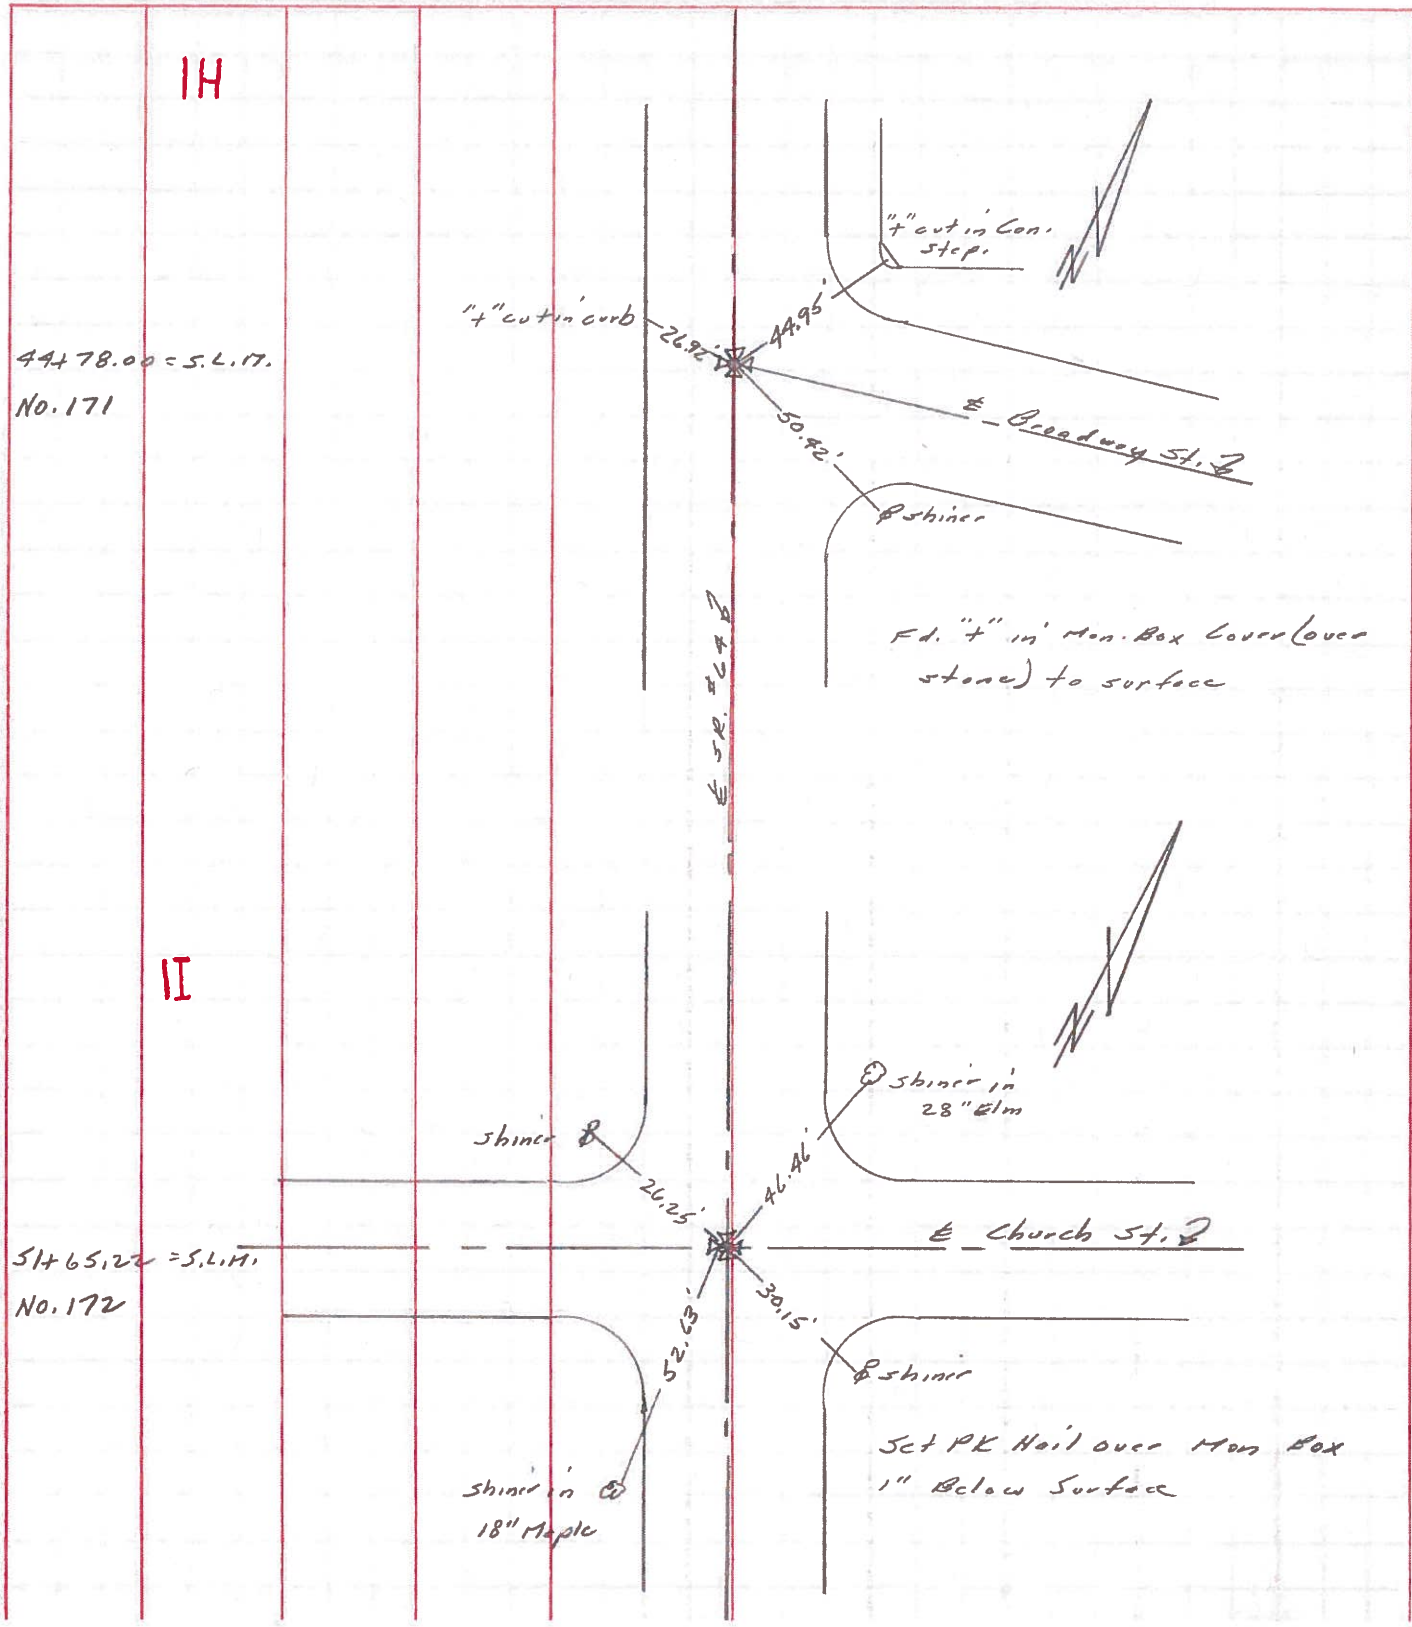

PERSONNEL	TITLE	PERSONNEL	TITLE	COUNTY	DATE	WEATHER	TEMP.
Denna				Fulton	June 3, 1966	Sunny	75°
Curtis				S. R. G4			
Granata				SEC.			
Oney							

DESCRIPTION Monument Ref. SR. G4 Swanton JOB NO. _____

