


**O.D.O.T. DISTRICT 2 SURVEY OFFICE (USE ONLY)**


PERSONNEL	REFERENCE NO.	<u>1 N</u>	SHEET	<u>17</u>	OF	<u>22</u>	
NOTES	<u>RHOADES</u>	DATE	<u>7-26-16</u>	ROUTE	<u>SR 64</u>		
H.C.	<u>O' DONNELL</u>	WEATHER	<u>SUNNY</u>	COUNTY	<u>FULTON</u>		
R.C.	<u>KEFFER</u>	TEMP.	<u>84°</u>	TOWNSHIP	<u>FULTON</u>		
				SECTION	<u>1</u>		
				T	<u>7 N</u>	R	<u>8 E</u>

TYPE MONUMENT MAG/WASHER  
 ON SURFACE - ~~BELOW~~ ON  
 LEFT - ☉ PAV'T - RIGHT ON  
- TO - EDGE PAVEMENT  
 S.L.M. 74+70

GRID: NOTHING: 705997.719 EASTING: 1586594.439

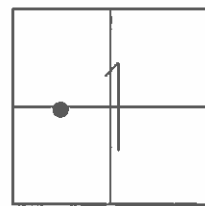

RECORD:  
 FD P.K.NAIL  
 8/13/03, MC  
 SET MAG/WASHER  
 9/23/03, MC  
 FD MAG/WASHER  
 REFN1  
 7/26/16, JFO  
 SET MAG/WASHER  
 NEWREFN1  
 11/15/16, JFO

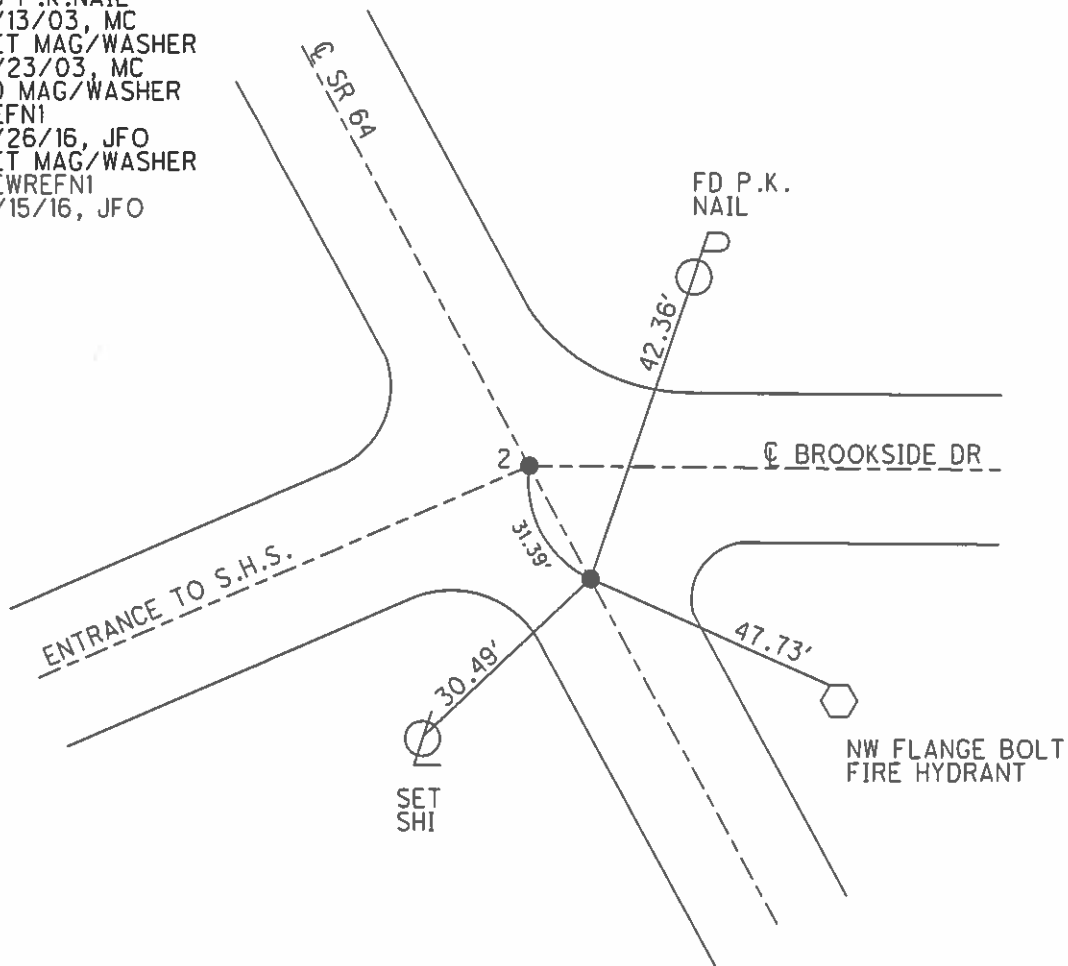

# O.D.O.T. DISTRICT 2 SURVEY OFFICE

PERSONNEL \_\_\_\_\_

REFERENCE NO. 2

SHEET 14 OF 18

NOTES CANTERBURY

H.C. NUMBER

R.C. BRUMBAUGH

DATE 8-13-03

WEATHER FAIR

TEMP. +78°

ROUTE SR 64

COUNTY Fulton

TOWNSHIP Fulton

SECTION 1

T 2 N 8 E


TYPE MONUMENT A-PK NAIL / B-PK NAIL  
 ON SURFACE - BELOW A-SURFACE / B SURFACE  
 LEFT - ☉ PAV'T. - RIGHT ON ♀  
TO EDGE PAVEMENT  
 S.L.M. A=74+70 B=75+01

Swanton	
CORP	



NOTE: POINT "B" WAS GONE, WE WERE ABLE TO RESET USING OLD TIES. M.C. 2003

RESET MAG/WASHER  
 @ BOTH  
 9-23-03  
 M.C.

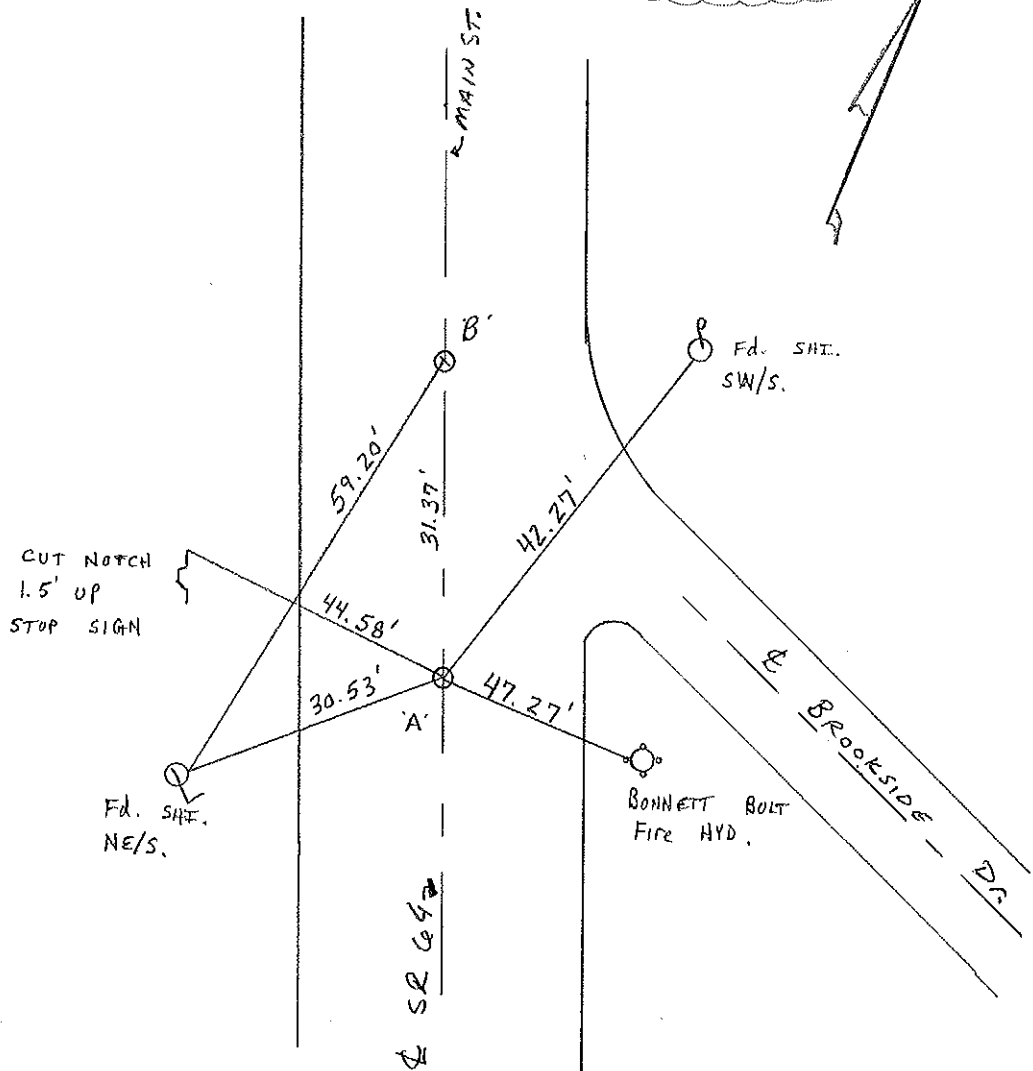

# O.D.O.T. DISTRICT 2 SURVEY OFFICE

PERSONNEL

REFERENCE NO. 2

SHEET 12 OF 16

NOTES 1. Stone

H.C. D. Cuntis

R.C. J. Hauscholder

DATE 6 April 88

WEATHER Cloudy

TEMP. 600

ROUTE SR #64

COUNTY Fulton

TOWNSHIP Fulton

SECTION \_\_\_\_\_

T \_\_\_\_\_ R \_\_\_\_\_

TYPE MONUMENT "A" = PK Nail  
"B" = PK Nail


ON SURFACE - BELOW Surface

LEFT - & PAV'T. - RIGHT \_\_\_\_\_

\_\_\_\_\_ TO \_\_\_\_\_ EDGE PAVEMENT

S.L.M. "A" = 74+70 "B" = 75+01


SW	NTON
CORP	

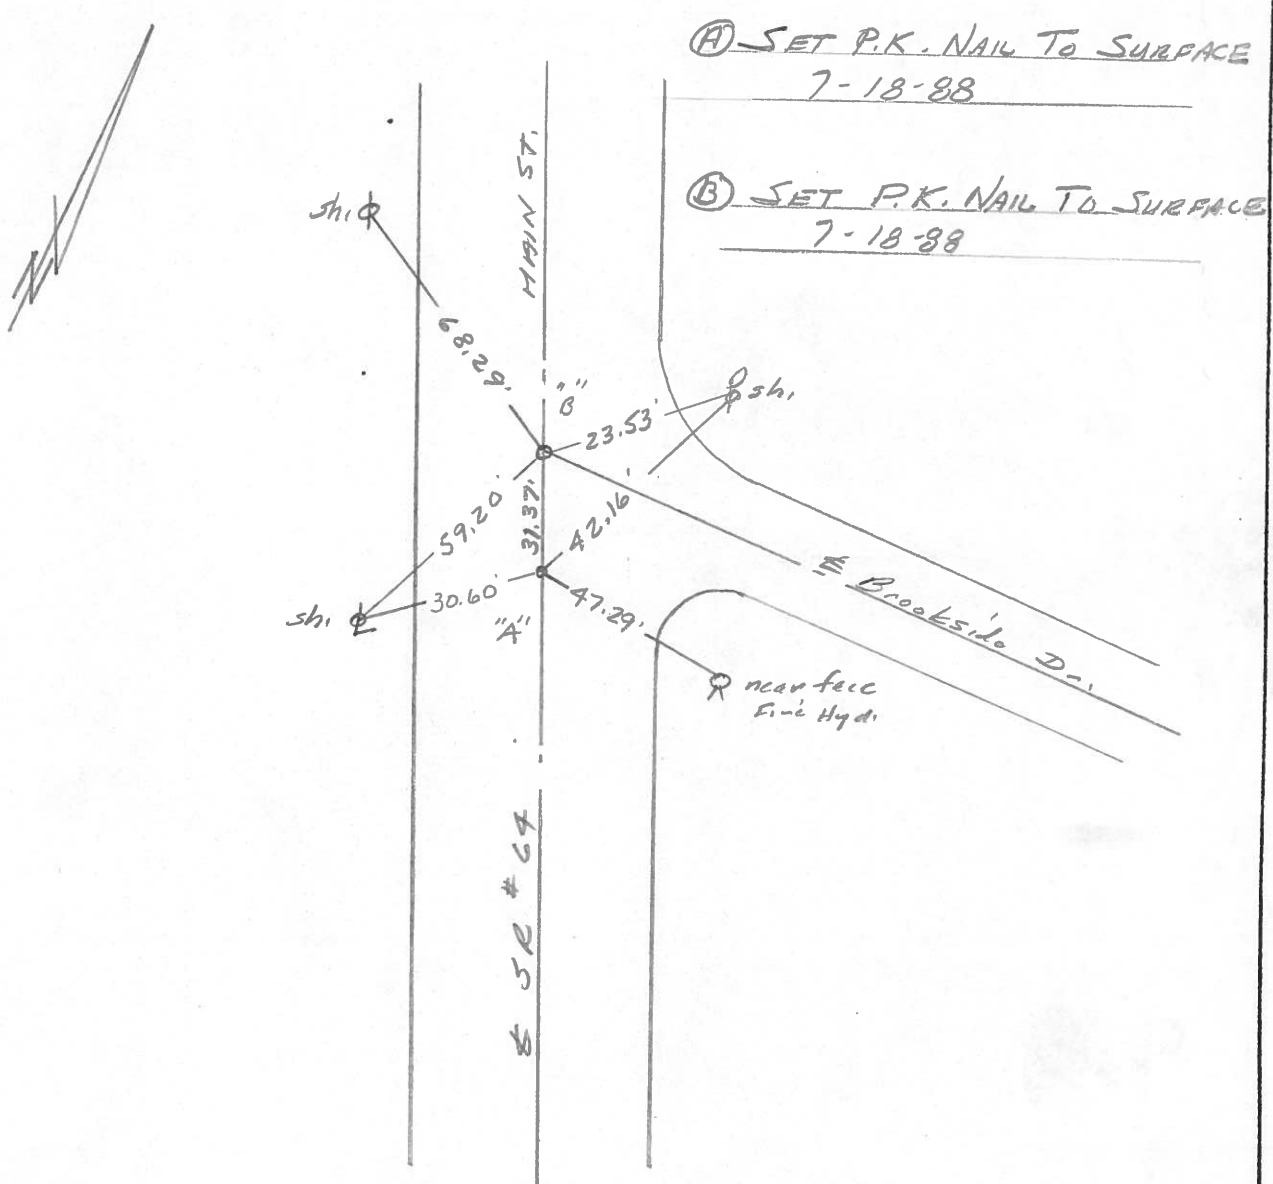

# S.R. 64 FULTON

PERSONNEL	TITLE	PERSONNEL	TITLE	COUNTY	DATE	WEATHER	TEMP.
Tomsic		Granata		Fulton	Aug. 6-73		
Vanzo				S. R. 64			
Neuber				SEC. FULTON TWP			
Boyle							

DESCRIPTION	LEFT	CENTER LINE	RIGHT	JOB NO.
-------------	------	-------------	-------	---------

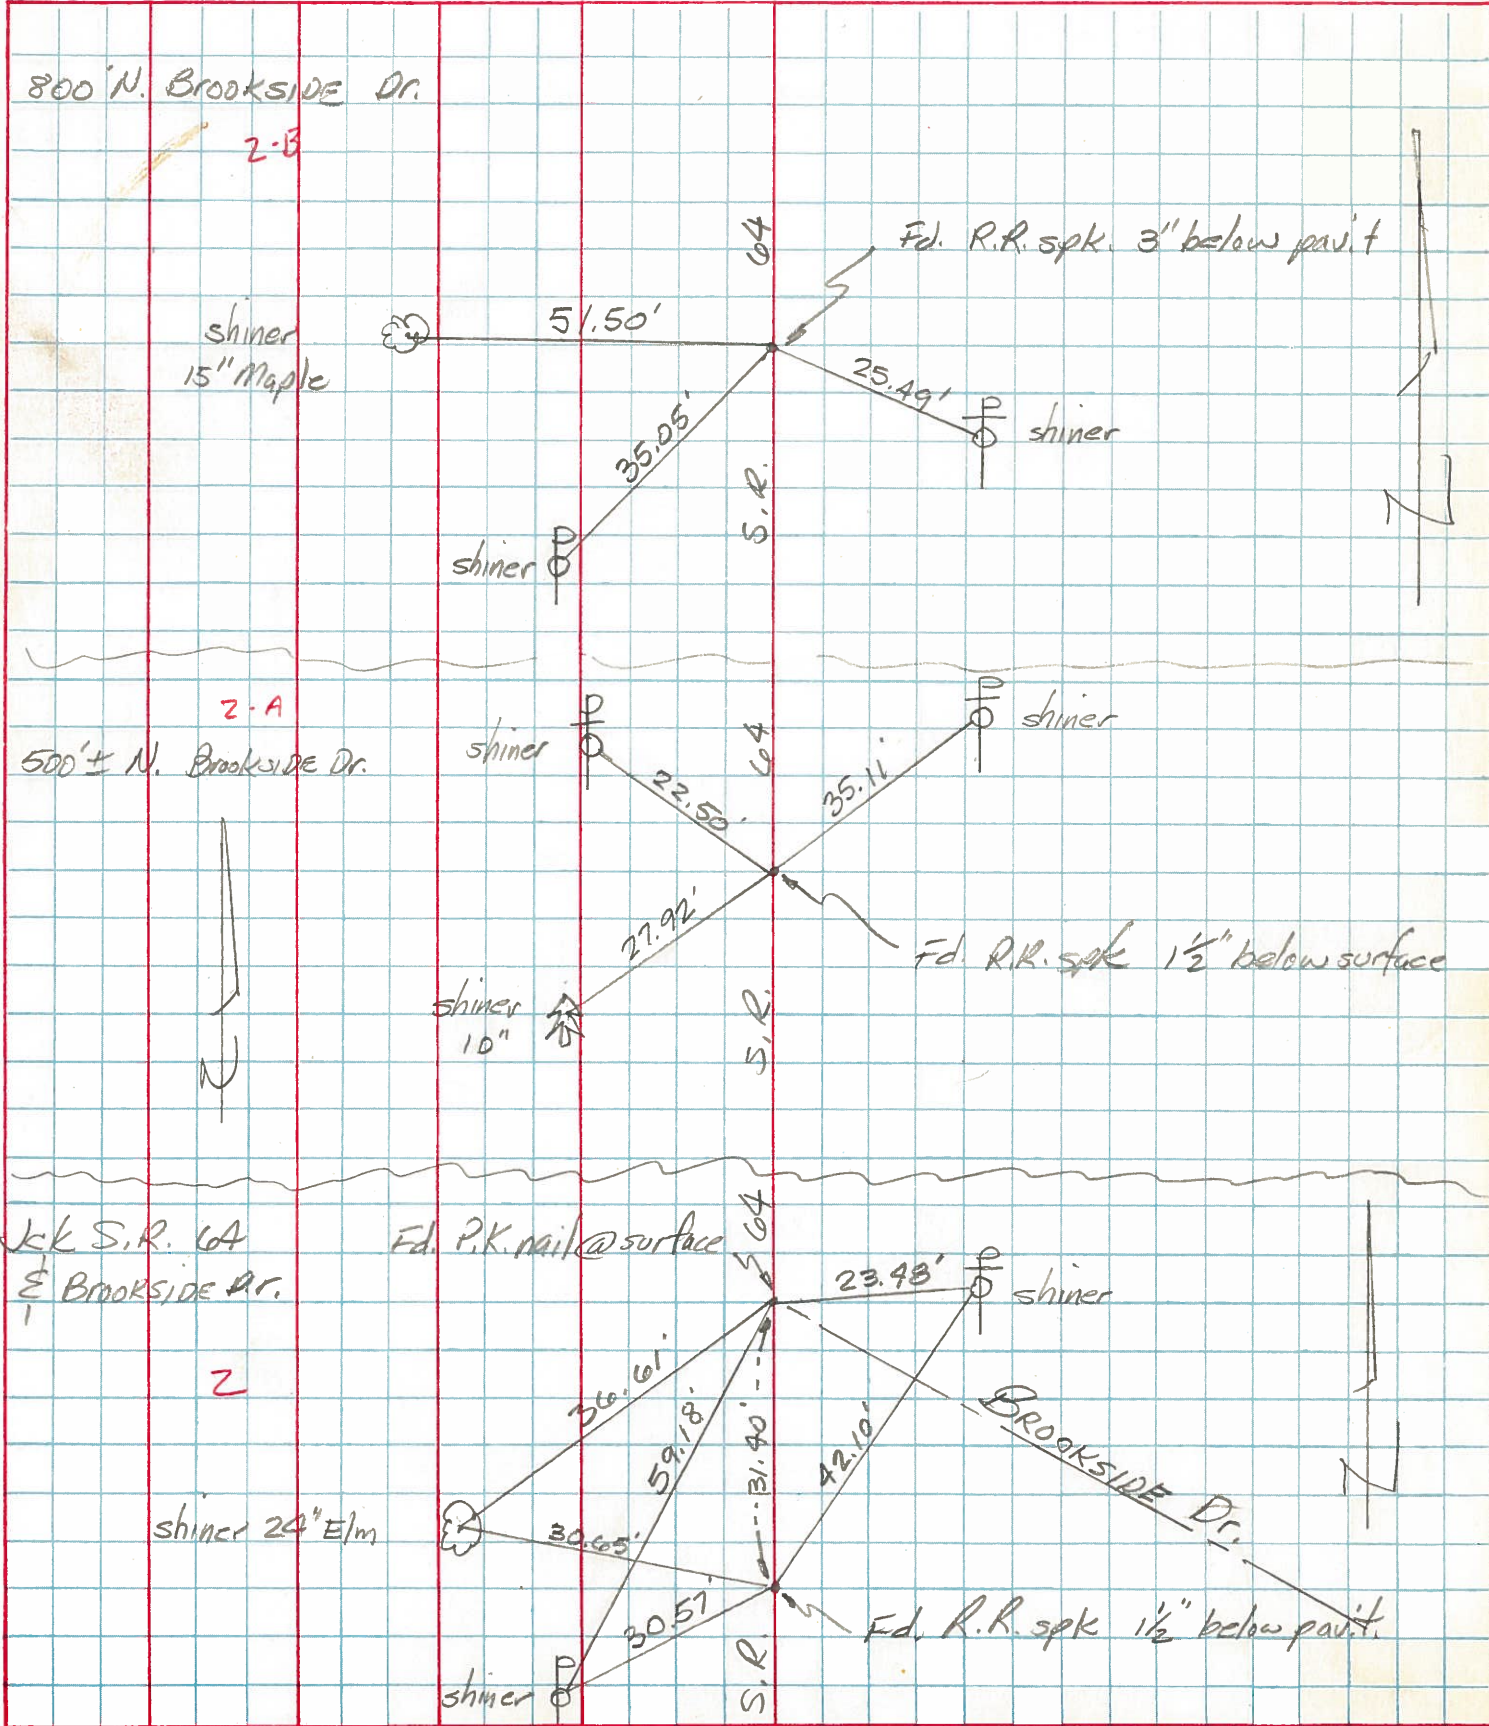

PERSONNEL	TITLE	PERSONNEL	TITLE	COUNTY	DATE
Stone				Fulton	22 March 73
Michalak				S. R. #64	WEATHER Cool
Donno				SEC. Swanton	TEMP. 35°
Curtis					

DESCRIPTION References to Control Points JOB NO. \_\_\_\_\_

