



O.D.O.T. DISTRICT 2 SURVEY OFFICE (USE ONLY)

PERSONNEL \_\_\_\_\_ REFERENCE NO. 2 SHEET 18 OF 22  
 NOTES RHOADES DATE 7-26-16 ROUTE SR 64  
 H.C. O' DONNELL WEATHER SUNNY COUNTY FULTON  
 R.C. KEFFER TEMP. 84° TOWNSHIP FULTON  
 SECTION 1  
 T 7 N R 8 E

TYPE MONUMENT MAG/WASHER  
 ON SURFACE - ~~BELOW~~ ON \_\_\_\_\_  
 LEFT - ☉ PAV'T - RIGHT ON \_\_\_\_\_  
 - TO - EDGE PAVEMENT  
 S.L.M. 75+01  
 GRID: NOTHING: 706023.067 EASTING: 1586576.029

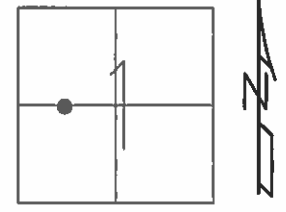

RECORD:  
 FD P.K.NAIL  
 8/13/03, MC  
 SET MAG/WASHER  
 9/23/03, MC  
 FD MAG/WASHER  
 REF2  
 7/26/16, JFO  
 SET MAG/WASHER  
 NEWREF2  
 11/15/16, JFO

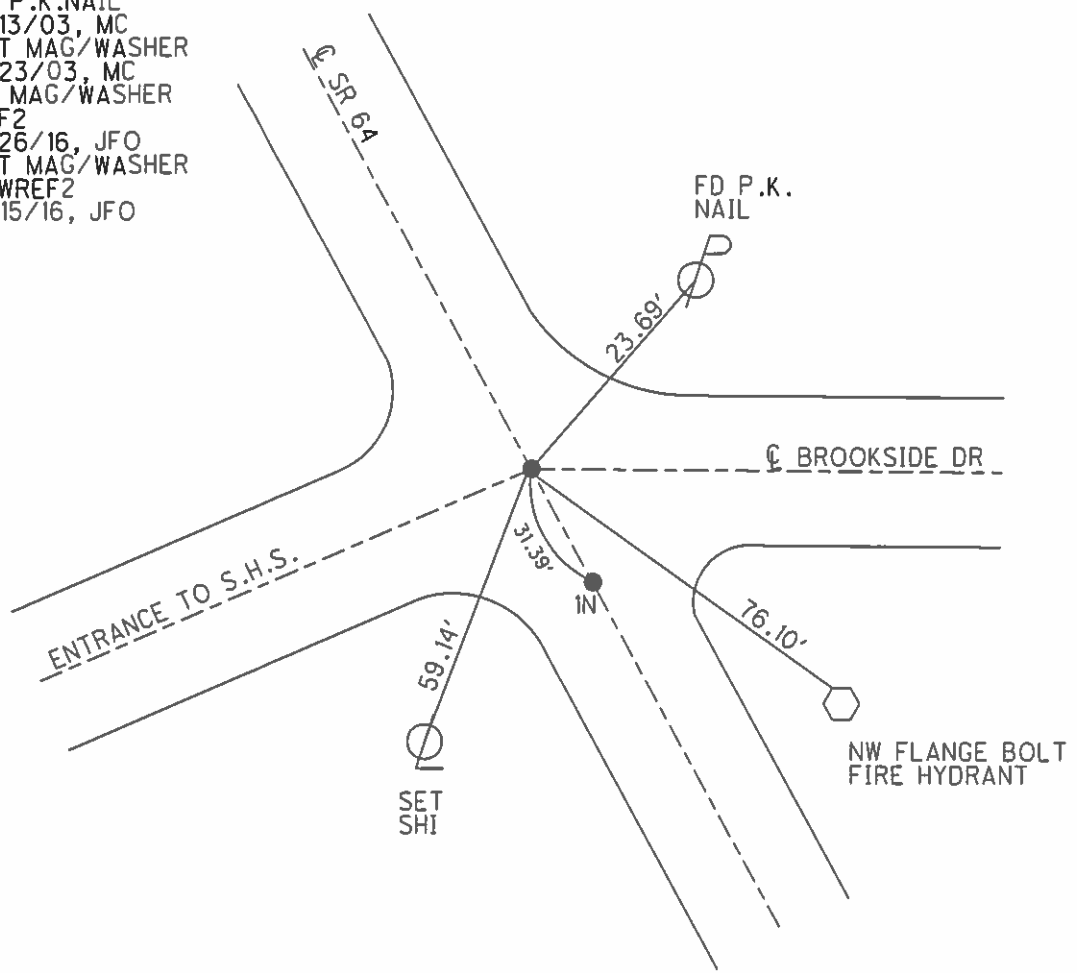

# O.D.O.T. DISTRICT 2 SURVEY OFFICE

PERSONNEL

REFERENCE NO. 2

SHEET 14 OF 18

NOTES CANTERBURY

H.C. NUMBER

R.C. BRUMBAUGH

DATE 8-13-03

WEATHER FAIR

TEMP. +78°

ROUTE SR 64

COUNTY Fulton

TOWNSHIP Fulton

SECTION 1

T 2 N 8 E


TYPE MONUMENT A-PK NAIL / B-PK NAIL  
 ON SURFACE - BELOW A-SURFACE / B SURFACE  
 LEFT - ☉ PAV'T. - RIGHT ON ♀  
TO EDGE PAVEMENT  
 S.L.M. A=74+70 B=75+01

SWANTON	
CORP	



NOTE: POINT "B" WAS GONE, WE WERE  
 ABLE TO RESET USING OLD TIES. M.C. 2003

RESET MAG/WASHER  
 @ BOTH  
 9-23-03  
 M.C.

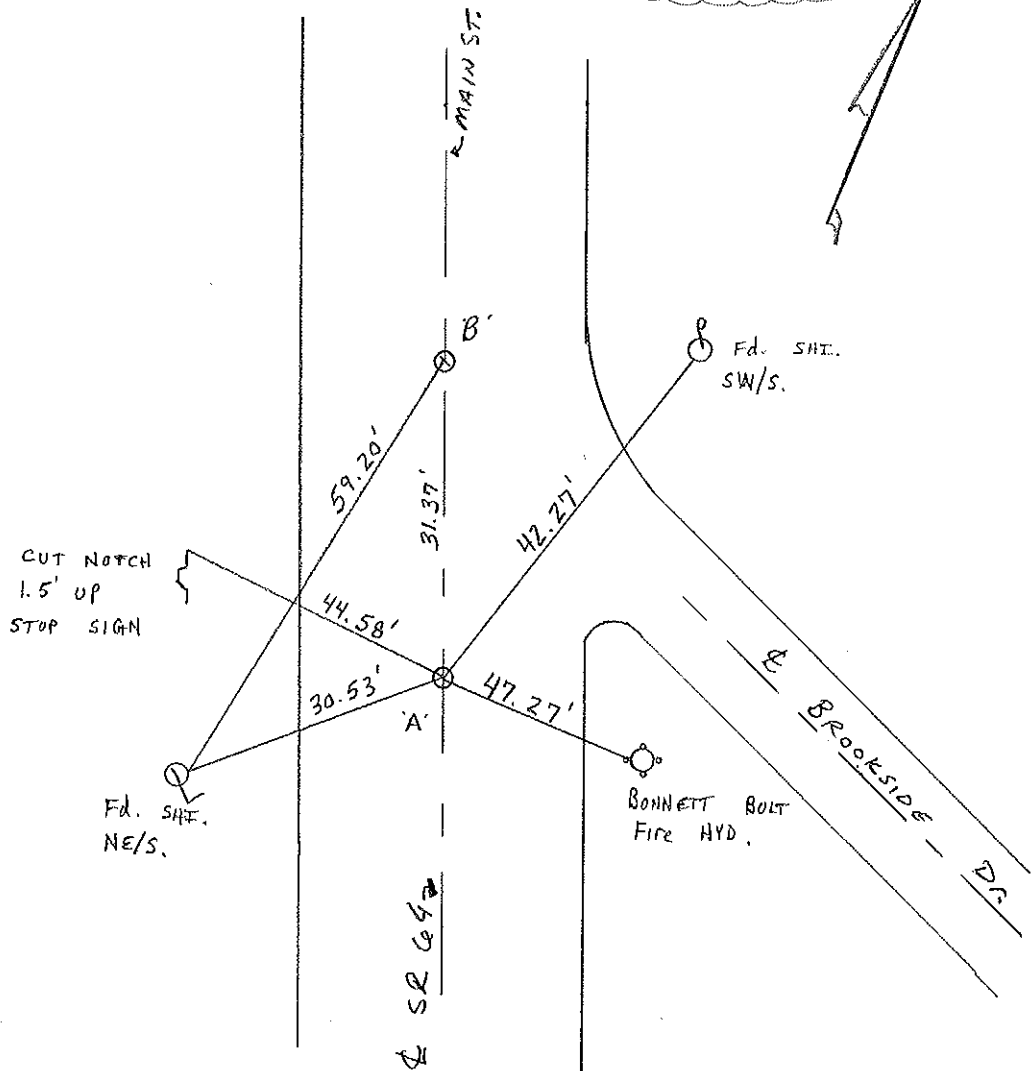

# O.D.O.T. DISTRICT 2 SURVEY OFFICE

PERSONNEL

REFERENCE NO. 2

SHEET 12 OF 16

NOTES 1. Stone

H.C. D. Cuntis

R.C. J. Hauscholder

DATE 6 April 88

WEATHER Cloudy

TEMP. 600

ROUTE SR #64

COUNTY Fulton

TOWNSHIP Fulton

SECTION \_\_\_\_\_

T \_\_\_\_\_ R \_\_\_\_\_

TYPE MONUMENT "A" = PK Nail  
"B" = PK Nail


ON SURFACE - BELOW Surface

LEFT - & PAV'T. - RIGHT \_\_\_\_\_

\_\_\_\_\_ TO \_\_\_\_\_ EDGE PAVEMENT

S.L.M. "A" = 74+70 "B" = 75+01


SW	NTON
CORP	

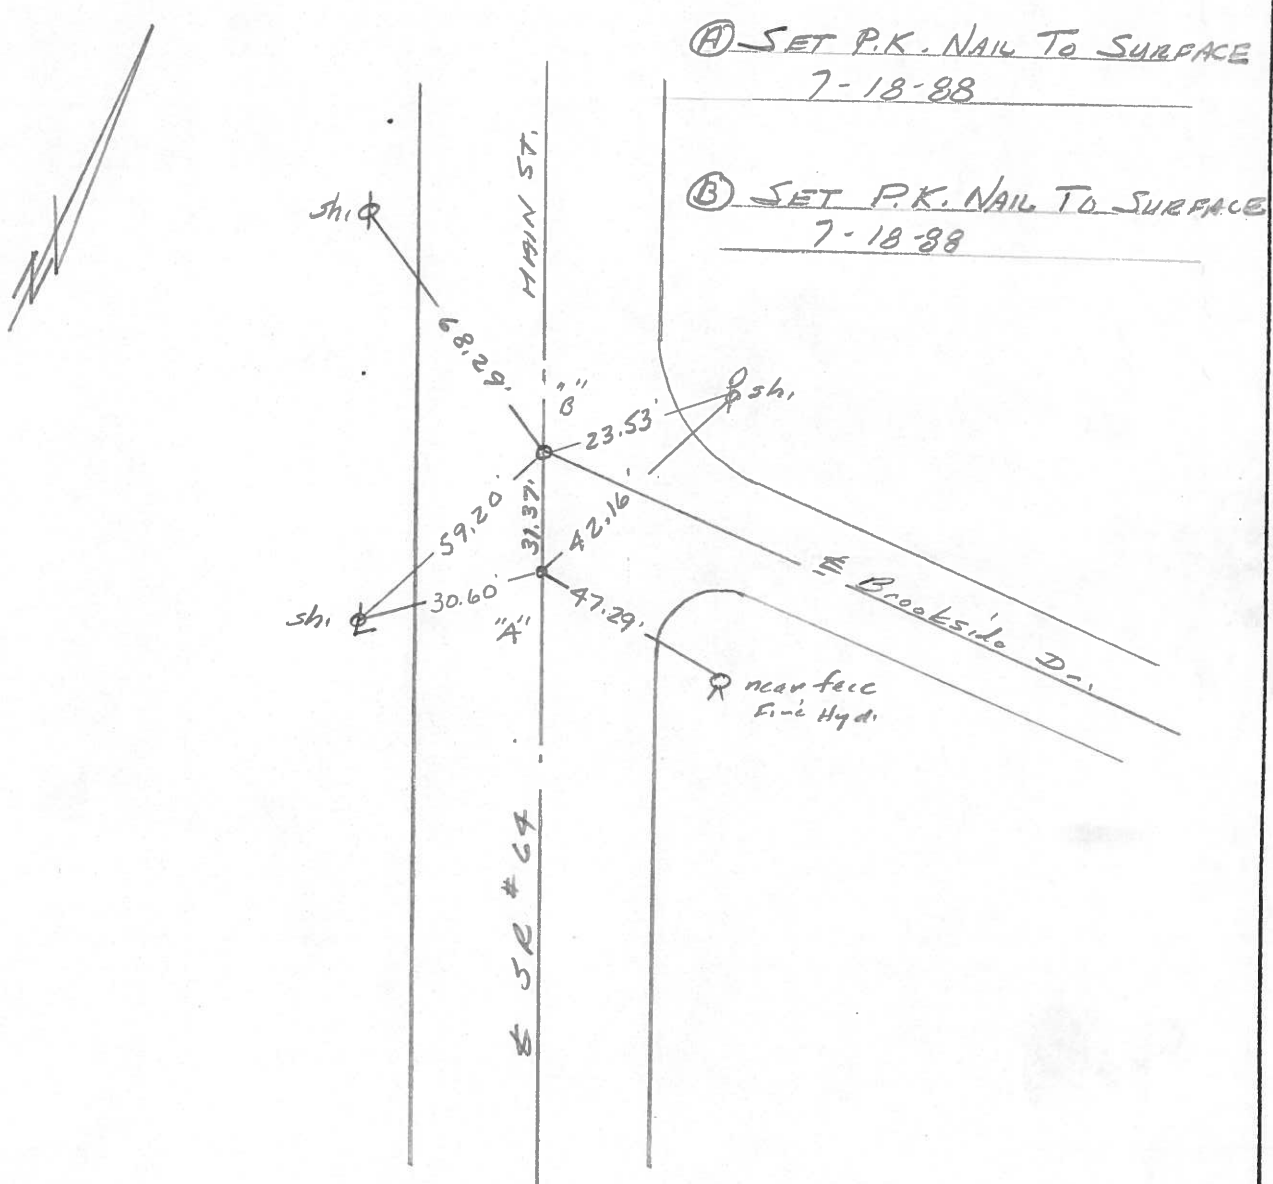

# S.R. 64 FULTON


PERSONNEL	TITLE	PERSONNEL	TITLE	COUNTY	DATE	WEATHER	TEMP.
Tomsic		Granata		Fulton	Aug. 6-73		
Vanzo				S. R. 64			
Neuber				SEC. FULTON TWP			
Boyle							

DESCRIPTION	LEFT	CENTER LINE	RIGHT	JOB NO.
-------------	------	-------------	-------	---------

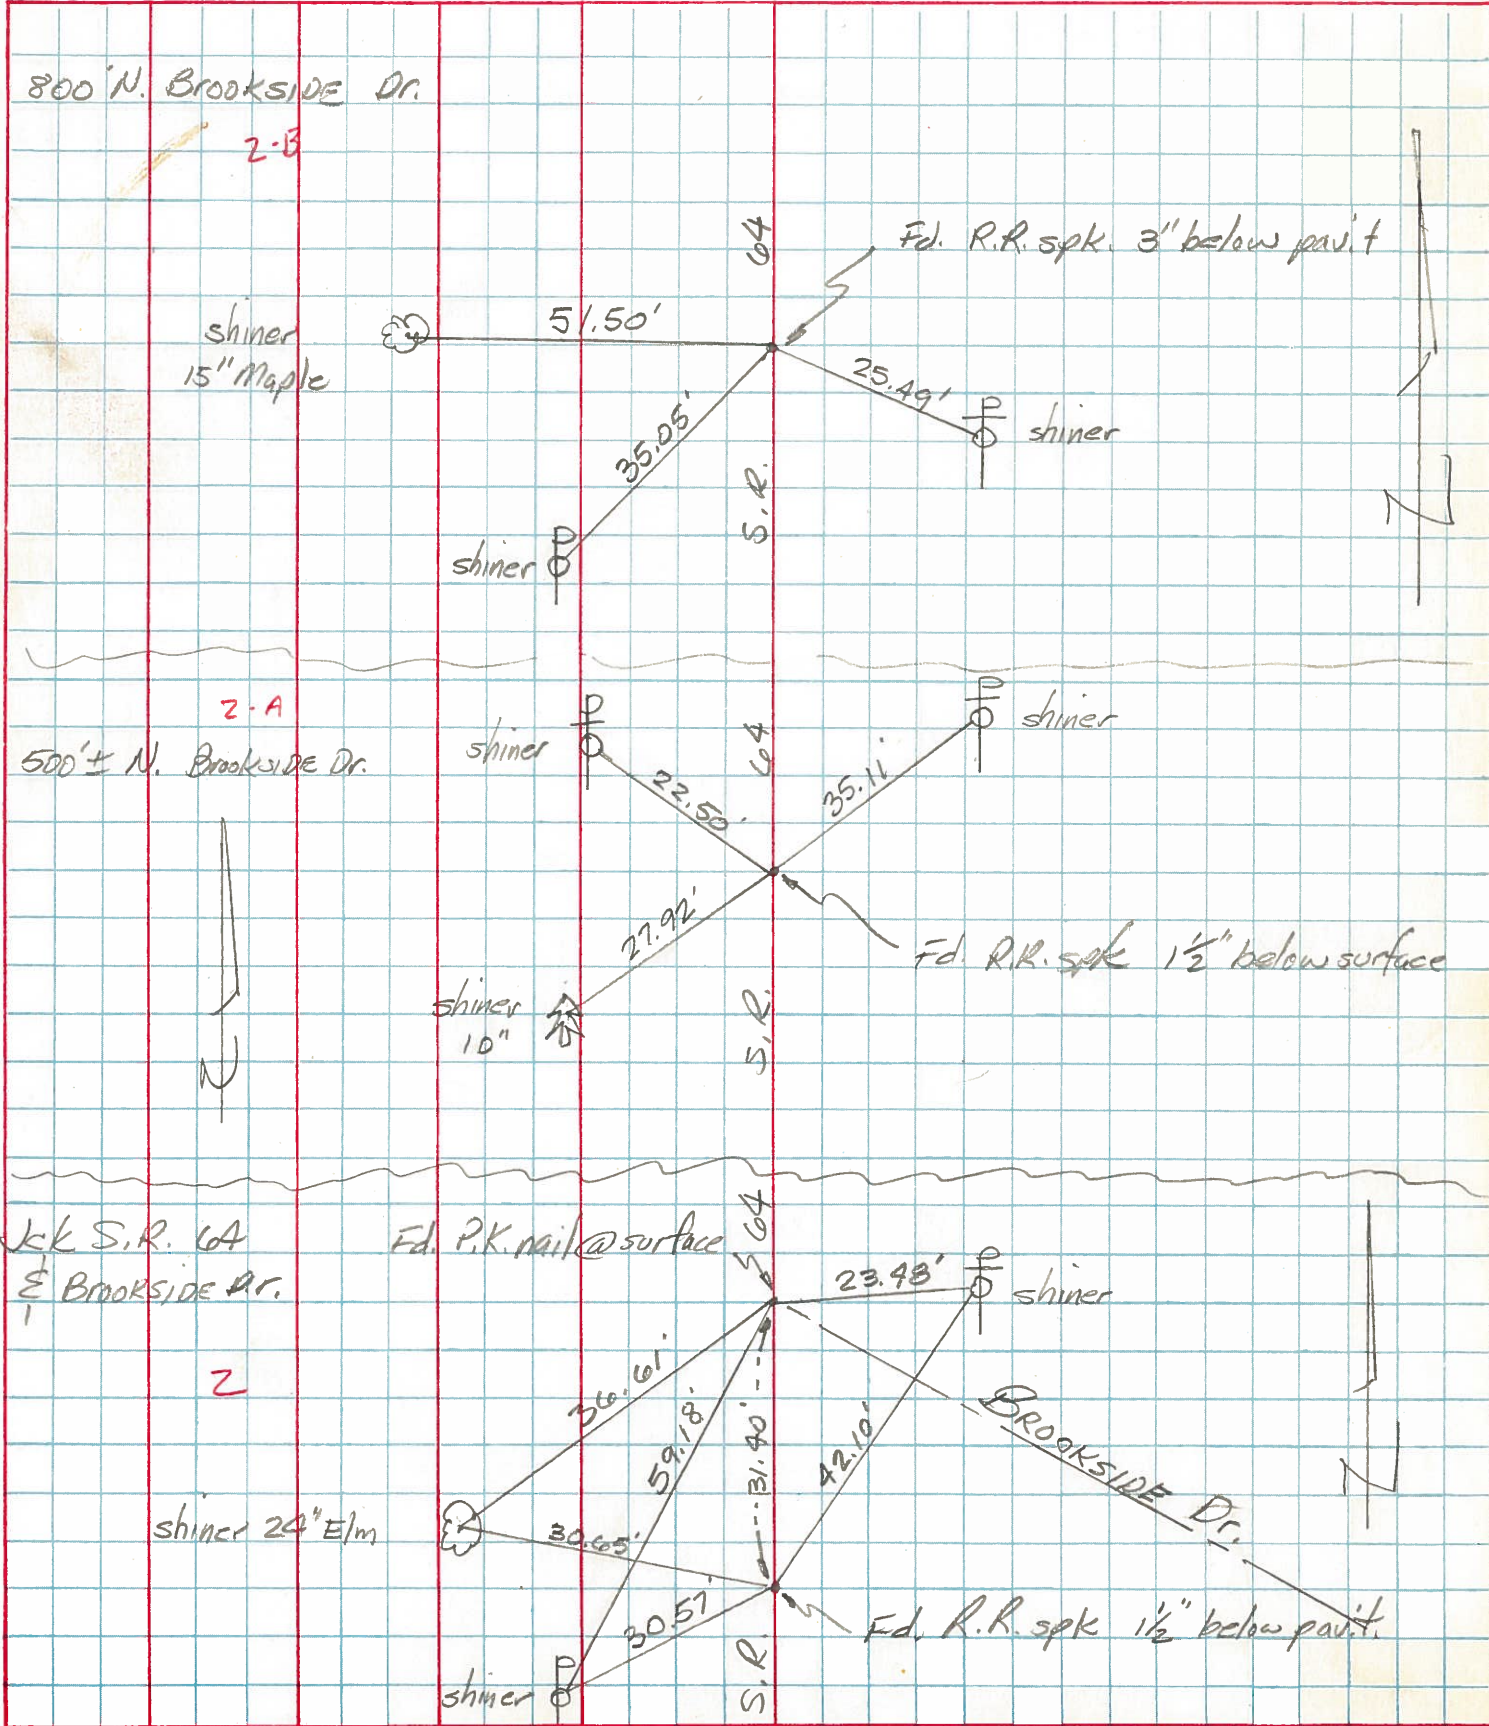

PERSONNEL	TITLE	PERSONNEL	TITLE	COUNTY	DATE
Stone				Fulton	22 March 73
Michalak				S. R. #64	WEATHER Cool
Denno				SEC. Swanton	TEMP. 35°
Curtis					

DESCRIPTION References to Control Points JOB NO. \_\_\_\_\_

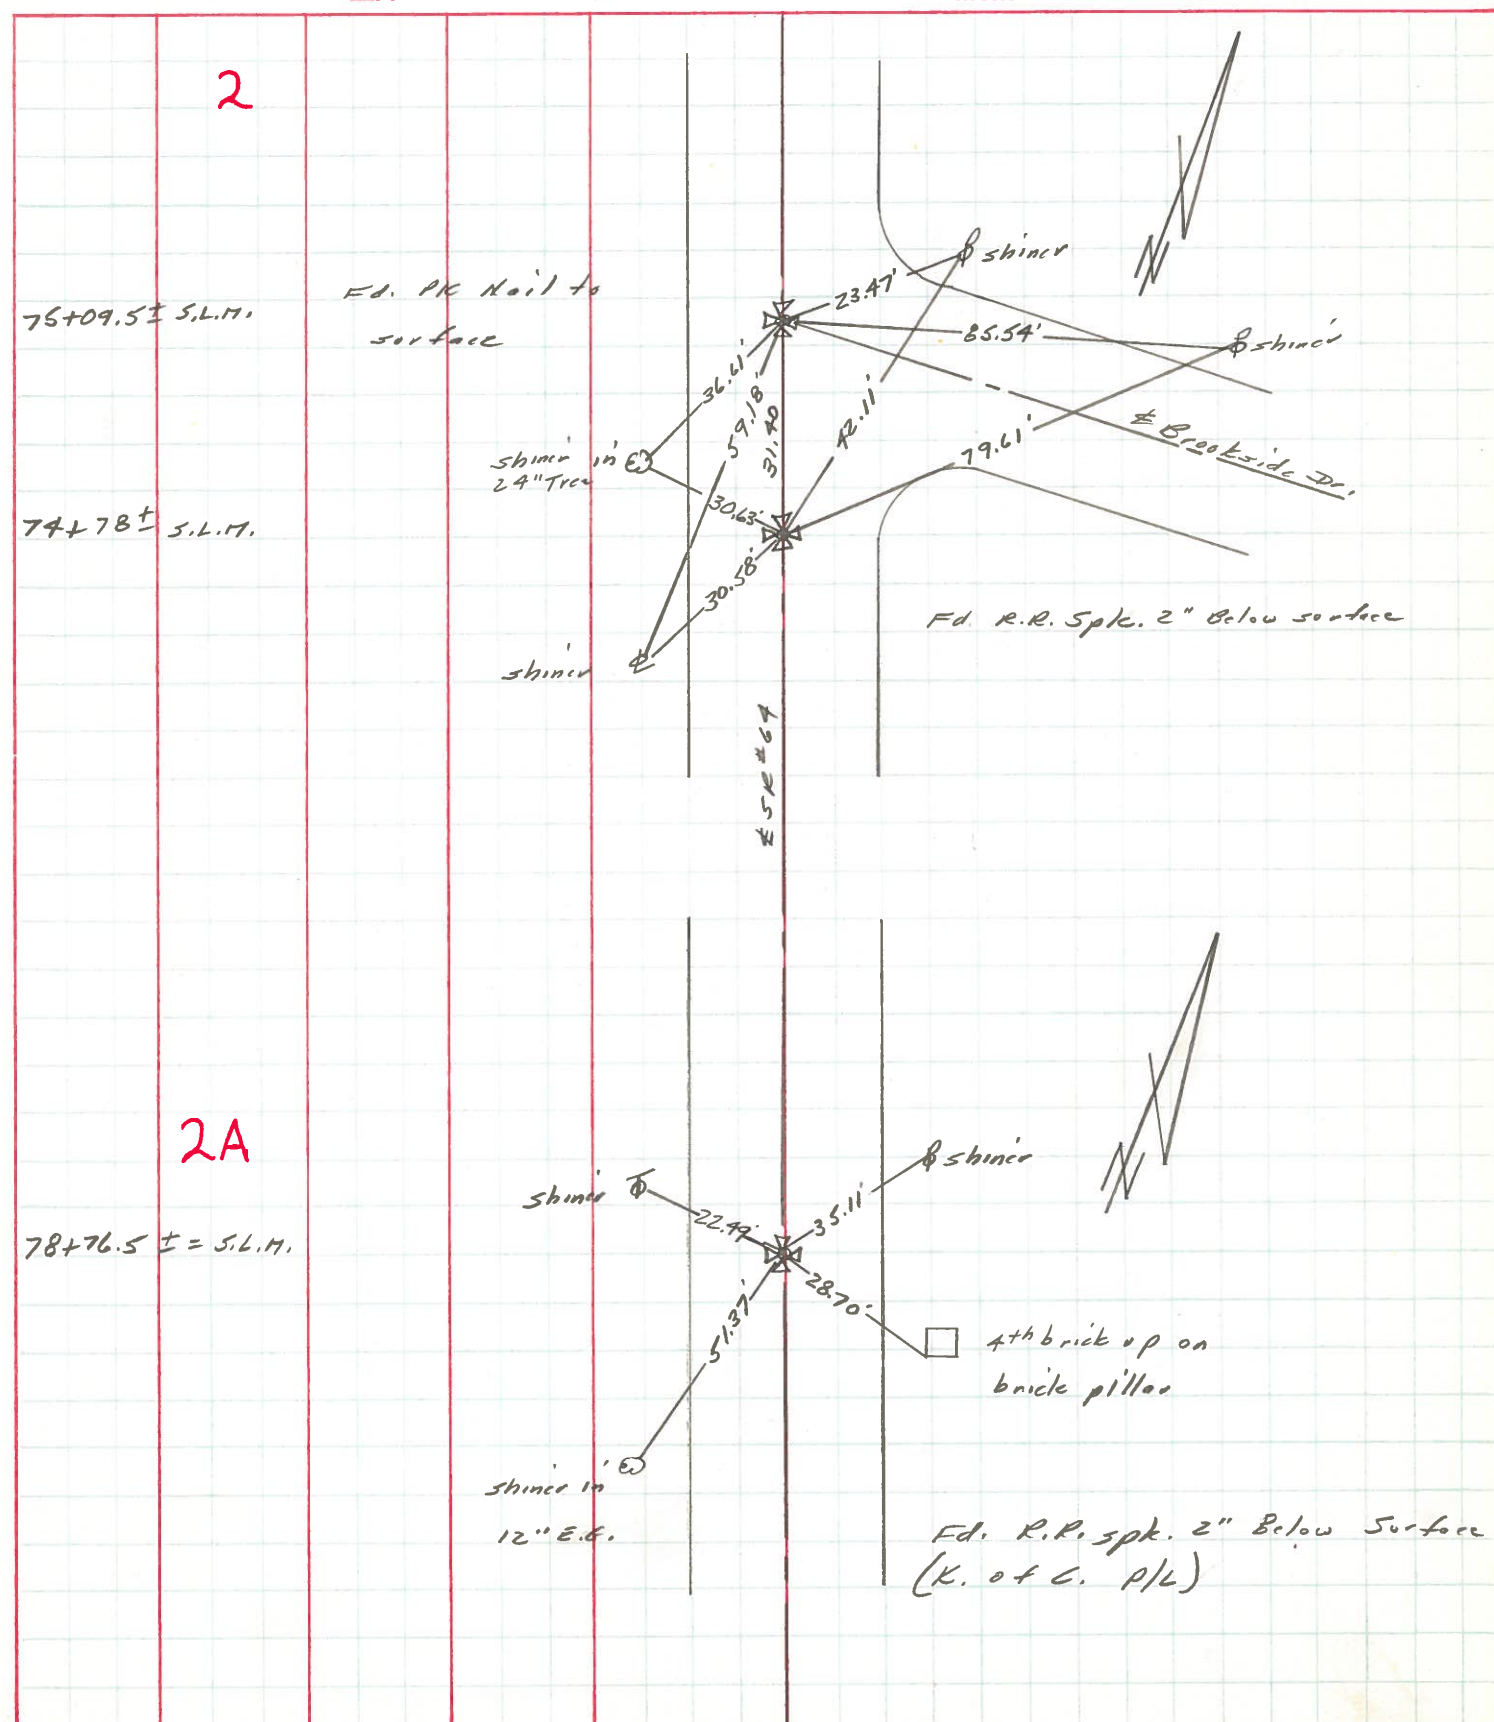



PERSONNEL TITLE PERSONNEL TITLE

COUNTY Fulton DATE June 6, 1966

Denno \_\_\_\_\_

Curtis \_\_\_\_\_

S. R. 64 WEATHER Cloudy

Granata \_\_\_\_\_

Omeij \_\_\_\_\_

SEC. \_\_\_\_\_ TEMP. 80°

DESCRIPTION \_\_\_\_\_ LEFT \_\_\_\_\_ CENTER LINE \_\_\_\_\_ RIGHT \_\_\_\_\_ JOB NO. \_\_\_\_\_

