

O.D.O.T. DISTRICT 2 SURVEY OFFICE (USE ONLY)

PERSONNEL

REFERENCE NO. 4 B

SHEET 24 OF 59

NOTES HUSS

DATE 5/10/10

ROUTE SR 64

H.C. CANTERBURY

WEATHER FAIR

COUNTY FULTON

R.C. HUSS

TEMP. 58°

TOWNSHIP FULTON

SECTION 35

DWG BY RHOADES PID PAVETRAIN

T 8 N R 4 E

TYPE MONUMENT P.K.SHANK

~~ON SURFACE~~ - BELOW 0.1'

OFFSET  $\text{C}$  PAVEMENT ON LT : RT  
9.3' TO LT EDGE PAVEMENT


STATION: 123+59.69

HORIZ.DATUM: NAD83 2011

GEOID: NAVD88 2012A

GRID: NORTHING: 709283.654

EASTING: 1584660.454

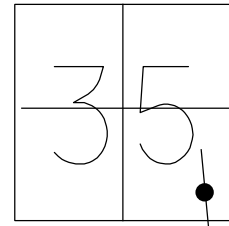

69.64'

$\text{C}$  SR 64



44.81'



40.37'

67.41'




RECORD:  
 SET PK/WASHER  
 8/18/93  
 FD P.K./WASHER  
 8/20/08  
 REFB4  
 8/28/08, SAH  
 FD P.K.SHANK  
 0.1' DOWN  
 5/10/10, SAH  
 SET MAG/WASHER  
 7-28-10 SAH  
 FD MAG/WASHER  
 1/2" DOWN  
 REFB4  
 8/7/17, JFO  
 UNCOVERED  
 11/6/17, JFO  
 FD MAG/WASHER  
 REFB4  
 6/27/22, DSA  
 FD MAG/WASHER  
 12/29/22, TDN


O.D.O.T. DISTRICT 2 SURVEY OFFICE (USE ONLY)

PERSONNEL \_\_\_\_\_ REFERENCE NO. 4 B SHEET 4 OF 39  
 NOTES HUSS DATE 5-10-10 ROUTE SR 64  
 H.C. CANTERBURY WEATHER FAIR COUNTY FULTON  
 R.C. HUSS TEMP. 58° TOWNSHIP FULTON  
 \_\_\_\_\_ SECTION 35  
 \_\_\_\_\_ T 8 N R 4 E

TYPE MONUMENT \_\_\_\_\_ P.K. SHANK  
~~ON SURFACE~~ - BELOW 0.1'  
 LEFT - ☉ PAV'T - RIGHT ON  
9.3' TO LT EDGE PAVEMENT  
 S.L.M. 123+59.69

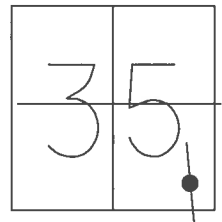

GRID: NOTHING: 709283.654 EASTING: 1584660.454

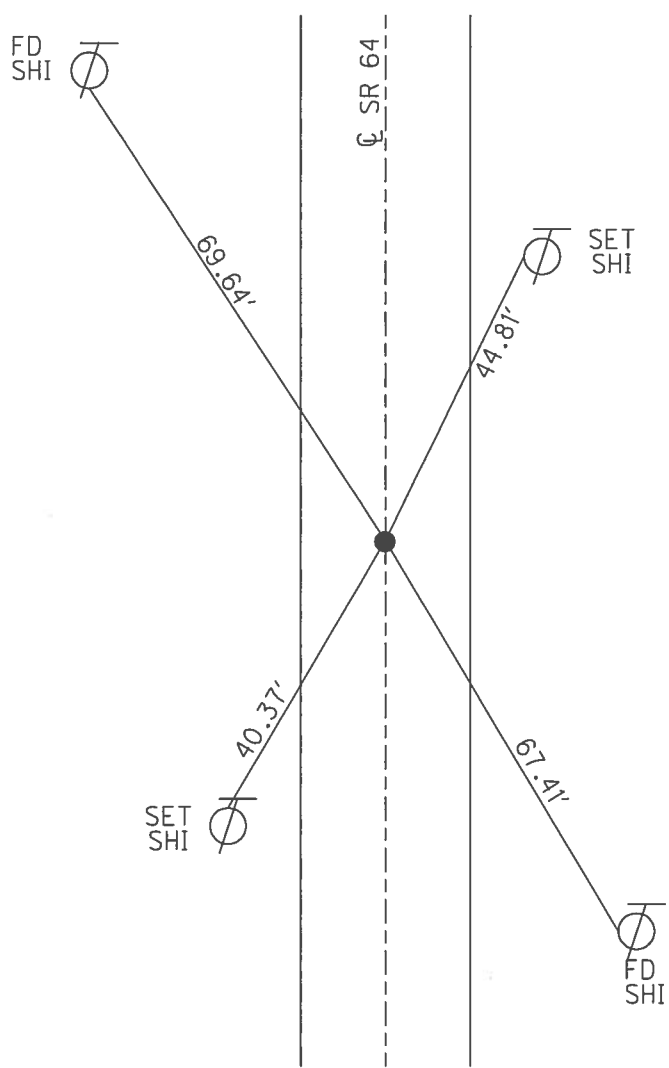


RECORD:  
 SET PK/WASHER  
 8/18/93  
 FD P.K./WASHER  
 8/20/08  
 REFB4  
 8/28/08, SAH  
 FD P.K.SHANK  
 0.1' DOWN  
 5/10/10, SAH  
 SET MAG/WASHER  
 7-28-10 SAH  
 FD MAG/WASHER  
 1/2" DOWN  
 REFB4  
 8/7/17, JFO  
 UNCOVERED  
 11/6/17, JFO

O.D.O.T. DISTRICT 2 SURVEY OFFICE (USE ONLY)

PERSONNEL \_\_\_\_\_ REFERENCE NO. 4 B SHEET 4 OF 39  
 NOTES HUSS DATE 5-10-10 ROUTE SR 64  
 H.C. CANTERBURY WEATHER FAIR COUNTY FULTON  
 R.C. HUSS TEMP. 58° TOWNSHIP FULTON  
 SECTION 35  
 T 8 N R 4 E

TYPE MONUMENT \_\_\_\_\_ P.K. SHANK \_\_\_\_\_  
~~ON SURFACE~~ - BELOW 0.1' \_\_\_\_\_  
 LEFT - ☉ PAV'T - RIGHT ON \_\_\_\_\_  
9.3' TO LT. EDGE PAVEMENT  
 S.L.M. 123+59.69

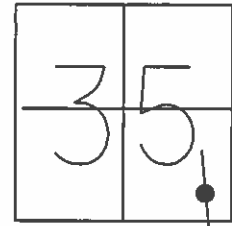

GRID: NOTHING: 709283.686 EASTING: 1584660.351

FD. SHI. S/S



69.64'

☉ SR 64

SET N/SHI.  
NW/S



44.81'

SET PK/WASHER  
8/18/93

SET MAG & WASHER  
7-28-10 SAH

FD P.K. / WASHER  
8/20/08

REFB4, VRS  
8/28/08 SAH

40.37'




SET N/SHI.  
NW/S

67.41'



FD. SHI.  
SW/S

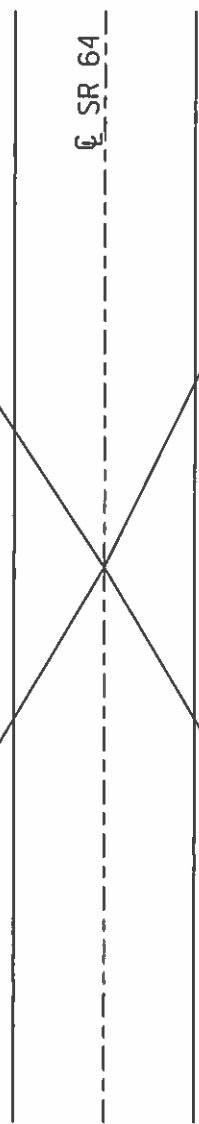

# O.D.O.T. DISTRICT 2 SURVEY OFFICE

PERSONNEL \_\_\_\_\_

REFERENCE NO. 4-B

SHEET 3 OF 20

NOTES D. CURTIS

H.C. CORDES

DATE 7-27-93

ROUTE S.E. #64

R.C. CANTERBURY

WEATHER Sunny - Warm

COUNTY FULTON

ROMETO

TEMP. +85.5°

TOWNSHIP FULTON

SET P.K. & WASHER  
8-18-93

SECTION 35

T 8 N R 4 E



TYPE MONUMENT S.M. R.R. SPK.

ON SURFACE - BELOW YES

LEFT- & PAV'T. - RIGHT & PAV'T

10.0' TO LT. EDGE PAVEMENT

S.L.M. 113 + 29

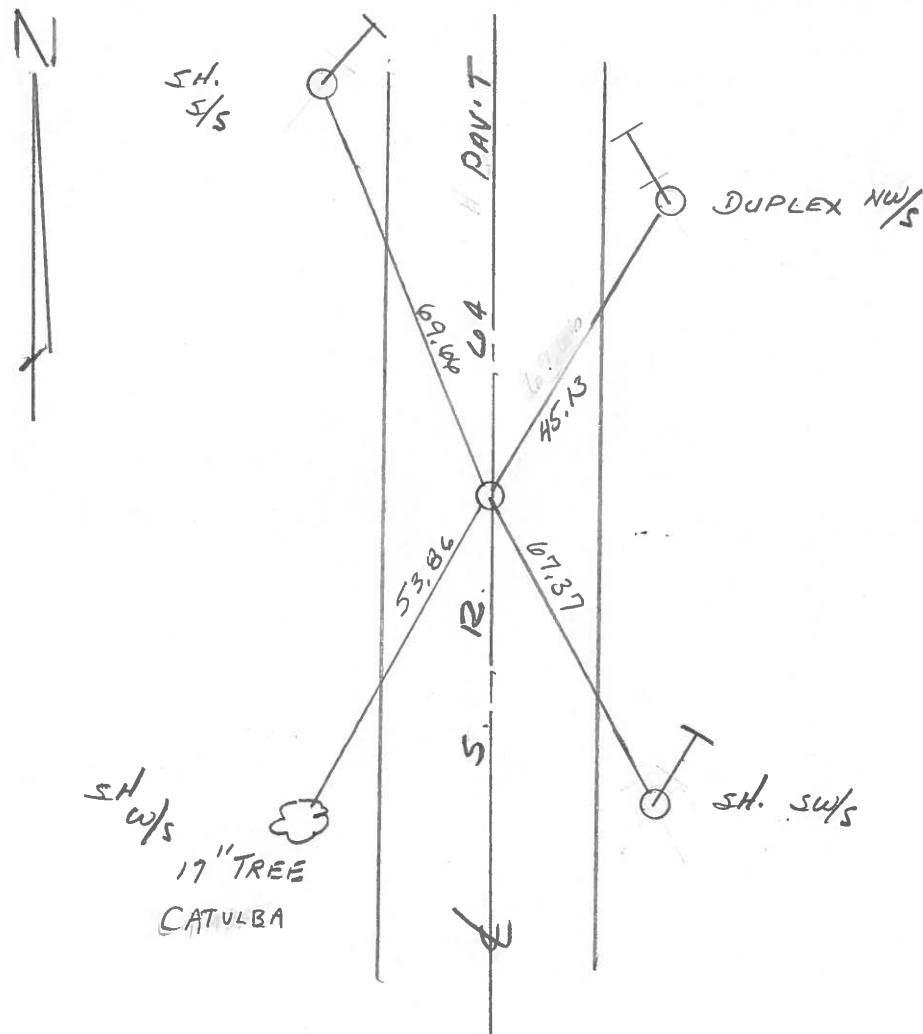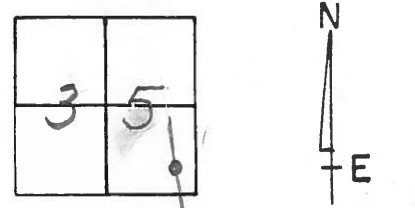

Q.D.O.T. DISTRICT 2 SURVEY OFFICE

SHEET 3 OF

County Fulton S.R. 64

Date 18 April 84

Township Fulton

Weather cloudy

Section 35

Temp. 35°


T\_N, R\_E

Personnel L. Stone

P. Neuser


R. Michalek

D. Curtis

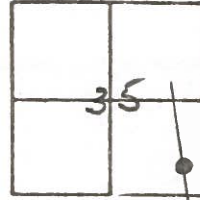

113+20


REF. NO. 4-B

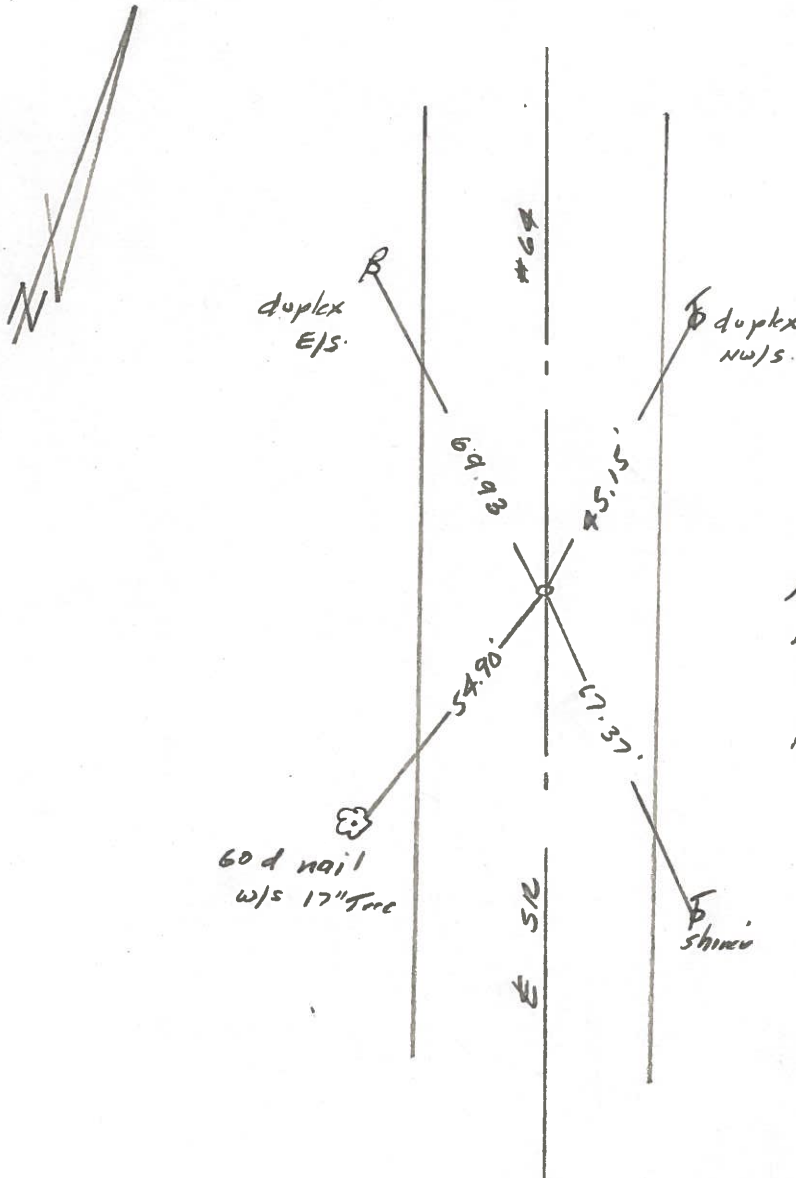

Fd. 1" I. pipe 1 1/2" deep  
 10.5' to E. edge put,  
 9.5' to W. edge put  
 Reset Sm. R.R. Spk. to  
 surface = 6-18-84

PERSONNEL	TITLE	PERSONNEL	TITLE	COUNTY	Fulton	DATE	AUG. 8, 1973
Tomsic		Boyle		S. R.	64	WEATHER	
Neuser				SEC.	FULTON TWP	TEMP.	
Granata							
Vandy							





DESCRIPTION \_\_\_\_\_ LEFT \_\_\_\_\_ CENTER LINE \_\_\_\_\_ RIGHT \_\_\_\_\_ JOB NO. \_\_\_\_\_

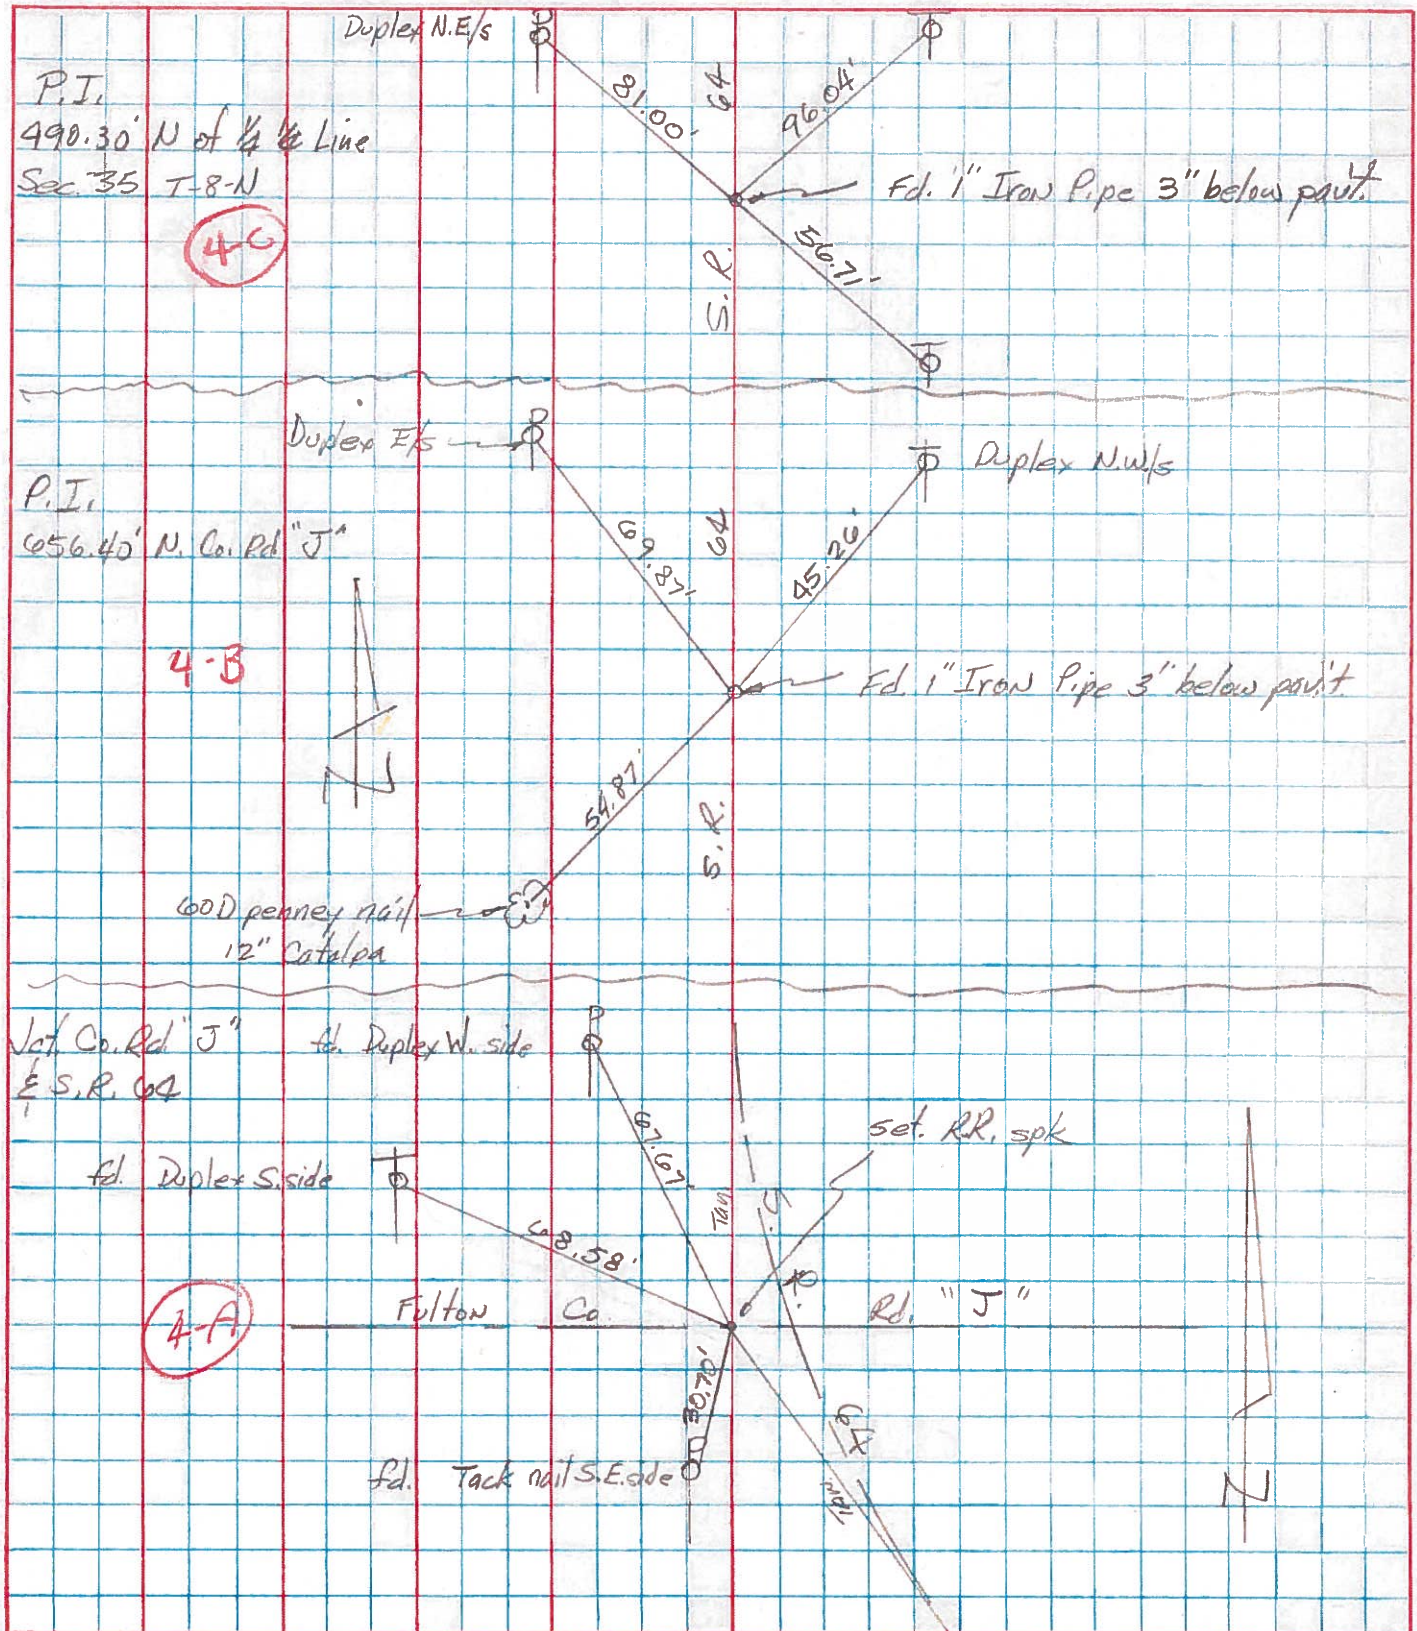



PERSONNEL TITLE PERSONNEL TITLE COUNTY Fulton DATE Apr. 197  
Red Beach \_\_\_\_\_  
Newcomb \_\_\_\_\_  
Knape \_\_\_\_\_  
Wise \_\_\_\_\_  
 S. R. 64 WEATHER \_\_\_\_\_  
 SEC. Ful. Twp. Sec. 35 T-8-N TEMP. \_\_\_\_\_

DESCRIPTION CONTROL POINTS JOB NO. \_\_\_\_\_

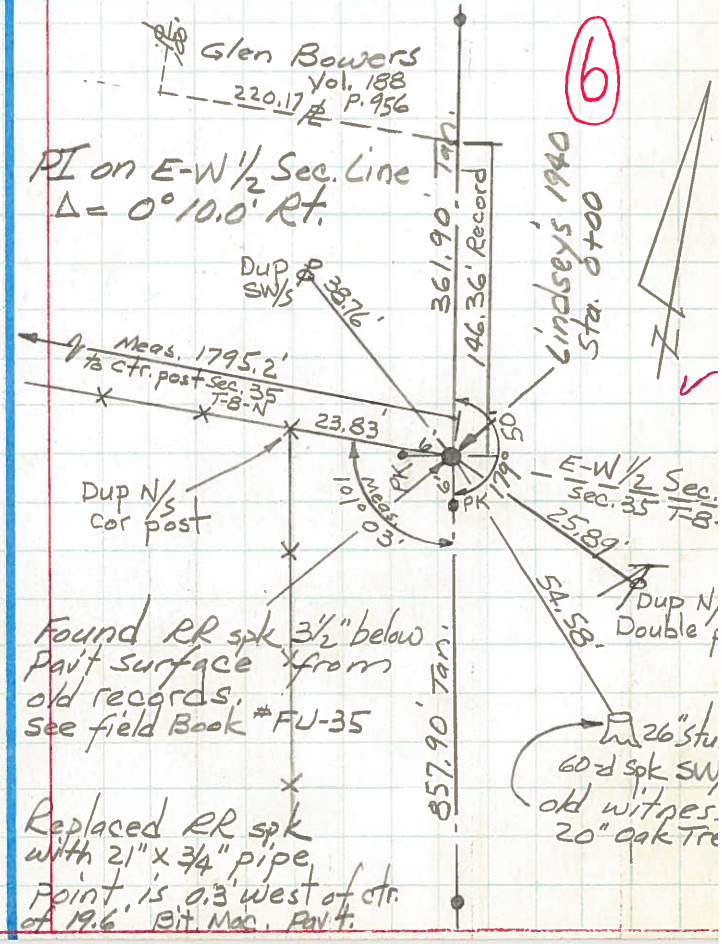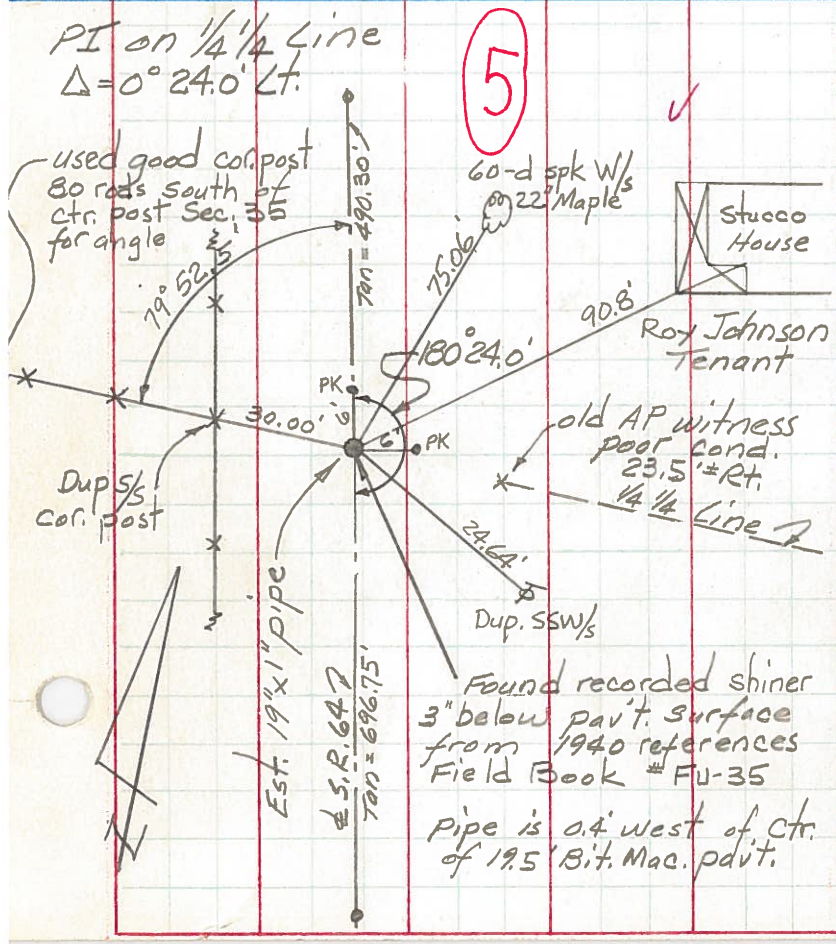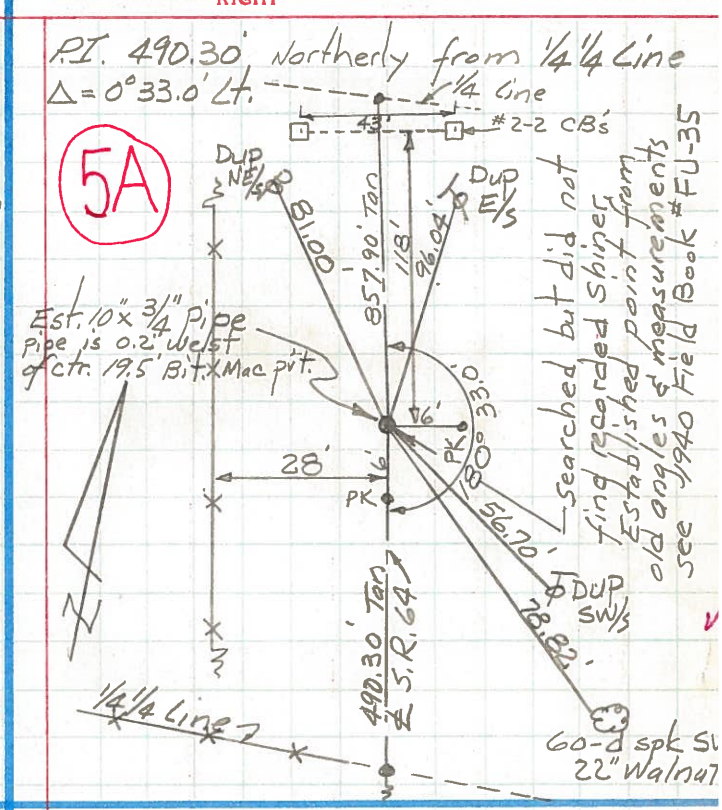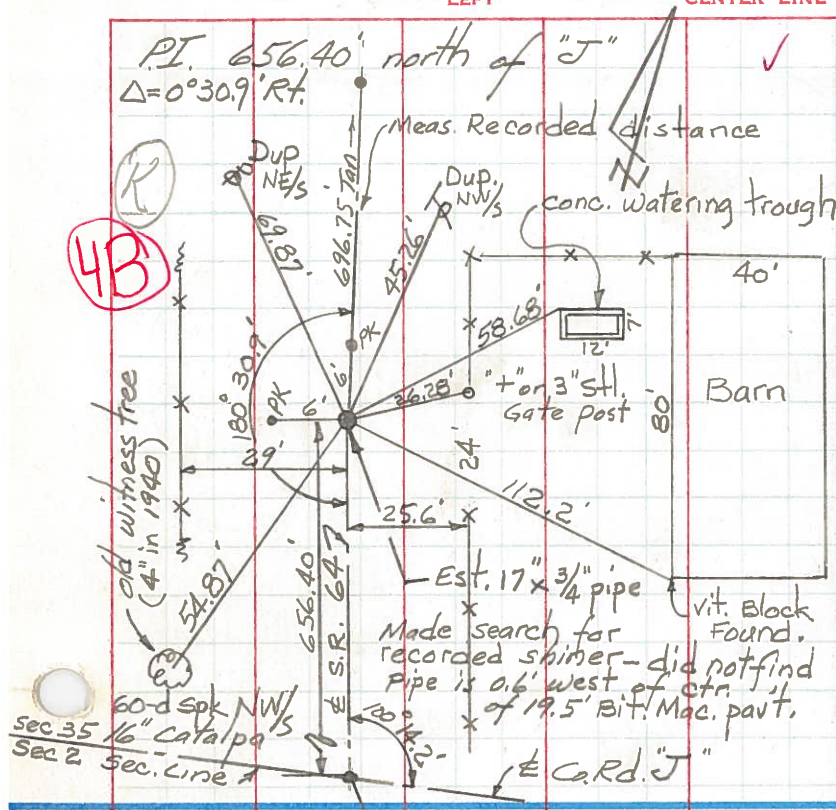



PERSONNEL TITLE PERSONNEL TITLE  
 Red Beach  
 Newscomb  
 Knope  
 Wise

COUNTY FULTON DATE Apr. 1971  
 S. R. 64 WEATHER  
 SEC. SE 1/4 Sec. 35 Ful. Twp. TEMP.

DESCRIPTION ALIGNMENT & CONTROLS LEFT CENTER LINE RIGHT JOB NO.

