


O.D.O.T. DISTRICT 2 SURVEY OFFICE (USE ONLY)


PERSONNEL _____ REFERENCE NO. 6 AB SHEET 29 OF 59
 NOTES HUSS DATE 5/24/10 ROUTE SR 64
 H.C. CANTERBURY WEATHER SUNNY COUNTY FULTON
 R.C. FINTEL TEMP. 80° TOWNSHIP FULTON
 _____ PID PAVETRAIN SECTION 35
 DWG BY RHOADES _____ T 8 N R 4 E

TYPE MONUMENT 1 1/2" IPIPE
~~ON SURFACE~~ - BELOW 4"
 OFFSET \odot PAVEMENT 12.38' ~~RT~~ : RT
2.5' RT TO RT EDGE PAVEMENT
 STATION: 147+66

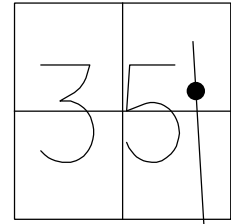

HORIZ.DATUM: NAD83 2011 GEOID: NAVD88 2012A
 GRID: NORTHING: 711657.096 EASTING: 1584261.945

RECORD:
 FD 1" IPIPE
 4" DOWN
 8/20/08
 FD 1 1/2" IPIPE
 4" DOWN
 5/24/10, SAH
 FD 1 1/2" IPIPE
 10" DOWN
 REFAB6
 8/7/17, JFO

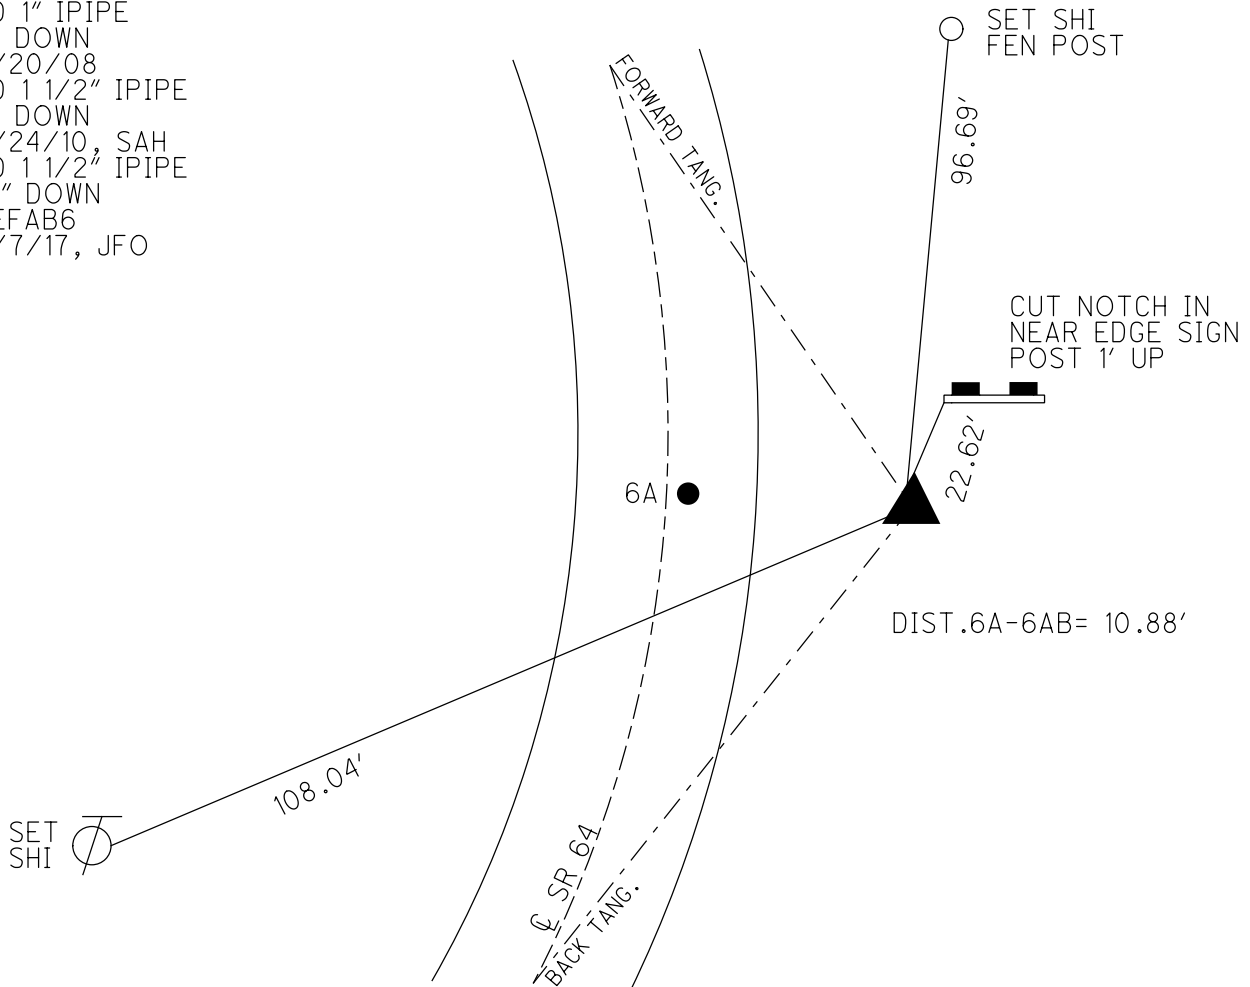

O.D.O.T. DISTRICT 2 SURVEY OFFICE (USE ONLY)

PERSONNEL _____ REFERENCE NO. 6 AB SHEET 9 OF 39

NOTES HUSS DATE 5-24-10 ROUTE SR 64
 H.C. CANTERBURY WEATHER HOT COUNTY FULTON
 R.C. FINTEL TEMP. 80° TOWNSHIP FULTON
 _____ SECTION 35
 _____ T 8 N R 4 E

TYPE MONUMENT _____ 1 1/2" IPIPE _____


~~ON SURFACE~~ - BELOW _____ 4" _____

~~LEFT~~ - Q PAV'T - RIGHT _____ 12.38' _____


2.5' RITO RT EDGE PAVEMENT

S.L.M. _____ 147+66 _____

GRID: NOTHING: 711657.096 EASTING: 1584261.945

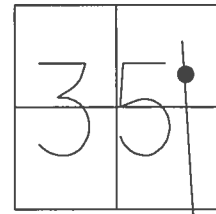

RECORD:
 FD 1" IPIPE
 4" DOWN
 8/20/08
 FD 1 1/2" IPIPE
 4" DOWN
 5/24/10, SAH
 FD 1 1/2" IPIPE
 10" DOWN
 REFAB6
 8/7/17, JFO

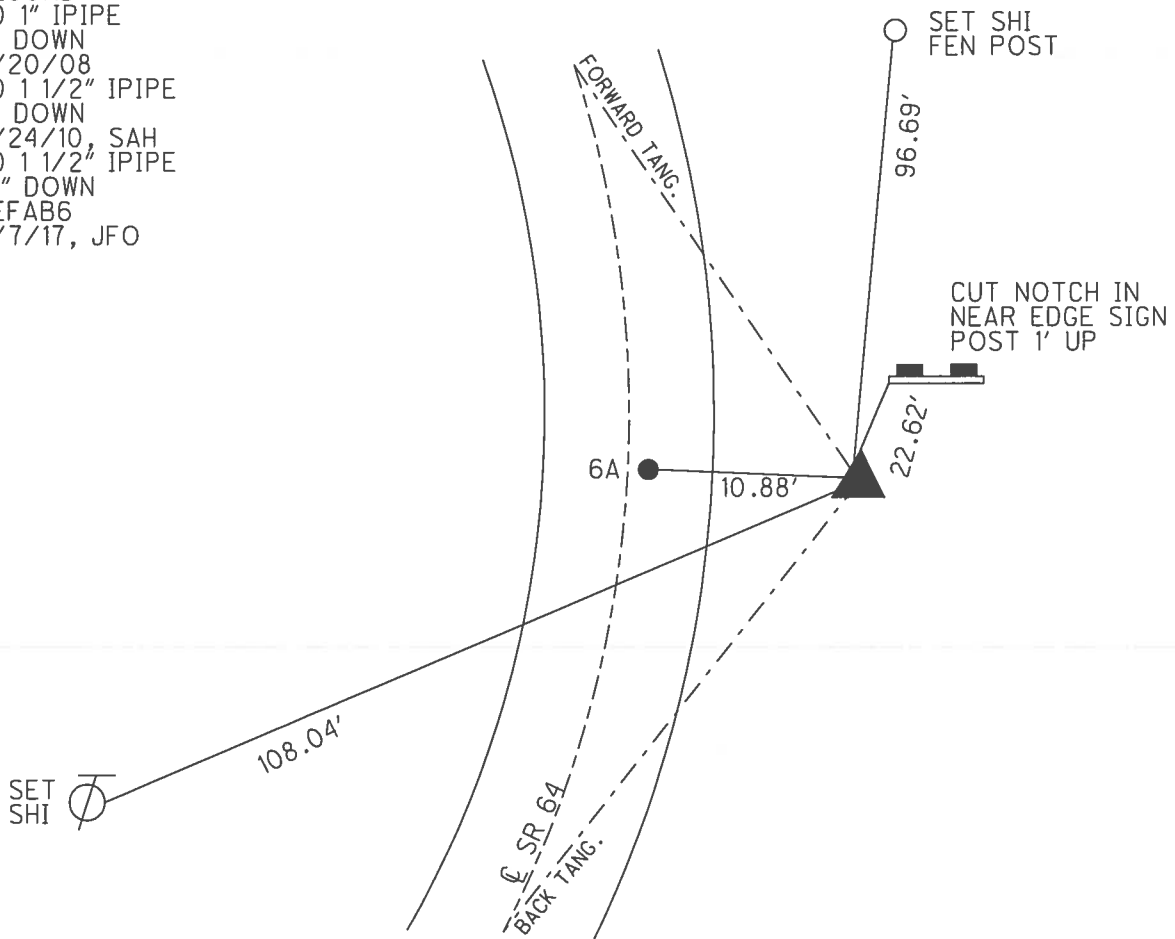


O.D.O.T. DISTRICT 2 SURVEY OFFICE (USE ONLY)

PERSONNEL _____ REFERENCE NO. 6 AB SHEET 9 OF 39


NOTES HUSS DATE 5-24-10 ROUTE SR 64
H.C. CANTERBURY WEATHER HOT COUNTY FULTON
R.C. FINTEL TEMP. 80° TOWNSHIP FULTON
SECTION 35
T 8 N R 4 E

TYPE MONUMENT 1 1/2" IPIPE
~~ON SURFACE~~ - BELOW 4"
~~LEFT~~ - CL PAV'T - RIGHT 2.5'
2.5' TO RT. EDGE PAVEMENT
S.L.M. 147+66
GRID: NOTHING: _____ EASTING: _____

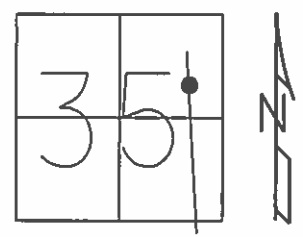

FD 1" IRON PIPE
4" DOWN 8/20/08

SET N/SHI. IN FENCE POST

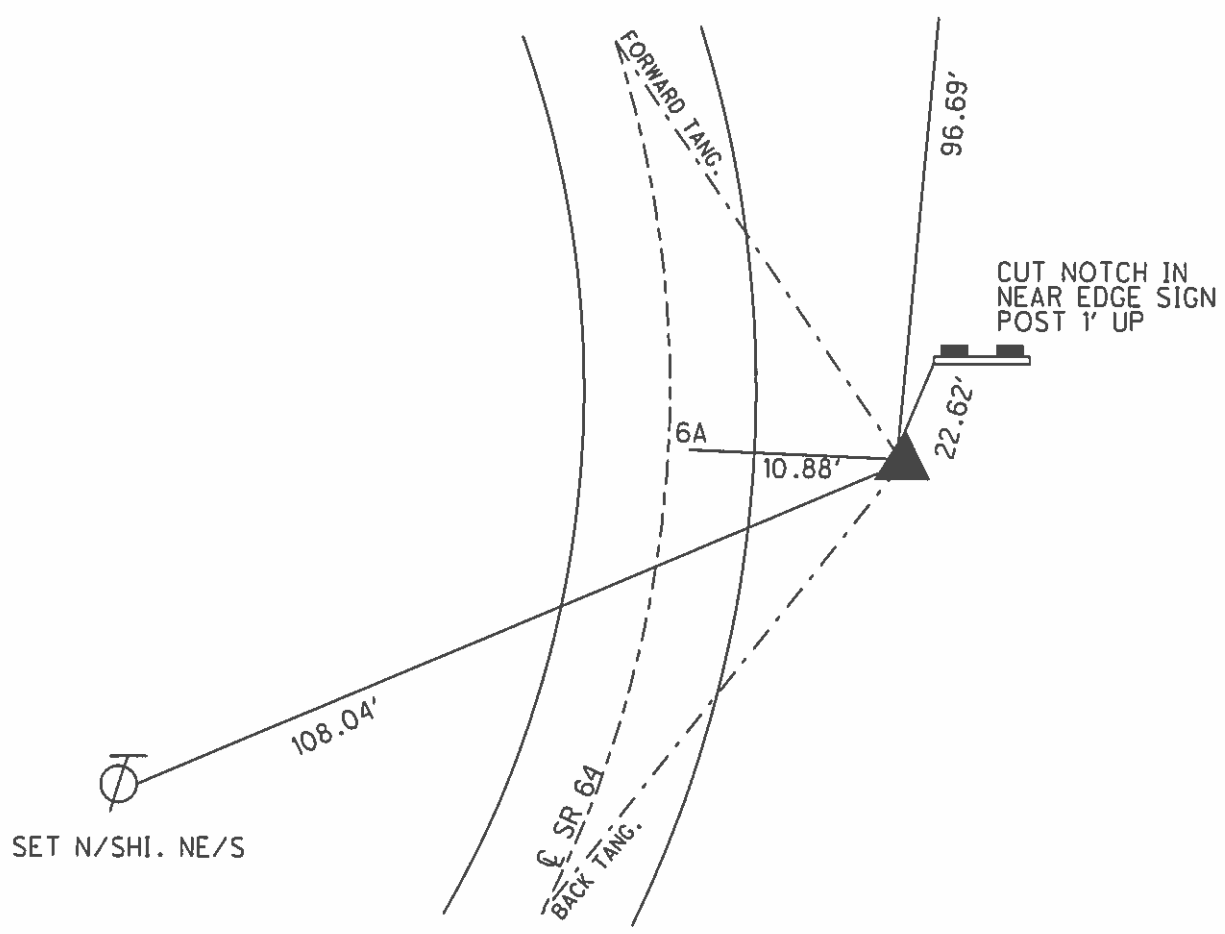

O.D.O.T. DISTRICT 2 SURVEY OFFICE

PERSONNEL _____

REFERENCE NO. 6A

SHEET 67 OF 20

NOTES D. CURTIS

H.C. CORDES

DATE 7-27-93

ROUTE S.R. #60

R.C. CANTONBERRY

WEATHER Hot

COUNTY FULTON

ROMGTO

TEMP. +87°

TOWNSHIP FULTON

SECTION 35

T 8 N R 4 E



TYPE MONUMENT S.M. R.R. SPK.

ON SURFACE - BELOW YES

LEFT-~~E~~ PAV'T. - RIGHT 2' RIGHT

7.7 TO RT. EDGE PAVEMENT

S.L.M. 137+70

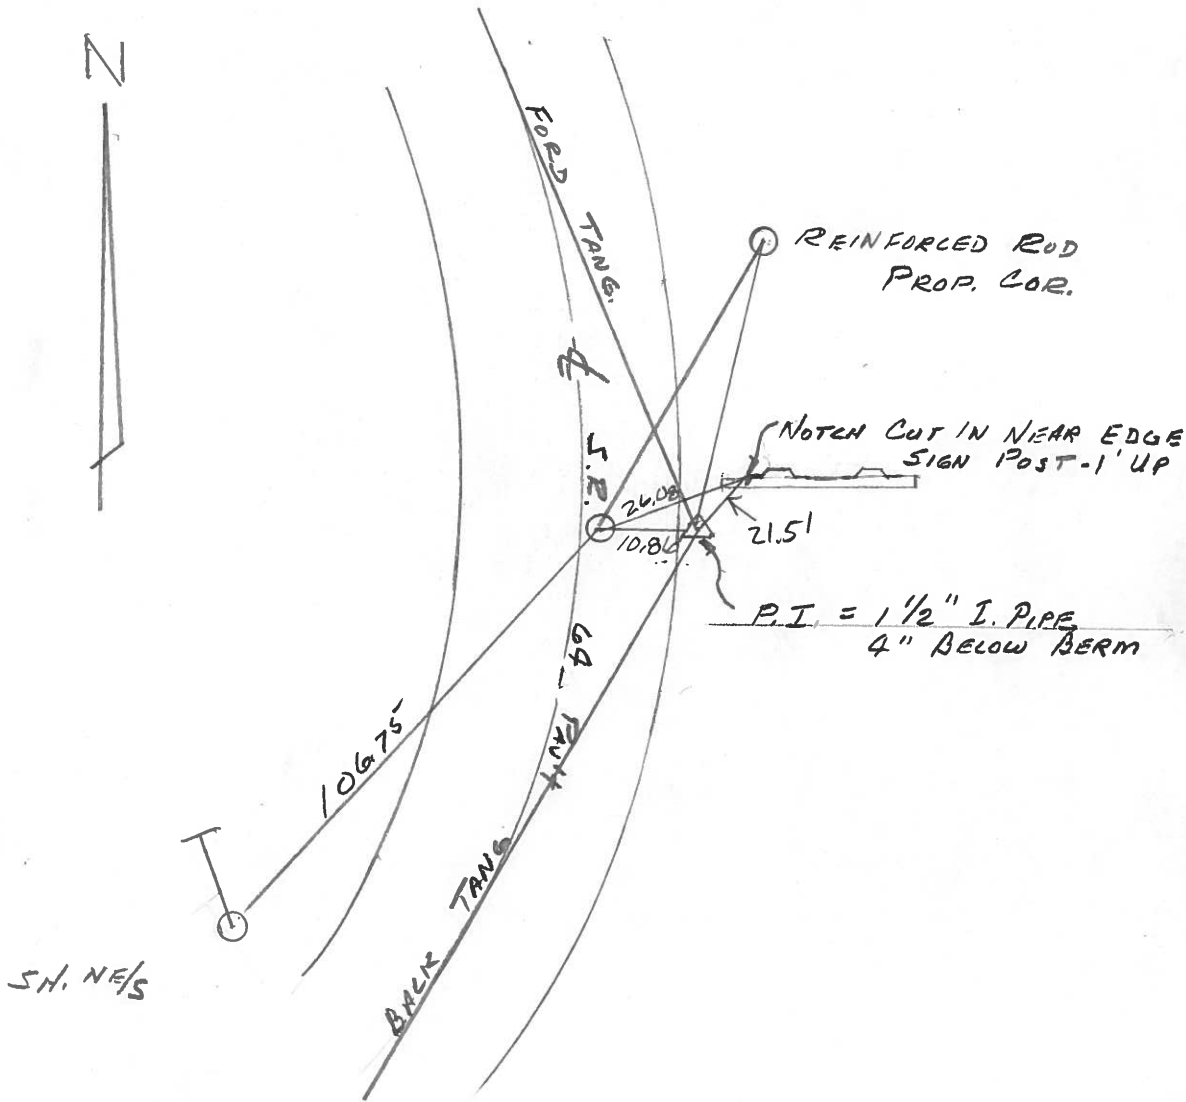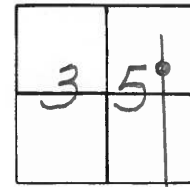

Q.D.O.T. DISTRICT 2 SURVEY OFFICE

SHEET 6-A OF

County Fulton S.R. 64

Date 20 April 84

Township Fulton

Weather Sunny

Section 35


Temp. 47°

T N, R E

Personnel I. Stone

P. Neuser

R. Michalak

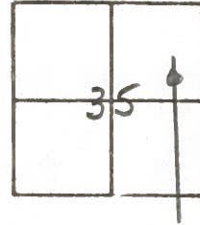


137+30

REF. NO. 6-A



Fd. 1" I. pipe 2" deep
Set
8.5' to E. edge put.
11.2' to W. edge put.
Reset Sm. 12. R. Spk.
To Surface - 6-18-84

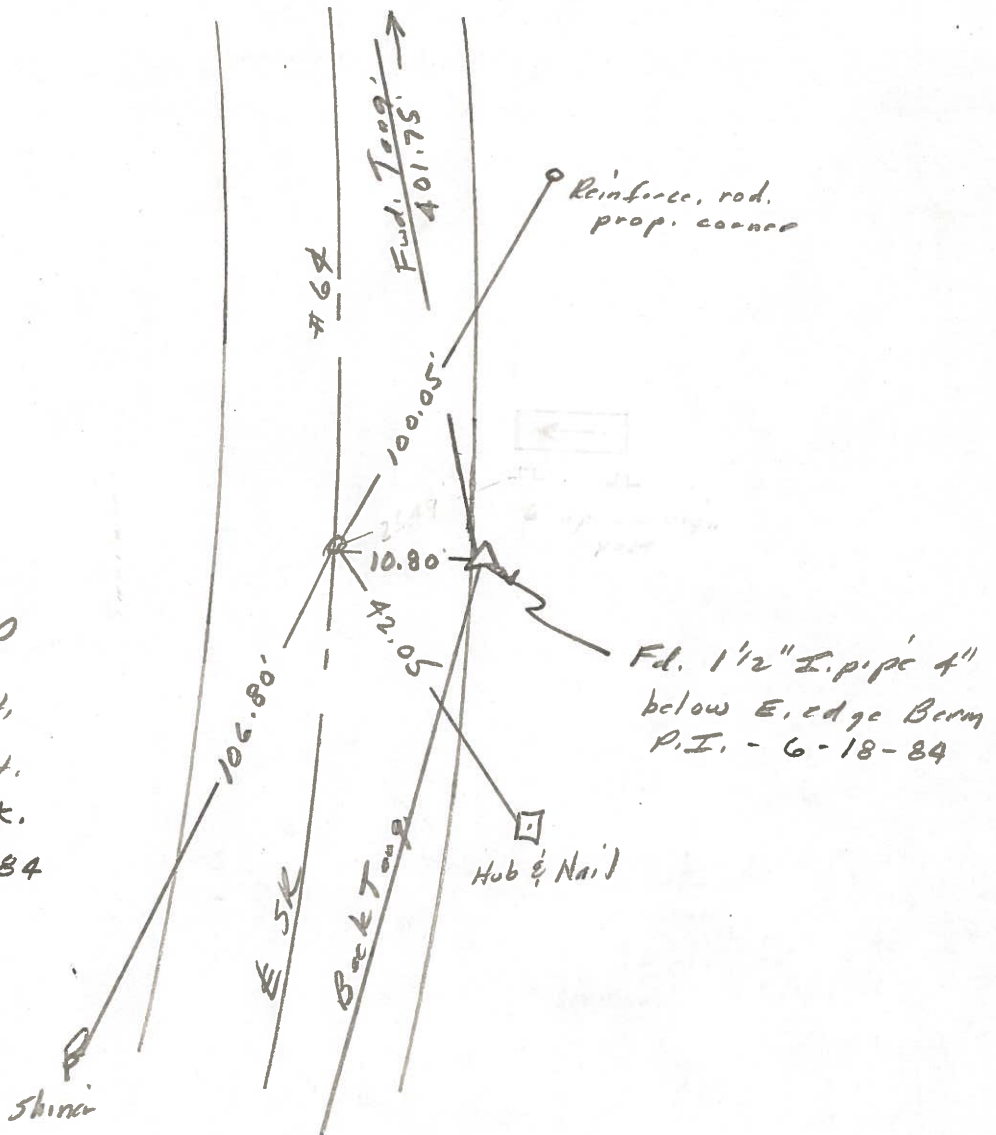

Shiner

PERSONNEL TITLE PERSONNEL TITLE COUNTY FULTON DATE Apr. 71
Red Beach _____
Newcomb _____
Knape _____
Wise _____
 S. R. 64 WEATHER _____
 SEC. Ful. Twp. Sec. 35 T-8-N TEMP. _____
 DESCRIPTION CONTROL POINTS JOB NO. _____

