

O.D.O.T. DISTRICT 2 SURVEY OFFICE (USE ONLY)

PERSONNEL

REFERENCE NO. 6 C

SHEET 31 OF 59

NOTES RHOADES

DATE 8/7/17

ROUTE SR 64

H.C. O'DONNELL

WEATHER FAIR

COUNTY FULTON

R.C. RHOADES

TEMP. 65°

TOWNSHIP FULTON

SECTION 35

DWG BY RHOADES PID PAVETRAIN

T 8 N R 4 E

TYPE MONUMENT 1 1/2" IPIPE

~~ON SURFACE~~ - BELOW 6"

OFFSET Q PAVEMENT 18.5' LT : ~~RT~~

8' LT TO LT EDGE PAVEMENT



STATION: 155+17.22

HORZ. DATUM: NAD83 2011

GEOID: NAVD88 2012A



GRID: NORTHING: 712299.525

EASTING: 1583877.149

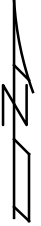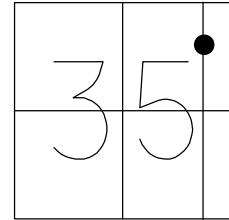

RECORD:
FD 1" IPIPE
3" DOWN
8/20/08
REFC6
8/28/08, SAH
FD 1 1/2" IPIPE
6" DOWN
REFC6
8/7/17, JFO

SET SHI
18" PINE

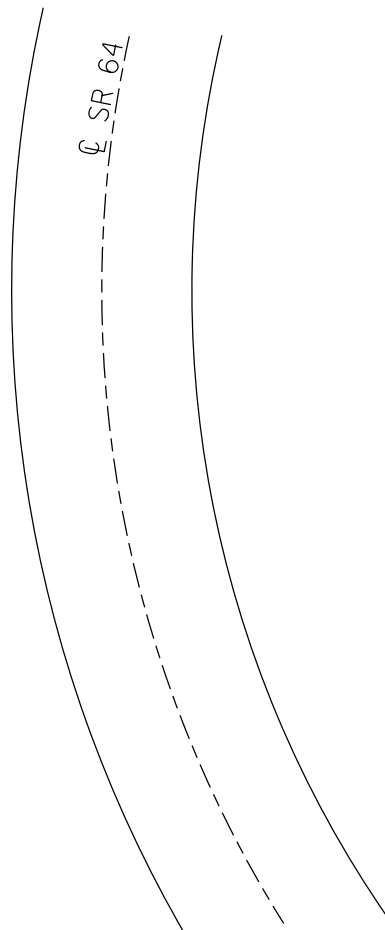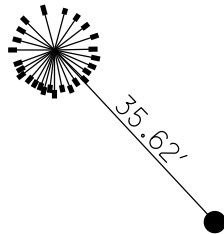

O.D.O.T. DISTRICT 2 SURVEY OFFICE (USE ONLY)

PERSONNEL _____ REFERENCE NO. 6 C SHEET 11 OF 39
 NOTES RHOADES DATE 8/7/17 ROUTE SR 64
 H.C. O'DONNELL WEATHER FAIR COUNTY FULTON
 R.C. RHOADES TEMP. 65° TOWNSHIP FULTON
 _____ SECTION 35
 _____ T 8 N R 4 E

TYPE MONUMENT 1 1/2" IPIPE


~~ON SURFACE~~ - BELOW 6"

LEFT - Q PAV'T - ~~RIGHT~~ 18.5'

8.0' LT TO LT EDGE PAVEMENT



S.L.M. 155+17.22

GRID: NOTHING: 712299.525 EASTING: 1583877.149

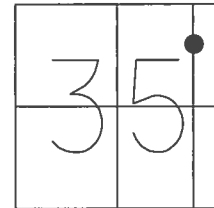

RECORD:
 FD 1" IPIPE
 3" DOWN
 8/20/08
 REFC6
 8/28/08, SAH
 FD 1 1/2" IPIPE
 6" DOWN
 REFC6
 8/7/17, JFO

SET SHI
 18" PINE

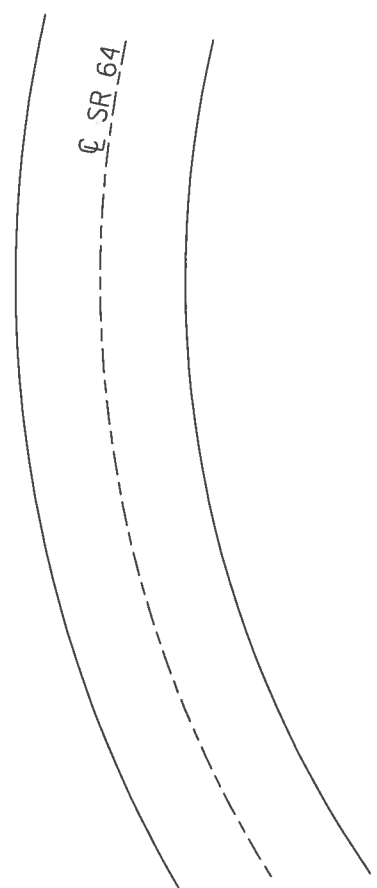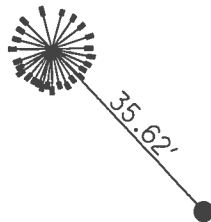

O.D.O.T. DISTRICT 2 SURVEY OFFICE (USE ONLY)

PERSONNEL	REFERENCE NO.	<u>6 C</u>	SHEET	<u>11</u>	OF	<u>39</u>
NOTES	<u>HUSS</u>	DATE	<u>7-28-10</u>	ROUTE	<u>SR 64</u>	
H.C.	<u>CANTERBURY</u>	WEATHER	<u>SUNNY</u>	COUNTY	<u>FULTON</u>	
R.C.	<u>FINTEL</u>	TEMP.	<u>87°</u>	TOWNSHIP	<u>FULTON</u>	
				SECTION	<u>35</u>	
				<u>T 8 N R 4 E</u>		

TYPE MONUMENT 1" IPIPE


~~ON SURFACE~~ - BELOW 3"

LEFT - ☉ PAV'T - ~~RIGHT~~ 18.5'

8.0' TO LT. EDGE PAVEMENT

S.L.M. 155+17.22


GRID: NOTHING: 712299.486 EASTING: 1583877.119

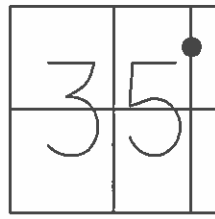

FD 1" IRON PIPE
3" DOWN 8/20/08

REFC6, VRS
8/28/08 SAH

SET MAG & WASHER
7-28-10 SAH

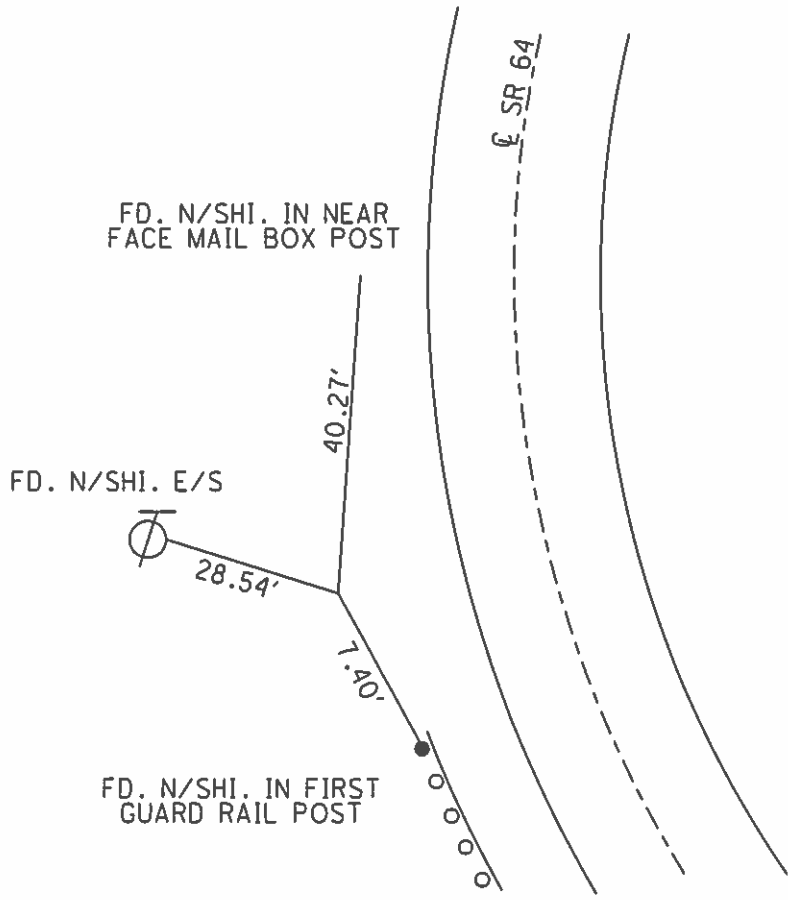

O.D.O.T. DISTRICT 2 SURVEY OFFICE

PERSONNEL

REFERENCE NO. 6-2

SHEET 69 OF 20

NOTES D. CURTIS

H.C. CORDES

DATE 7-27-93

ROUTE S. R. #64

R.C. CANTERRYBURY

WEATHER Sunny

COUNTY FULTON

ROMETO

TEMP. +87

TOWNSHIP FULTON

SECTION 35

T. 8 N R. 4 E



TYPE MONUMENT 1" IRON PIPE

ON SURFACE - BELOW 3" BELOW

LEFT - ~~0~~ PAV'T. - RIGHT 17.5 LEFT

7.0 TO LT. EDGE PAVEMENT

S.L.M. 144 + 90

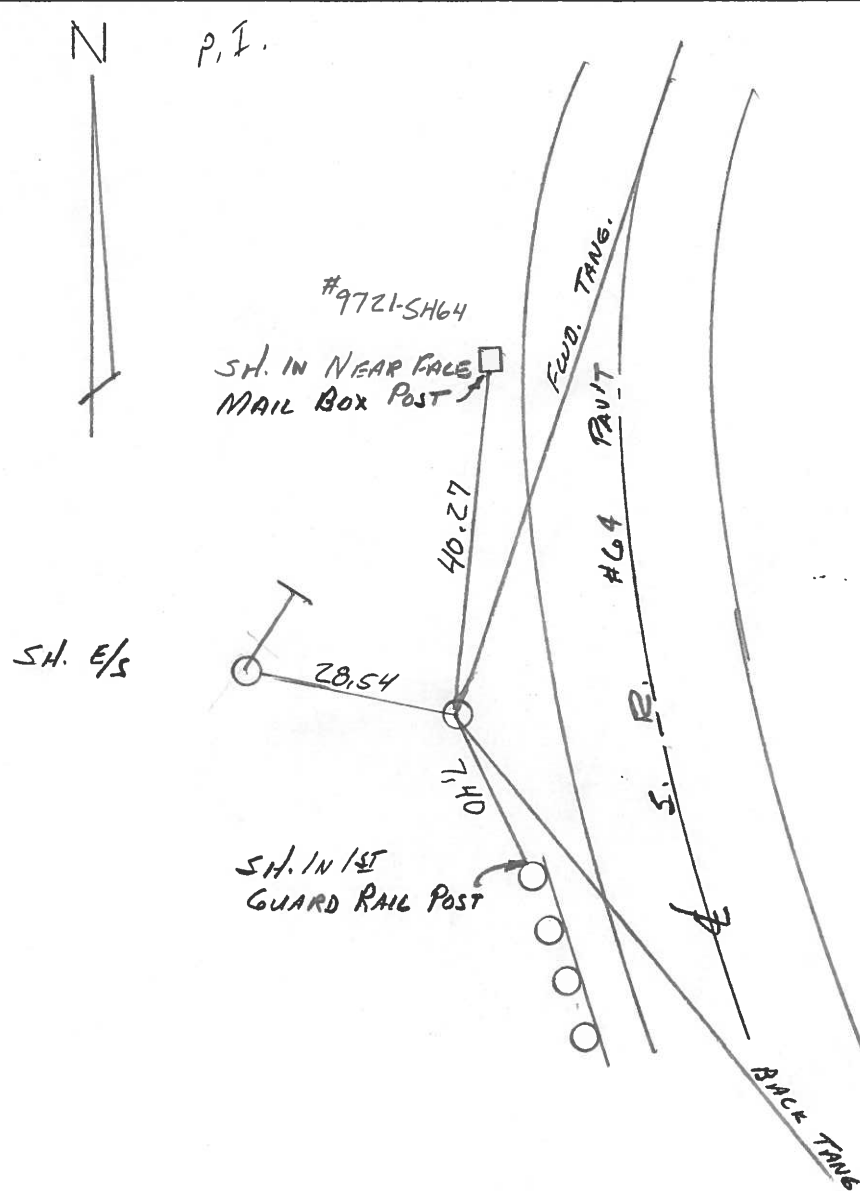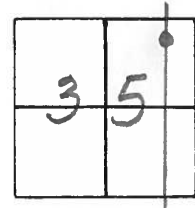

Q.D.O.T. DISTRICT 2 SURVEY OFFICE

SHEET 6-C OF

County Fulton S.R. 64

Date 20 April 84

Township Fulton

Weather Sunny

Section 35


Temp. 47°

T N, R E

Personnel I. Stone


P. Neuser

R. Michelak

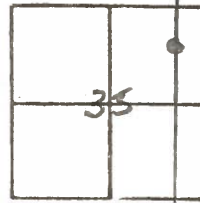

144+75

REF. NO. 6-C

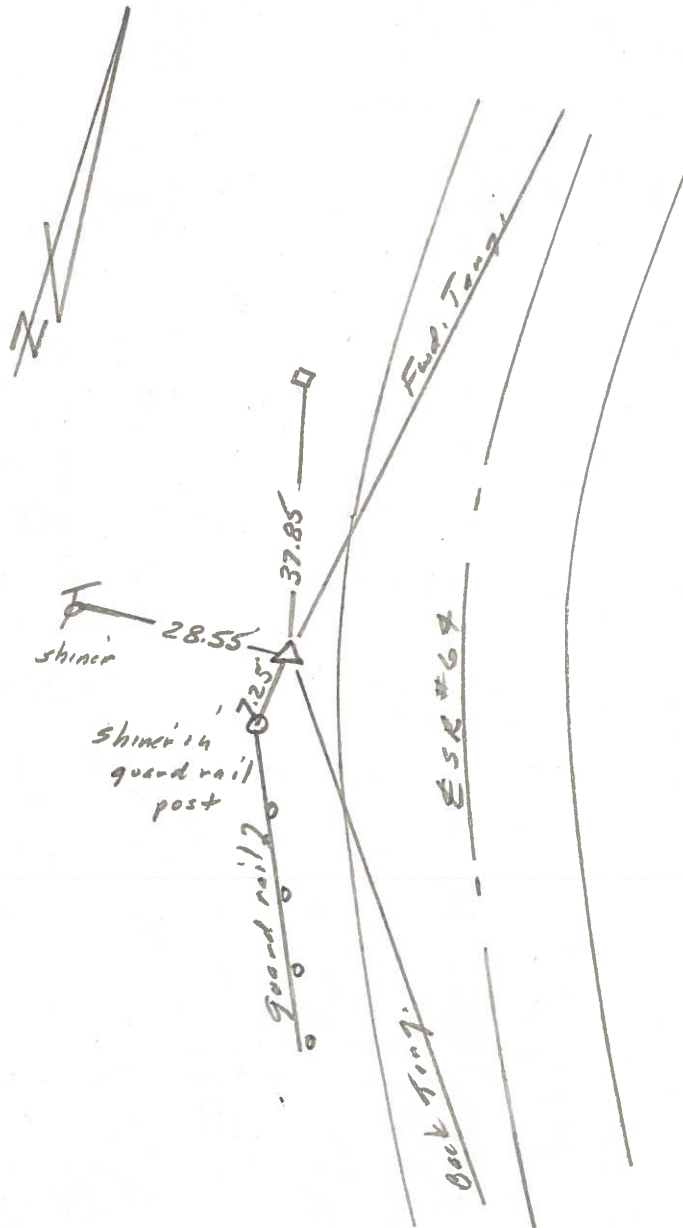


Fd. 1" I. pipe 3" deep -
Checked - 6-18-84

PERSONNEL TITLE PERSONNEL TITLE
 Red Beach
 Newcomb
 Knape
 Wise

COUNTY FULTON DATE Apr 1971
 S. R. 64 WEATHER
 SEC. NE 1/4 Sec. 35 Ful. Twp TEMP.

DESCRIPTION ALIGNMENT & CONTROLS LEFT CENTER LINE RIGHT JOB NO.

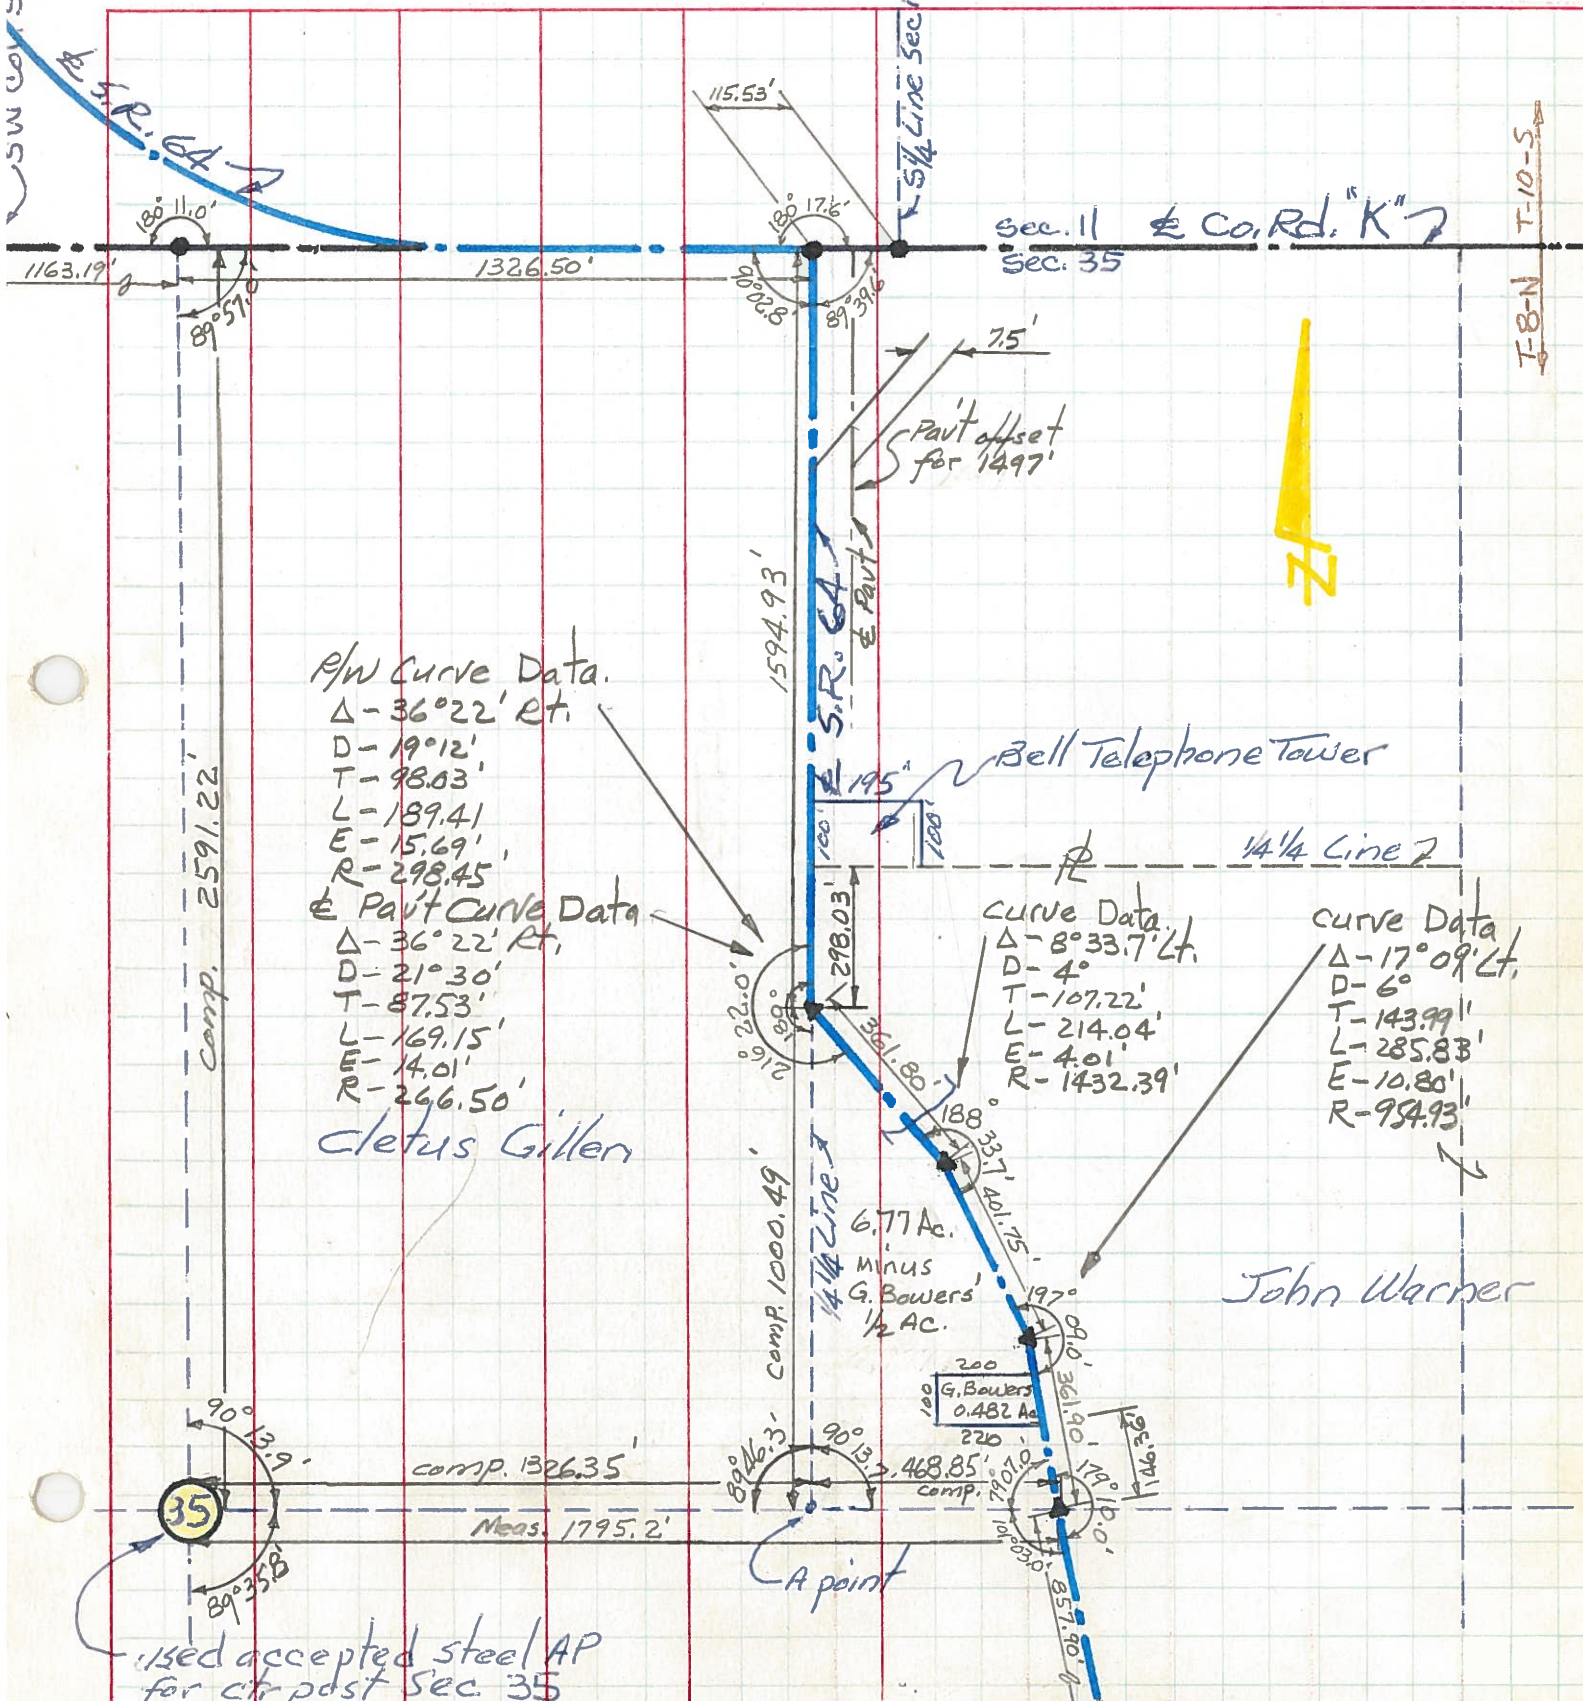

R/W Curve Data.
 $\Delta - 36^{\circ} 22'$ Rt.
 $D - 19^{\circ} 12'$
 $T - 98.03'$
 $L - 189.41$
 $E - 15.69'$
 $R - 298.45'$
 & Pavt Curve Data
 $\Delta - 36^{\circ} 22'$ Rt.
 $D - 21^{\circ} 30'$
 $T - 87.53'$
 $L - 169.15'$
 $E - 14.01'$
 $R - 266.50'$
 cletus Gillen

Curve Data
 $\Delta - 8^{\circ} 33.7'$ Lt.
 $D - 4^{\circ}$
 $T - 107.22'$
 $L - 214.04'$
 $E - 4.01'$
 $R - 1432.39'$

curve Data
 $\Delta - 17^{\circ} 09'$ Lt.
 $D - 6^{\circ}$
 $T - 143.99'$
 $L - 285.83'$
 $E - 10.80'$
 $R - 954.93'$

John Warner

used accepted steel AP for ctr. post Sec. 35

PERSONNEL TITLE PERSONNEL TITLE

Red Beach
Newcomb
Knappe
Wise

COUNTY FULTON

DATE APRIL 1971

S. R. 64

WEATHER

SEC. Fulton Twp.

TEMP.

DESCRIPTION PERTINENT DATA Co. Rd. K

JOB NO.

