



O.D.O.T. DISTRICT 2 SURVEY OFFICE (USE ONLY)

PERSONNEL _____ REFERENCE NO. 11 A SHEET 38 OF 59
 NOTES O'DONNELL DATE 6/15/21 ROUTE SR 64
 H.C. O'DONNELL WEATHER SUNNY COUNTY FULTON
 R.C. NIESE TEMP. 70° TOWNSHIP FULTON
 DWG BY RHOADES PID PAVETRAIN SECTION 2
 T 10 N R 4 E

TYPE MONUMENT MAG/WASHER
 ON SURFACE - ~~BELOW~~ ON
 OFFSET ☉ PAVEMENT ON LT : RT
9.6' TO LT EDGE PAVEMENT
 STATION: 259+43.61

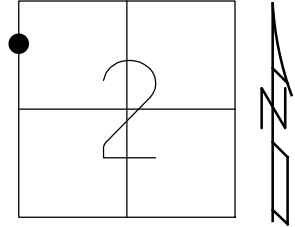

HORIZ.DATUM: NAD83 2011 GEOID: NAVD88 2018
 GRID: NORTHING: 721885.459 EASTING: 1581348.517

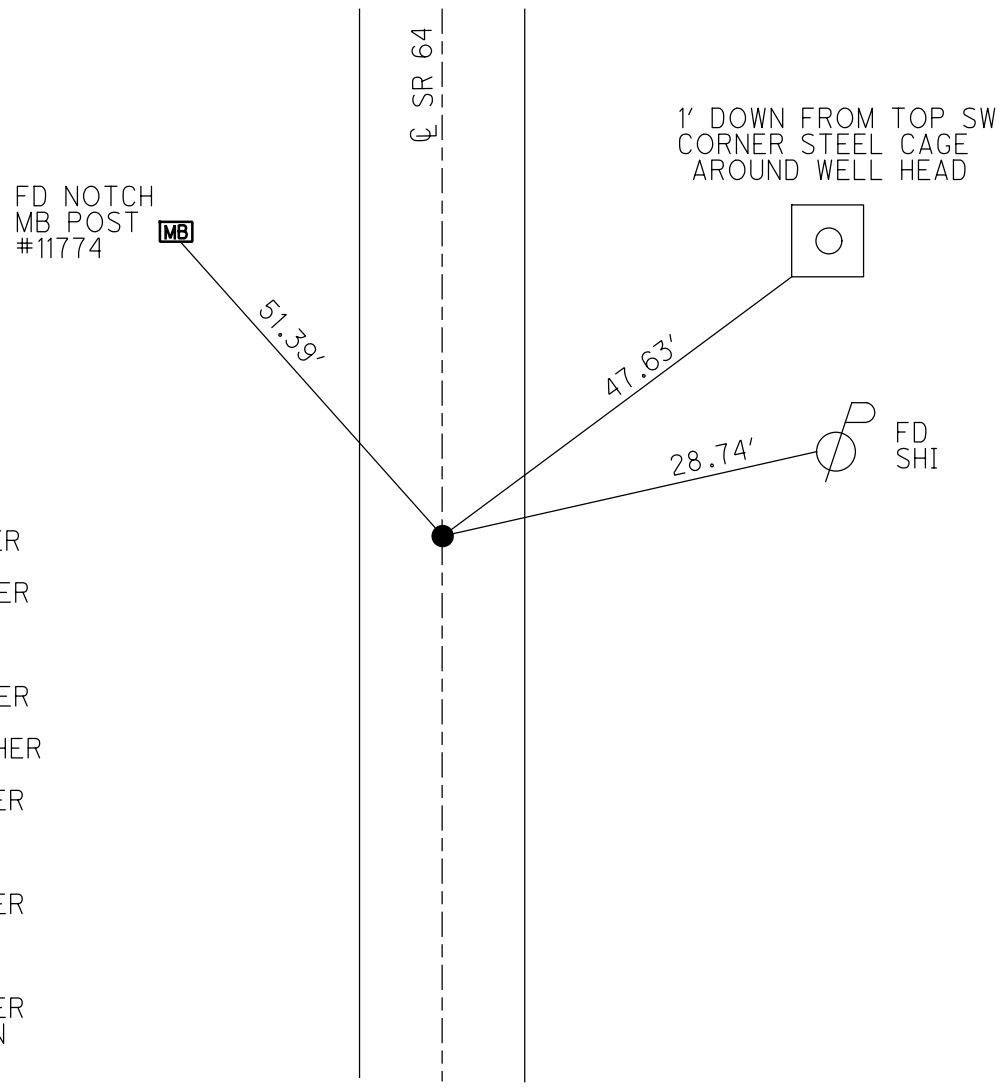


RECORD:
 SET PK/WASHER
 8/18/93
 FD P.K./WASHER
 8/20/08
 REFA11
 9/11/08, SAH
 FD P.K./WASHER
 5/25/10, SAH
 SET MAG/WASHER
 7-29-10, SAH
 FD MAG/WASHER
 REFA11
 8/10/17, JFO
 11/7/17, JFO
 FD MAG/WASHER
 REFA11
 6/15/21, JFO
 7/14/22, TDN
 FD MAG/WASHER
 12/29/22, TDN


O.D.O.T. DISTRICT 2 SURVEY OFFICE (USE ONLY)

PERSONNEL _____ REFERENCE NO. 11 A SHEET 18 OF 39
 NOTES O'DONNELL DATE 6/15/21 ROUTE SR 64
 H.C. O'DONNELL WEATHER SUNNY COUNTY FULTON
 R.C. NIESE TEMP. 70° TOWNSHIP FULTON
 DWG BY RHOADES PID NO PID R/W SECTION 2
 T 10 S R 4 E

TYPE MONUMENT MAG/WASHER
 ON SURFACE - ~~BELOW~~ ON
 OFFSET \varnothing PAVEMENT ON LT : RT
9.6' TO LT EDGE PAVEMENT
 STATION: 259+43.61

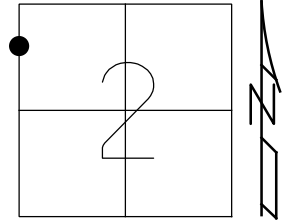

HORZ.DATUM: NAD83 2011 GEOID: NAVD88 2018
 GRID: NORTHING: 721885.506 EASTING: 1581348.523

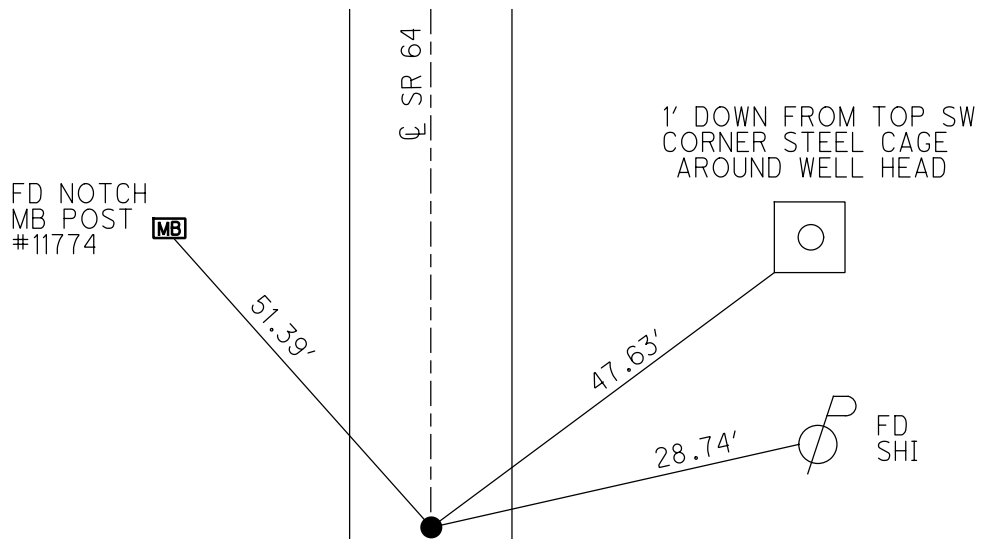

RECORD:
 SET PK/WASHER
 8/18/93
 FD P.K./WASHER
 8/20/08
 REFA11
 9/11/08, SAH
 FD P.K./WASHER
 5/25/10, SAH
 SET MAG/WASHER
 7-29-10, SAH
 FD MAG/WASHER
 REFA11
 8/10/17, JFO
 11/7/17, JFO
 FD MAG/WASHER
 REFA11
 6/15/21, JFO

O.D.O.T. DISTRICT 2 SURVEY OFFICE (USE ONLY)

PERSONNEL _____ REFERENCE NO. 11 A SHEET 18 OF 39
 NOTES HUSS DATE 5-25-10 ROUTE SR 64
 H.C. CANTERBURY WEATHER SUNNY COUNTY FULTON
 R.C. FINTEL TEMP. 84° TOWNSHIP FULTON
 _____ SECTION 2
 _____ T 10 S R 4 E


TYPE MONUMENT PK/WASHER

ON SURFACE - ~~BELOW~~ _____ ON _____
 LEFT - ☉ PAV'T - RIGHT _____ ON _____

9.6' TO LT EDGE PAVEMENT

S.L.M. 259+43.61

GRID: NOTHING: 721885.459 EASTING: 1581348.517

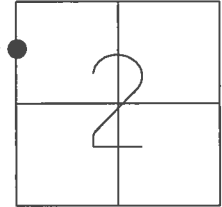

FD NOTCH
 MB POST
 #11774



51.39'

☉ SR 64

1' DOWN FROM TOP SW
 CORNER STEEL CAGE
 AROUND WELL HEAD




47.63'

28.74'



FD
 SHI

RECORD:
 SET PK/WASHER
 8/18/93
 FD P.K./WASHER
 8/20/08
 REFA11
 9/11/08, SAH
 FD P.K./WASHER
 5/25/10, SAH
 SET MAG/WASHER
 7-29-10, SAH
 FD MAG/WASHER
 REFA11
 8/10/17, JFO
 UNCOVERED
 11/7/17, JFO

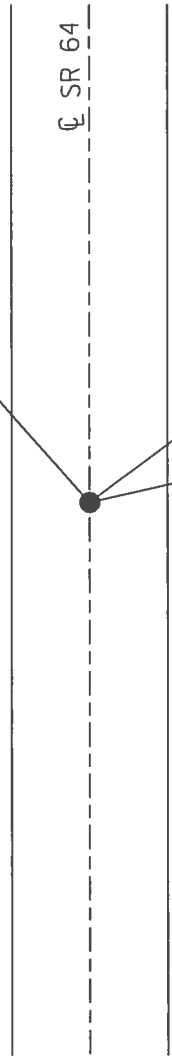

O.D.O.T. DISTRICT 2 SURVEY OFFICE (USE ONLY)

PERSONNEL _____ REFERENCE NO. 11 A SHEET 18 OF 39
 NOTES HUSS DATE 5-25-10 ROUTE SR 64
 H.C. CANTERBURY WEATHER SUNNY COUNTY FULTON
 R.C. FINTEL TEMP. 84° TOWNSHIP FULTON
 _____ SECTION 2
 _____ T 10 S R 4 E

TYPE MONUMENT PK/WASHER



ON SURFACE - ~~BELOW~~ _____ ON _____

LEFT - ☉ PAV'T - ~~RIGHT~~ _____ 0.2'

9.6' TO LT. EDGE PAVEMENT

S.L.M. 269+43.61

GRID: NOTHING: 721885.471 EASTING: 1581348.433

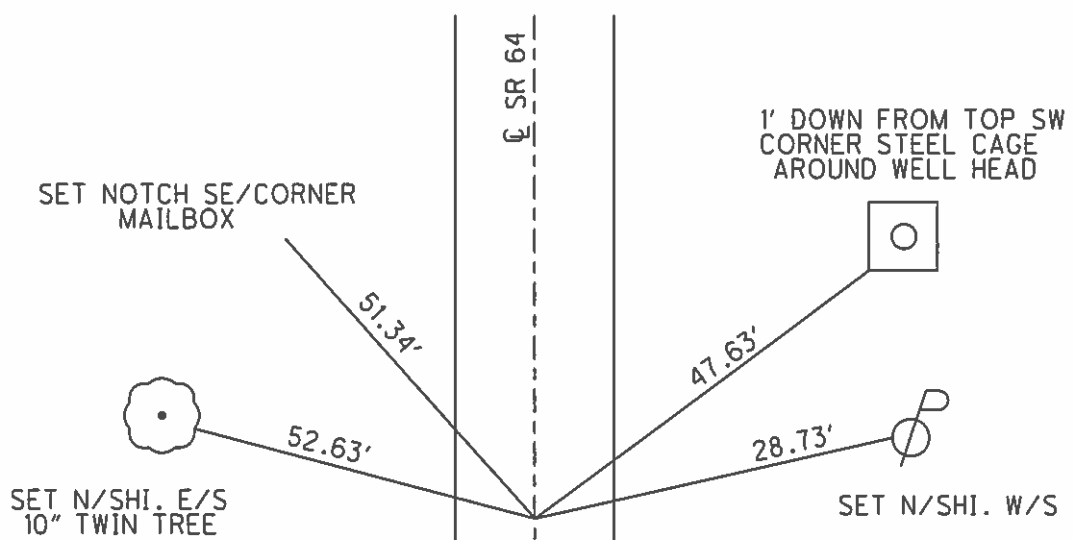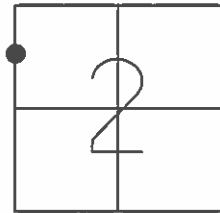

SET PK/WASHER
8/18/93

FD P.K. & WASHER
8/20/08

REFA11, VRS
9/11/08 SAH

SET MAG & WASHER
7-29-10 SAH

O.D.O.T. DISTRICT 2 SURVEY OFFICE

PERSONNEL

REFERENCE NO. 11-A

SHEET 15 OF 20

NOTES D. CURTIS

H.C. CORDES

DATE 7-27-93

ROUTE S.R. 64

R.C. CANTERBURY

WEATHER Sunny

COUNTY FULTON

ROMETO

TEMP. +90

TOWNSHIP FULTON

SECTION 2

SET P.K. & WASHER
8-18-93

T10 S R 4 E



TYPE MONUMENT SMALL R.R. SPK.

ON SURFACE - BELOW 2" BELOW

LEFT & PAV'T. - RIGHT ON & PAV'T

9.8 TO Lt EDGE PAVEMENT

S.L.M. 259 + 45

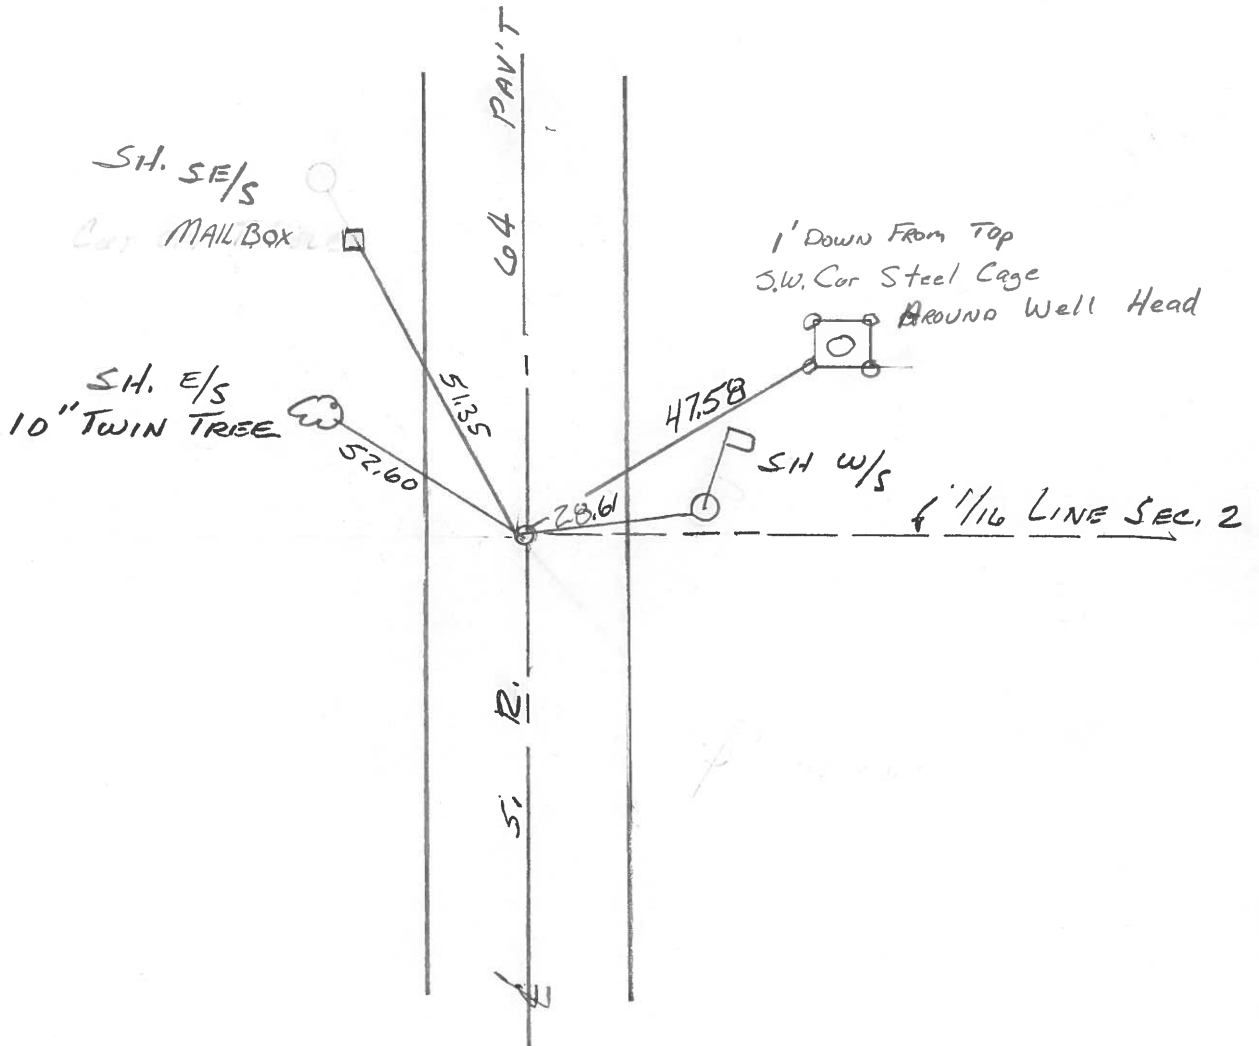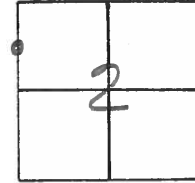

OD.O.T. DISTRICT 2 SURVEY OFFICE

SHEET 11-A OF

County Fulton S.R. 64

Date 19 April 84

Township Fulton

Weather Sunny

Section 2

Temp. 43°


T N, R E

Personnel I. Stone

P. Neuser


R. Michelak

D. Curtis

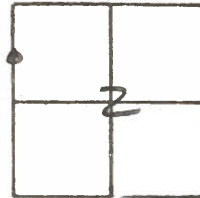

259 + 10

REF. NO. 11-A

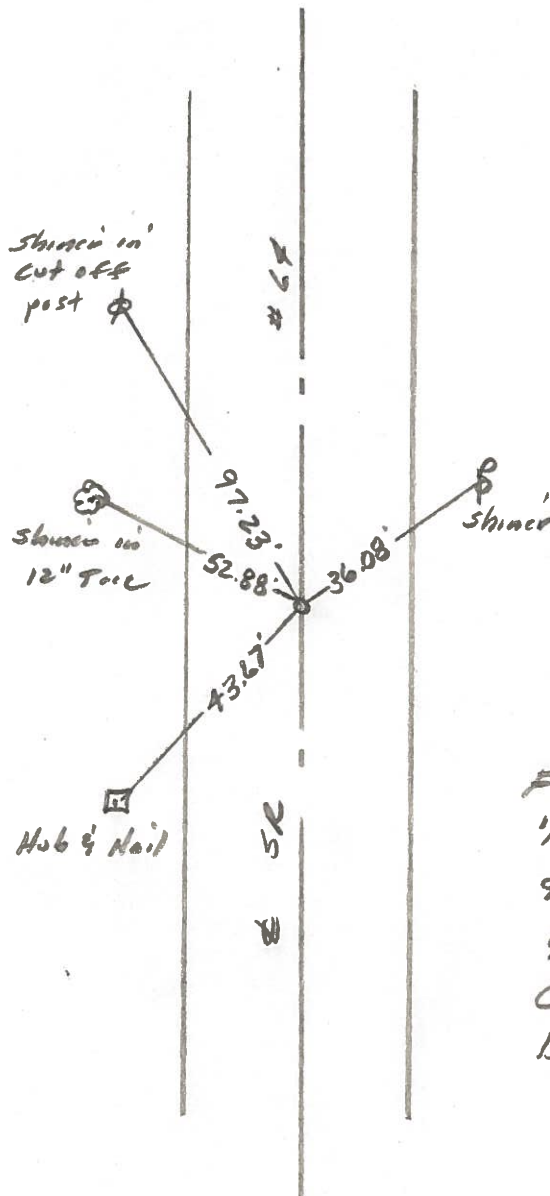

Fd. RR Spk To Surface
1/16 corner
9.4' to W. edge put.
9.1' to E. edge put.
Checked & Fd. R.R. Spk. 2
below Surface - 6-18-84