



O.D.O.T. DISTRICT 2 SURVEY OFFICE (USE ONLY)

PERSONNEL _____ REFERENCE NO. 17 D SHEET 49 OF 59
 NOTES RHOADES DATE 6/22/21 ROUTE SR 64
 H.C. AUBLE WEATHER SUNNY COUNTY FULTON
 R.C. NIESE TEMP. 59° TOWNSHIP AMBOY
 DWG BY NIESE PID 101213 SECTION 23
 T 9 N R 4 E

TYPE MONUMENT MAG/WASHER
 ON SURFACE - ~~BELOW~~ ON
 OFFSET 9.9' CL PAVEMENT 0.6' RT : RT
9.9' TO LT EDGE PAVEMENT
 STATION: 413+25.43

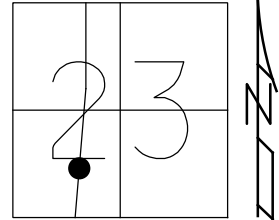

HORZ.DATUM: NAD83(2011) GEOID: NAVD88 2012A
 GRID: NORTHING: 734977.824 EASTING: 1582854.447

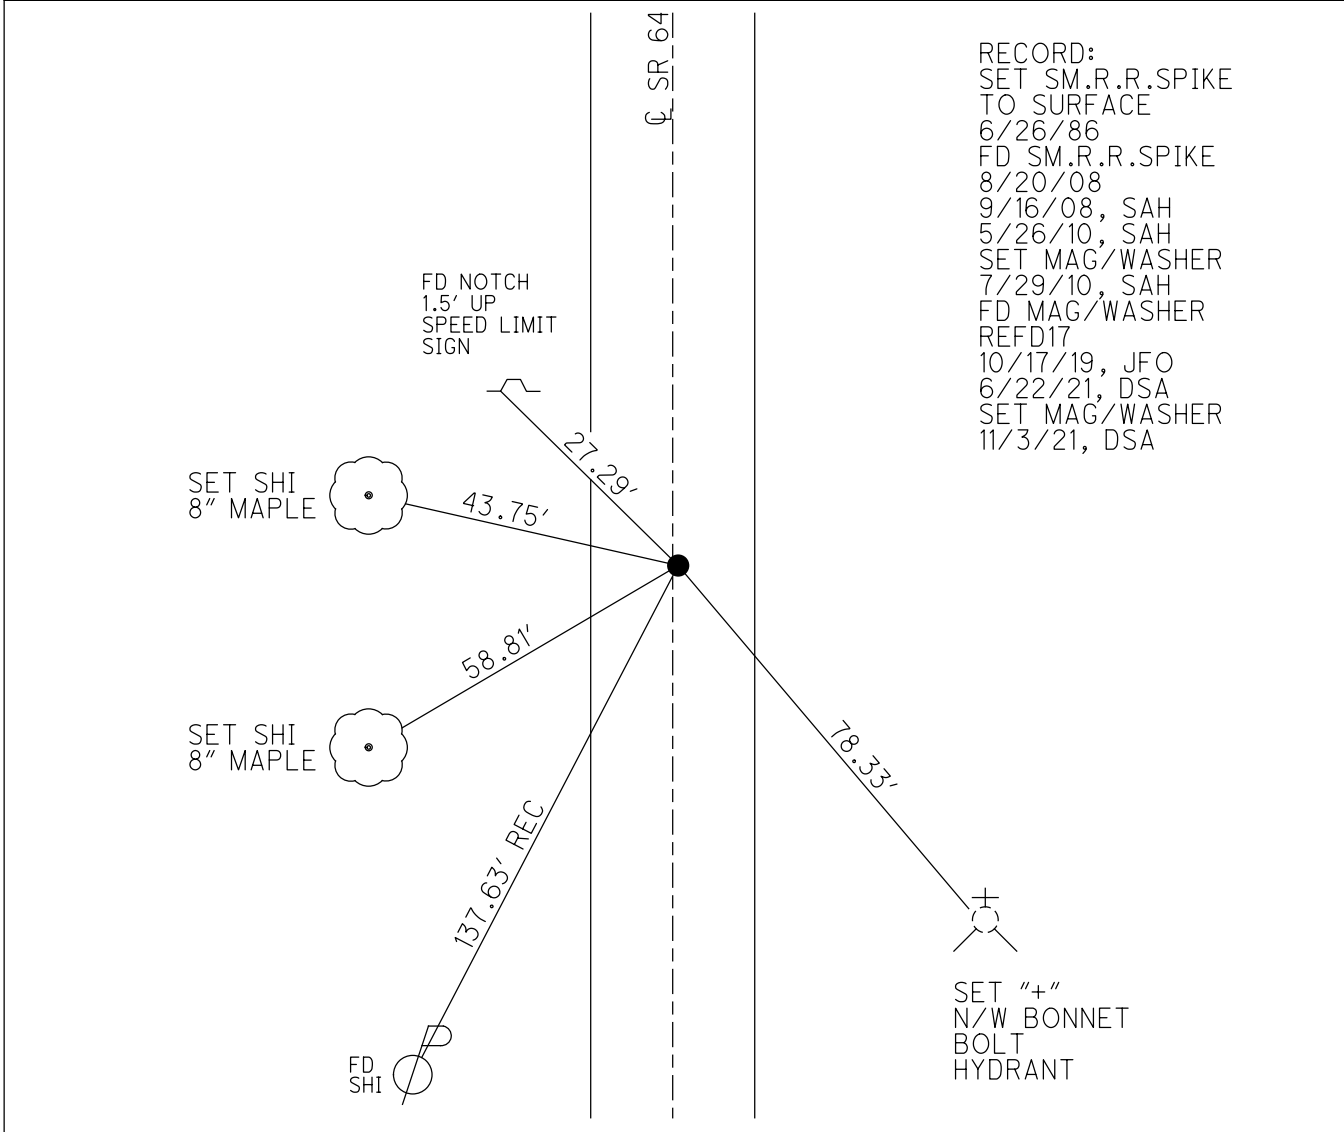

RECORD:
 SET SM.R.R.SPIKE
 TO SURFACE
 6/26/86
 FD SM.R.R.SPIKE
 8/20/08
 9/16/08, SAH
 5/26/10, SAH
 SET MAG/WASHER
 7/29/10, SAH
 FD MAG/WASHER
 REFD17
 10/17/19, JFO
 6/22/21, DSA
 SET MAG/WASHER
 11/3/21, DSA

O.D.O.T. DISTRICT 2 SURVEY OFFICE (USE ONLY)

PERSONNEL

REFERENCE NO. 17 D SHEET 29 OF 39

NOTES HUSS
 H.C. FINTEL
 R.C. CANTERBURY

DATE 5-26-10
 WEATHER SUNNY
 TEMP. 84°

ROUTE SR 64
 COUNTY FULTON
 TOWNSHIP AMBOY
 SECTION 23
 T 9 N R 4 E

TYPE MONUMENT SM. R.R. SPIKE



ON SURFACE - ~~BELOW~~ ON

LEFT - ☉ PAV'T - ~~RIGHT~~ 0.6'

9.9' TO LT EDGE PAVEMENT

S.L.M. 413+25.43

GRID: NOTHING: 734977.861 EASTING: 1582854.542

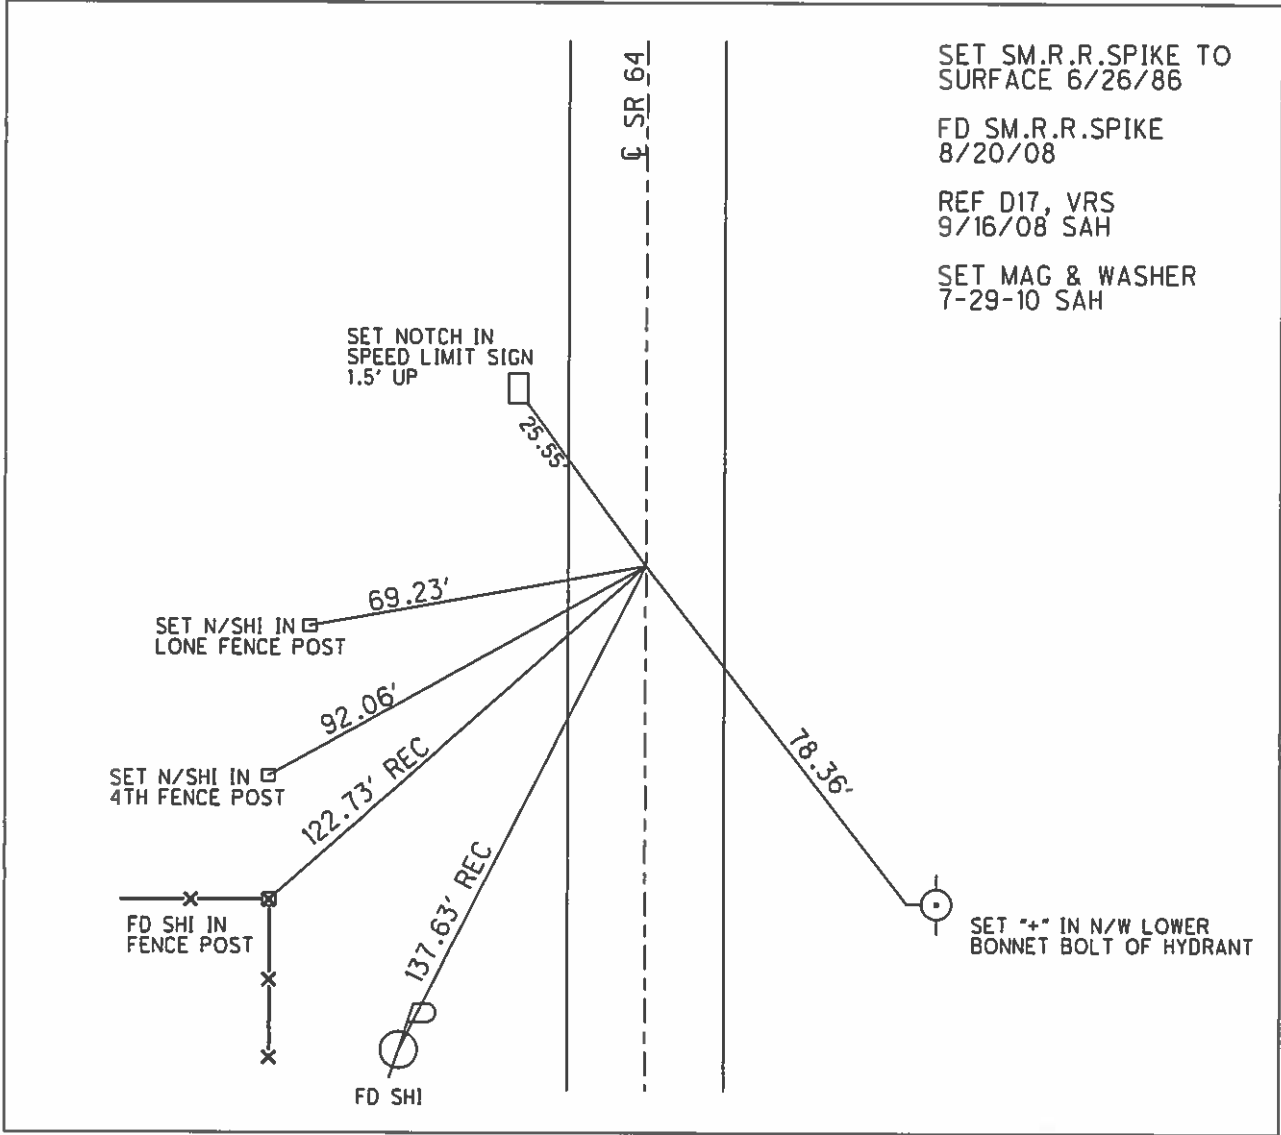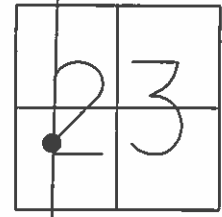

SET SM.R.R.SPIKE TO SURFACE 6/26/86
 FD SM.R.R.SPIKE 8/20/08
 REF D17, VRS 9/16/08 SAH
 SET MAG & WASHER 7-29-10 SAH

O.D.O.T. DISTRICT 2 SURVEY OFFICE

PERSONNEL

REFERENCE NO. 17-D

SHEET 4 OF

NOTES 1. Stone

H.C. D. Curtis

R.C. R. Michalek

DATE 28 April 86

WEATHER Nice

TEMP. 67°

ROUTE SR #64

COUNTY Fulton

TOWNSHIP Amboy

SECTION 23

T R


TYPE MONUMENT 3/4" I. pipe

ON SURFACE - BELOW 2" deep


LEFT - PAV'T. - RIGHT

 TO EDGE PAVEMENT

S.L.M. 401+81

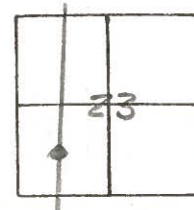

Set Sm. 12.12. Spk. To Surface -
6-26-86

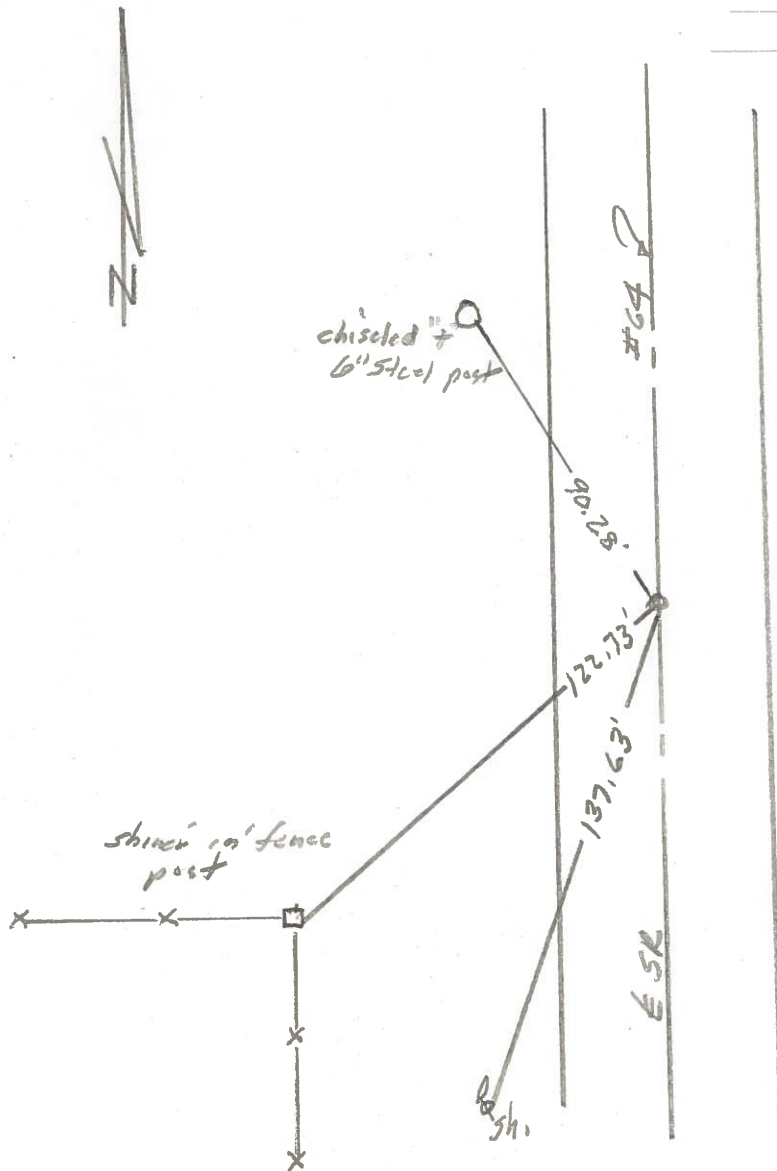

PERSONNEL	TITLE	PERSONNEL	TITLE	COUNTY	DATE
Tomsic		Boyle		Fulton	Aug 13, 1973
Neuser				S. R.	6A
Granata				SEC.	Amboy Twp.
Vandy				TEMP.	

DESCRIPTION LEFT CENTER LINE RIGHT JOB NO.

