

O.D.O.T. DISTRICT 2 SURVEY OFFICE (USE ONLY)

PERSONNEL

REFERENCE NO. 17 E

SHEET 50 OF 59

NOTES RHOADES

DATE 6/22/21

ROUTE SR 64

H.C. AUBLE

WEATHER SUNNY

COUNTY FULTON

R.C. NIESE

TEMP. 59°

TOWNSHIP AMBOY

SECTION 23

DWG BY NIESE

PID 101213

T 9 S R 4 E

TYPE MONUMENT MAG NAIL

ON SURFACE - ~~BELOW~~ ON

OFFSET Q PAVEMENT ON LT : RT

8.8' TO LT EDGE PAVEMENT


STATION: 415+82.56

HORIZ.DATUM: NAD83(2011)


GEOID: NAVD88 2012A

GRID: NORTHING: 735234.156

EASTING: 1582874.714

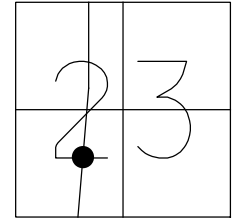


RECORD:
 SET SM. RR SPIKE
 TO SURFACE
 6/26/86
 FD SM.R.R.SPIKE
 8/20/08
 9/16/08, SAH
 5/26/10, SAH
 SET MAG & WASHER
 7/29/10, SAH
 FD MAG NAIL
 REFE17
 10/17/19, JFO
 6/22/21, DSA
 SET MAG/WASHER
 11/3/21, DSA

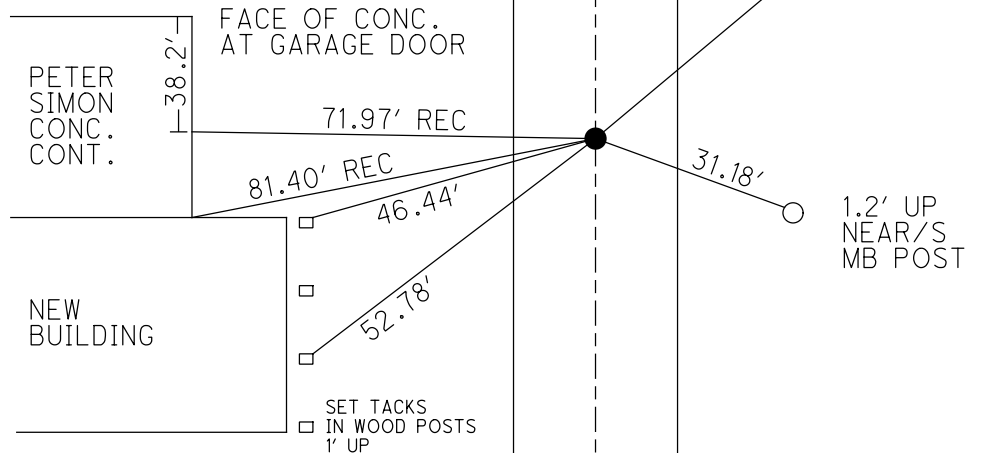


O.D.O.T. DISTRICT 2 SURVEY OFFICE (USE ONLY)

PERSONNEL _____ REFERENCE NO. 17 E SHEET 30 OF 39
 NOTES HUSS DATE 5-26-10 ROUTE SR 64
 H.C. FINTEL WEATHER SUNNY COUNTY FULTON
 R.C. CANTERBURY TEMP. 84° TOWNSHIP AMBOY
 _____ SECTION 23
 _____ T. 9 N R. 4 E

TYPE MONUMENT SM. R.R. SPIKE
 ON SURFACE - ~~BELOW~~ ON
 LEFT - CL PAV'T - ~~RIGHT~~ 0.8'
8.8' TO LT. EDGE PAVEMENT
 S.L.M. 415+82.53

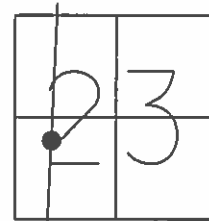

GRID: NOTHING: 735234.169 EASTING: 1582874.723

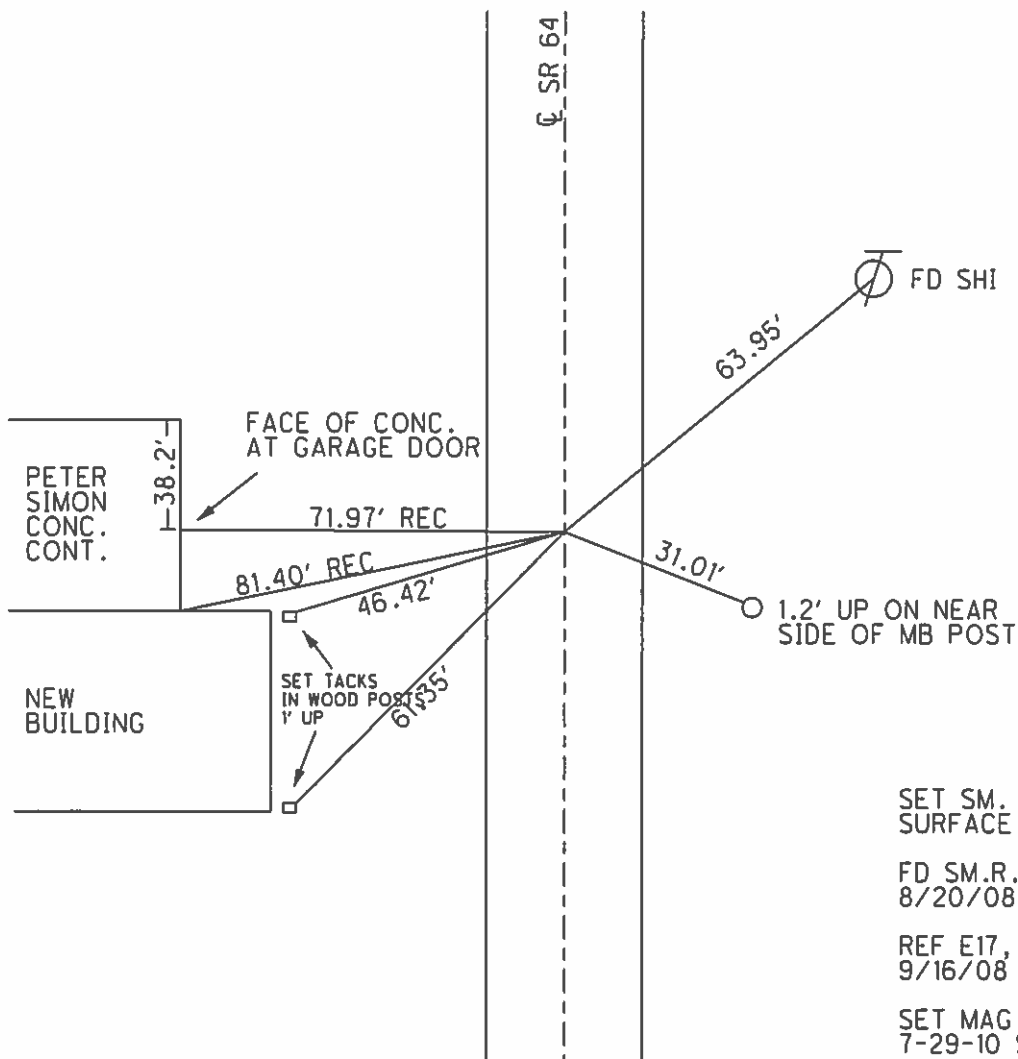

SET SM. RR SPIKE TO SURFACE 6/26/86
 FD SM.R.R.SPIKE 8/20/08
 REF E17, VRS 9/16/08 SAH
 SET MAG & WASHER 7-29-10 SAH

O.D.O.T. DISTRICT 2 SURVEY OFFICE

PERSONNEL _____

REFERENCE NO. 17-E

SHEET 5 OF _____

NOTES 1. Stone

H.C. D. Curtis

R.C. R. Michalak

DATE 28 April 1986

WEATHER Nice

TEMP. 67°

ROUTE SR#64

COUNTY Fulton

TOWNSHIP Amboyn

SECTION 23

T _____ R _____


TYPE MONUMENT 1" I. pipe

ON SURFACE - BELOW 2" deep


LEFT - ☉ PAV'T. - RIGHT _____

TO _____ EDGE PAVEMENT

S.L.M. 404+38

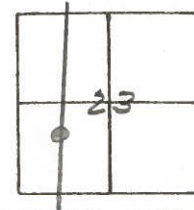


Set Sm. R.R. Spk To Surface -
6-26-86

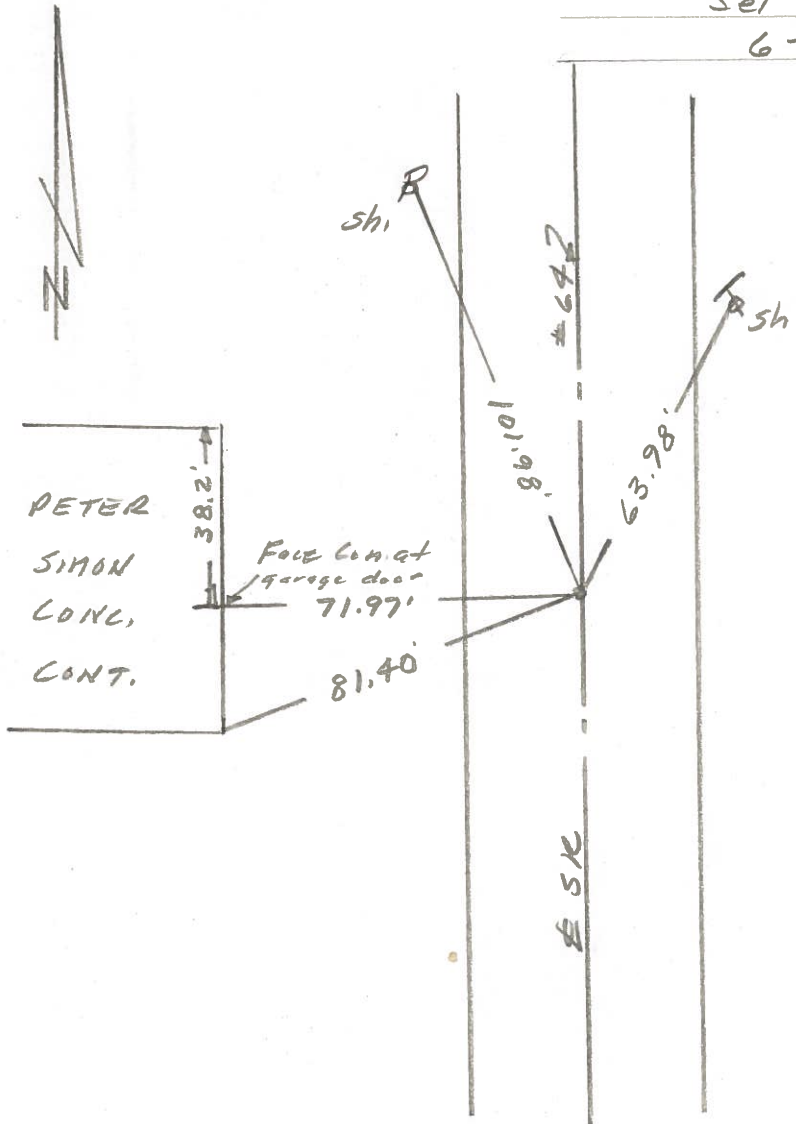

PERSONNEL	TITLE	PERSONNEL	TITLE	COUNTY	DATE	WEATHER	TEMP.
Tomsic		Boyle		Fulton	AUG 13, 1973		
Neuser				S. R. 64			
Granata				SEC. Amboy TWP.			
Vandy							

DESCRIPTION LEFT CENTER LINE RIGHT JOB NO.

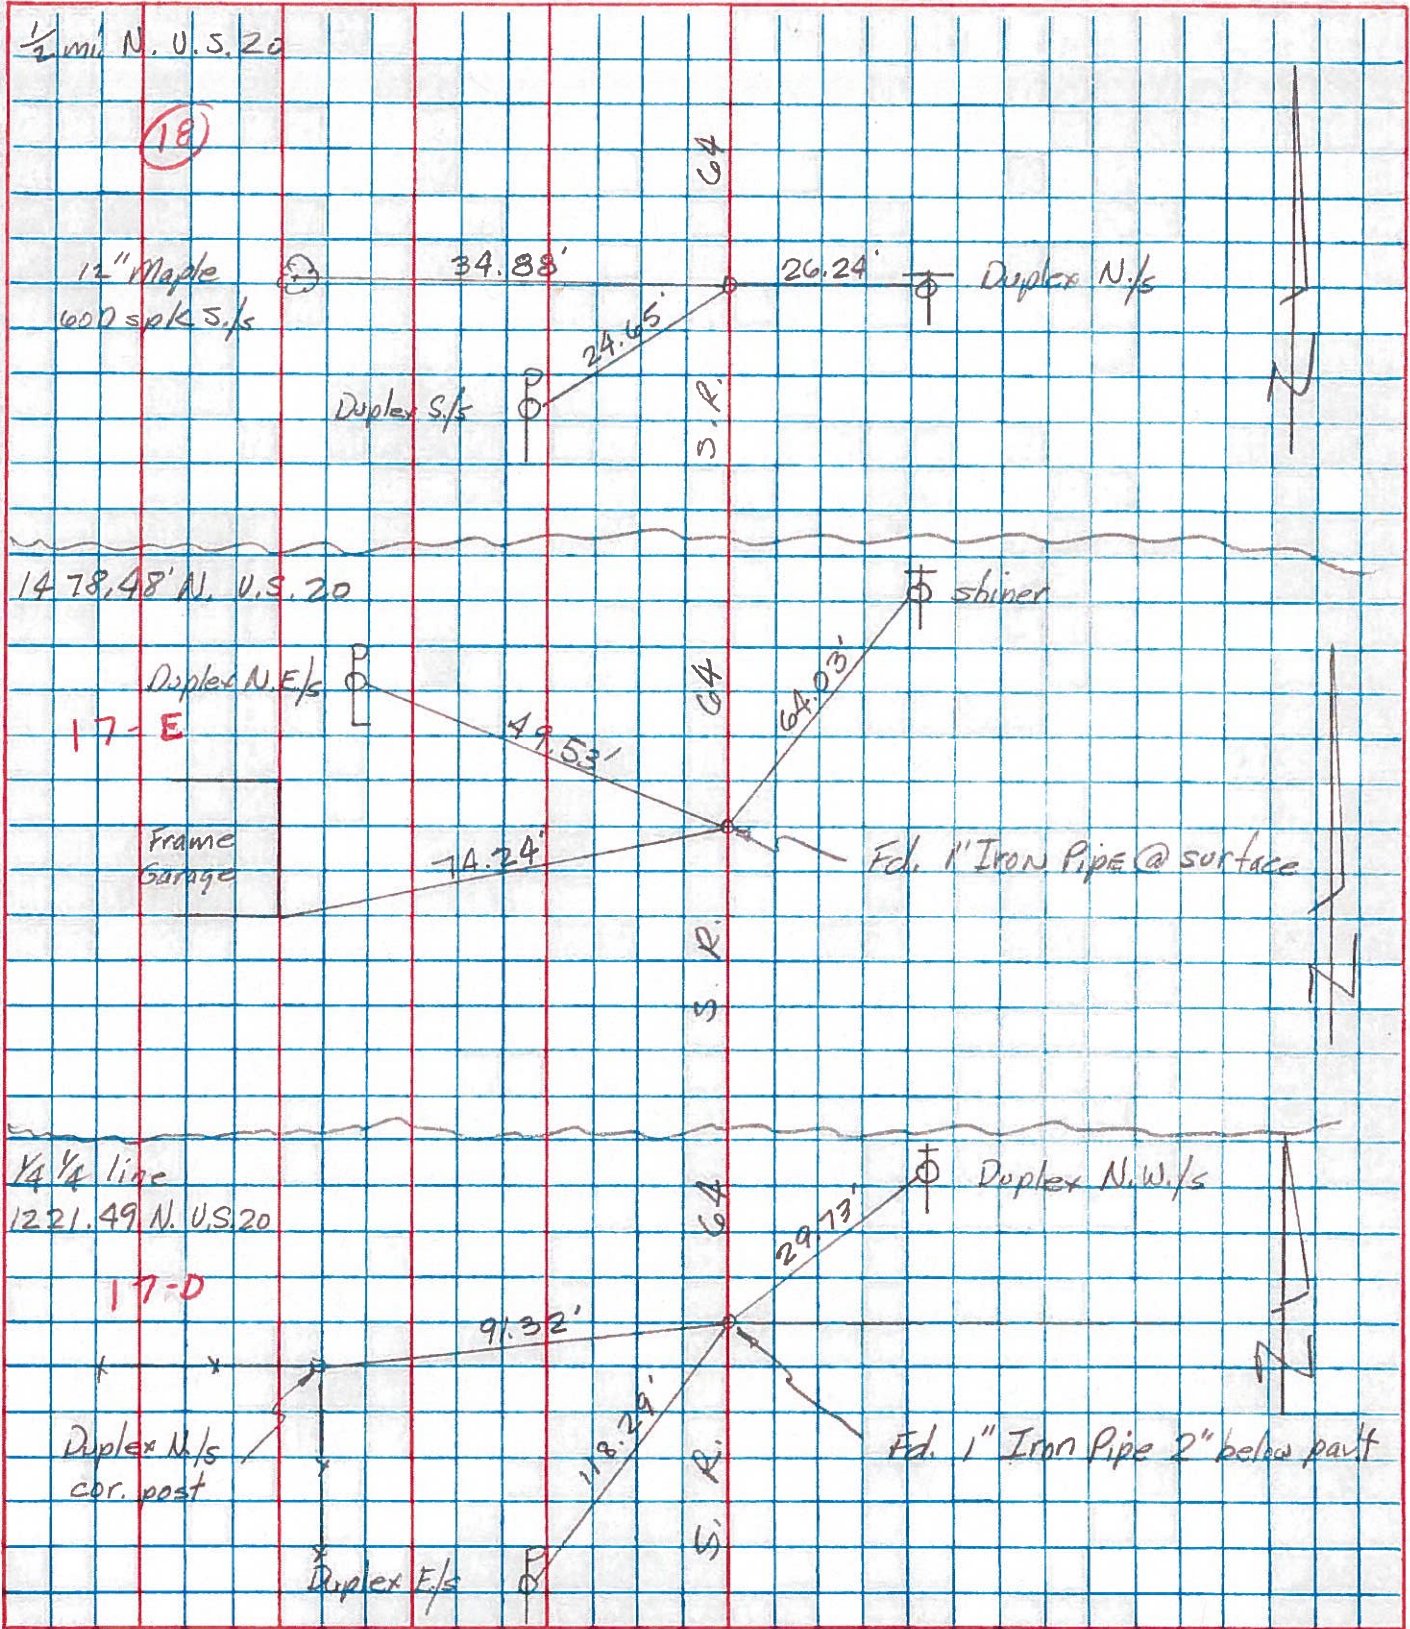


PERSONNEL TITLE PERSONNEL TITLE COUNTY Fulton DATE May '71
Red Beach _____
Newcomb _____
Knape _____
Wise _____

S. R. 64 WEATHER _____

SEC. SW 1/4 Sec. 23, Amboy TEMP. _____

DESCRIPTION ALIGNMENT & CONTROLS JOB NO. _____

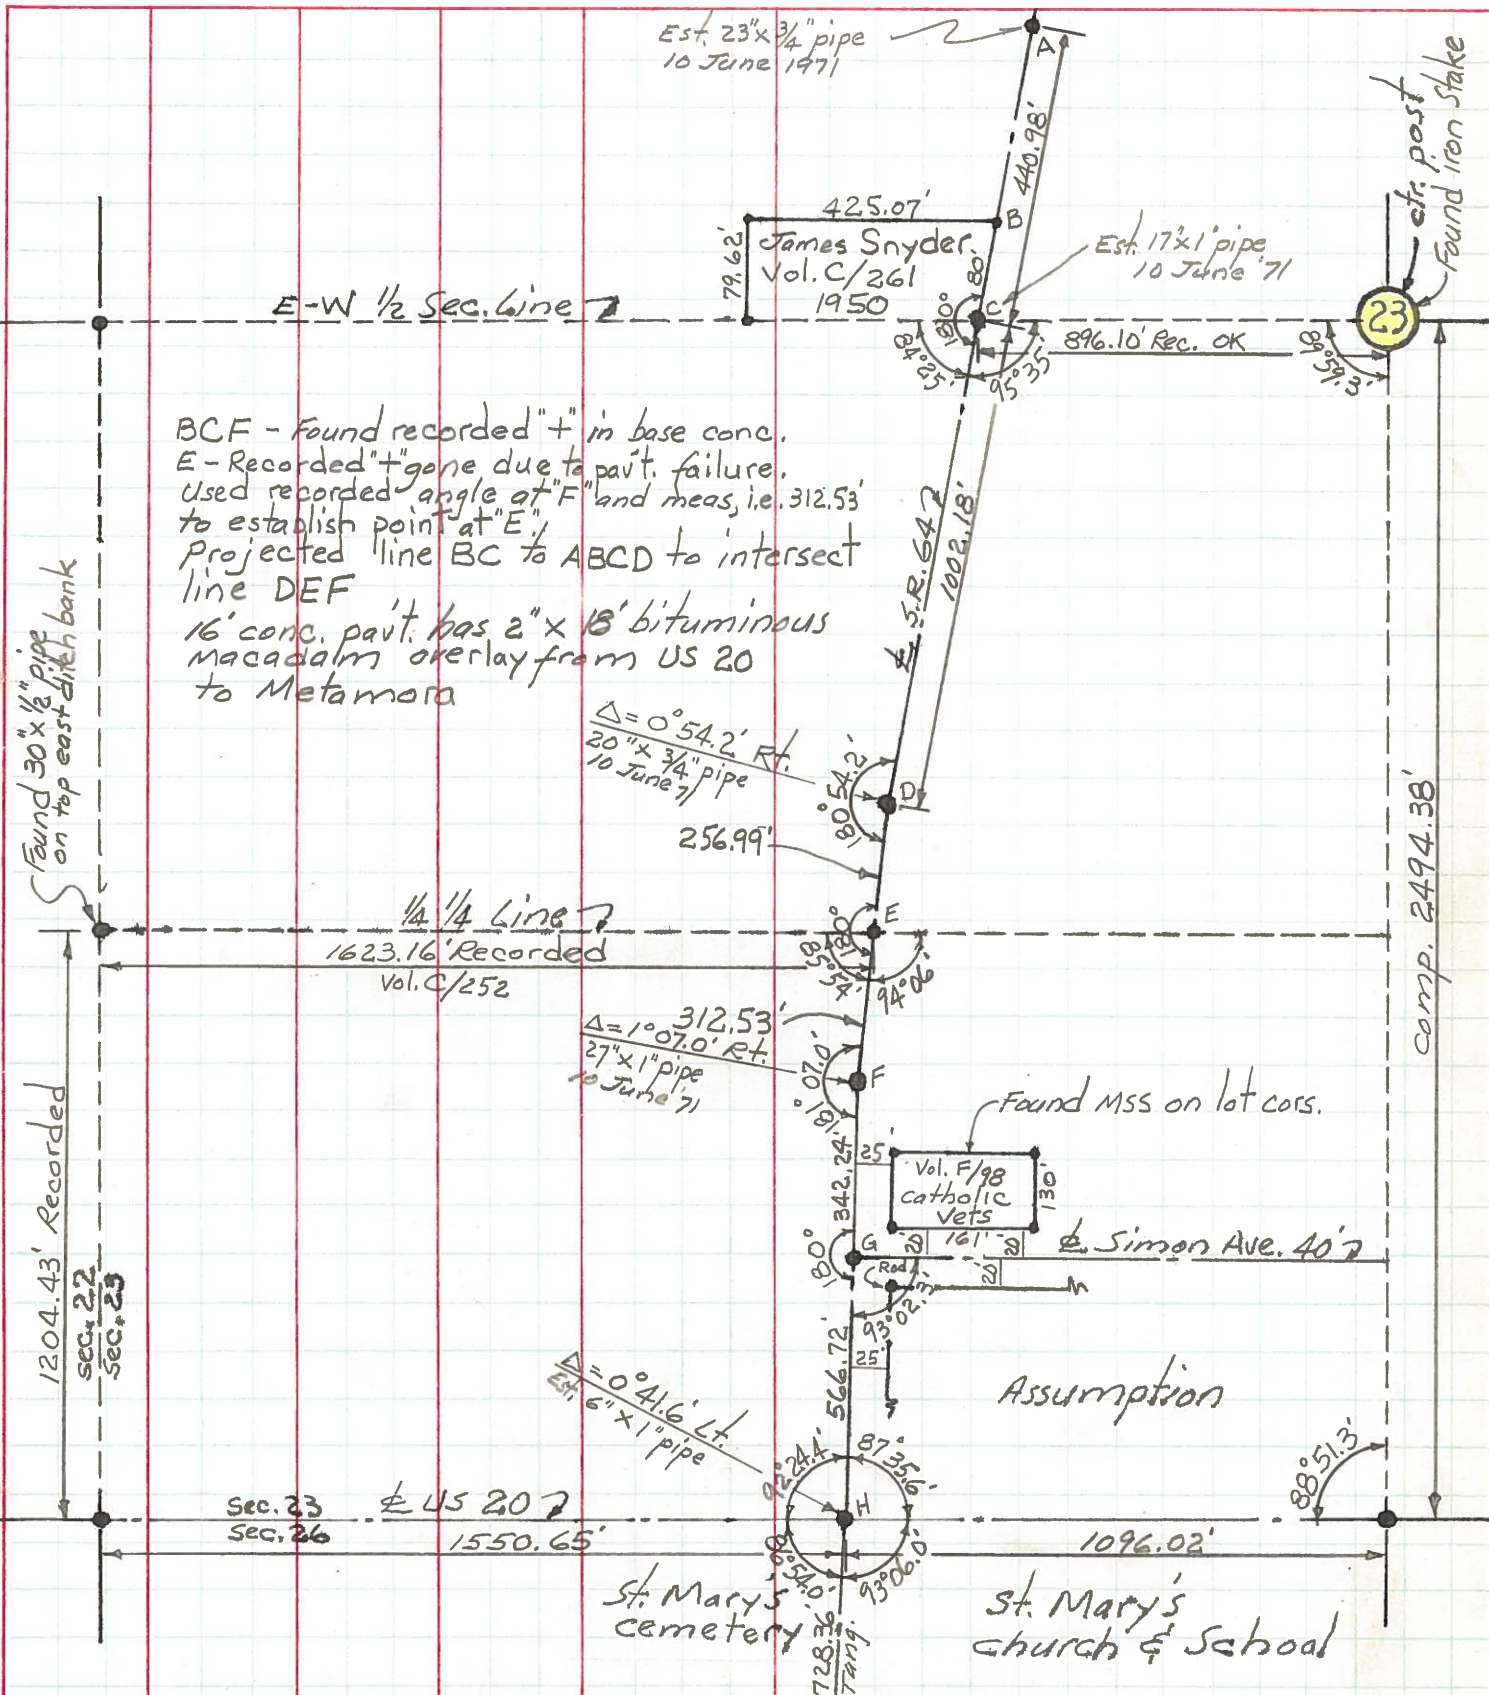

PERSONNEL TITLE PERSONNEL TITLE COUNTY Fulton DATE May '71
Red Beach _____
Newcomb _____
Knape _____
Wise _____
 S. R. 64 WEATHER _____
 SEC. Amboy Twp TEMP. _____
 DESCRIPTION CONTROL Witnesses JOB NO. _____

