

O.D.O.T. DISTRICT 2 SURVEY OFFICE (USE ONLY)

PERSONNEL

REFERENCE NO. 18

SHEET 51 OF 59

NOTES RHOADES

DATE 6/22/21

ROUTE SR 64

H.C. AUBLE

WEATHER SUNNY

COUNTY FULTON

R.C. NIESE

TEMP. 59°

TOWNSHIP AMBOY

SECTION 23

DWG BY NIESE

PID 101213

T 9 S R 4 E

TYPE MONUMENT MAG/WASHER

ON SURFACE - ~~BELOW~~ ON

OFFSET  $\bar{C}$  PAVEMENT ON LT : RT

9.4' TO LT EDGE PAVEMENT


STATION: 425+84.57

HORZ.DATUM: NAD83(2011)


GEOID: NAVD88 2012A

GRID: NORTHING: 736231.887

EASTING: 1582968.532

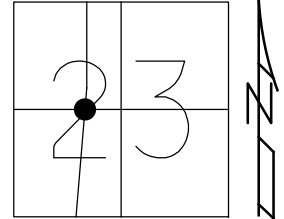



RECORD:  
 SET SM.R.R.SPIKE  
 TO SURFACE  
 6/26/86  
 FD SM.R.R.SPIKE  
 8/20/08  
 9/16/08, SAH  
 5/26/10, SAH  
 SET MAG & WASHER  
 7/29/10, SAH  
 FD MAG/WASHER  
 REF18  
 10/17/19, JFO  
 6/22/21, DSA  
 SET MAG/WASHER  
 11/3/21, DSA

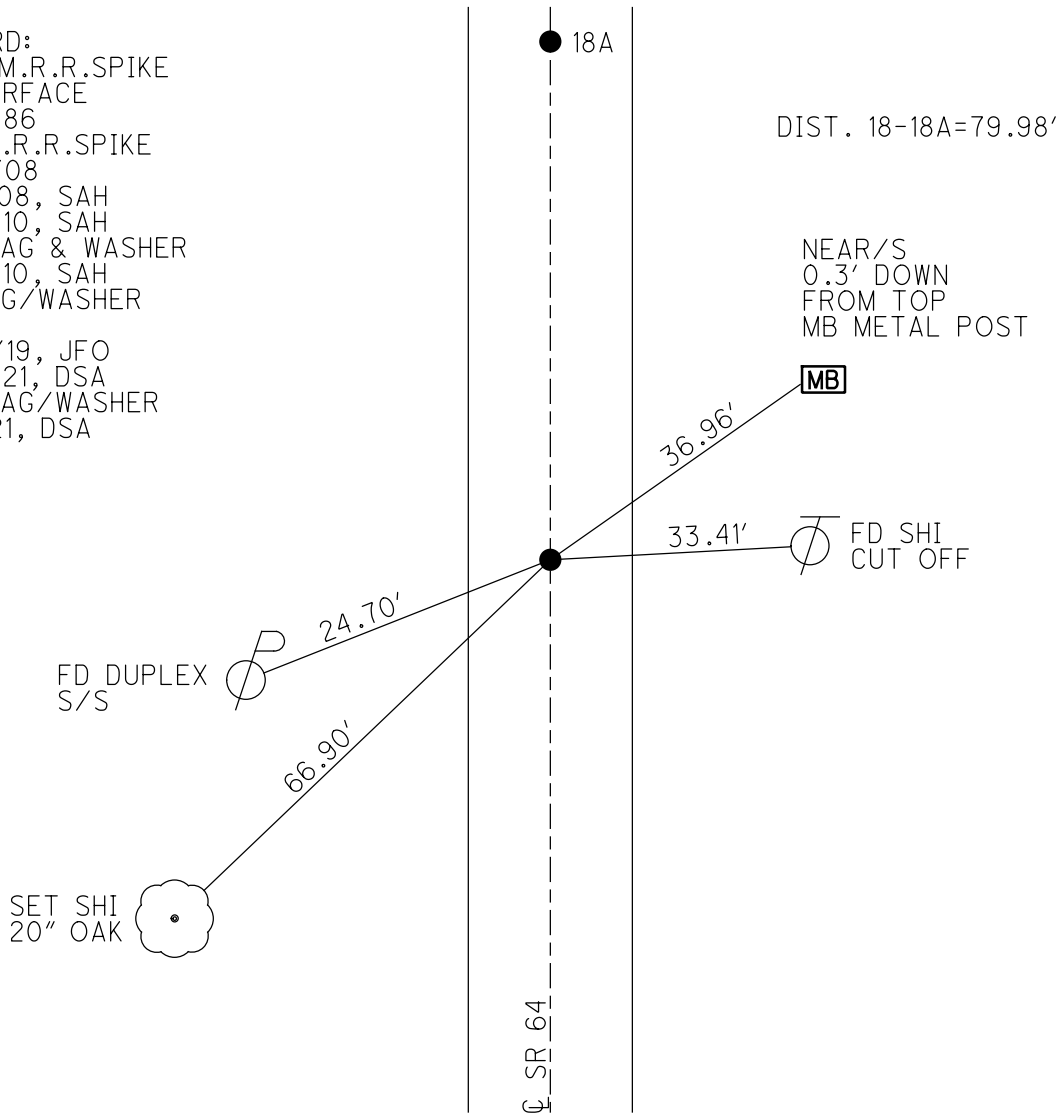

O.D.O.T. DISTRICT 2 SURVEY OFFICE (USE ONLY)

PERSONNEL \_\_\_\_\_ REFERENCE NO. 18 SHEET 31 OF 39  
 NOTES HUSS DATE 5-26-10 ROUTE SR 64  
 H.C. FINTEL WEATHER SUNNY COUNTY FULTON  
 R.C. CANTERBURY TEMP. 84° TOWNSHIP AMBOY  
 \_\_\_\_\_ SECTION 23  
 \_\_\_\_\_ T 9 N R 4 E

TYPE MONUMENT SM. RR SPIKE  
 ON SURFACE - ~~BELOW~~ ON  
 LEFT - ☉ PAV'T - ~~RIGHT~~ 0.5'  
9.4' TO LT. EDGE PAVEMENT  
 S.L.M. 425+84.57  
 GRID: NOTHING: 736231.818 EASTING: 1582968.409

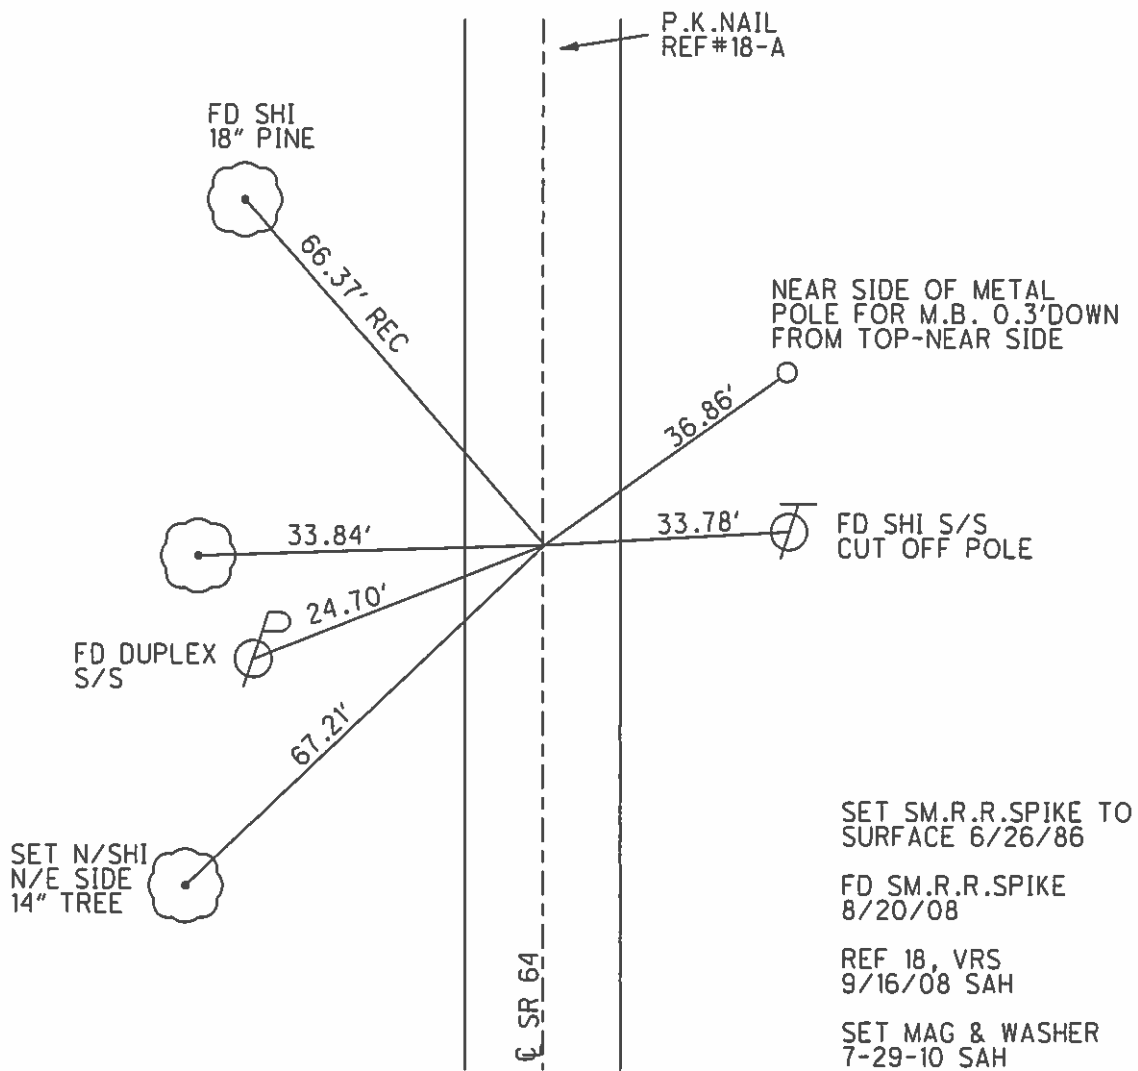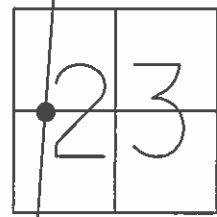

# O.D.O.T. DISTRICT 2 SURVEY OFFICE

PERSONNEL \_\_\_\_\_

REFERENCE NO. 18

SHEET 6 OF \_\_\_\_\_

NOTES I. Stone

H.C. D. Curtis

R.C. R. Micholak

DATE 28 April 86

WEATHER Nice

TEMP. 72°

ROUTE SR #64

COUNTY Fulton

TOWNSHIP Amboy

SECTION \_\_\_\_\_

T \_\_\_\_\_ R \_\_\_\_\_


TYPE MONUMENT 3/4" I. pipe

ON SURFACE - BELOW 2" deep


LEFT -  $\odot$  PAV'T. - RIGHT \_\_\_\_\_

TO \_\_\_\_\_ EDGE PAVEMENT

S.L.M. 414 + 41

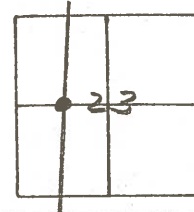


Set Sm. R.R. Spk. To Surface -  
6-26-86

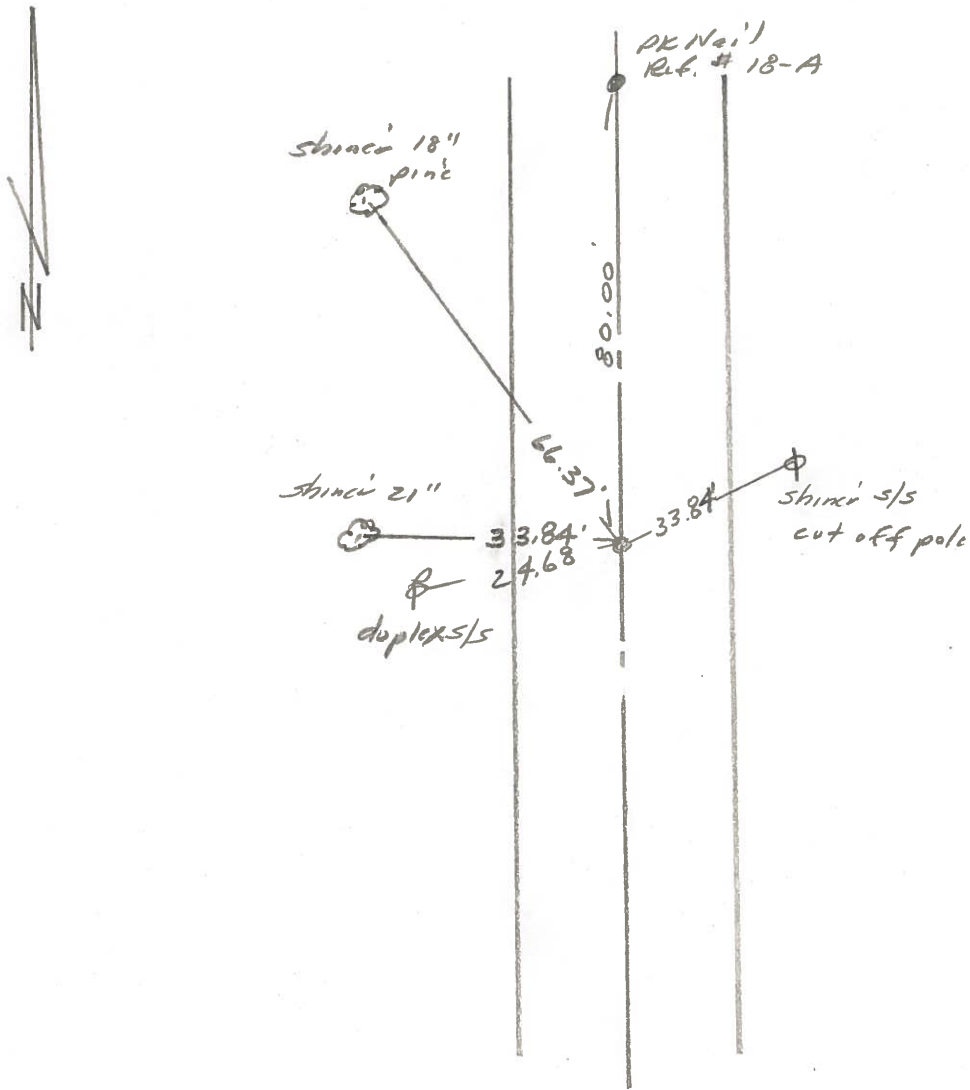



PERSONNEL	TITLE	PERSONNEL	TITLE	COUNTY	Fulton	DATE	AUG 13, 1973
Tomsic		Boyle		S. R.	64	WEATHER	
Neuser				SEC.	Amboy TWP.	TEMP.	
Granata							
Vandy							

DESCRIPTION	LEFT	CENTER LINE	RIGHT	JOB NO.
-------------	------	-------------	-------	---------

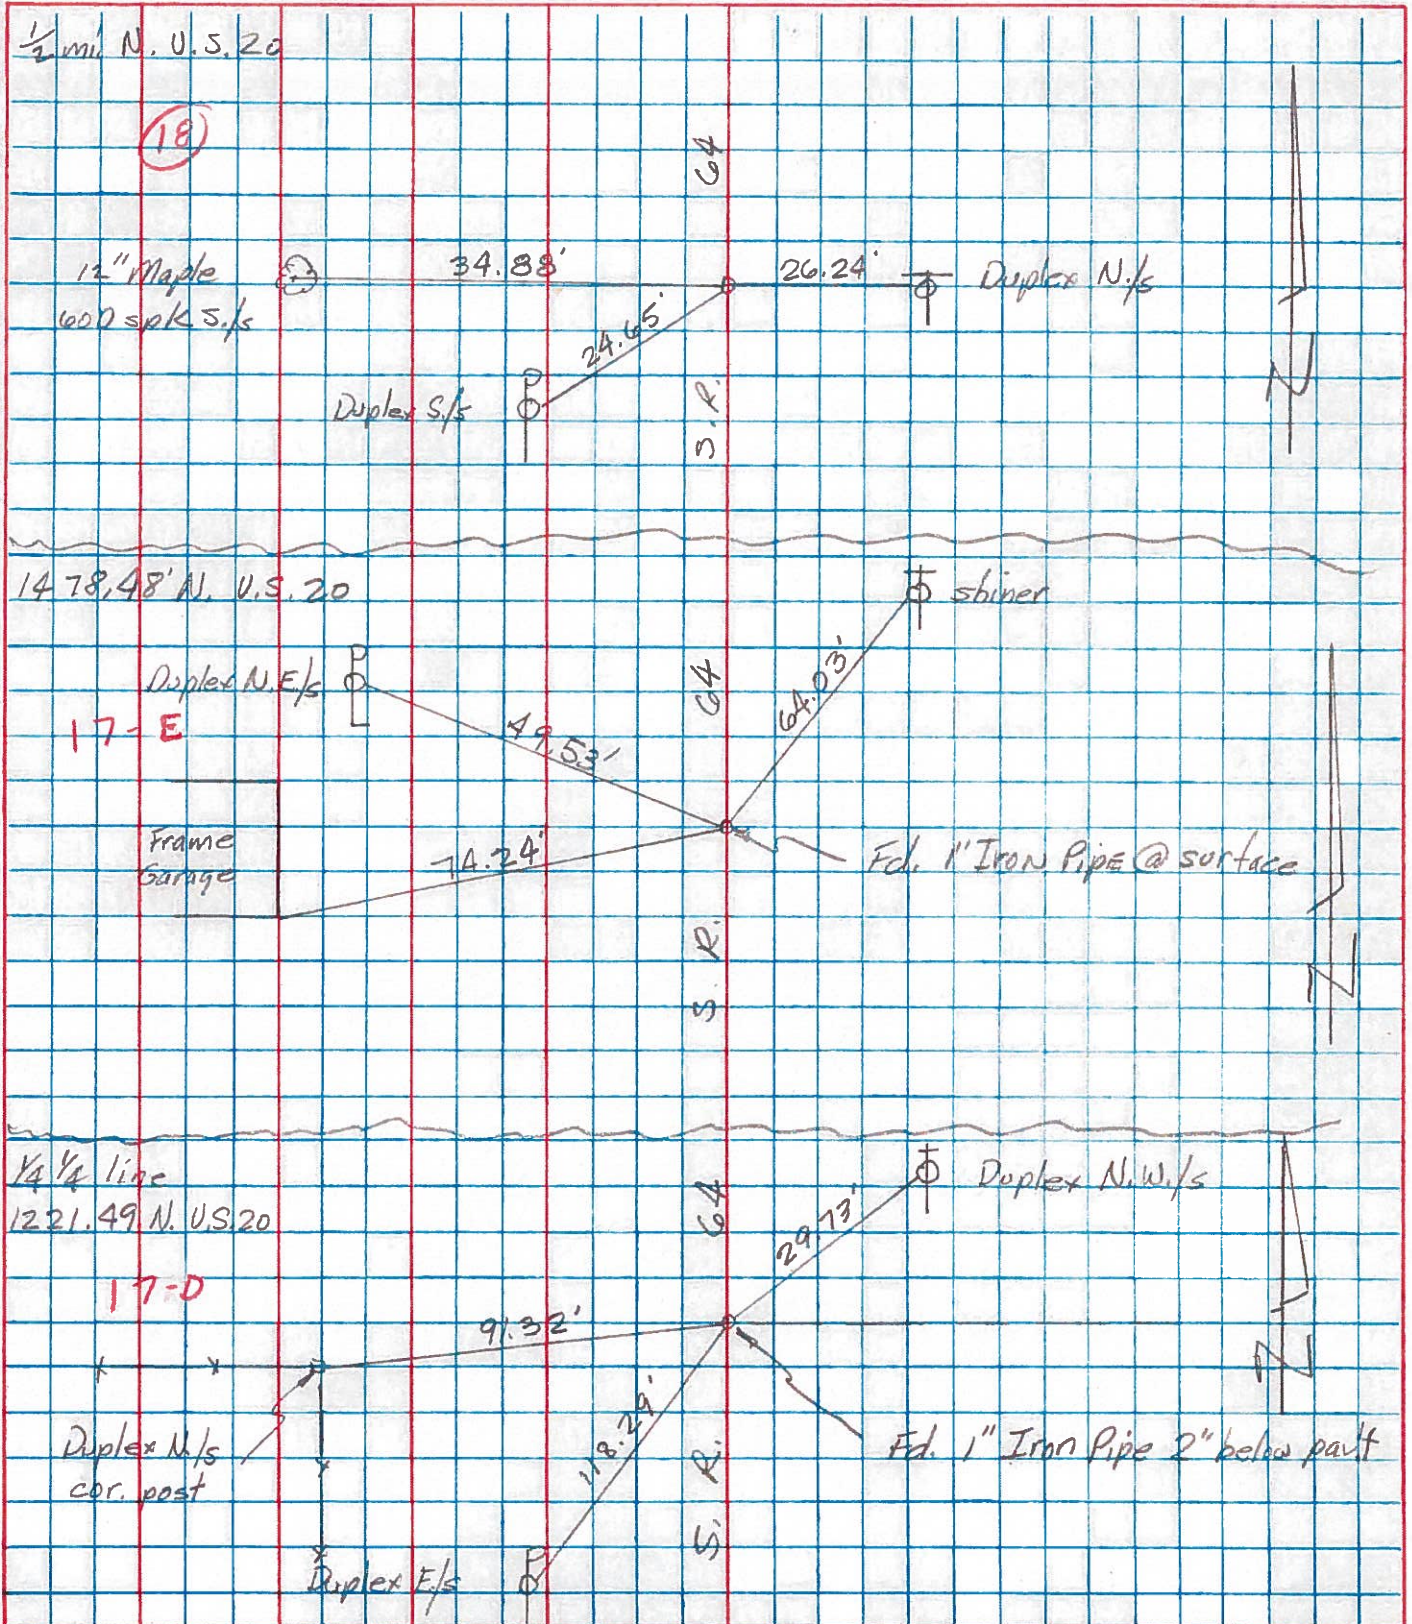




PERSONNEL TITLE PERSONNEL TITLE  
 Red Beach \_\_\_\_\_  
 Newcomb \_\_\_\_\_  
 Knappe \_\_\_\_\_  
 Wise \_\_\_\_\_

COUNTY Fulton DATE May '71

S. R. 64 WEATHER \_\_\_\_\_

SEC. SW 1/4 Sec. 23, Amboy TEMP. \_\_\_\_\_

DESCRIPTION ALIGNMENT & CONTROLS JOB NO. \_\_\_\_\_

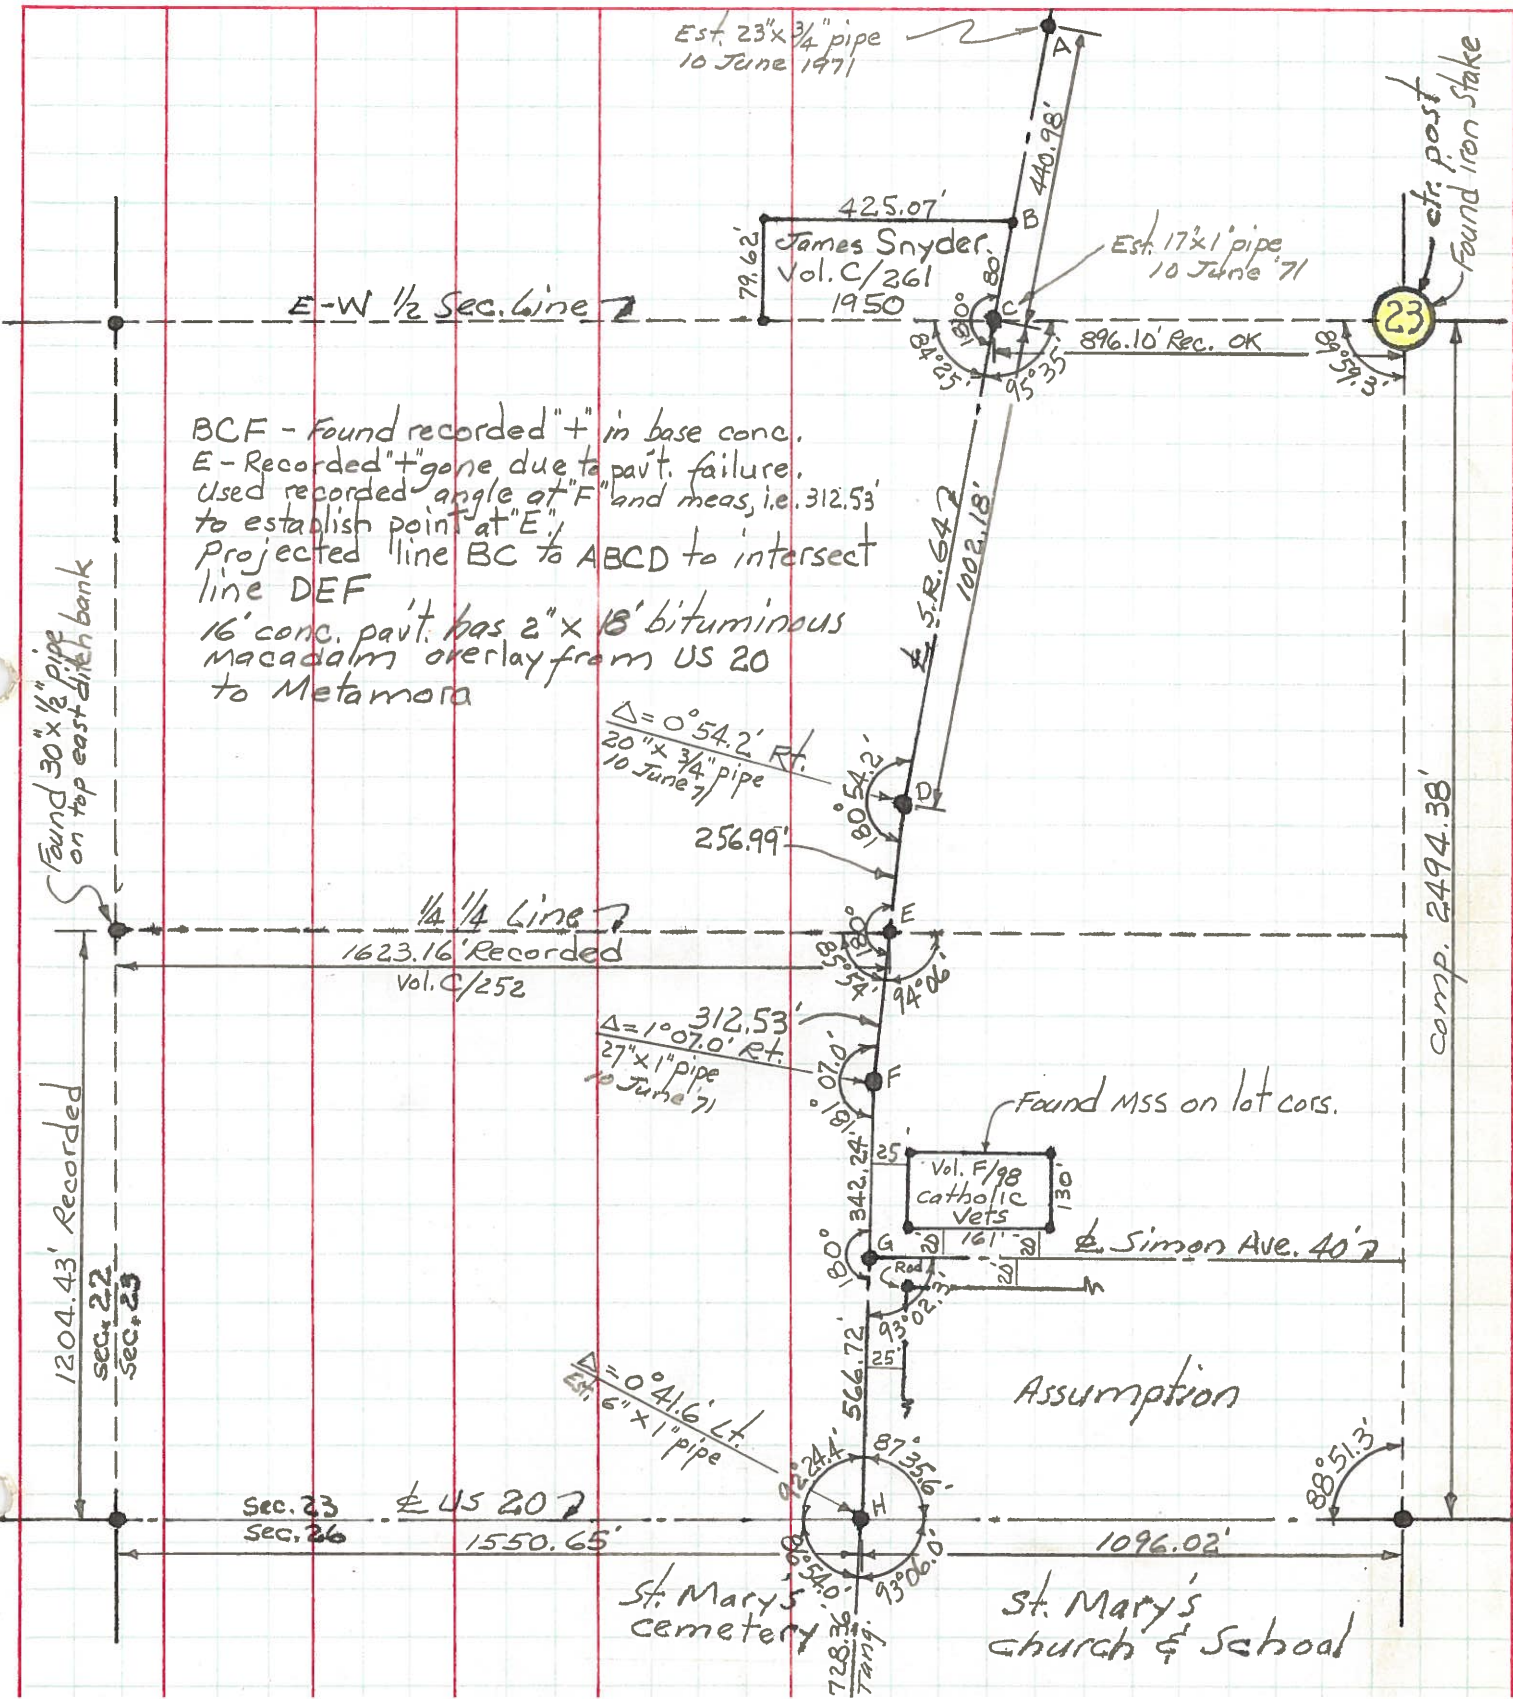



PERSONNEL TITLE PERSONNEL TITLE

Red Beach  
Newcomb  
Knappe  
Wise

COUNTY Fulton

DATE May '71

S. R. 64

WEATHER

SEC. Amboy Twp

TEMP.

DESCRIPTION

CONTROL Witnesses

JOB NO.

LEFT

CENTER LINE

RIGHT

