


O.D.O.T. DISTRICT 2 SURVEY OFFICE (USE ONLY)


PERSONNEL \_\_\_\_\_ REFERENCE NO. 18 B SHEET 53 OF 59  
 NOTES RHOADES DATE 6/22/21 ROUTE SR 64  
 H.C. AUBLE WEATHER SUNNY COUNTY FULTON  
 R.C. NIESE TEMP. 59° TOWNSHIP AMBOY  
 DWG BY NIESE PID 101213 SECTION 23  
 T 9 S R 4 E

TYPE MONUMENT MAG/WASHER  
 ON SURFACE - ~~BELOW~~ ON  
 OFFSET  $\varnothing$  PAVEMENT 1.5' ~~RT~~ : RT  
9.2' TO RT EDGE PAVEMENT  
 STATION: 430+25.55

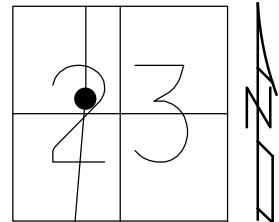

HORZ.DATUM: NAD83(2011) GEOID: NAVD88 2012A  
 GRID: NORTHING: 736670.812 EASTING: 1583009.834


- RECORD:  
 SET SM.R.R.SPIKE  
 TO SURFACE  
 6/26/86  
 FD SM.R.R.SPIKE  
 8/29/08, SAH/MC  
 9/16/08, SAH  
 5/26/10, SAH  
 SET MAG/WASHER  
 7/29/10, SAH  
 FD MAG/WASHER  
 REFB18  
 10/17/19, JFO  
 6/22/21, DSA  
 SET MAG/WASHER  
 11/3/21, DSA

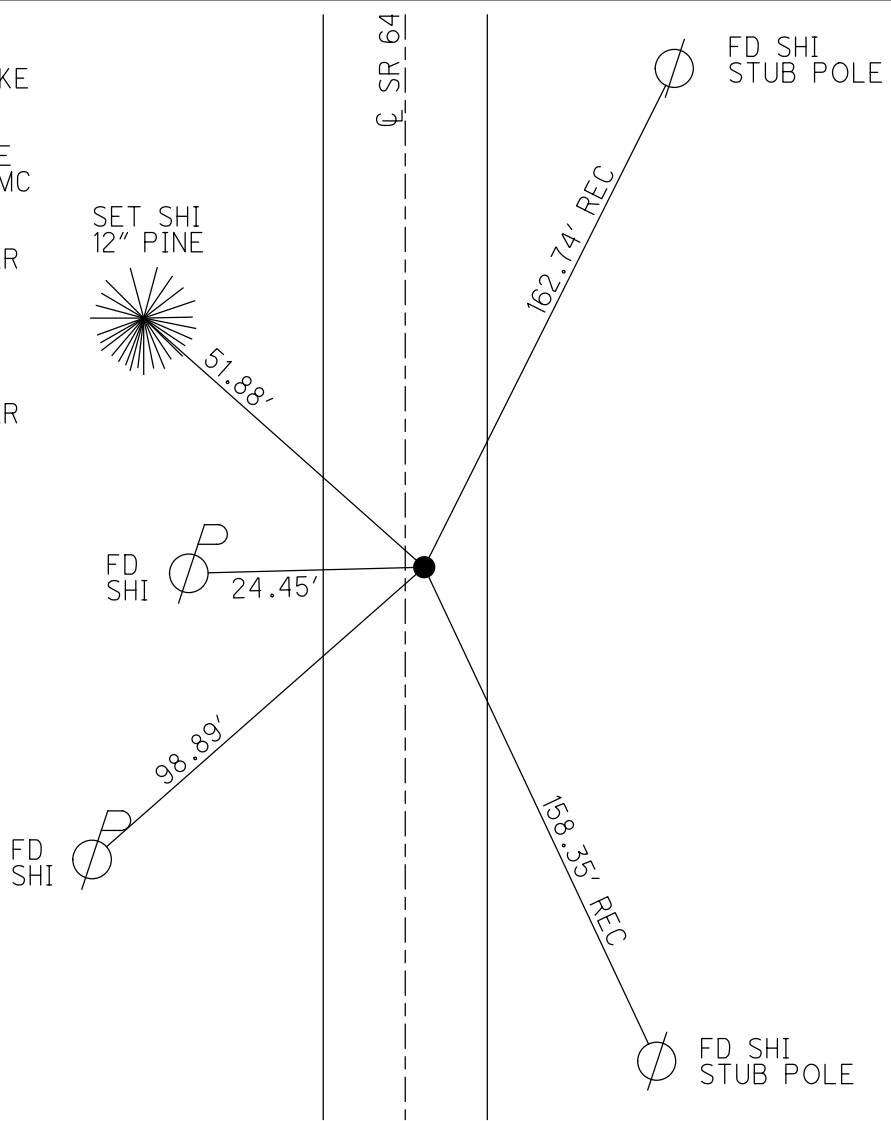


O.D.O.T. DISTRICT 2 SURVEY OFFICE (USE ONLY)

PERSONNEL \_\_\_\_\_ REFERENCE NO. 18 B SHEET 33 OF 39  
 NOTES HUSS DATE 5-26-10 ROUTE SR 64  
 H.C. FINTEL WEATHER SUNNY COUNTY FULTON  
 R.C. CANTERBURY TEMP. 84° TOWNSHIP AMBOY  
 SECTION 23  
 T 9 N R 4 E

TYPE MONUMENT \_\_\_\_\_ SM. RR SPIKE  
 ON SURFACE - ~~BELOW~~ ON \_\_\_\_\_  
~~LEFT~~ - RIGHT - 1.5'  
9.2' TO RT EDGE PAVEMENT  
 S.L.M. 430+25.42

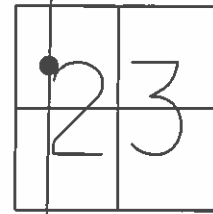

GRID: NOTHING: 736670.729 EASTING: 1583009.718

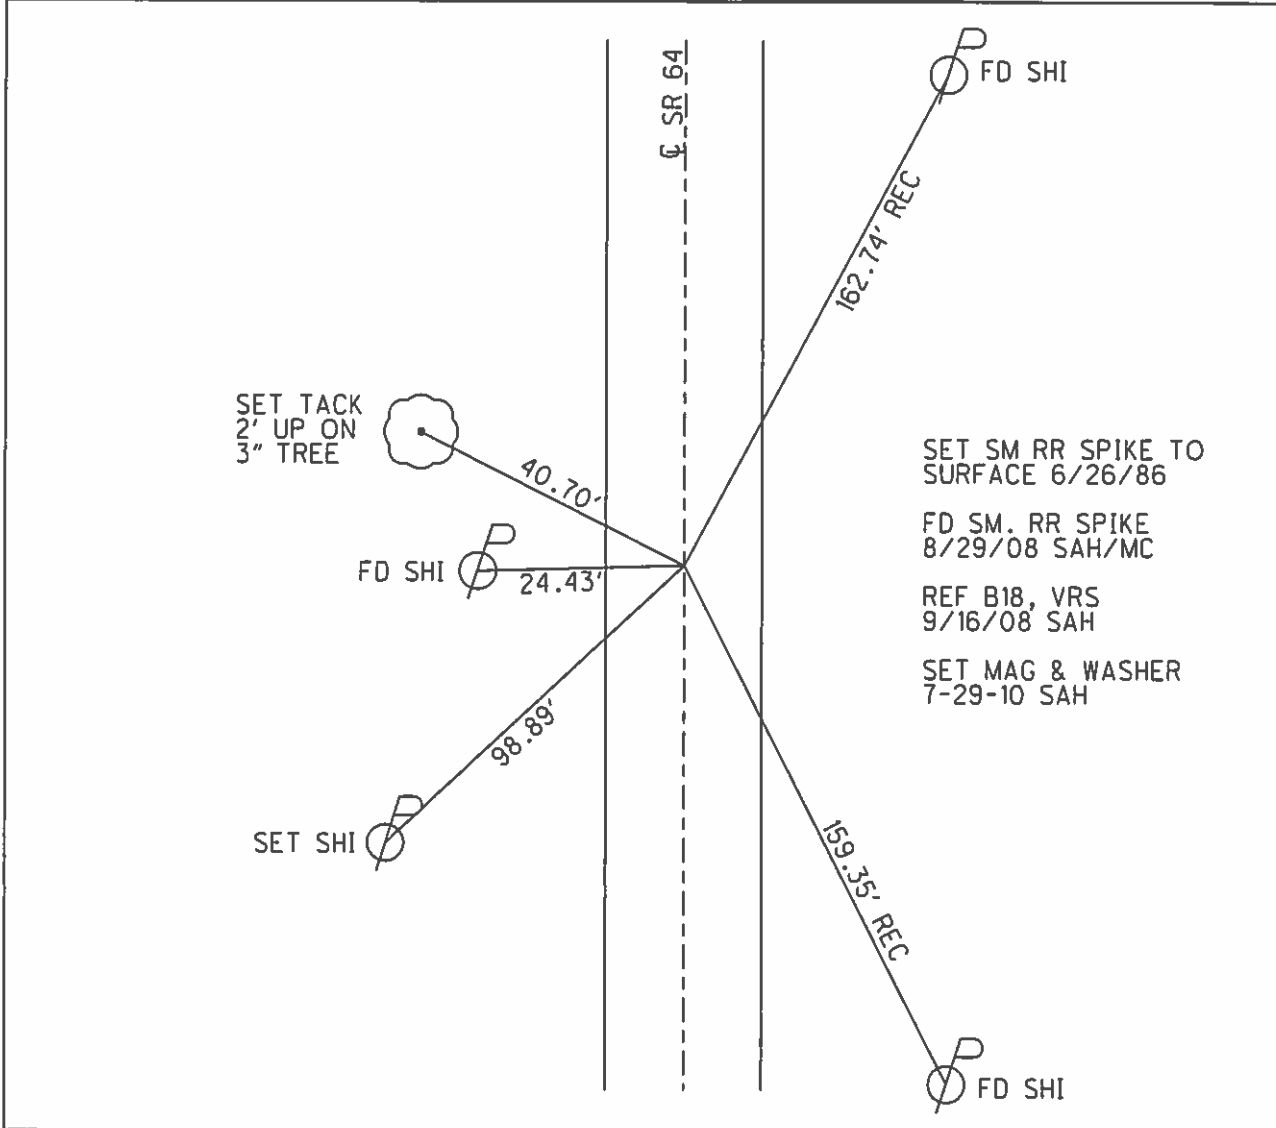

O.D.O.T. DISTRICT 2 SURVEY OFFICE

PERSONNEL

REFERENCE NO. 18-B


SHEET 8 OF     

NOTES 1. Stone  
 H.C. D. Curtis  
 R.C. J. Householder  
R. Michalak


DATE 29 April 86  
 WEATHER Cloudy  
 TEMP. 48°

ROUTE SR#64  
 COUNTY Fulton  
 TOWNSHIP Amberg  
 SECTION 23  
 T      R     

TYPE MONUMENT 1" I. pipe  
 ON SURFACE - BELOW 2" deep  
 LEFT -      PAW'T. - RIGHT       
     TO      EDGE PAVEMENT  
 S.L.M. 718 + 81

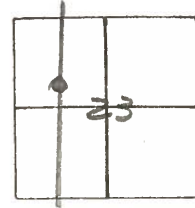


Set Sm. R.R. Spk. To Surface  
 6-26-86

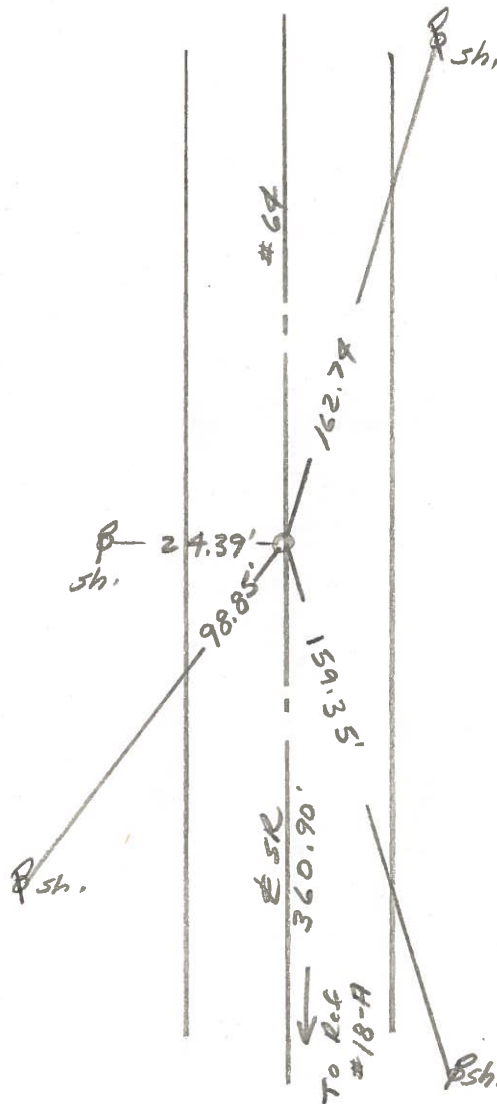

PERSONNEL	TITLE	PERSONNEL	TITLE	COUNTY	DATE	WEATHER	TEMP.
Tomsic		Boyle		Fulton	Aug 13, 1973		
Wasser				S. R. 64			
Granata				SEC. Amboy			
Vandy							

DESCRIPTION LEFT CENTER LINE RIGHT JOB NO.

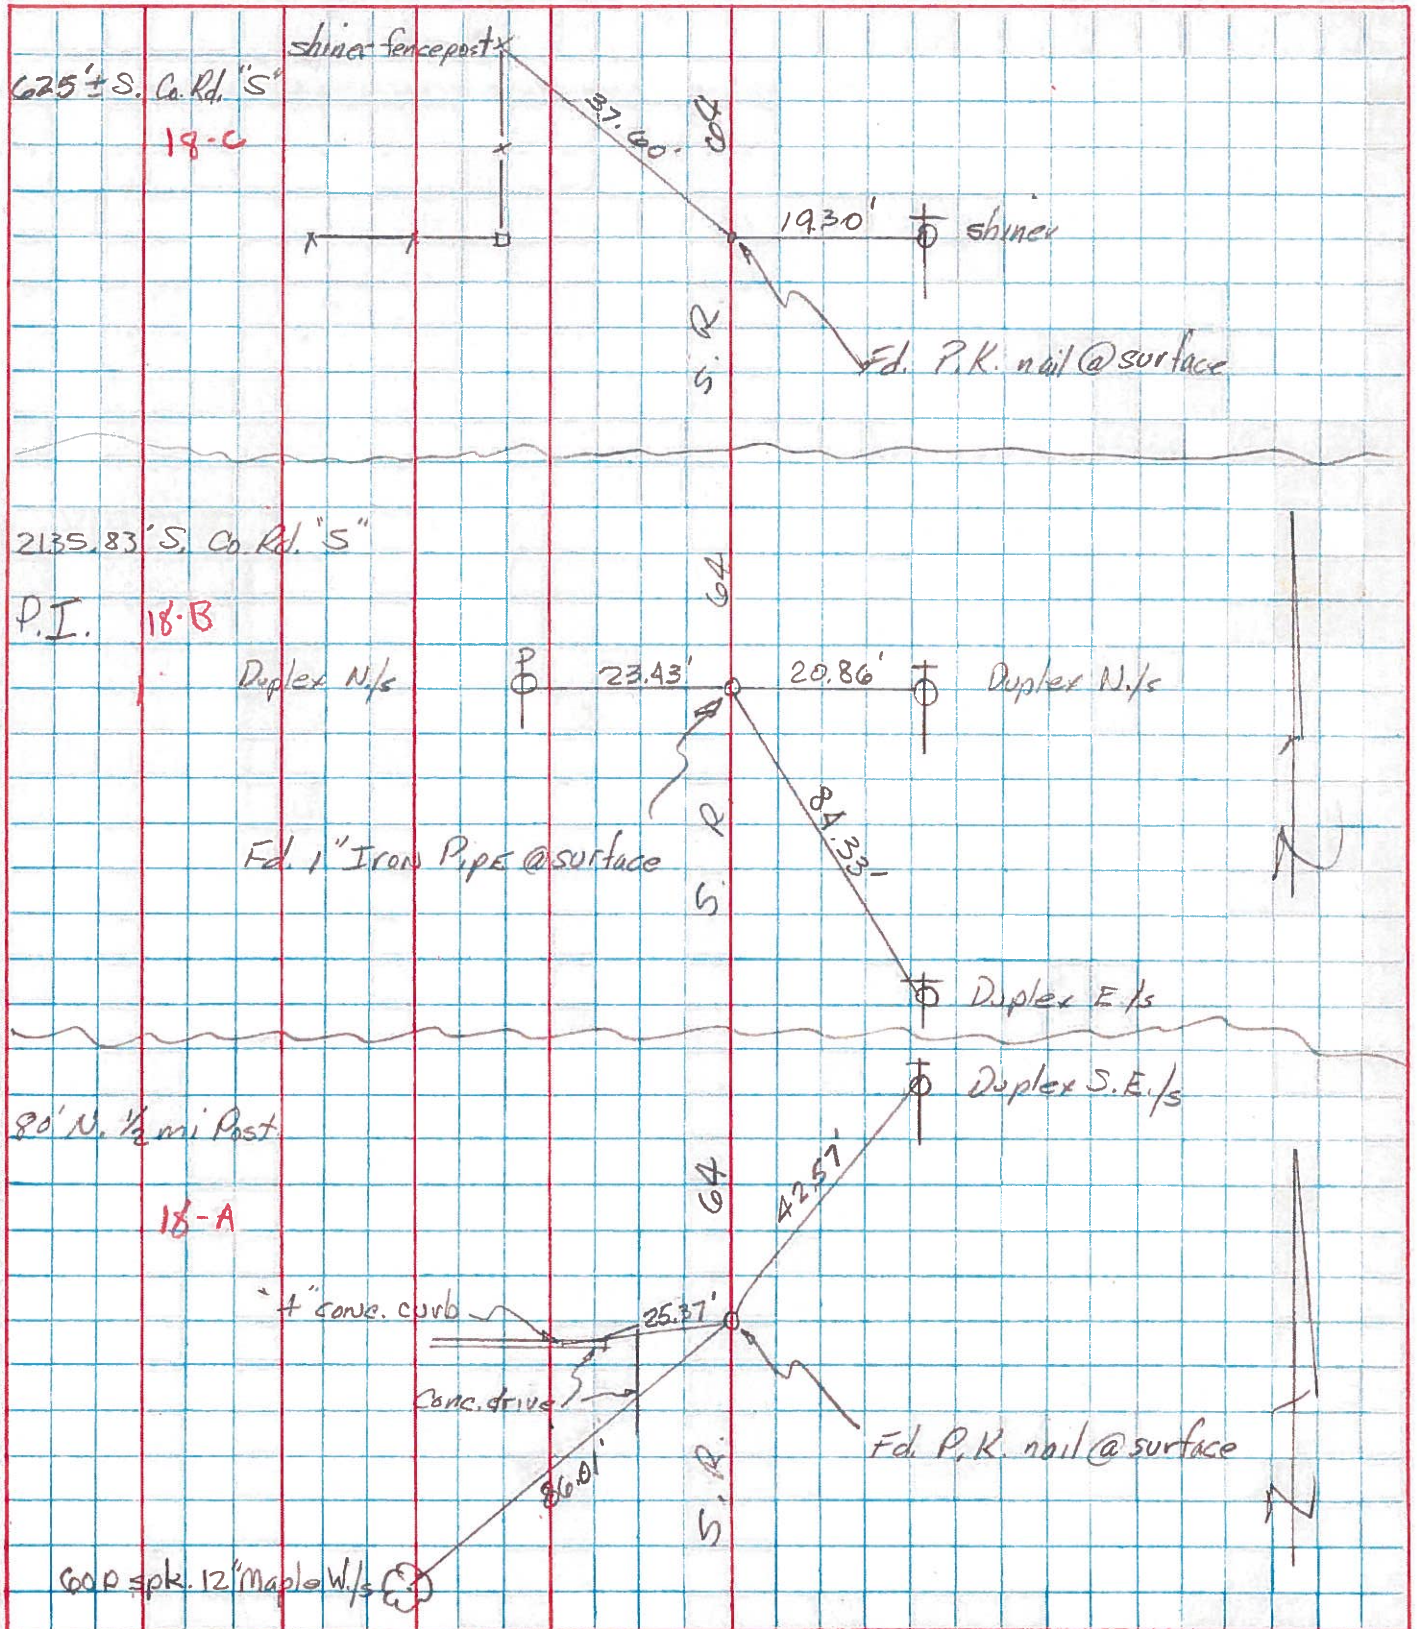

PERSONNEL TITLE PERSONNEL TITLE COUNTY Fulton DATE May '71  
Red Beach \_\_\_\_\_  
Newcomb \_\_\_\_\_  
Knape \_\_\_\_\_  
Wise \_\_\_\_\_  
 S. R. 64 WEATHER \_\_\_\_\_  
 SEC. SW 1/4 Sec. 23, Amboy TEMP. \_\_\_\_\_

DESCRIPTION ALIGNMENT & CONTROLS JOB NO. \_\_\_\_\_  
 LEFT CENTER LINE RIGHT

