

O.D.O.T. DISTRICT 2 SURVEY OFFICE (USE ONLY)

PERSONNEL

REFERENCE NO. 23 CD

SHEET 4 OF 10

NOTES RHOADES

DATE 6/23/21

ROUTE SR 64

H.C. AUBLE

WEATHER CLOUDY

COUNTY FULTON

R.C. NIESE

TEMP. 63°

TOWNSHIP AMBOY

SECTION 11

DWG BY NIESE

PID 101213

T 9 S R 4 E

TYPE MONUMENT MAG/WASHER

ON SURFACE - ~~BELOW~~ ON

OFFSET \varnothing PAVEMENT 6.7' LT : ~~RT~~

- TO - EDGE PAVEMENT



STATION: 556+17.67

HORZ. DATUM: NAD83(2011)

GEOID: NAVD88 2012A

GRID: NORTHING: 748185.577

EASTING: 1583512.551

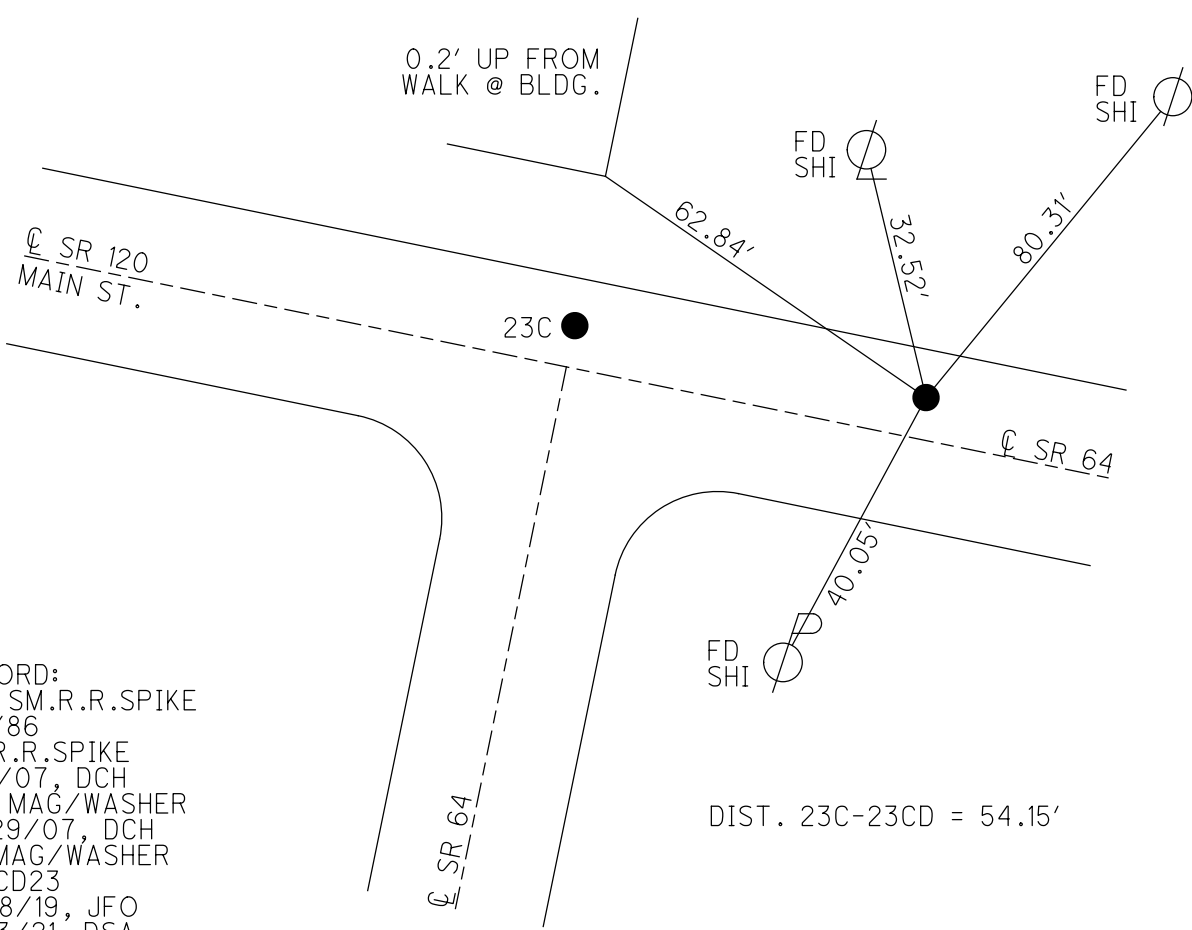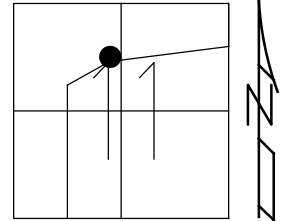

RECORD:
 SET SM.R.R.SPIKE
 7/1/86
 FD R.R.SPIKE
 8/9/07, DCH
 SET MAG/WASHER
 10/29/07, DCH
 FD MAG/WASHER
 REFCD23
 10/18/19, JFO
 6/23/21, DSA
 SET MAG/WASHER
 11/4/21, DSA


DIST. 23C-23CD = 54.15'

O.D.O.T. DISTRICT 2 SURVEY OFFICE (USE ONLY)

PERSONNEL _____ REFERENCE NO. 23 CD SHEET 4 OF 8

NOTES HOMAN _____ DATE 8/9/07 ROUTE SR 64
 H.C. CORDES _____ WEATHER CLOUDY COUNTY FULTON
 R.C. VIETH _____ TEMP. 80° TOWNSHIP AMBOY
 _____ SECTION 11
 _____ T 9 N R 4 E

TYPE MONUMENT R.R.SPIKE
 ON SURFACE - ~~BELOW~~ ON
 LEFT - ~~C PAV'T - RIGHT~~ 6.7'
 - TO - EDGE PAVEMENT
 S.L.M. 543+32

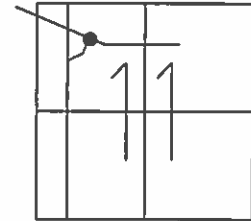

GRID: NORTHING: 748185.736 EASTING: 1583512.472

SET SMALL RR SPIKE TO SURFACE 7-1-86

SET MAG/WASHER 10-29-07 DH

0.2' UP FROM WALK @ BLDG.

