

O.D.O.T. DISTRICT 2 SURVEY OFFICE (USE ONLY)

PERSONNEL

REFERENCE NO. 23 F

SHEET 6 OF 10

NOTES RHOADES

DATE 6/23/21

ROUTE SR 64

H.C. AUBLE

WEATHER CLOUDY

COUNTY FULTON

R.C. NIESE

TEMP. 63°

TOWNSHIP AMBOY

DWG BY NIESE

PID 101213

SECTION 11

T 9 S R 4 E

TYPE MONUMENT MAG/WASHER

ON SURFACE - ~~BELOW~~ ON

OFFSET ☉ PAVEMENT 3.0' ± : RT

- TO - EDGE PAVEMENT


STATION: 577+95.95

HORZ. DATUM: NAD83(2011)


GEOID: NAVD88 2012A

GRID: NORTHING: 748270.188

EASTING: 1585666.422

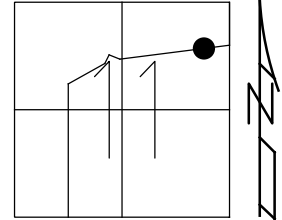


RECORD:
 FD HEX BOLT
 5/1/86
 SET SM.R.R.SPIKE
 7/1/86
 FD R.R.SPIKE
 8/9/07
 SET MAG/WASHER
 10/29/07, DCH
 FD MAG/WASHER
 REFF23
 10/18/19, JFO
 6/23/21, DSA
 SET MAG/WASHER
 11/4/21, DSA

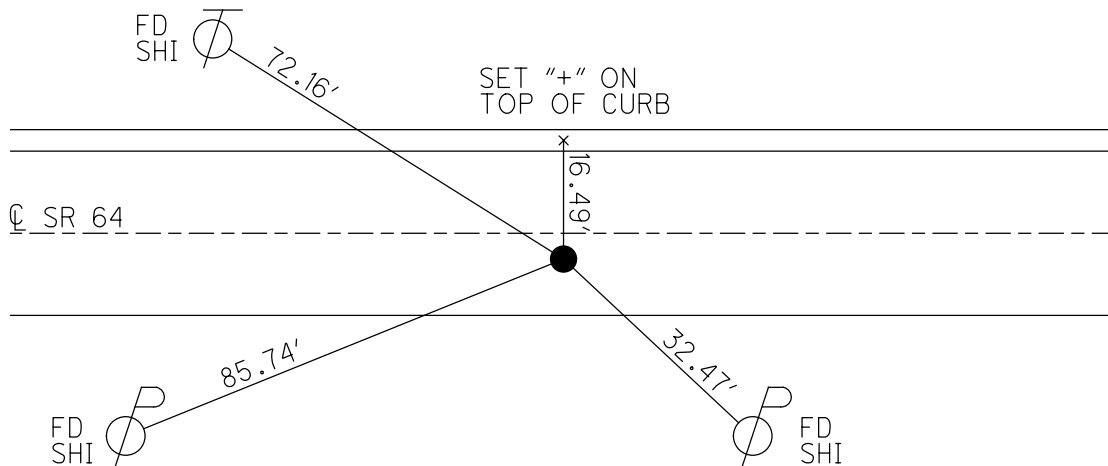


O.D.O.T. DISTRICT 2 SURVEY OFFICE (USE ONLY)

PERSONNEL _____ REFERENCE NO. 23 F SHEET 6 OF 8
 NOTES HOMAN DATE 8/9/07 ROUTE SR 64
 H.C. CORDES WEATHER CLOUDY COUNTY FULTON
 R.C. VIETH TEMP. 80° TOWNSHIP AMBOY
 _____ SECTION 11
 _____ T 9 N R 4 E

TYPE MONUMENT R.R. SPIKE
 ON SURFACE - ~~BELOW~~ ON
~~LEFT - C PAV'T - RIGHT~~ 3'
- TO - EDGE PAVEMENT
 S.L.M. 566+38
 GRID: NORTHING: 748270.097 EASTING: 1585666.391

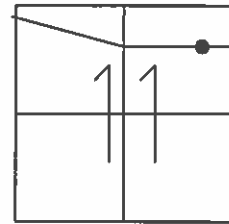

FD. HEX BOLT
 5-01-86
 SET SMALL RR
 SPIKE TO SURFACE
 7-1-86
 SET MAG/WASHER
 10-29-07 DH

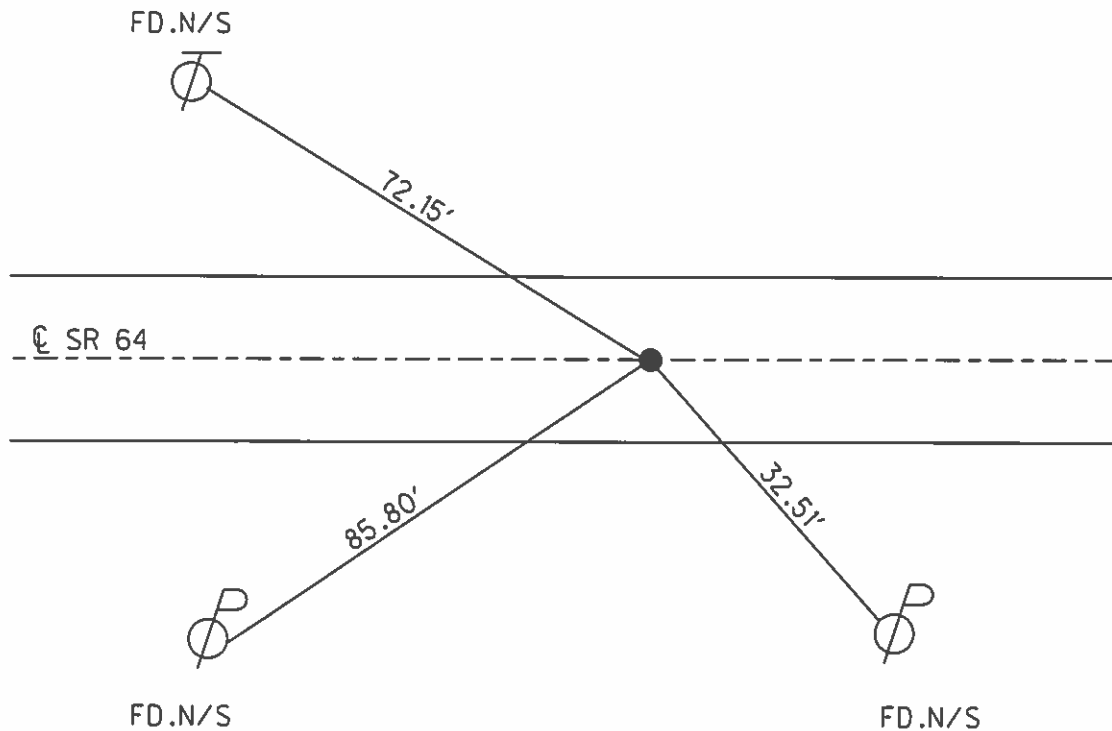

O.D.O.T. DISTRICT 2 SURVEY OFFICE

PERSONNEL


REFERENCE NO. 23-F SHEET 18 OF

NOTES 1. Stone
 H.C. D. Curtis
 R.C. J. Haushalter
R. Michalski


DATE 1 May 86
 WEATHER Fair
 TEMP. 62°

ROUTE SR #64
 COUNTY Fulton
 TOWNSHIP Amkey
 SECTION 11
 T R

TYPE MONUMENT Hex bolt
 ON SURFACE - BELOW 2" deep
 LEFT - ☉ PAV'T. - RIGHT
 TO EDGE PAVEMENT
 S.L.M. 566+38

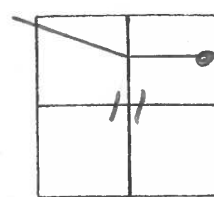

Set Sm. R.E. Spt. To Surface -
7-1-86

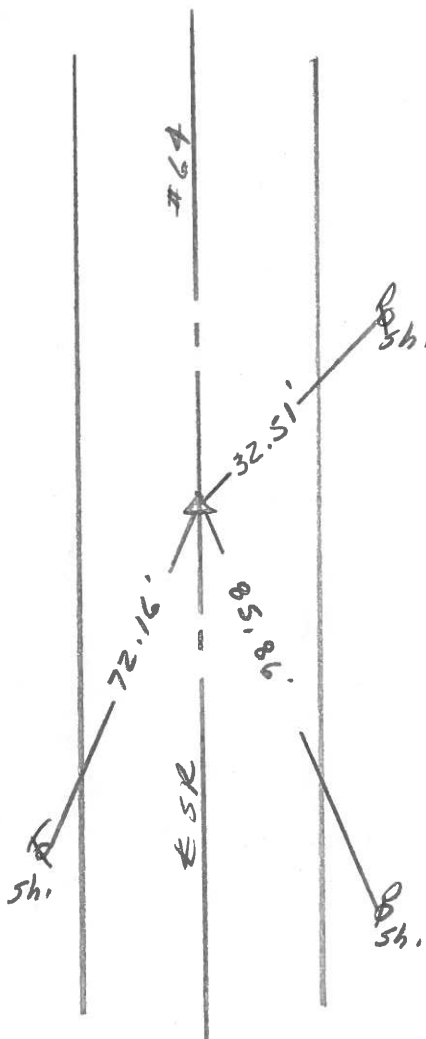

ROAD P.I.

PERSONNEL TITLE PERSONNEL TITLE

COUNTY Fulton

DATE OK-1-28-58

S. R. # 64E120

WEATHER

SEC.

TEMP.


DESCRIPTION

LEFT

CENTER LINE

RIGHT

JOB NO.

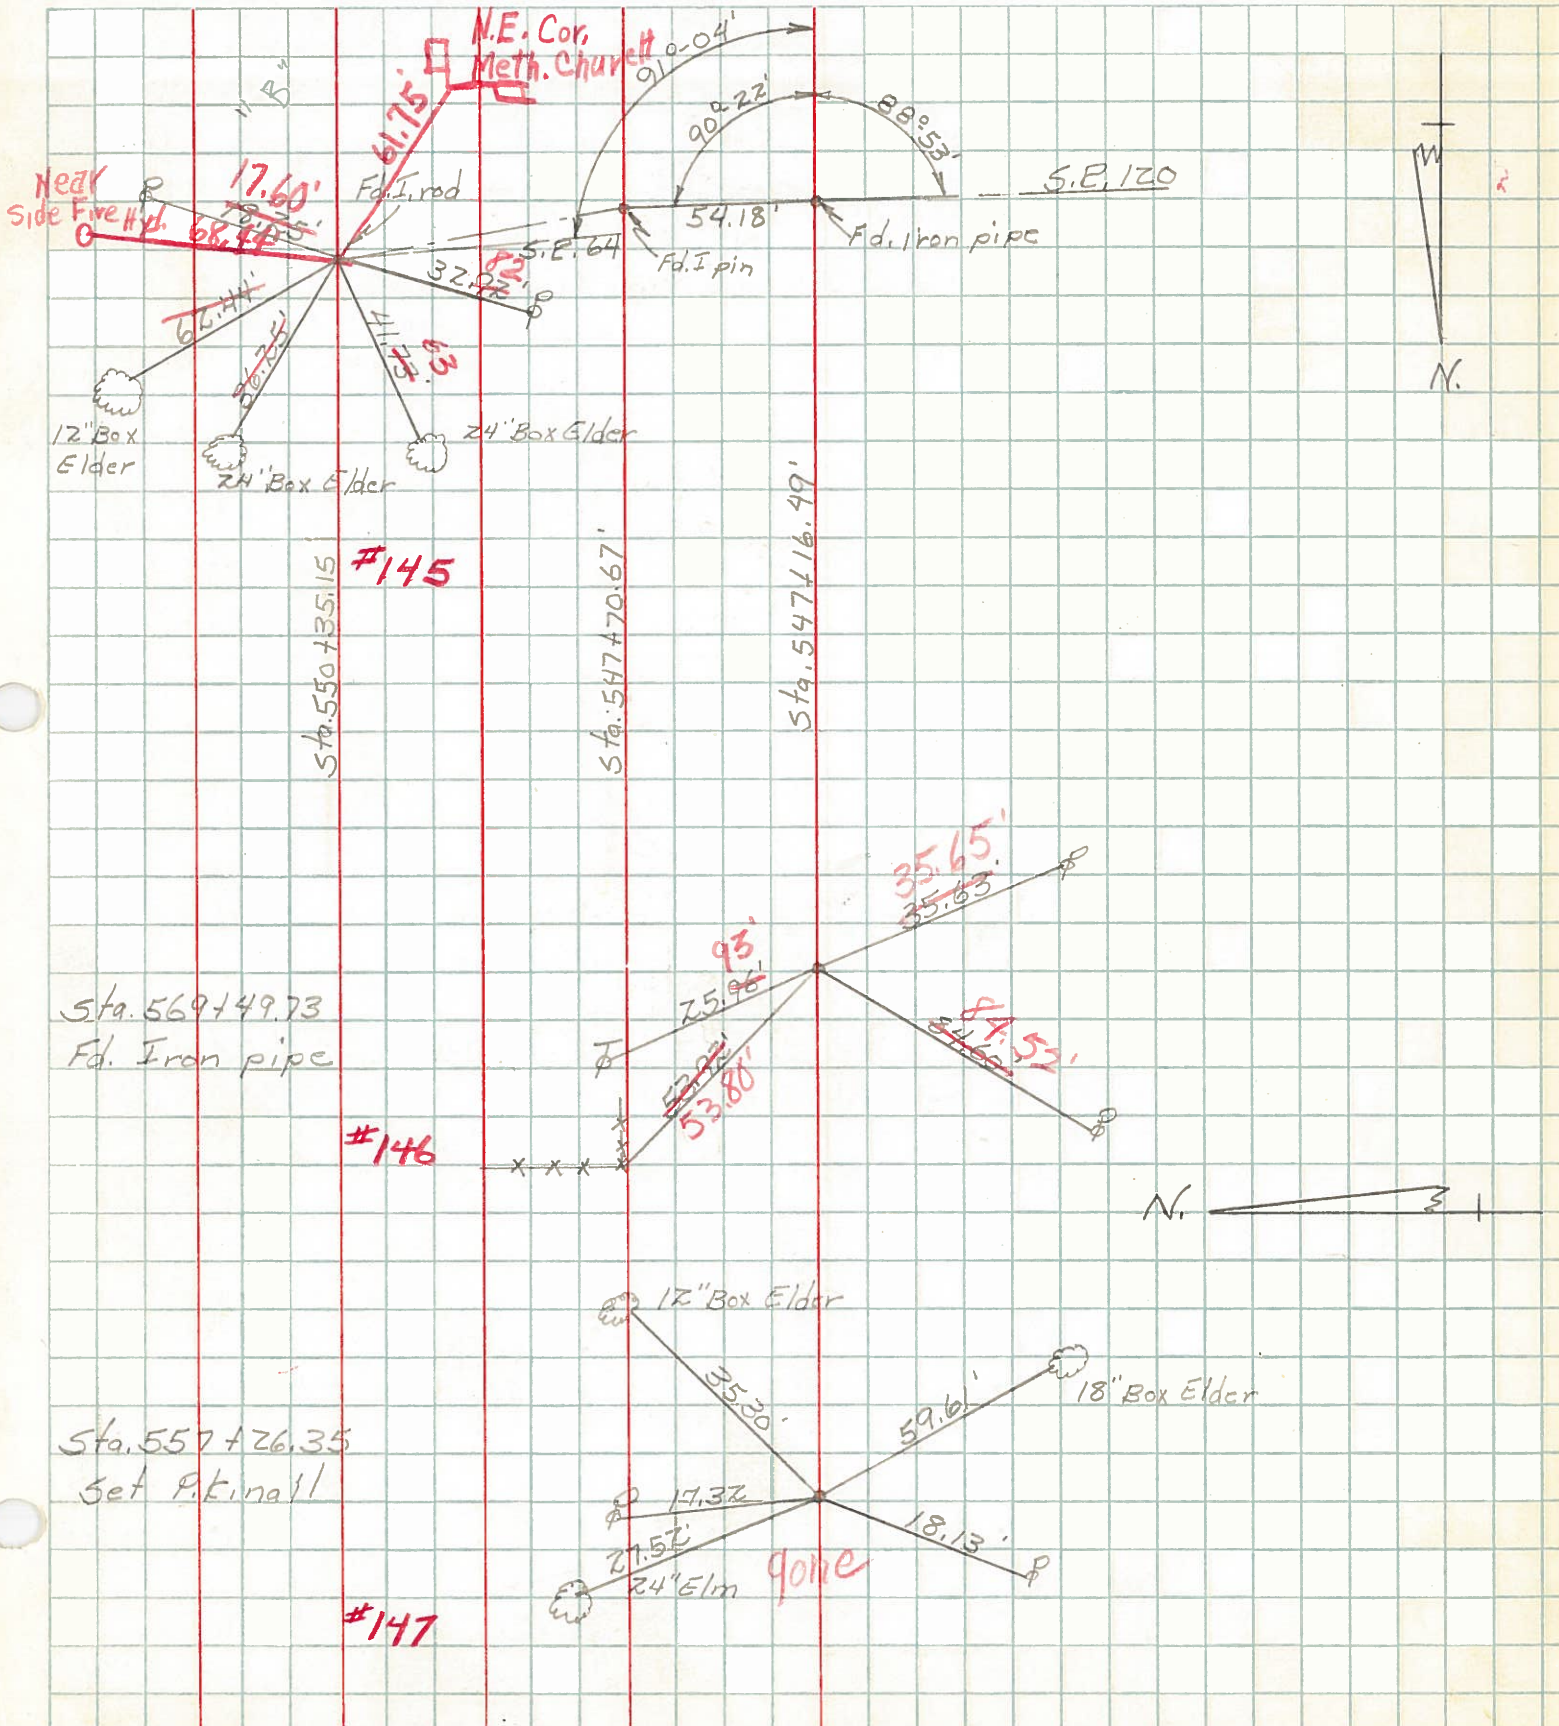

| PERSONNEL | TITLE | PERSONNEL | TITLE |
|-----------|-------|-----------|-------|
| Kujiwa | | | |
| Beck | | | |
| Carpenter | | | |

COUNTY Fulton DATE 12/12/52
 S. R. 64 WEATHER Rain
 SEC. _____ TEMP. 34

DESCRIPTION Ref. Metamora JOB NO. 0219
 LEFT CENTER LINE RIGHT

