

2677.534'

Form #1
to
"DEN 54"



KOHLI & KALIHAR ASSOCIATES, INC.
CONSULTING ENGINEERS & SURVEYORS 311 EAST MARKET, LIMA, OHIO 45801

PROJECT BRIDGE Ful-64-10.93 COUNTY FULTON SECTION _____


PARTY CHIEF BIBLER, HILE, BUETTNER DATE 12th APRIL 2000 NO. _____ OF _____ SHEETS

SUBJECT OF THIS SHEET HO 13. CONTROL

3: 10:00 AM
DUTCHMAN

Sta. 58791.45
Sta. 57711.45

1080.00' (C/R)

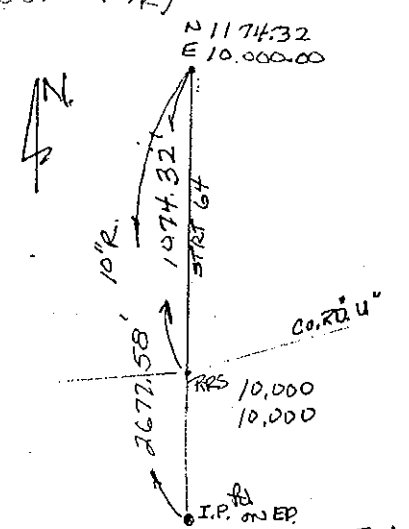

Sta. 587+91.45
(R)

(20) K&K
RRS. (ie mining SPIKE) FD ON SURFACE
N 1174.32
E. 10,000.00
Tinst h = 5.64' Elev. 719.59
"DEN 50"

STRT. 64

524.94' to Mont. C

4.65 @ 40

K&K. HUB & TACK C.P. (40)
N 10364.442
E. 10058.068

ELEV. 711.34
(29)

TEN MILE

580+45.375

CREEK

C.P. (30) K&K. HUB & TACK
N. 10291.042
E. 9935.453
ELEV. 710.21
(175)

B.M. [sq.]
elev. 715.75

04-13-2000 Thursday
Tinst @ (40)
T B/S @ (20) h = 5.24'
h = 5.54'
T @ (30) h = 5.26'
office

578+00
@ 57+800.00 = 82.87'

@ 1:49 Collected JAF
04-11-2000

Adj. 577+17.13
K&K. STA. 577+17.13
Sta. 577+11.45
(R)

CO. RD. "U"

(50) h 5.15' N. 13751.859
E. 10,000.130

T B/S 5.24'
RRS FD. ON SURFACE
ELEV. 717.97
N: 10+000
E 10+000
K&K (10)

"DEN 54"

CO. RD. 2

O.D.O.T. DISTRICT 2 SURVEY OFFICE

PERSONNEL _____

REFERENCE NO. 24-A

SHEET 20 OF _____

NOTES 1. Stone

H.C. J. Curtis

R.C. J. Houscholder

R. Michael

DATE 1 May 86

WEATHER Cloudy

TEMP. 600

ROUTE SR#64

COUNTY Fulton

TOWNSHIP Amboy

SECTION 12

T _____ R _____

TYPE MONUMENT PK Nail

ON SURFACE - BELOW Surface


LEFT - < PAV'T. - RIGHT _____

_____ TO _____ EDGE PAVEMENT

S.L.M. 581+74



Set P.K. Nail To Surface -
7-1-86

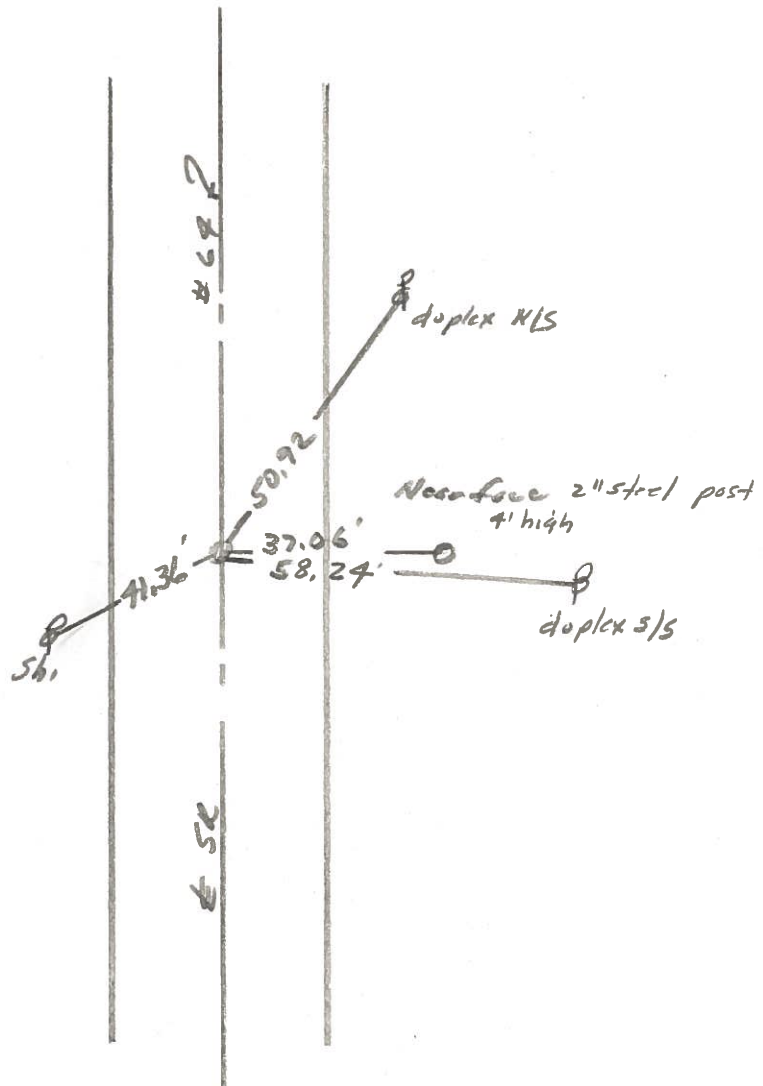

PERSONNEL	TITLE	PERSONNEL	TITLE
Tomsic		Boyle	
Neuser			
Granata			
Vanya			

COUNTY Fulton DATE Aug 24, 1973

S. R. 64 WEATHER _____

SEC. Amboy Twp TEMP. _____

DESCRIPTION _____ LEFT _____ CENTER LINE _____ RIGHT _____ JOB NO. _____

