

NOTES TO: B. Rosebrook 8-2-94

PRIORITY NO. 28 PART 2 OF 3 SHEET 1 OF 14
COUNTY Fulton ROUTE SR 66 SECTION 0.00
BEGIN LOG (SLM) 0.00 TERMINI Henry County Line
END LOG (SLM) 2.47 TERMINI SR 2
TOTAL LENGTH 2.47 MILES
MUNICIPALITY Archbold BEGIN LOG (SLM) 0.65 Rt. END LOG (SLM) -
MUNICIPALITY 1 BEGIN LOG (SLM) 0.81 Lt. END LOG (SLM) -
PROPOSED WORK: Resurface existing pavement & shoulder
PAVEMENT 1 1/2" 404 SHOULDER 1 1/2" 404, 607
OTHER grind along curb line - 5'

STATION ESTABLISHED FROM:

Ref Pt @ County Line = 0+00

STRUCTURES:

NUMBER	STATION	WIDTH	LENGTH	PROPOSED WORK
<u>Ful</u> <u>66-1.34</u>	<u>71+43</u>	<u>23'</u>	<u>68'</u>	<u>Dark Fair to Poor / CONC RAILS</u> <u>IN Poor Condition</u>

RAILROAD CROSSING:

(NO WORK)

NAME CON RAIL / AMTRACK STATION 127+73 NO. TRACKS 2 MAIN LENGTH ALONG C L 35.2 FT
NAME _____ STATION _____ NO. TRACKS _____ LENGTH ALONG C L _____ FT

MISCELLANEOUS:

NO RAISED PAVEMENT MARKERS; EDGE OF PAVEMENT - 0 - CENTERLINE 17
NO. MAILBOX APPROACHES N/A MAILBOX SUPPORTS N/A
REMARKS: New Const ± 71+00 to 108+12 ⇒ No Work Needed.

SHEET 2 OF 14

SHEET 2 OF 14

L - PROP PAVT DEPTH (IN) X 10; W - WIDTH @ MOUTH; W-I - WIDTH @ THROAT

[illegible]

UTILITIES (CATCH BASIN, MANHOLE, INLET, WATER VALVE, BOX AND MONUMENT BOX)

COUNTY FULTON ROUTE S.R. 66 SECTION 0.00

R - RAISE F - FEATHER

STATION	OUT (FT) RT/LT OF C	CATCH BASIN	MAN- HOLE	INLET	W V BOX	MON BOX	CASTING		REMARKS ie: RECONSTRUCT, NO WORK
							R	F	
41+39	18.0' Rt. of C		X					✓	Good
61+18	17' Lt of C		X					✓	"
108+00	Rt. curb	X						✓	"
108+02	Lt. Curb	X						✓	"
108+96	Rt. Curb	X						✓	"
109+81	22 Rt. of C		X				✓		"
110+72	ON C of Elms.					X	✓		"
110+89	16' Lt. of C		X						"
110+91	24' Rt of C				GAS VALVE X		✓		"
113+55	18' Rt of C			X				✓	"
113+69	18' LT. of C			X				✓	"
113+82	18' Rt of C		X					✓	"
113+82	16' Lt. of C		X					✓	"
113+88	16' Lt. of C		X					✓	"
116+82	19' RT of C			X				✓	"
116+95	18' LT. of C			X				✓	"
117+02	18' LT. of C		X					✓	"
117+16	20' RT of C		X					✓	"
119+19	18' LT of C		X					✓	GOOD
121+00	19' LT of C			X				✓	"
121+04	18' RT of C			X				✓	"
121+22	18' LT. of C		X					✓	"
121+23	20' RT. of C		X					✓	"
121+32	ON C					X		✓	"
121+50	18' LT of C		X					✓	"
121+62	18' RT of C			X				✓	"
124+19	18' LT of C		X					✓	"

SHEET 4 OF 14

SHEET 4 OF 14

UTILITIES (CATCH BASIN, MANHOLE, INLET, WATER VALVE, BOX AND MONUMENT BOX)

COUNTY FULTON ROUTE 66 SECTION 6.0

R = RAISE F = FEATHER

[illegible]

DATE 7-27-94SHEET 5 OF 14

1995

TWO-LANE RESURFACING PROGRAM
PAVEMENT DATANOTE: LOCATE ALL
CHANGES IN PVMT WIDTHCOUNTY FULTON ROUTE 66 SECTION 0.00


PAVEMENT MARKINGS:

* - STATION LOCATION

STATION	LANE LT/RT	OTHERS (SKETCH)				*SCHOOL	*ONLY			
108+40								X		
108+51							X			
111+56								X		
111+67							X			
112+93							X			
113+02								X		
114+70								X		
114+82							X			
117+86								X		
117+97							X			
120+39							X			
120+48								X		
122+18								X		
122+29							X			
125+50	N.B				X					
126+40							X			
126+49								X		
126+78							X			
126+90								X		
128+80	NB Lt						X			
128+80	N.B Rt						X			
128+92	NBLt							X		
128+92	N.B Rt								X	
129+75	NB Lt						X			
129+75	N.B Rt						X			
129+87	N.B. Rt								X	
129+83	N.B Lt.							X		
130+96	S.B				X					

PERSONNEL	TITLE	PERSONNEL	TITLE	COUNTY	DATE
LOEHRKE				FULTON	7-27-94
				S. R.	66
				WEATHER	Nice
CREW				SEC.	0.0
				TEMP.	+68

DESCRIPTION PAUT MARKINGS _____ JOB NO. _____

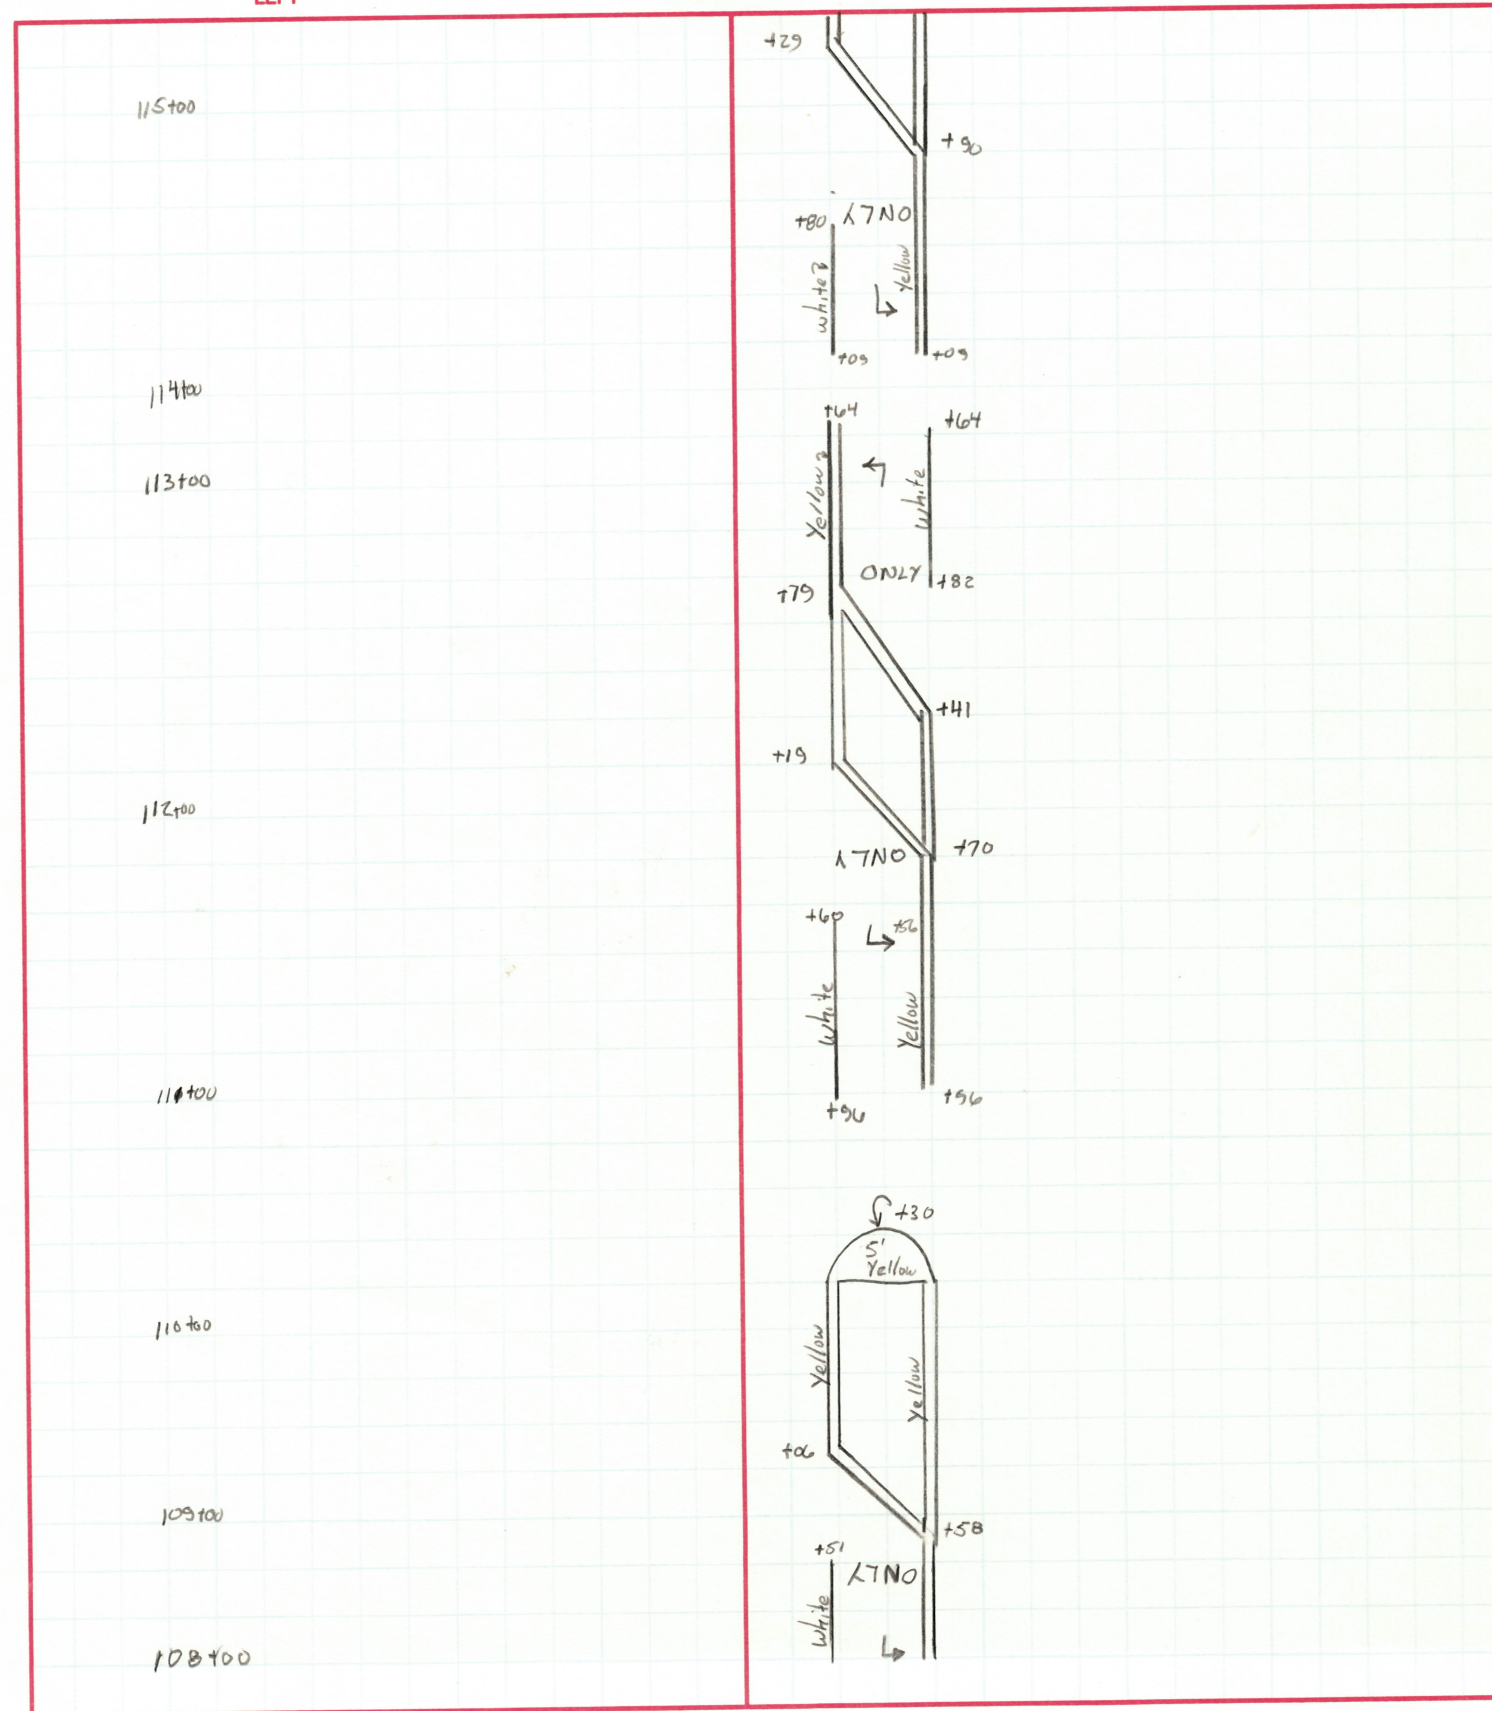

194SWH

OHIO DEPARTMENT OF TRANSPORTATION

SHEET NO. 7-14

PERSONNEL

TITLE

PERSONNEL

TITLE


COUNTY FULTONDATE 7-27-94LOEHMKE&S. R. 66WEATHER NiceCrewSEC. 0.0TEMP. +68DESCRIPTION PAVT MARKINGS

JOB NO. _____

LEFT

CENTER LINE

RIGHT

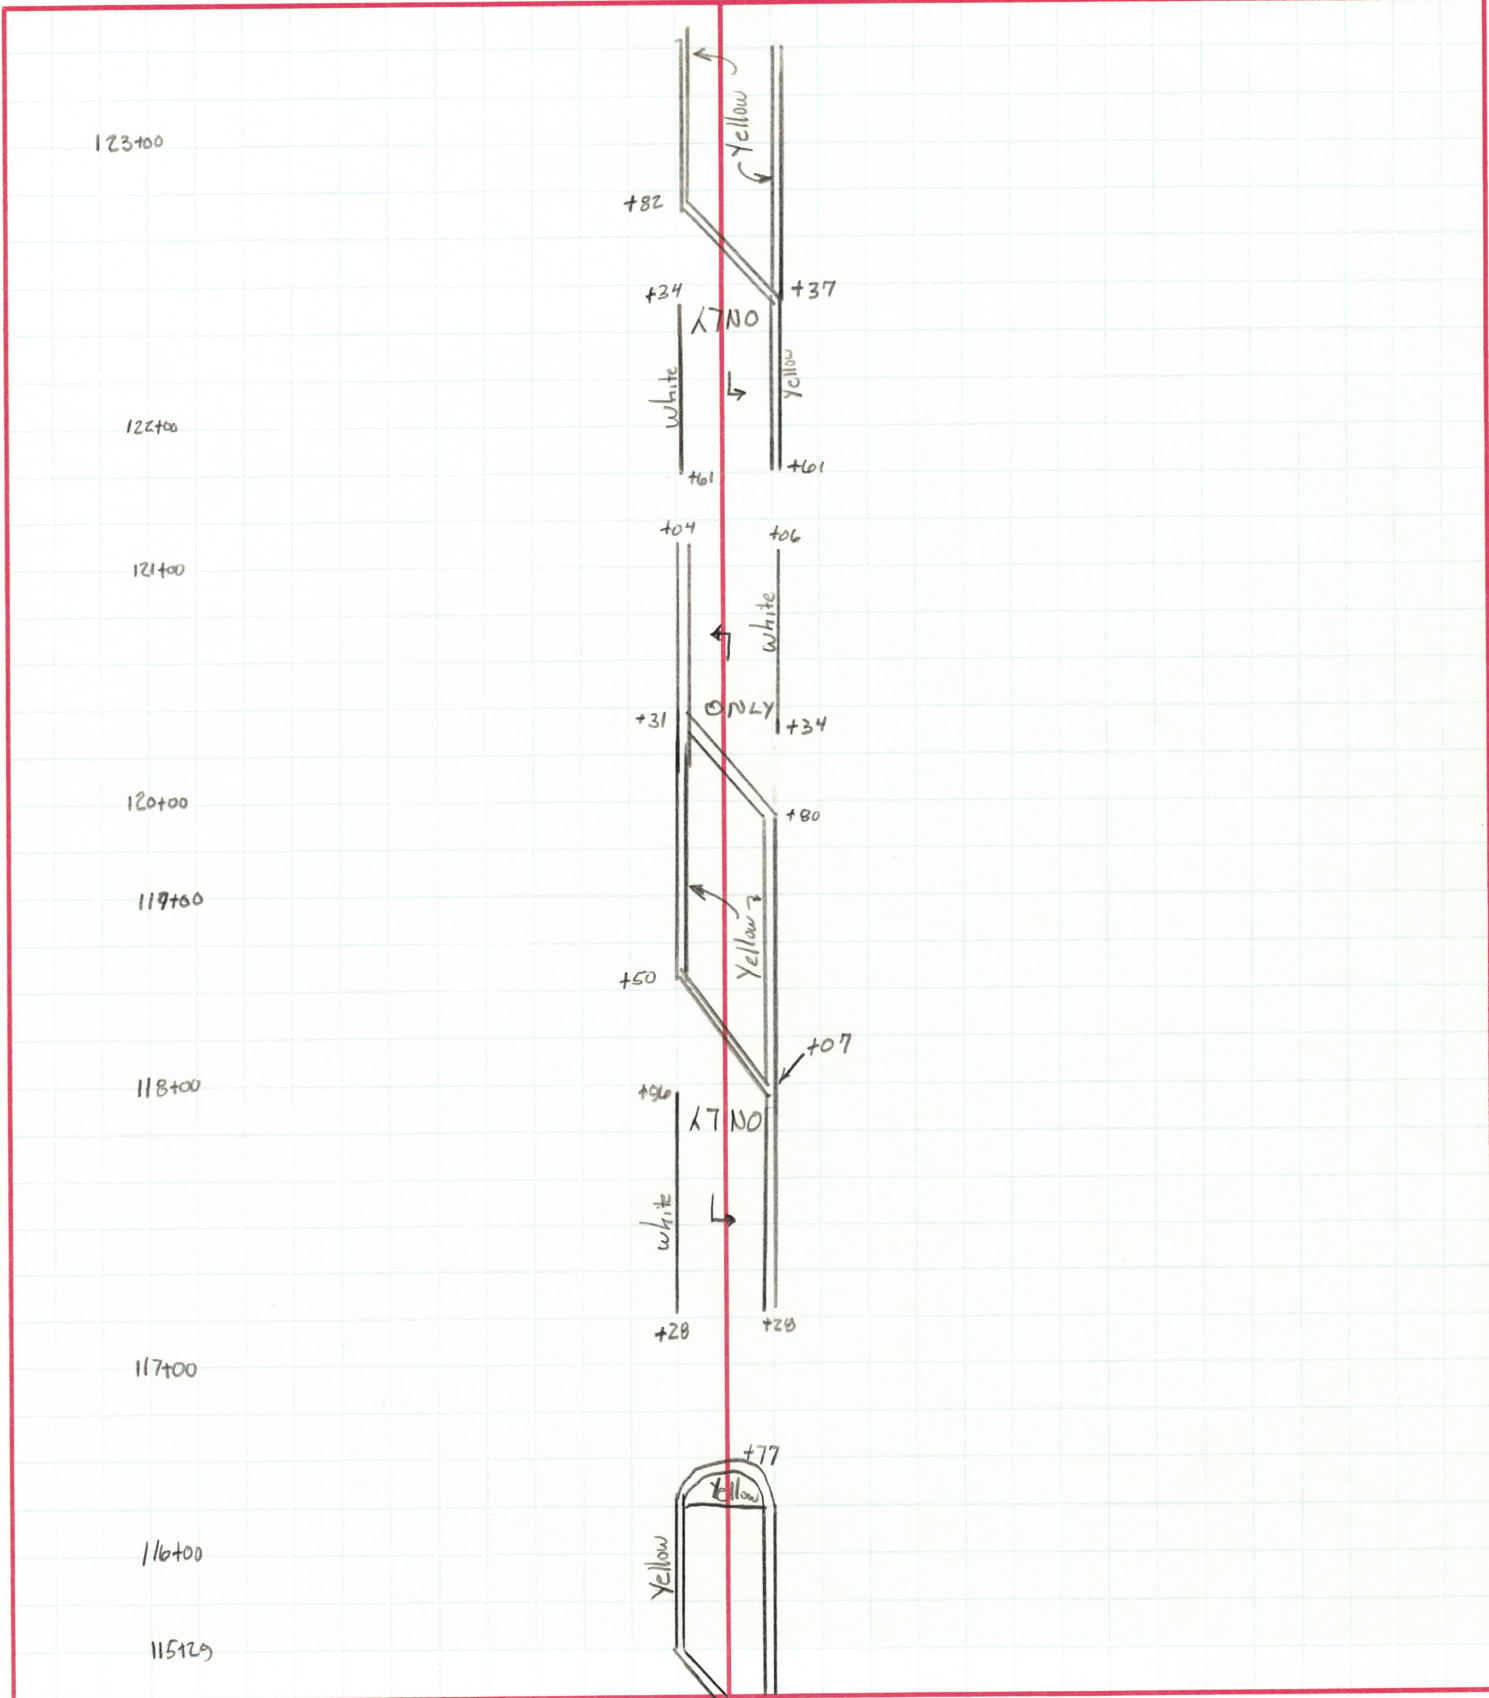

194SWH

OHIO DEPARTMENT OF TRANSPORTATION

SHEET NO. 8-14

P. M3

PERSONNEL

TITLE

PERSONNEL

TITLE

COUNTY FULTONDATE 7-27-94LOGARKE1S. R. 606WEATHER NiceCrewSEC. 0.0TEMP. +68

DESCRIPTION

PAV MARKINGS

JOB NO. _____

LEFT

CENTER LINE

RIGHT

128+00

127+00

126+00

125+00

124+00




123+00

5'

PAINTED SIDEWALK ON ASPH.

white

white

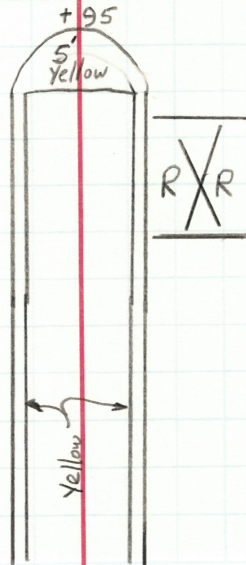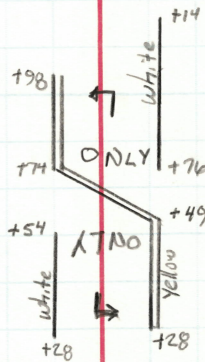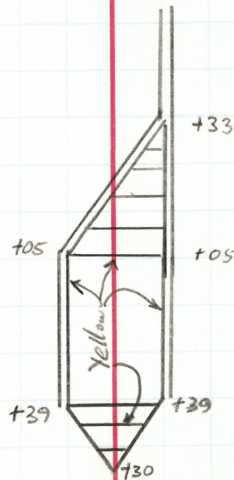

127+69

5'

PAINTED SIDEWALK ON ASPH.

white

white

125+98

Note: "PAINTED SIDEWALK" looks Like Cross Walk, Both Sides


PERSONNEL	TITLE	PERSONNEL	TITLE	COUNTY	DATE	WEATHER	TEMP.
LOEHKE				FULTON	7-27-94	Nice	+68
Crew				S. R. 66			
				SEC. 0.00			

DESCRIPTION	PAVT	MARKINGS	JOB NO.

LEFT

CENTER LINE

RIGHT

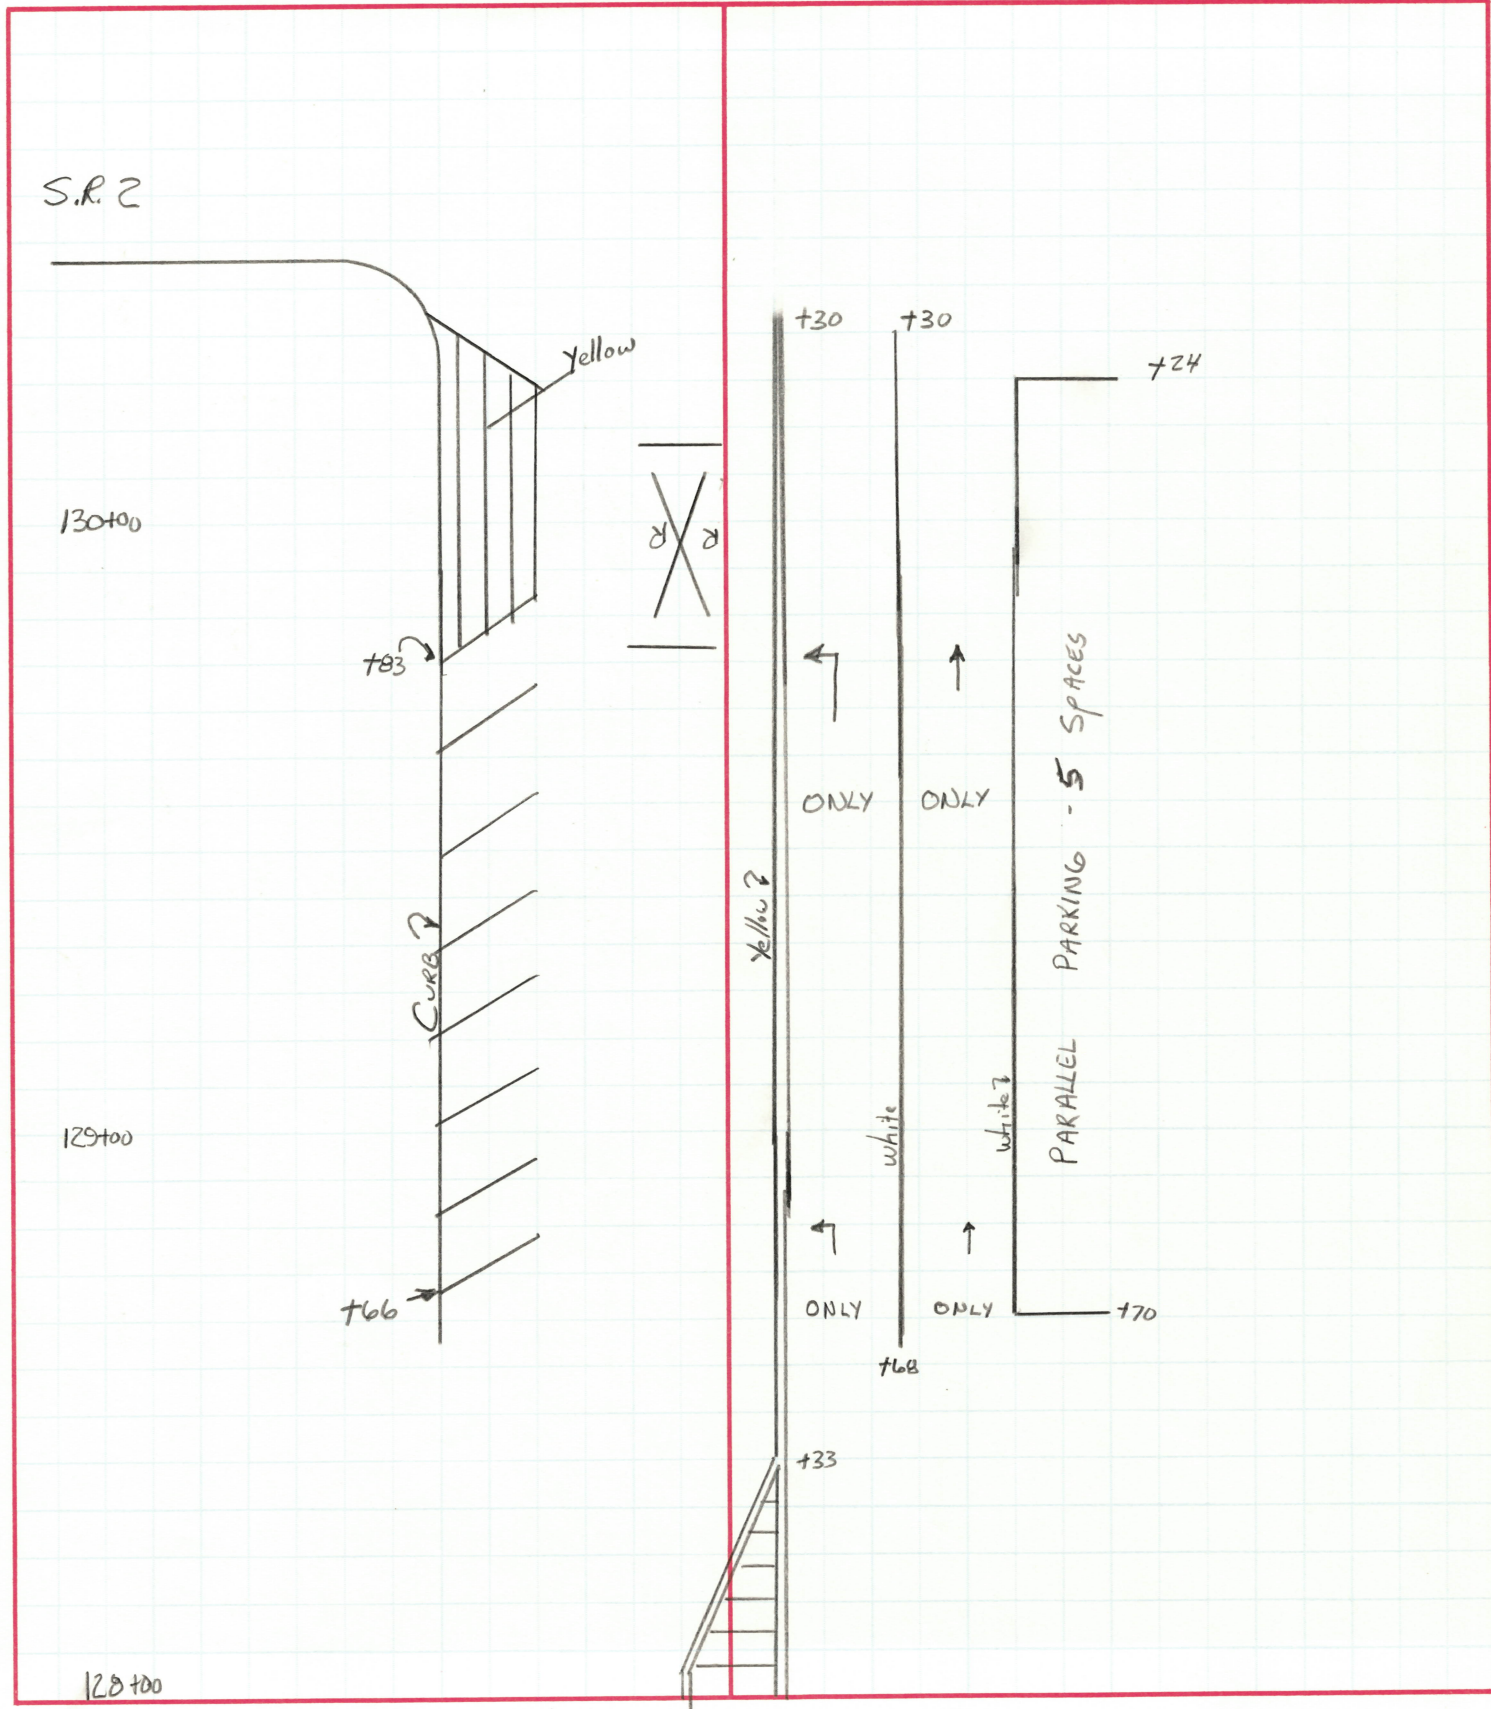

DATE 7-26-94

SHEET 11 OF 14

NOTE: LOCATE ALL
CHANGES IN PVMT WIDTH


TWO-LANE RESURFACING PROGRAM
PAVEMENT DATA

COUNTY FULTON ROUTE 66 SECTION 0.00

[illegible]

PERSONNEL	TITLE	PERSONNEL	TITLE	COUNTY	DATE
LOCHKE				FULTON	7-27-94
				S. R.	S.R. 666
				WEATHER	Dice
Crew				SEC.	O.O
				TEMP.	46.8

DESCRIPTION PAVT. W.OTH JOB NO.

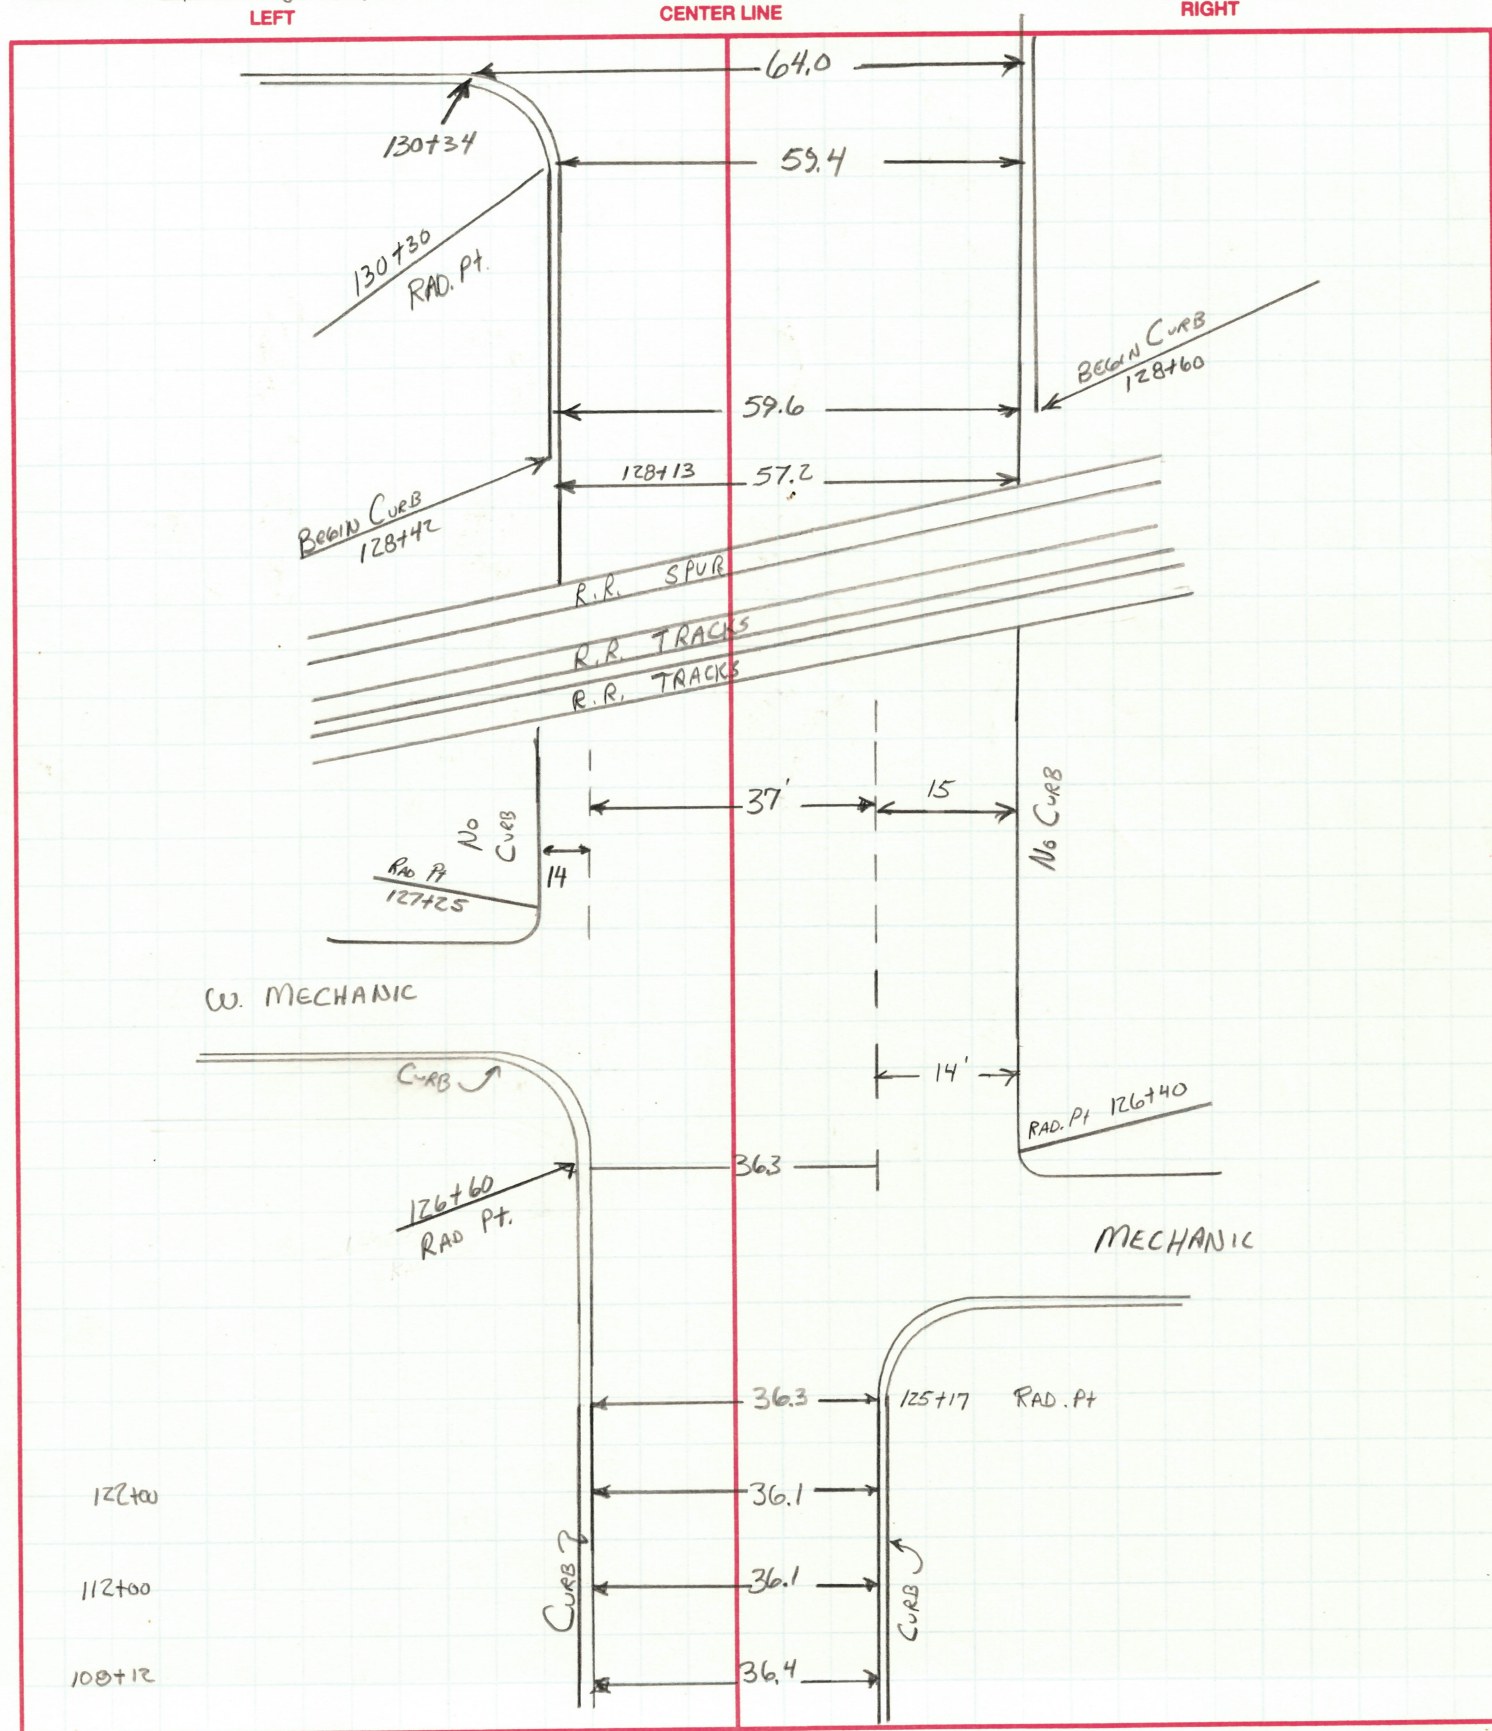

SHEET 13 OF 14

SHEET 13 OF 14

1. *Chlorophyll a* and *Chlorophyll b* contents were determined by spectrophotometry using the method of Lichtenthaler and Whistler (1987).

[illegible]

DATE 7-27-94

1995 ~~1995~~ TWO-LANE RESURFACING PROGRAM
DEFECTIVE PAVEMENT AREAS

SHEET 14 OF 14

COUNTY FULTON ROUTE S.R 66 SECTION 0.00

[illegible]