


O.D.O.T. DISTRICT 2 SURVEY OFFICE (USE ONLY)


PERSONNEL _____ REFERENCE NO. 3 SHEET 3 OF 24
 NOTES AUBLE DATE 3-21-18 ROUTE SR 66
 H.C. LEU WEATHER CLOUDY, WINDY COUNTY FULTON
 R.C. AUBLE TEMP. 32° TOWNSHIP GERMAN
 _____ SECTION 8
 DWG BY RHOADES PID 101211 T 6 N R 5 E

TYPE MONUMENT MONBOX W/ CMON
 ON SURFACE - ~~BELOW~~ ON
 OFFSET CL PAVEMENT ON LT : RT
11.6' TO LT EDGE PAVEMENT
 STATION: 26+47.32

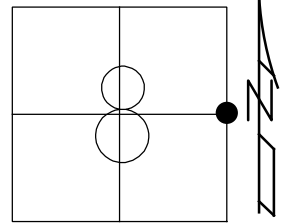

HORZ. DATUM: NAD83 2011 GEOID: NAVD88 2012A
 GRID: NORTHING: 670510.498 EASTING: 1473703.640

RECORD:
 FD P.K.NAIL
 7-8-95, CL
 SET P.K./WASHER
 8-7-96, CL
 FD MONBOX
 W/ CMON
 REF3
 3/21/18,
 12/19/18, JLL

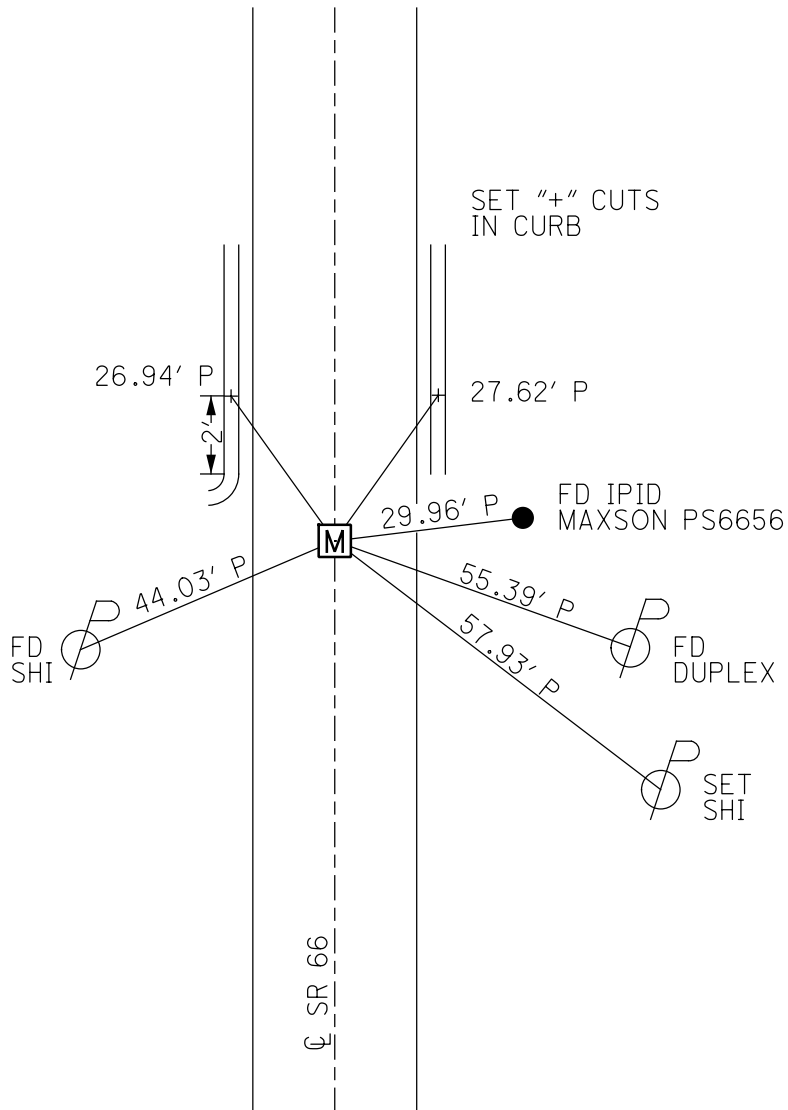

O.D.O.T. DISTRICT 2 SURVEY OFFICE

PERSONNEL _____

REFERENCE NO. 3

SHEET 3 OF 24

NOTES LODGE

H.C. RAISOS

R.C. CENTER BARY

DATE 7-8-95

WEATHER CLOUDY

TEMP. +80°

ROUTE S.R. 66

COUNTY FULTON

TOWNSHIP GERMAN

SECTION 8

T 6 N R 5 E

Reset

TYPE MONUMENT PK NAIL / WASH


ON SURFACE - BELOW ON SURFACE

~~LEFT~~ & PAV'T. - RIGHT ON &

11.6 TO LEFT EDGE PAVEMENT



S.L.M. 26+47

8-7-96
C.L.

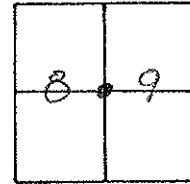

QTR. LINE SEC 8

QTR. LINE SEC 9

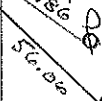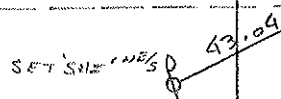

SHIPER NWS

* CUT TOP N BOLT FILE NWS

SHIPER NWS

S.R. 66

County FULTON S.R. 66

Township GERMAN

Section 8

T6N, R5E

Personnel Hoffman

HOUSEHOLDER RC


BARNHISEL HC

LOHRKE CD

Date 7-11-84

Weather CLOUDY, WINDY

Temp. +75

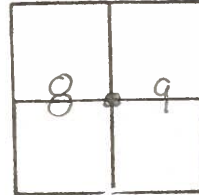

Fd. PK @ SURFACE
 OUG PAUT SR66
 12.2 REP
 11.9 LEP

SLM 26+48

(3)

SET PK+WASHER
 10-22-84
 C.L

QTR LINE Sec 8

QTR LINE Sec 9

SR 66

24.20-P + Cut Top
 SW COR.
 CONC CB.

55.26 DUP
 Nw/s

42.84 + Cut Top
 N. Bolt
 FIRE Hyd.

55.96 SHOWER
 Nw/s

PERSONNEL TITLE PERSONNEL TITLE

Red Beach
W. Knape

COUNTY Fulton

DATE March '75

S. R. 66

WEATHER

SEC. German TWP.

TEMP

DESCRIPTION


CONTROL POINTS

JOB NO.


① SHEET NO. one

①


NOTE: The sec. cor. is 2.5' east of ctr. of the 24' part.

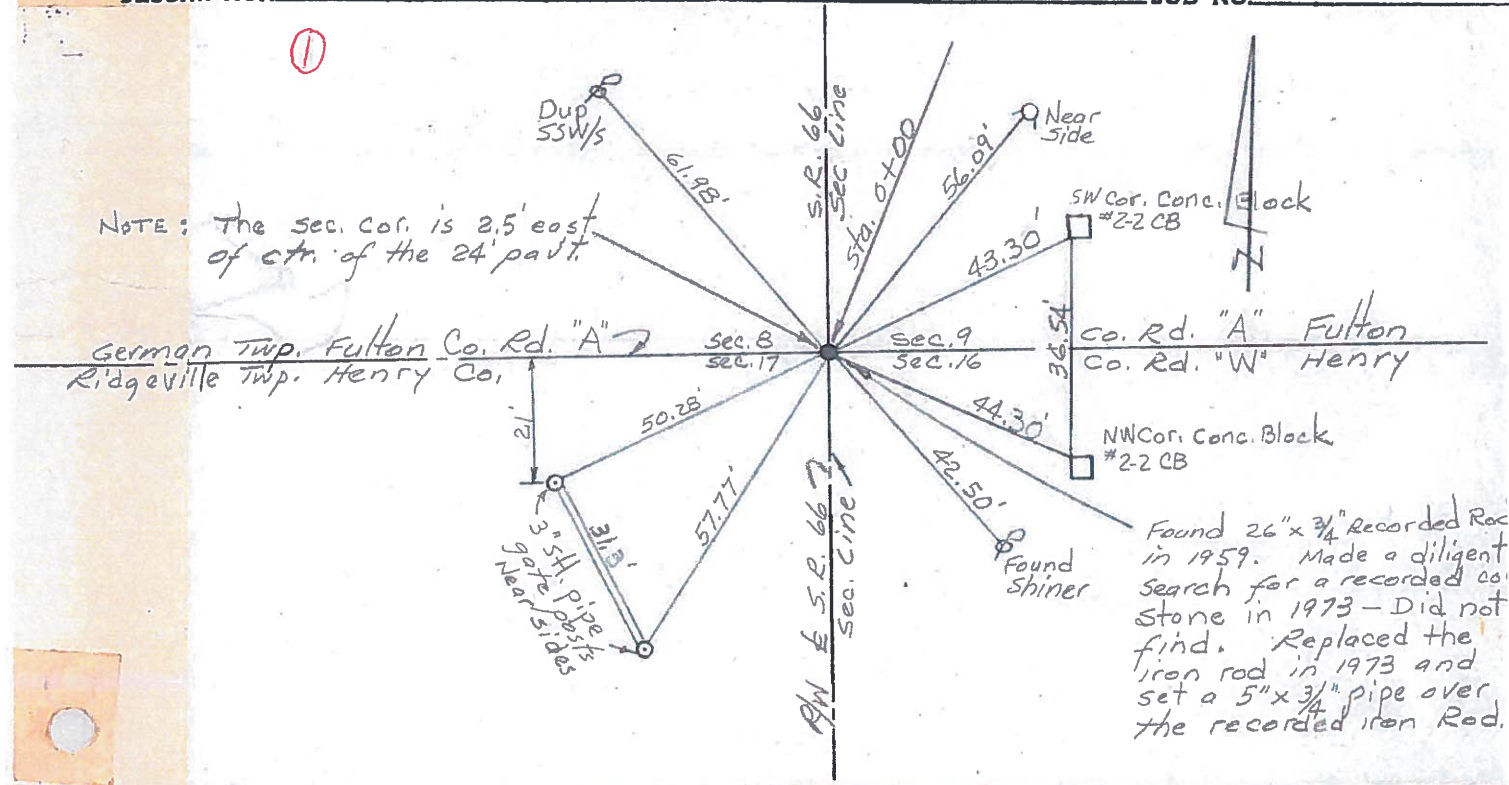

②

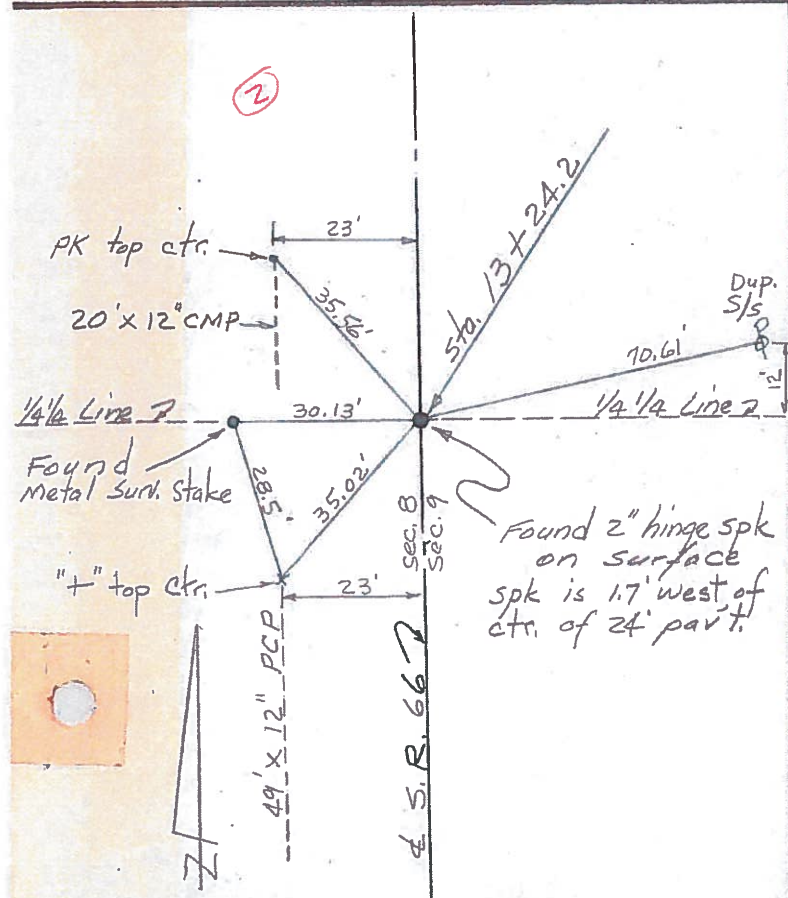

③

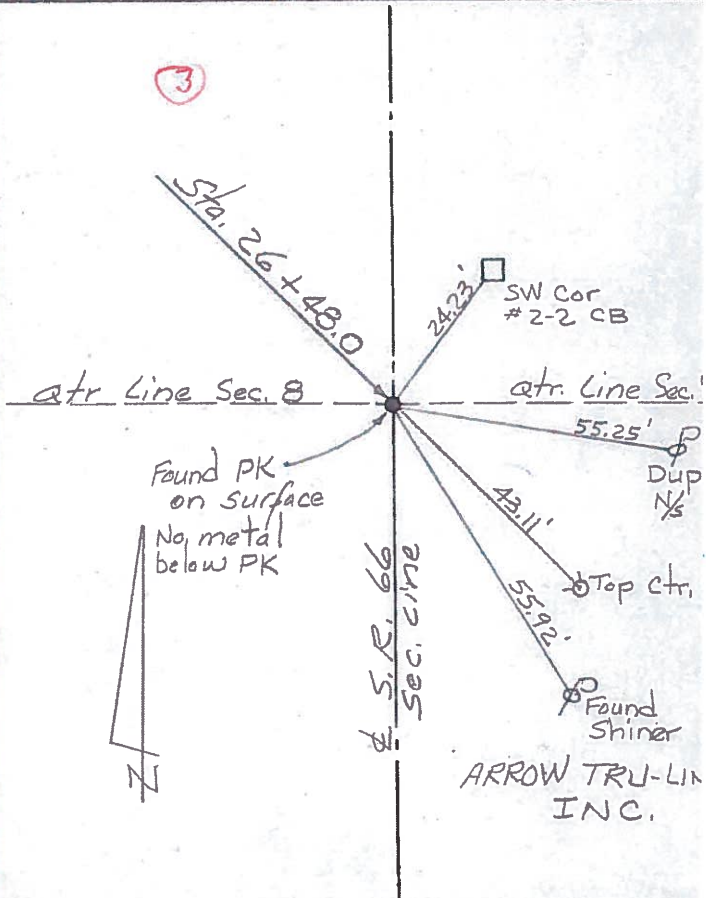

PERSONNEL	TITLE	PERSONNEL	TITLE
Tomsic			
Nasser			
Granata			
Vanyo			

COUNTY Fulton

DATE MAY 1, 1973

S. R. 66

WEATHER

SEC.

TEMP.

DESCRIPTION

LEFT

CENTER LINE

RIGHT

JOB NO.

