

O.D.O.T. DISTRICT 2 SURVEY OFFICE (USE ONLY)

PERSONNEL

REFERENCE NO. 5

SHEET 11 OF 24

NOTES LOEHRKE
 H.C. BARNHISEL
 R.C. HOUSEHOLDER
HOFFMAN

DATE 7/18/84
 WEATHER PARTLY CLOUDY
 TEMP. 64°

ROUTE SR 66
 COUNTY FULTON
 TOWNSHIP GERMAN
 SECTION 5

DWG BY NIESE PID _____

T 6 N R 5 E

TYPE MONUMENT P.K. NAIL

ON SURFACE - ~~BELOW~~ ON


OFFSET ☉ PAVEMENT ON LT : RT

- TO - EDGE PAVEMENT


STATION: 79+51

HORZ. DATUM: _____ GEOID: _____

GRID: NORTHING: _____ EASTING: _____

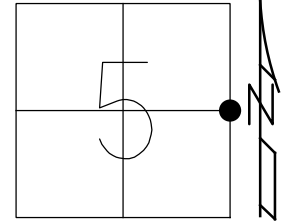

RECORD:
 FD PK/WASHER
 RECORDED AS MONBOX
 7/18/84, CL
 SET PK/WASHER
 10/22/84, CL
 FD MONBOX
 9/96, CAL

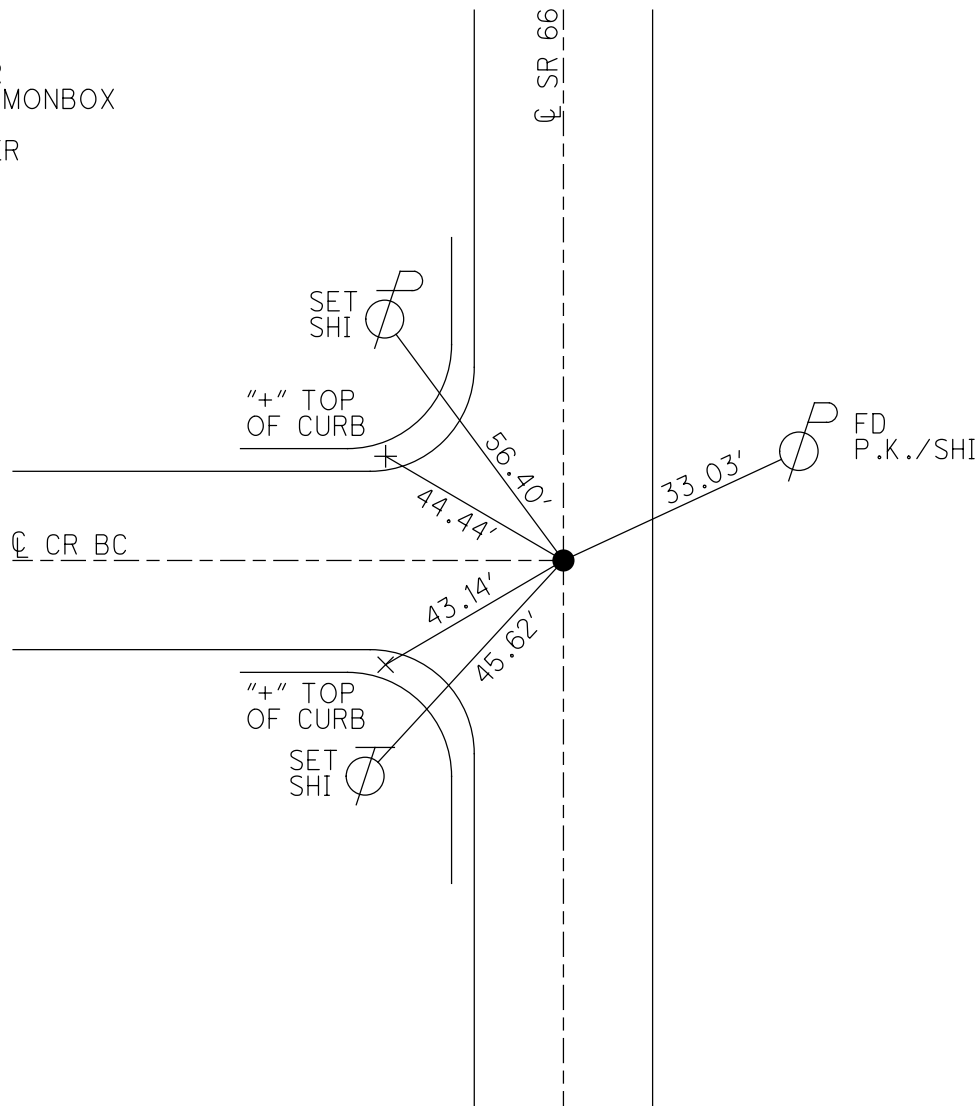

County FULTON S.R. 66

Date 7-18-84

Township GERMAN

Weather PT CLOUDY

Section 5


Temp. +64°

T6N, R5E

Personnel Williams

5

<u>Williams</u>	<u>RC</u>
<u>W. Williams</u>	<u>HC</u>
<u>Carroll</u>	<u>MC</u>
<u>Logan</u>	<u>TD</u>

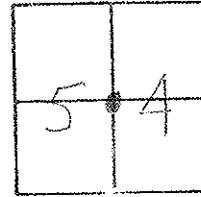

Fd: PK @ SURFACE

SLM 79451

Q Both Rds


SET PK + WASHER

Revised As Map, Box

10-22-84

C.L.

Q SMT SR 66

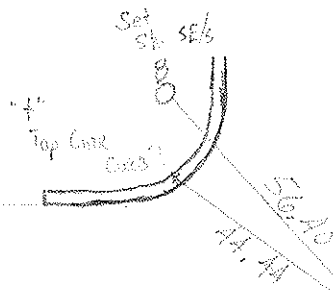


PK. 1/2 W/S

33.03

Q Co. Rd "BC"

QTR LINE Sec 4

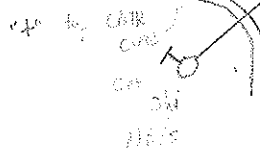

Q SR 66

NOTES:

Recent New Construction monument Box at surface





C.A.C.

9-96

PERSONNEL	TITLE	PERSONNEL	TITLE
Red Beach			
W. Knepe			

COUNTY FULTON DATE March 75
 S. R. 66 WEATHER _____
south ARCHBOLD
 SEC. German TWP TEMP _____


DESCRIPTION CONTROL POINTS JOB NO. _____

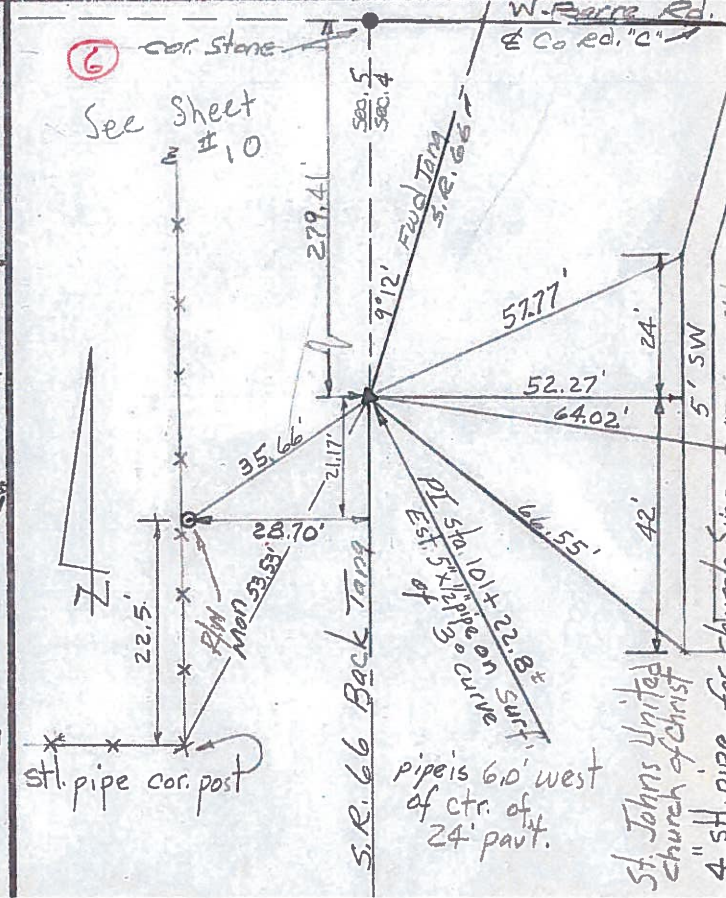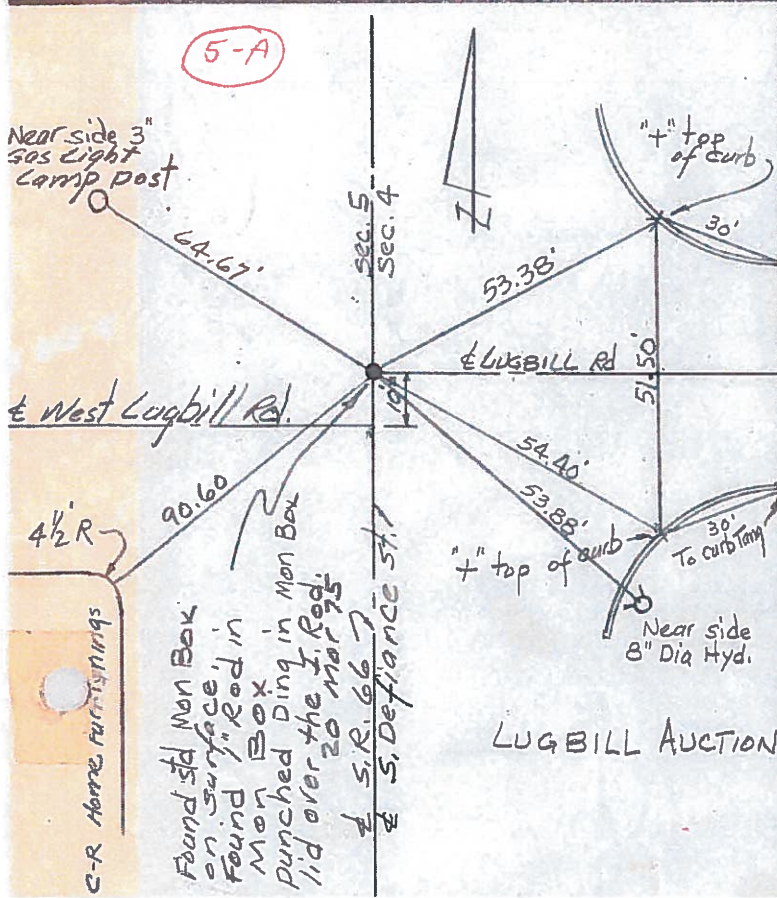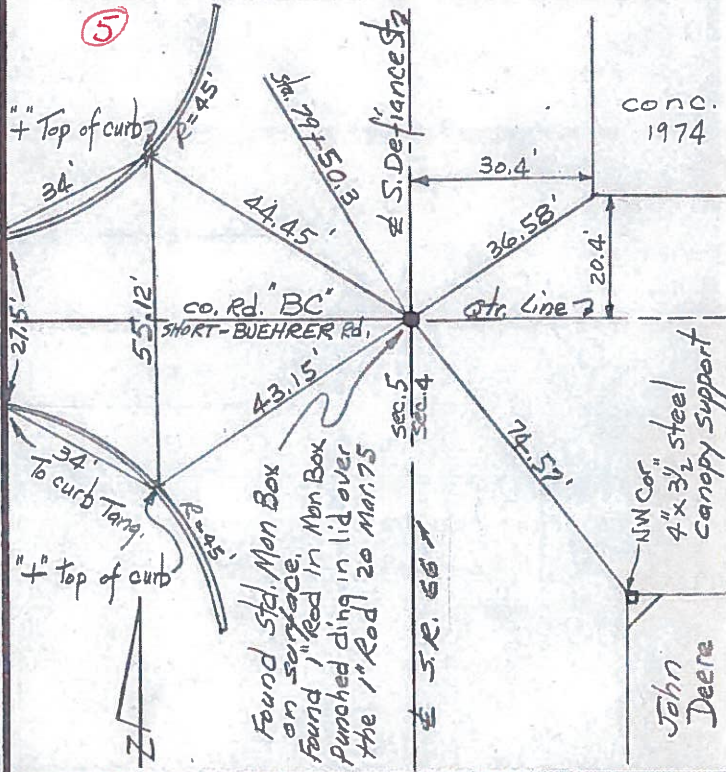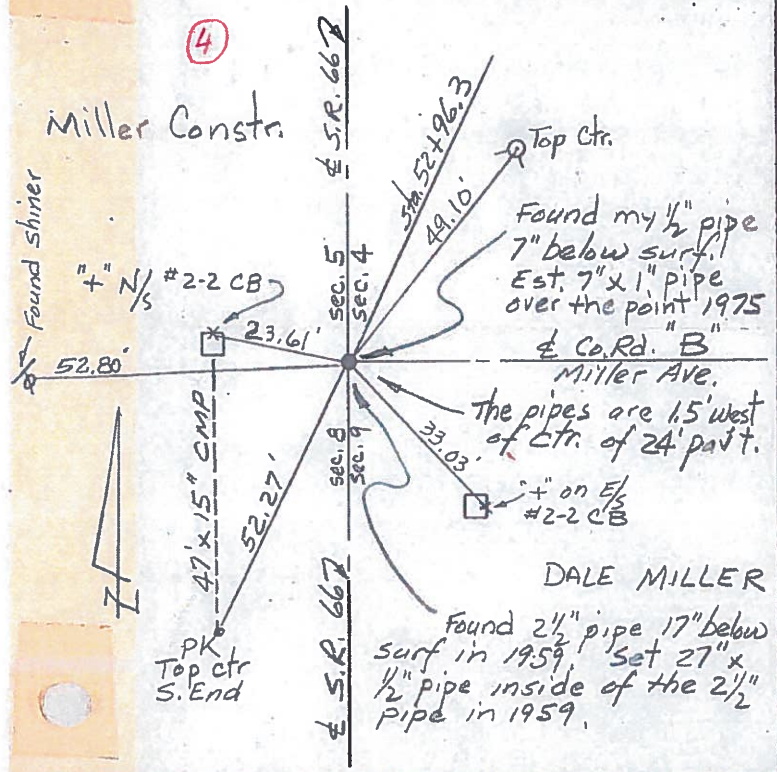

PERSONNEL	TITLE	PERSONNEL	TITLE
Tomsic			
Neuser			
Granata			
Vanyo			

COUNTY Fulton DATE MAY 1, 1973
 S. R. 66 WEATHER _____
 SEC. ARCHBOLD O. TEMP. _____

DESCRIPTION _____ LEFT _____ CENTER LINE _____ RIGHT _____ JOB NO. _____

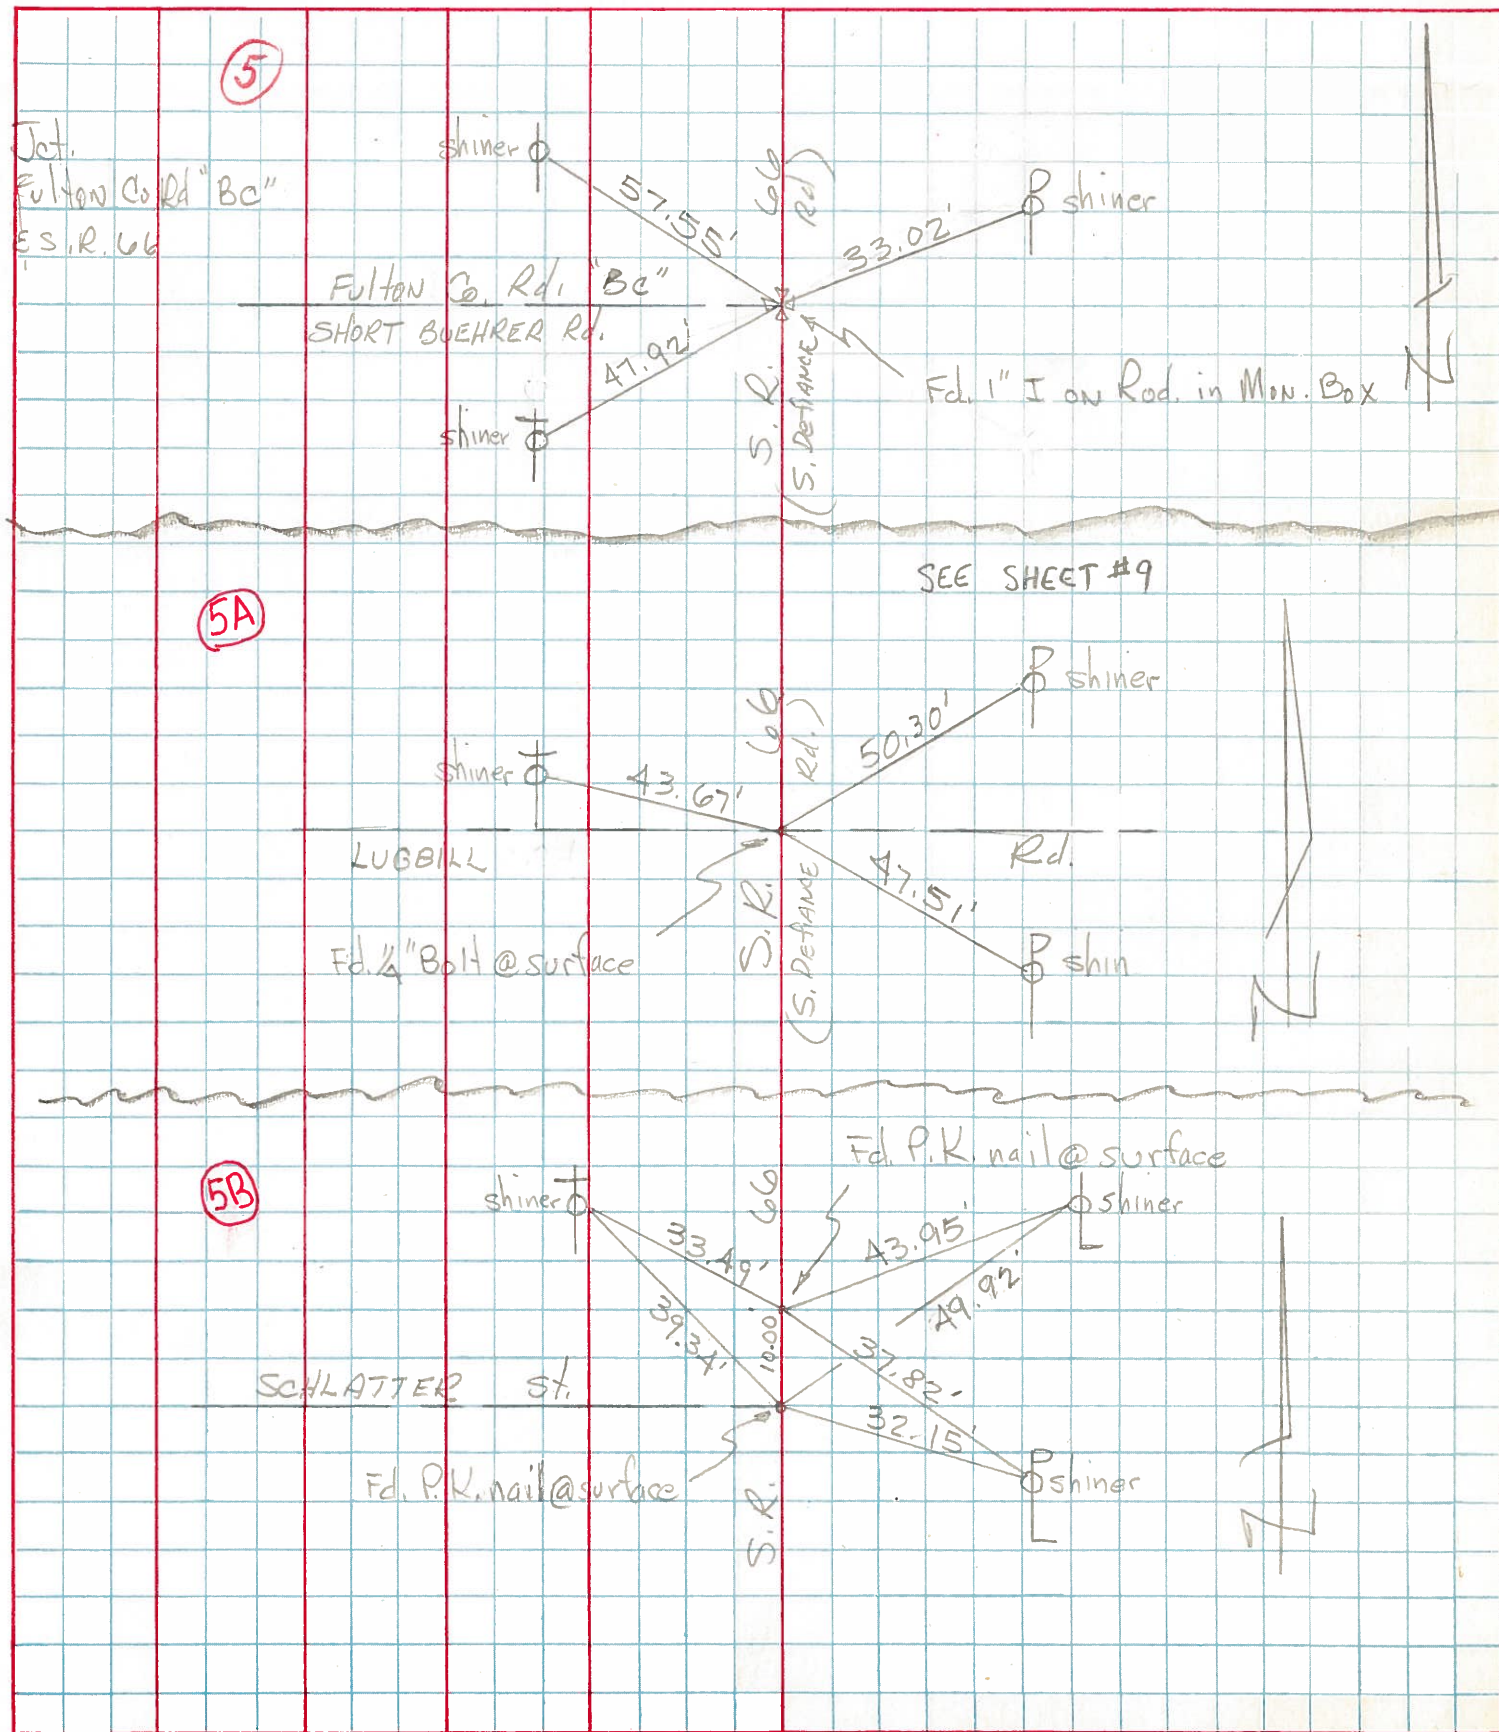

COMPUTATION SHEET

STATE OF OHIO - DEPARTMENT OF HIGHWAYS - BUREAU OF LOCATION AND DESIGN _____ COLUMBUS, OHIO



BY Denno - Curtis - Omev - Granata DATE June 13, 1966 NO. _____ OF _____ SHEETS

COUNTY Fulton SECTION _____

DIV. NO. 2 S.R. 66 U.S.R. _____ I. R. _____

SUBJECT OF THIS SHEET Monument Ref SR 66 Archbold

5

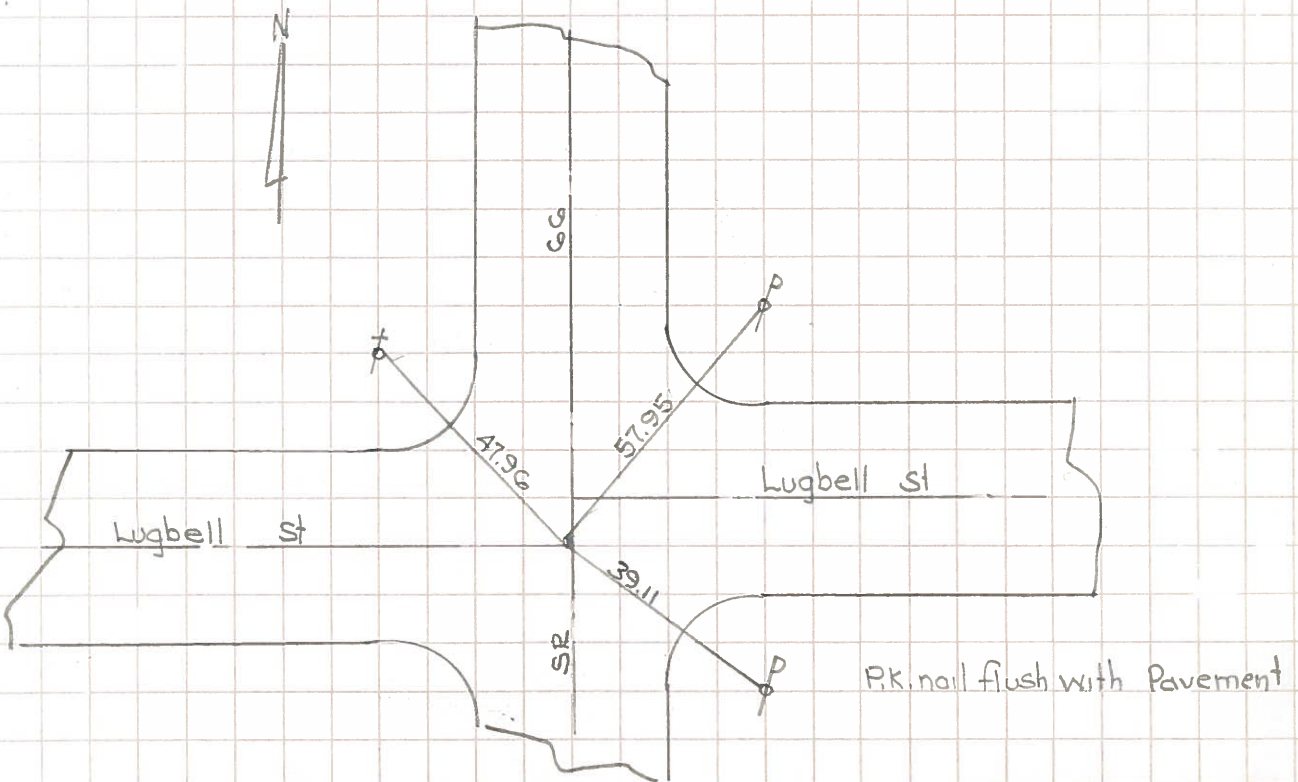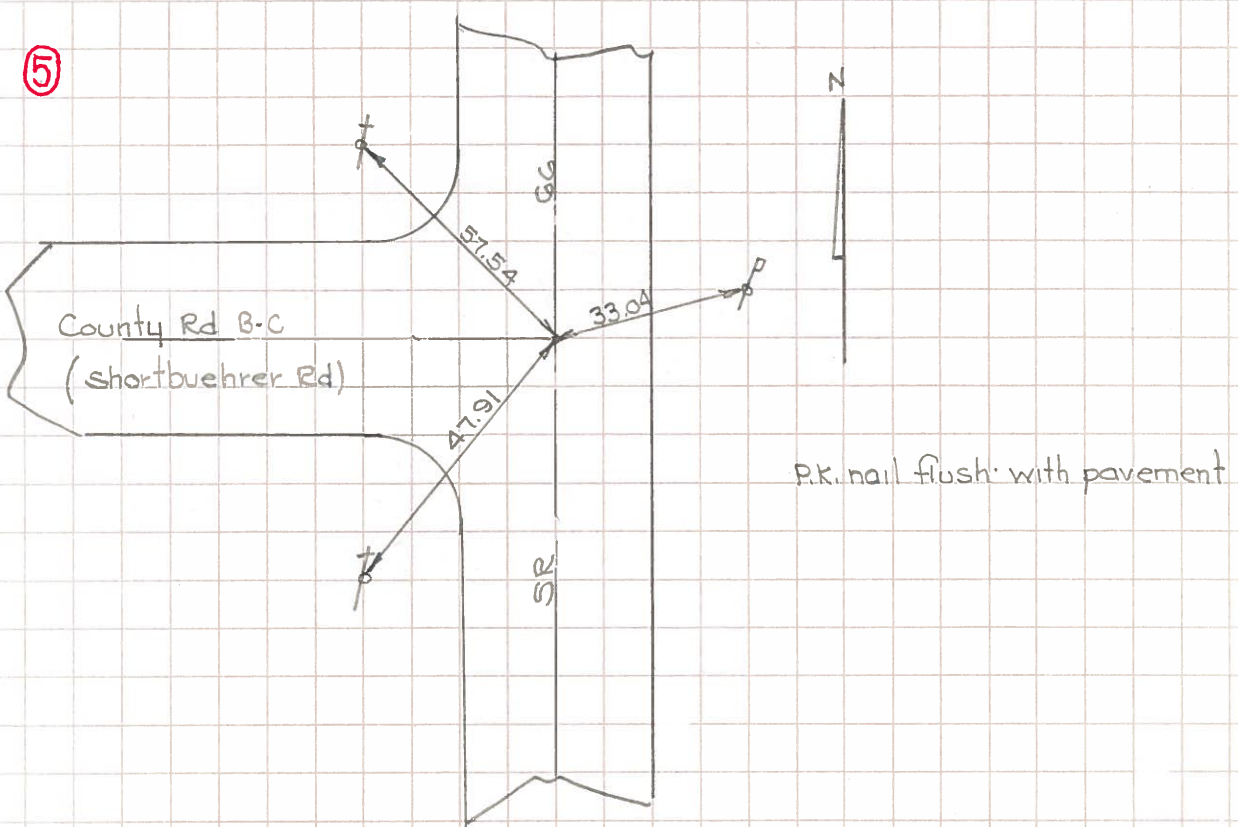

PERSONNEL	TITLE	PERSONNEL	TITLE
Beach			
Knape			
Gunter			

COUNTY Fulton DATE 14 Oct '59

S. R. 66 WEATHER _____

SEC. Henry-Fulton North TEMP _____

DESCRIPTION CONTROL POINTS JOB NO. _____

LEFT CENTER LINE RIGHT

