

O.D.O.T. DISTRICT 2 SURVEY OFFICE (USE ONLY)

PERSONNEL

REFERENCE NO. 5 A

SHEET 12 OF 24

NOTES LOEHRKE

DATE 7/18/84

ROUTE SR 66

H.C. BARNHISEL

WEATHER CLEAR

COUNTY FULTON

R.C. HOUSEHOLDER

TEMP. 65°

TOWNSHIP GERMAN

HOFFMAN

SECTION 5

DWG BY NIESE

PID \_\_\_\_\_

T 6 N R 5 E

TYPE MONUMENT P.K. NAIL

~~ON SURFACE~~ - BELOW 3"

OFFSET  $\odot$  PAVEMENT ON LT : RT

- TO - EDGE PAVEMENT


STATION: 87+33

HORZ. DATUM: \_\_\_\_\_

GEOID: \_\_\_\_\_


GRID: NORTHING: \_\_\_\_\_

EASTING: \_\_\_\_\_

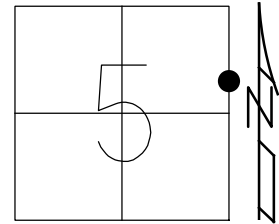

RECORD:  
 FD P.K.  
 3" DOWN  
 SET P.K. NAIL  
 7/18/84, CL  
 SET P.K./WASHER  
 10/22/84, CL  
 FD MONBOX  
 9/96, CAL

DIST. 5A - 5AB = 10.00'

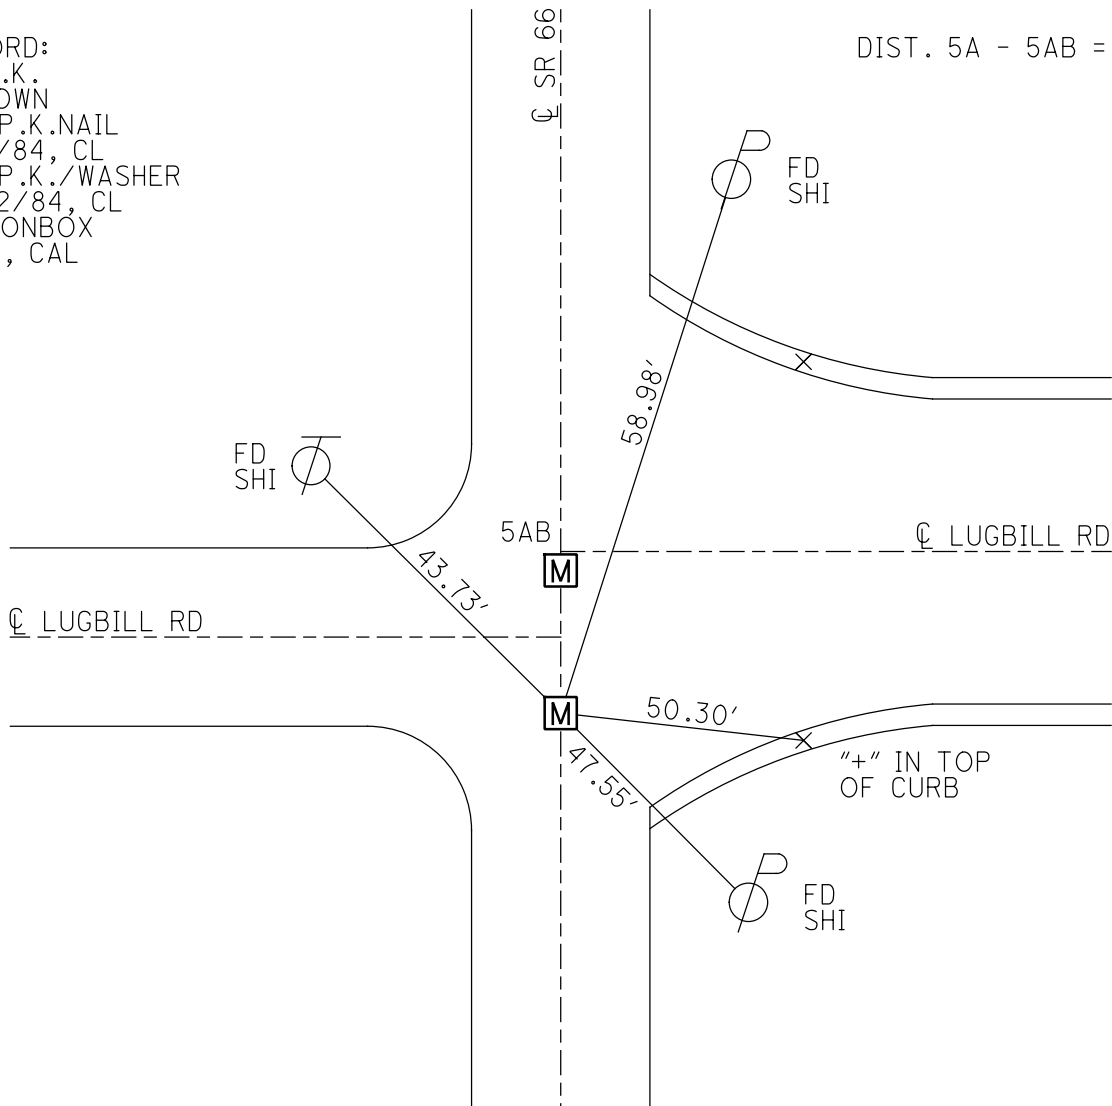

County FULLON S.R. 66

Date 7-18-84

Township GERMAN

Weather CLEAR

Section 5

Temp. +65

T6N, R5E


Personnel Hoffman

HOUSEHOLDER RC

BARBUSEI HC

LOGBILL TI


5A

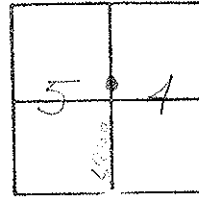

PT. 'A' <sup>Ed:</sup> PK 3" Below from old Ref.  
 DID NOT FIND IRON ROD. SET PK @ SURFACE  
 ON E SR 66  
 4' S of E W LUGBILL RD  
 SLM 87+33

PT. 'B' Ed Main Box Ref to Center.  
 DID NOT OPEN  
 ON E PART SR 66  
 4' S. of E. LUGBILL RD.  
 SLM 87+43

DID NOT RAISE  
 SET PK + WASHER  
 10-22-84  
 C.L.

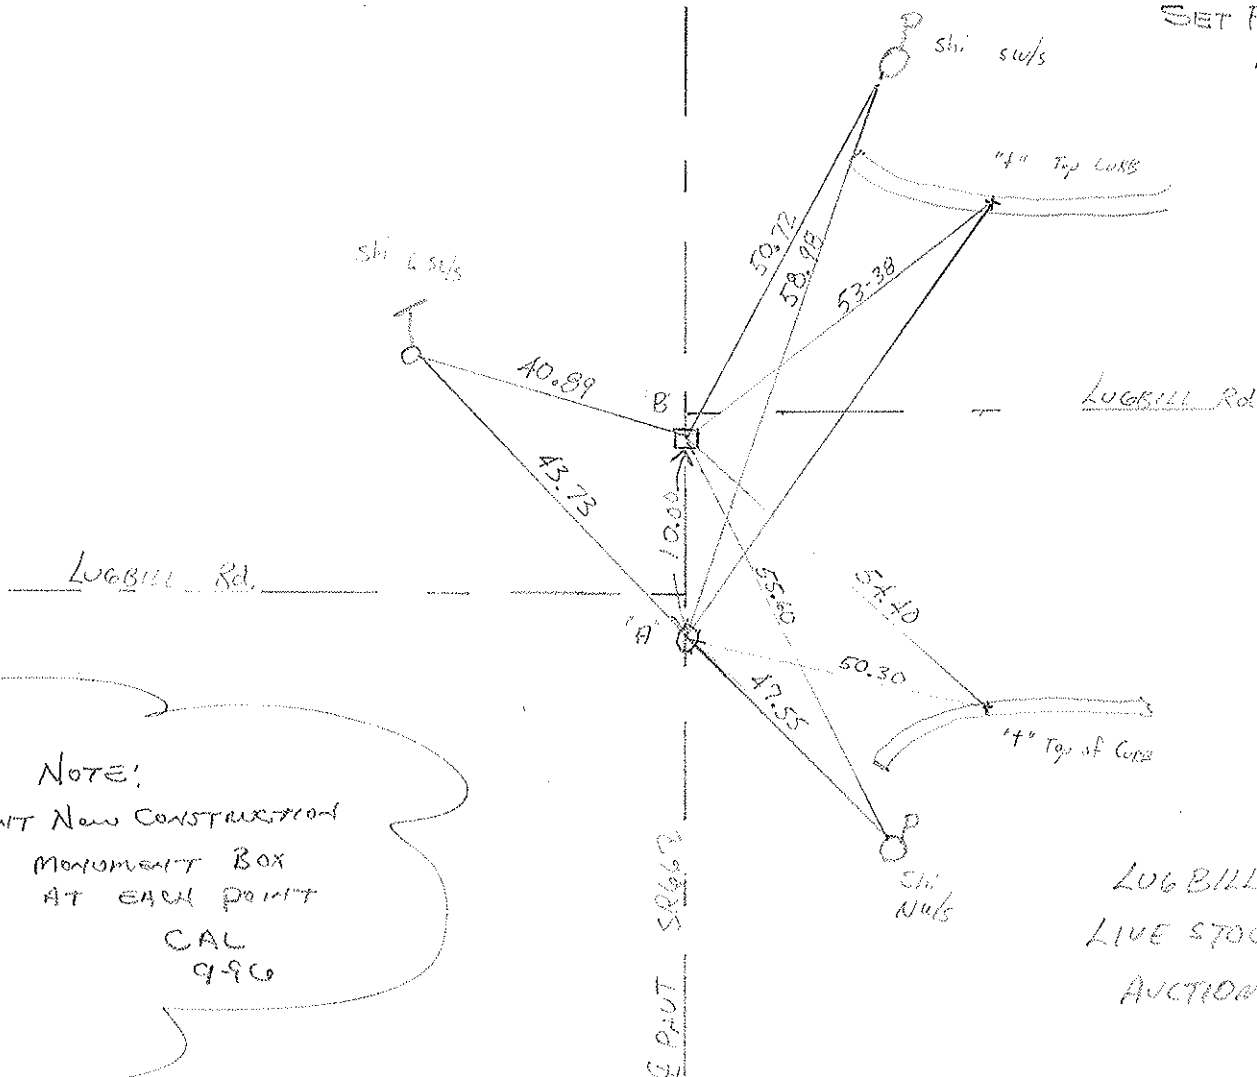

NOTE:  
 RECENT NEW CONSTRUCTION  
 MONUMENT BOX  
 AT EACH POINT  
 CAL  
 9-96

LUGBILL  
 LIVE STOCK  
 AUCTION

PERSONNEL TITLE PERSONNEL TITLE

Red Beach  
W. Knepe

COUNTY FULTON DATE March 75





S. R. 66 WEATHER South ARCHIBOLD

SEC. German Twp TEMP

DESCRIPTION

CONTROL POINTS


JOB NO.

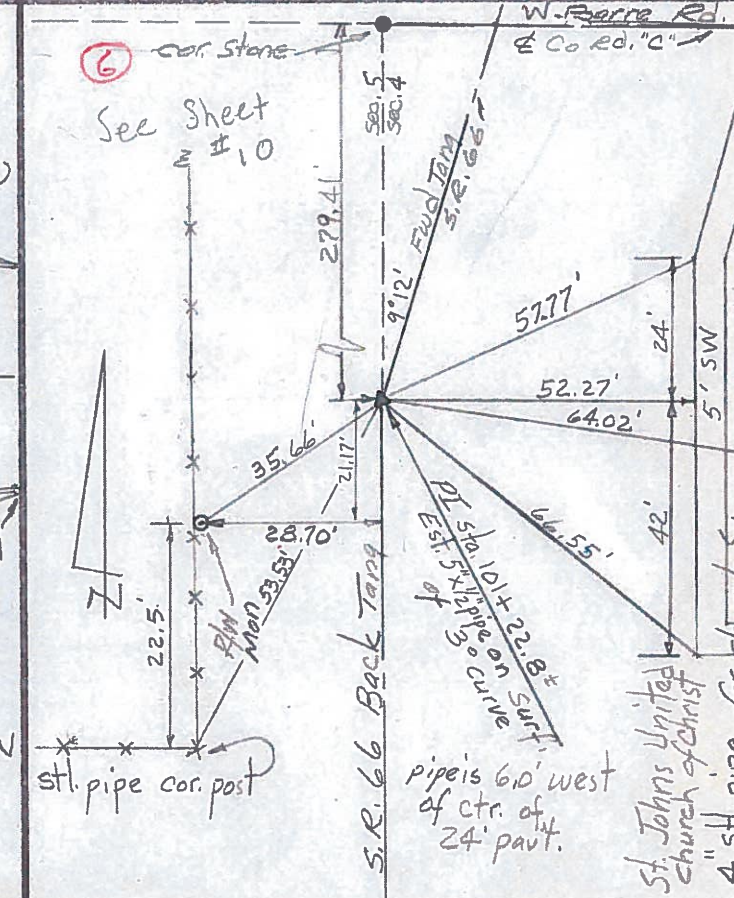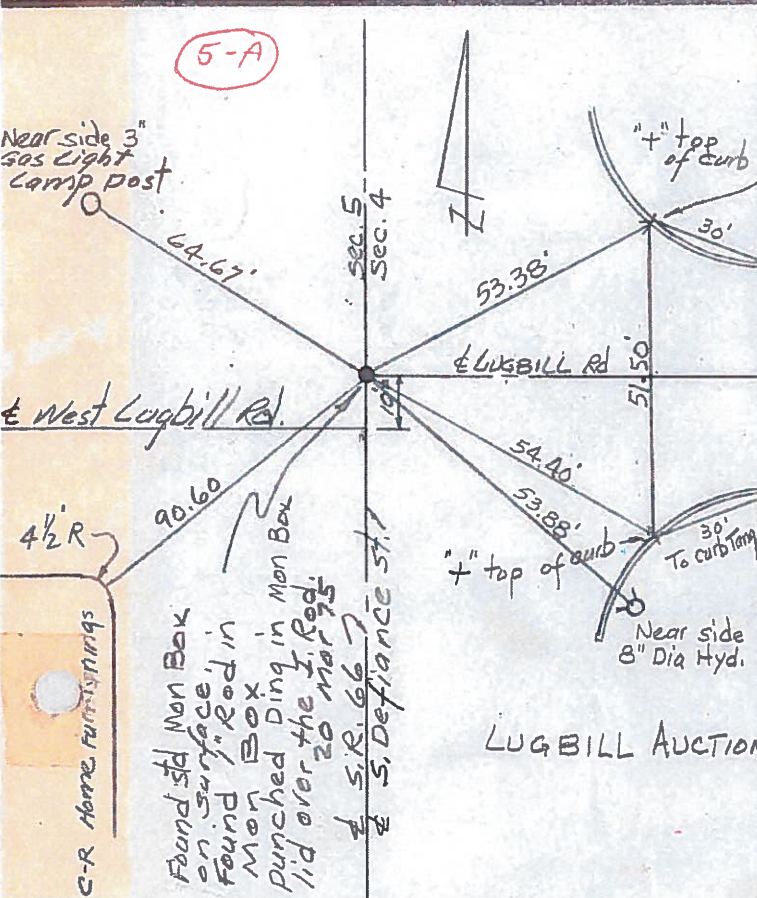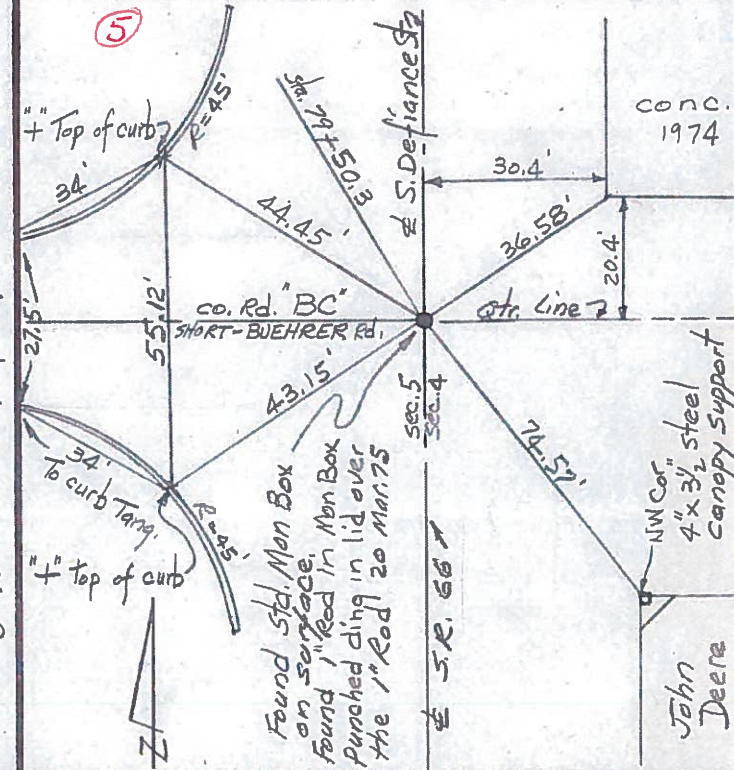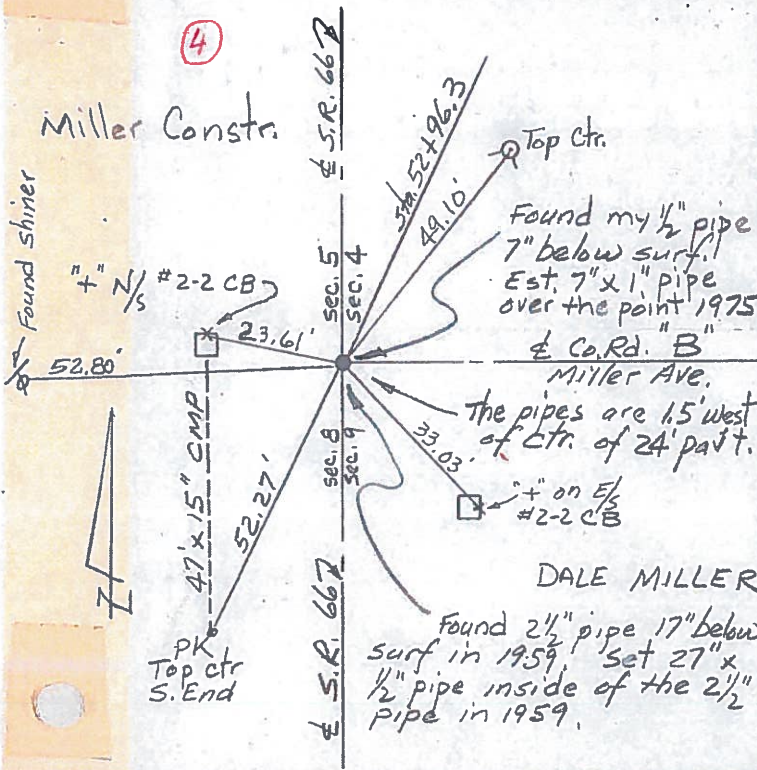


PERSONNEL	TITLE	PERSONNEL	TITLE
Tomsic			
Granata			
Vandy			
Belle			

COUNTY Fulton DATE Aug 27, 1973  
 S. R. 66 WEATHER \_\_\_\_\_  
 SEC. Archbold, O. TEMP. \_\_\_\_\_

DESCRIPTION \_\_\_\_\_ LEFT \_\_\_\_\_ CENTER LINE \_\_\_\_\_ RIGHT \_\_\_\_\_ JOB NO. \_\_\_\_\_

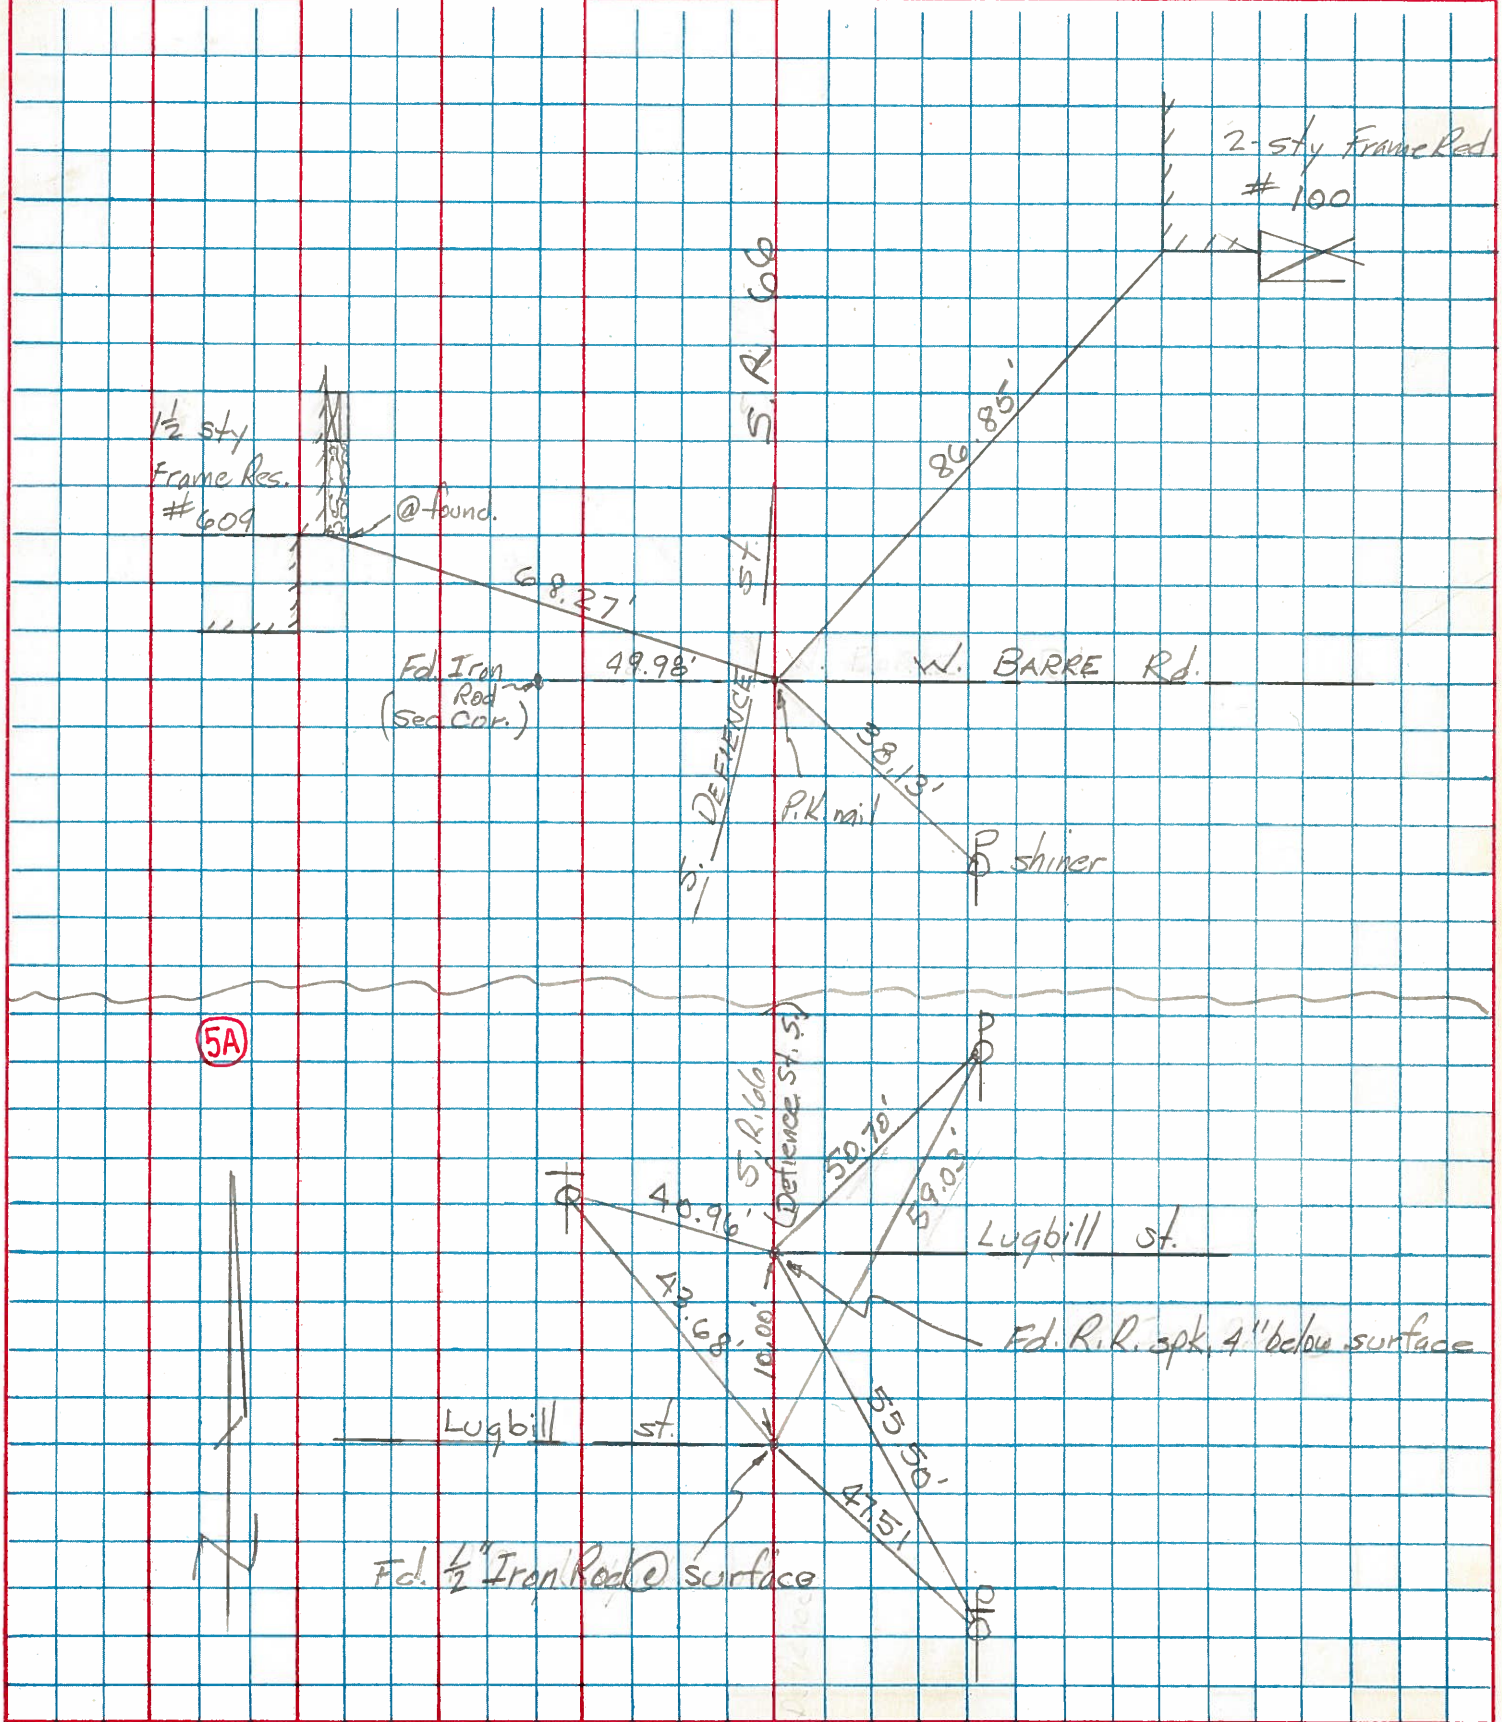

PERSONNEL	TITLE	PERSONNEL	TITLE	COUNTY	DATE	WEATHER	TEMP.
Tamsic				Fulton	MAY 1, 1973		
Nasser				S. R. 66			
Granata				SEC. ARCHBOLD O.			
Vanyo							

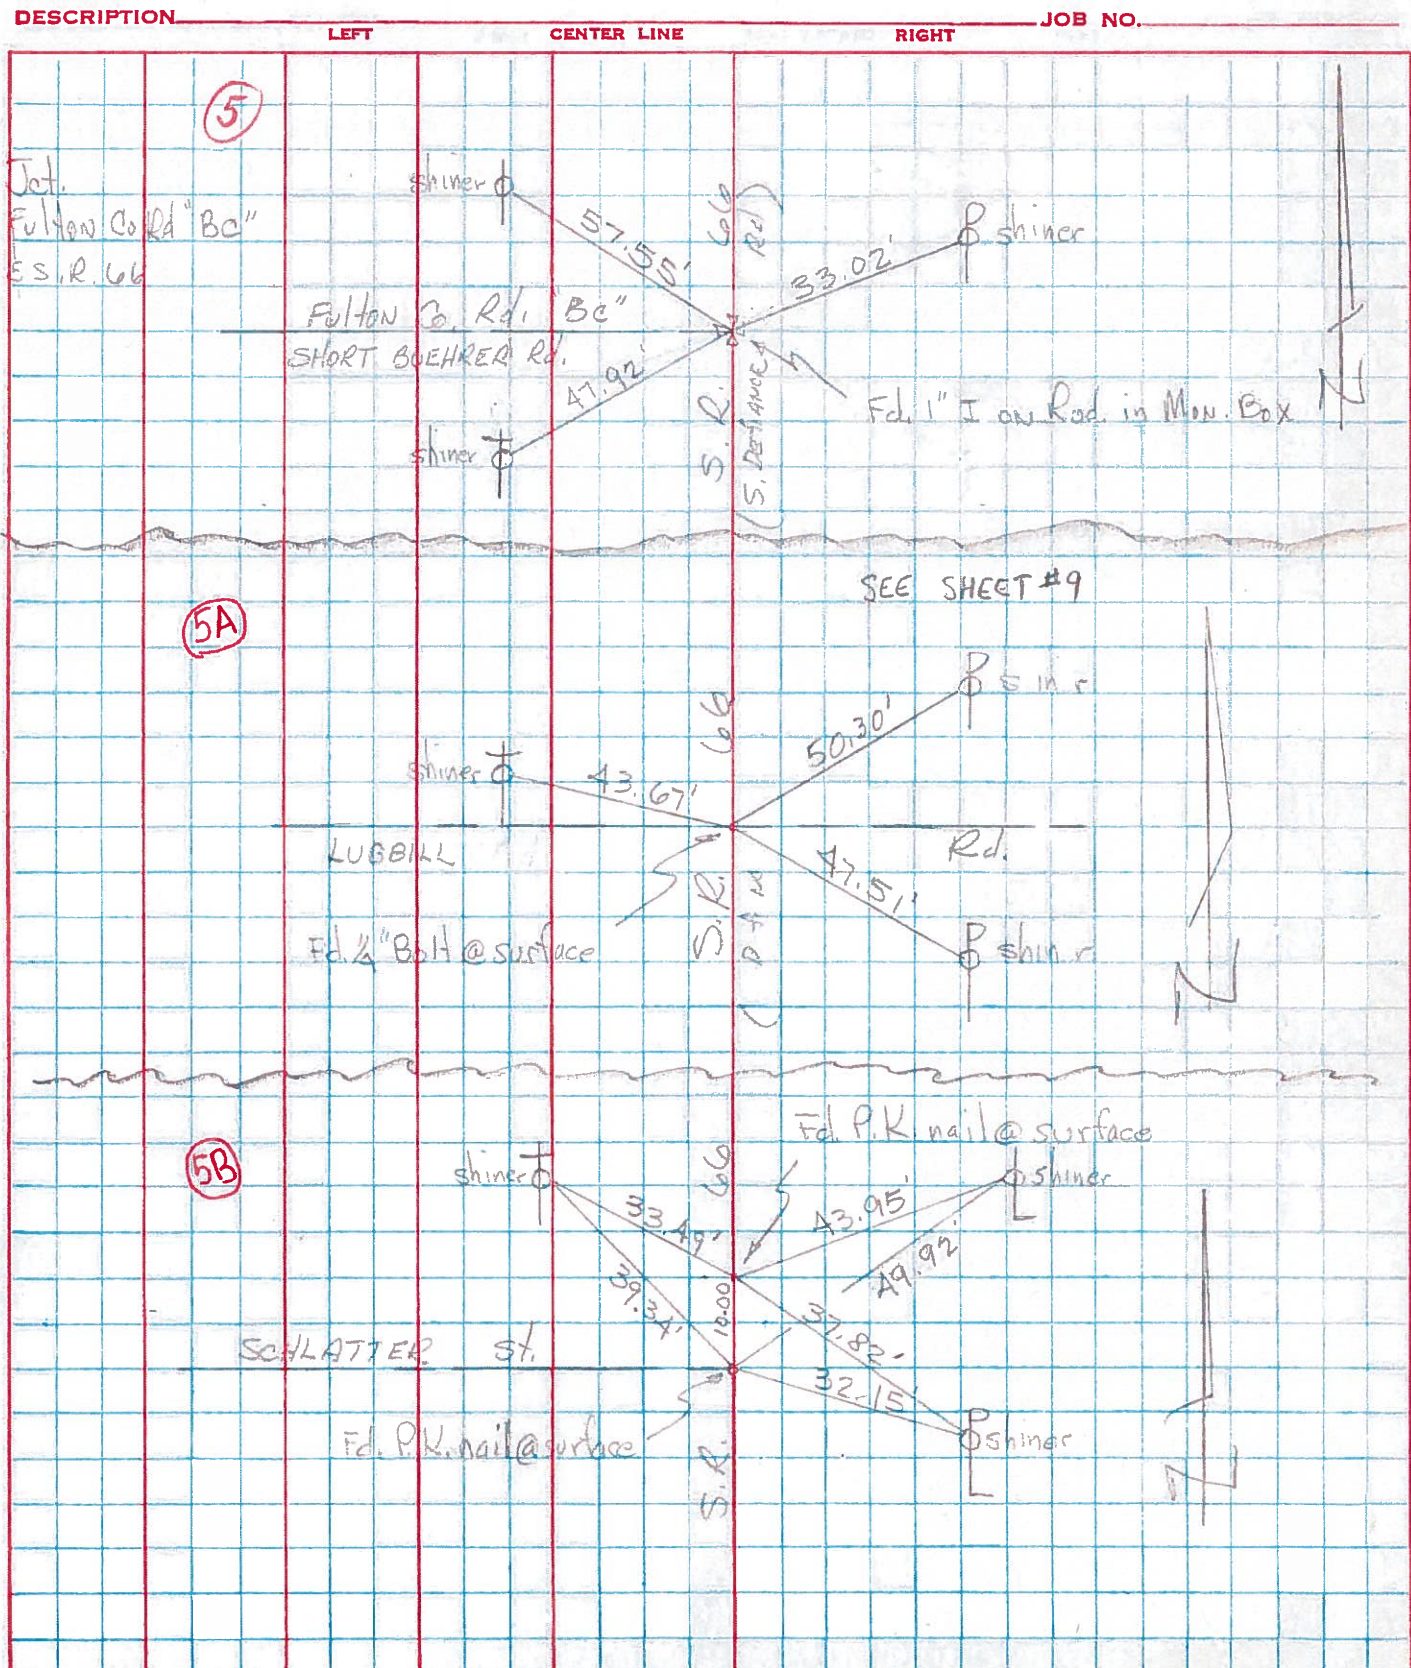

PERSONNEL TITLE PERSONNEL TITLE

Beach  
Knape  
Gunter

COUNTY Fulton

DATE 14 Oct '59

S. R. 66

WEATHER

SEC Henry-Fulton North

TEMP

DESCRIPTION

CONTROL POINTS

JOB NO.

LEFT

CENTER LINE

RIGHT

