

O.D.O.T. DISTRICT 2 SURVEY OFFICE (USE ONLY)

PERSONNEL

REFERENCE NO. 5 AB

SHEET 13 OF 24

NOTES LOEHRKE

DATE 7/18/84

ROUTE SR 66

H.C. BARNHISEL

WEATHER CLEAR

COUNTY FULTON

R.C. HOUSEHOLDER

TEMP. 65°

TOWNSHIP GERMAN

HOFFMAN

SECTION 5

DWG BY NIESE

PID _____

T 6 N R 5 E

TYPE MONUMENT MONBOX

ON SURFACE - ~~BELOW~~ ON

OFFSET \odot PAVEMENT ON LT : RT

- TO - EDGE PAVEMENT


STATION: 87+43

HORZ. DATUM: _____


GEOID: _____

GRID: NORTHING: _____

EASTING: _____

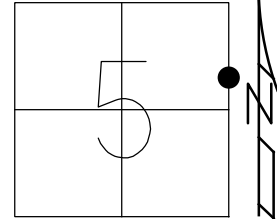

RECORD:
FD MONBOX
7/18/84, CL
SET P.K./WASHER
10/22/84, CL
FD MONBOX
9/96, CAL

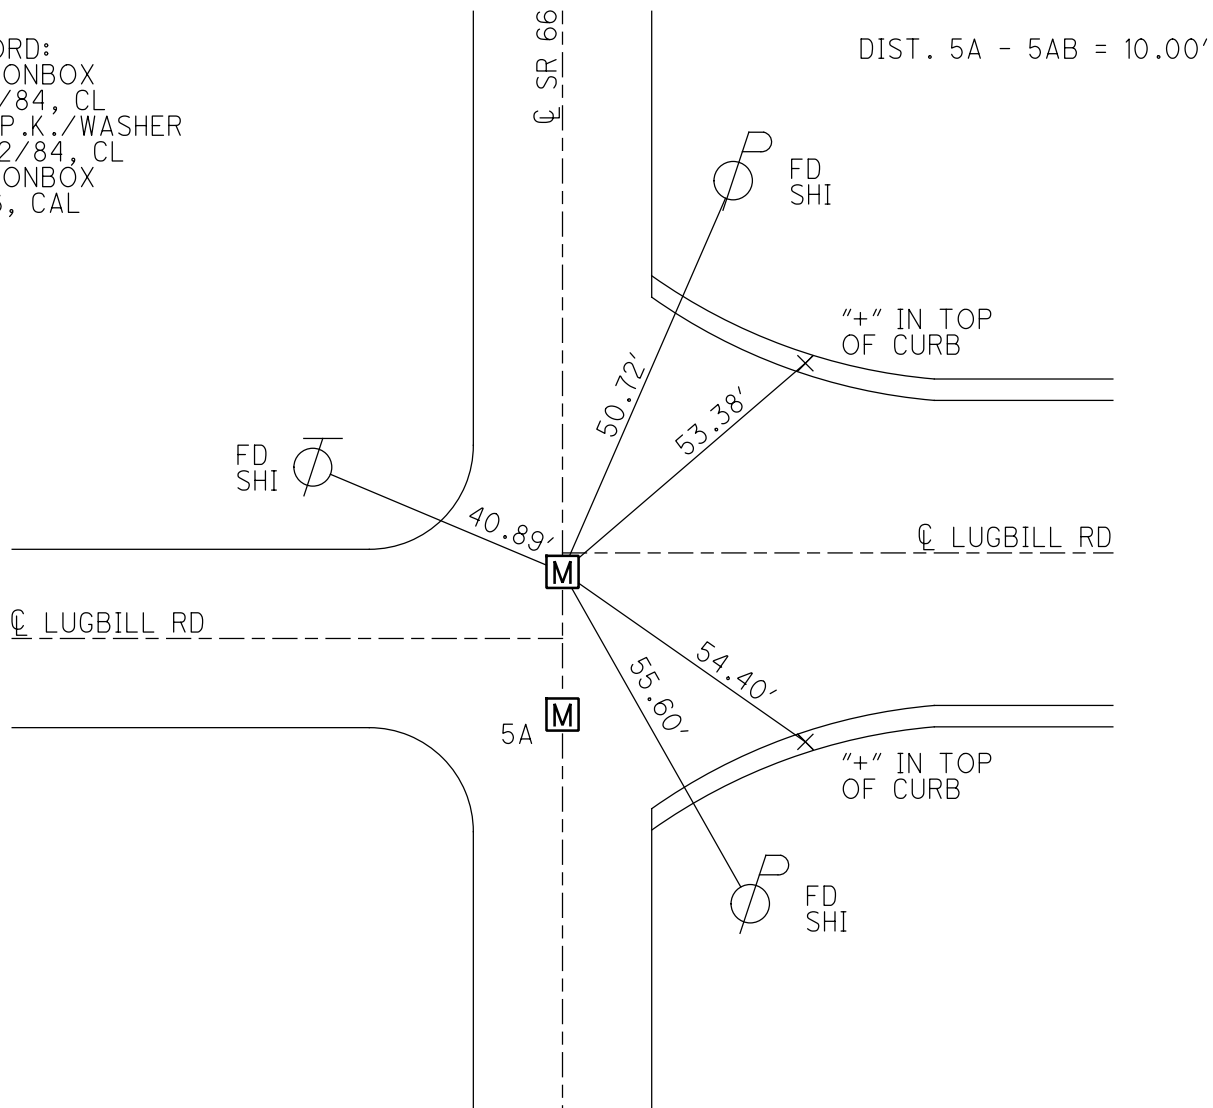

County FULLON S.R. 66

Date 7-18-84

Township GERMAN

Weather CLEAR

Section 5

Temp. +65

T6N, R5E


Personnel Hoffman

HOUSEHOLDING RC

BARBUSEI HC

LOEBNER TI


5A

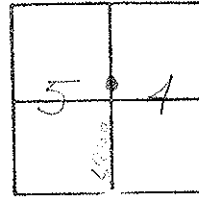

PT. 'A' ^{Ed:} PK 3" Below from old Ref.
 DID NOT FIND IRON ROD. SET PK @ SURFACE
 ON E SR 66
 4' S of E W LUGBILL RD
 SLM 87+33

PT. 'B' Ed Main Box Ref to Center.
 DID NOT OPEN
 ON E PART SR 66
 4' S. of E. LUGBILL RD.
 SLM 87+43

DID NOT RAISE
 SET PK + WASHER
 10-22-84
 C.L.

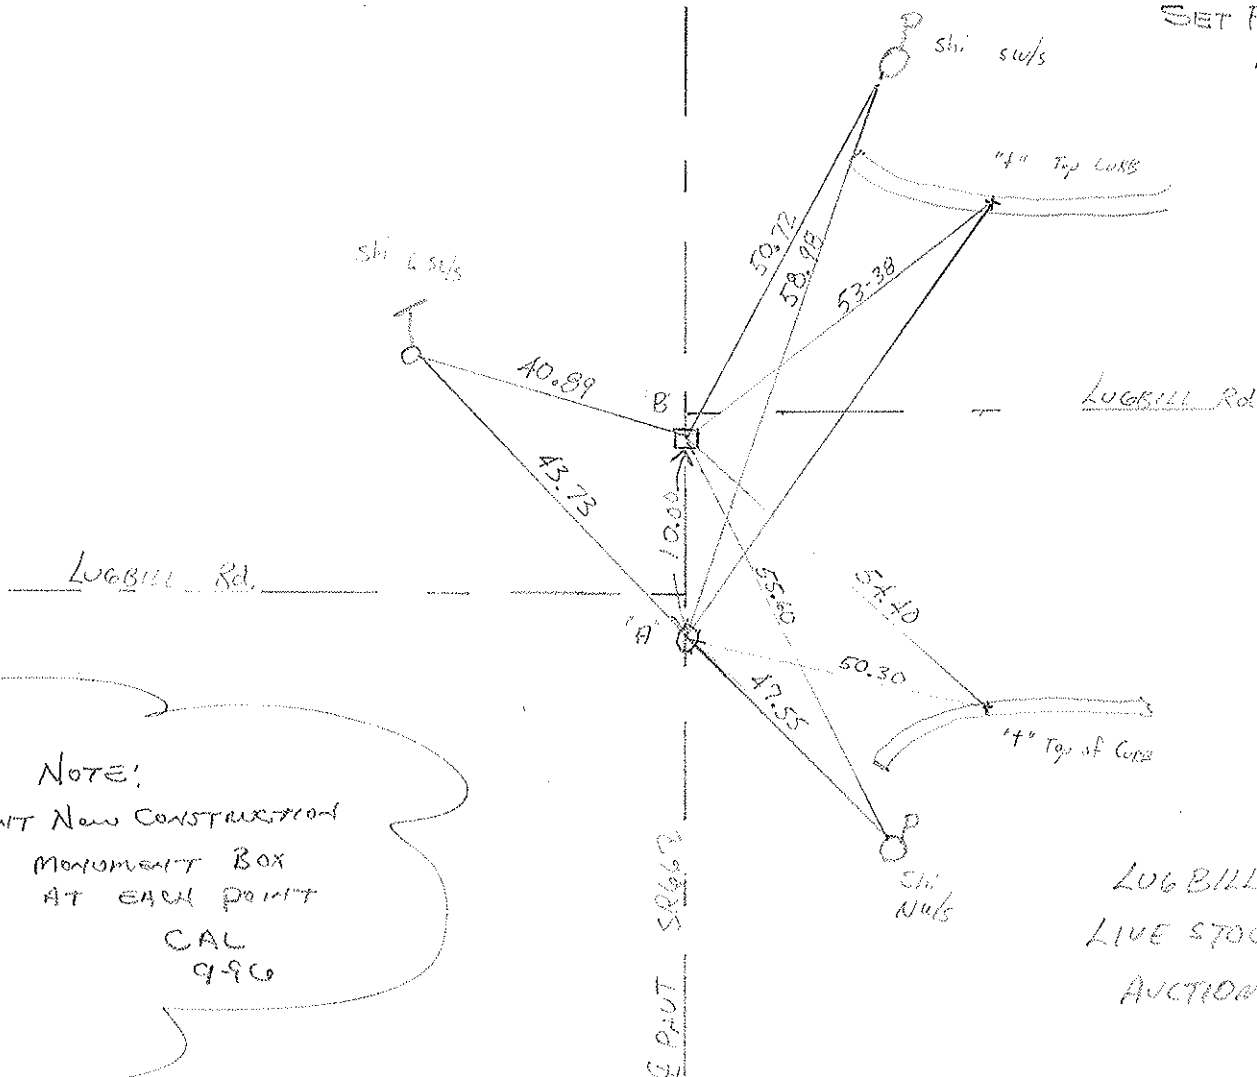

NOTE:
 RECENT NEW CONSTRUCTION
 MONUMENT BOX
 AT EACH POINT
 CAL
 9-96

LUGBILL
 LIVE STOCK
 AUCTION

PERSONNEL TITLE PERSONNEL TITLE

Red Beach
W. Knepe

COUNTY FULTON DATE March 75





S. R. 66 WEATHER South ARCHIBOLD

SEC. German Twp TEMP

DESCRIPTION

CONTROL POINTS


JOB NO.

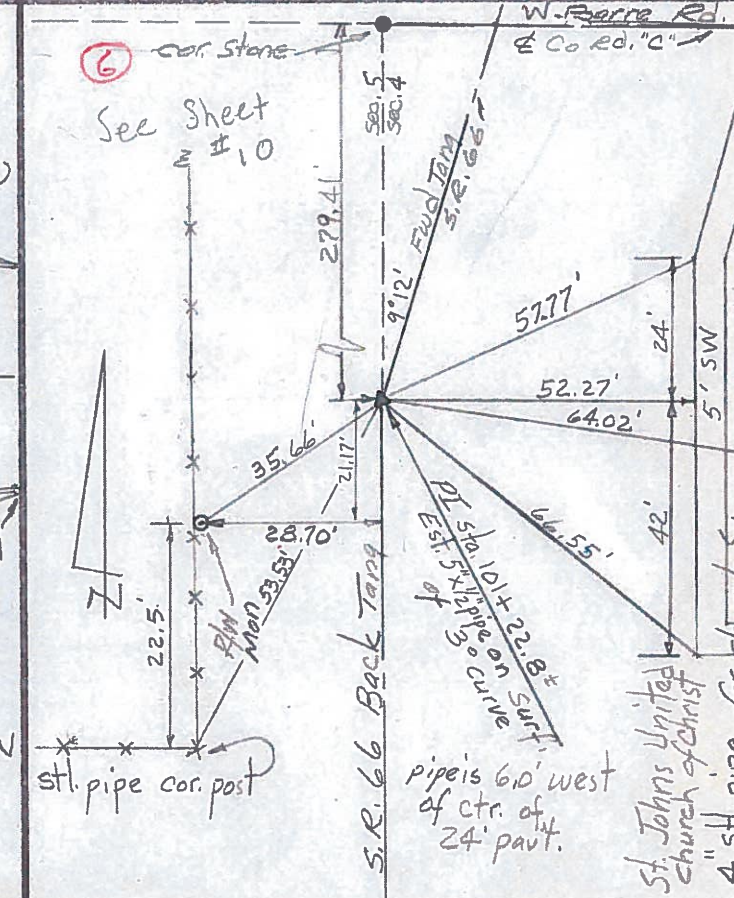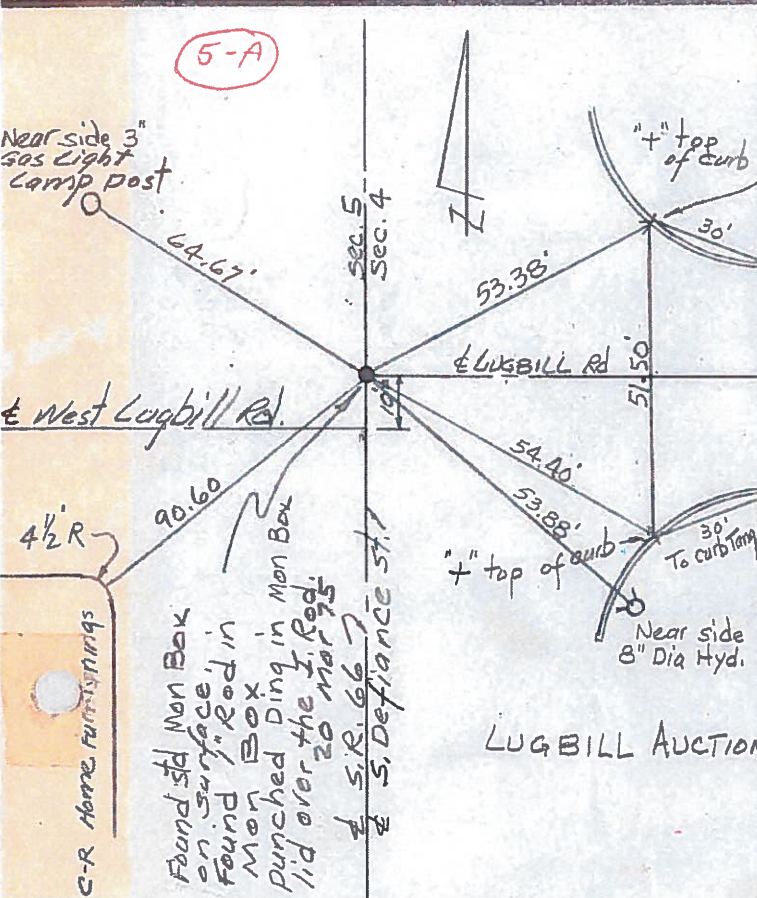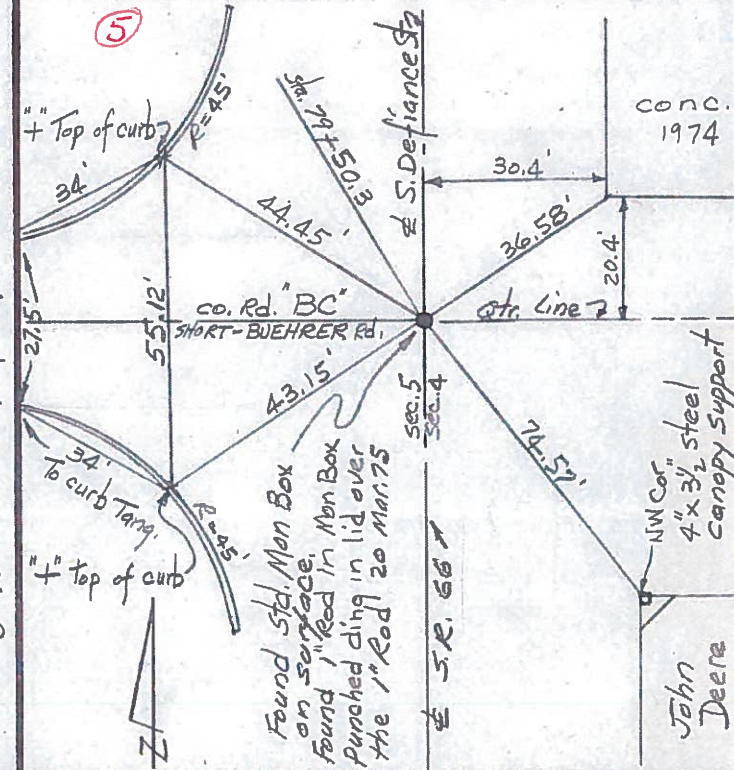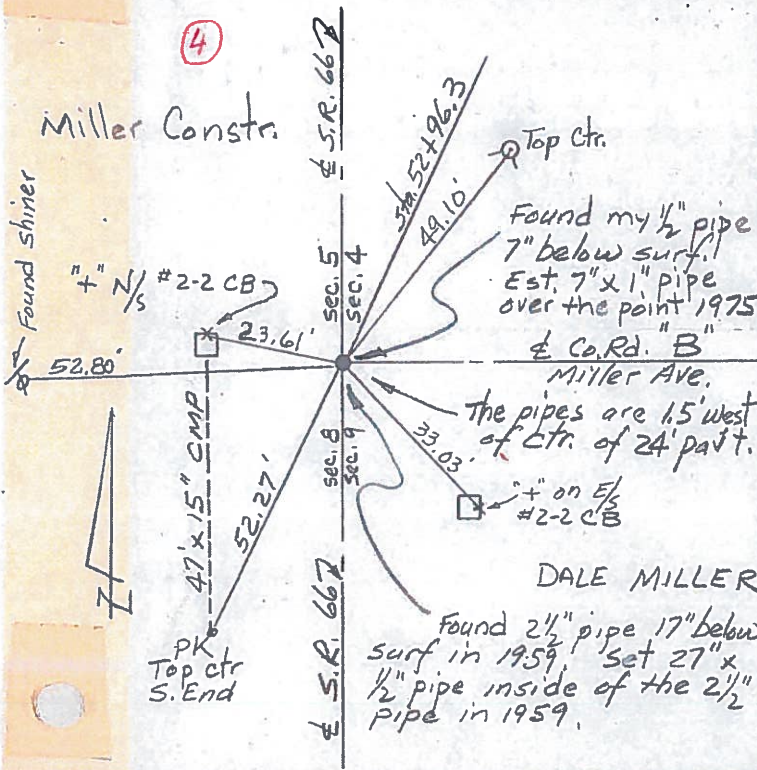

PERSONNEL	TITLE	PERSONNEL	TITLE
Tomsic			
Granata			
Vandy			
Belle			


COUNTY Fulton DATE Aug 27, 1973
 S. R. 66 WEATHER _____
 SEC. Archbold, O. TEMP. _____

DESCRIPTION _____ LEFT _____ CENTER LINE _____ RIGHT _____ JOB NO. _____

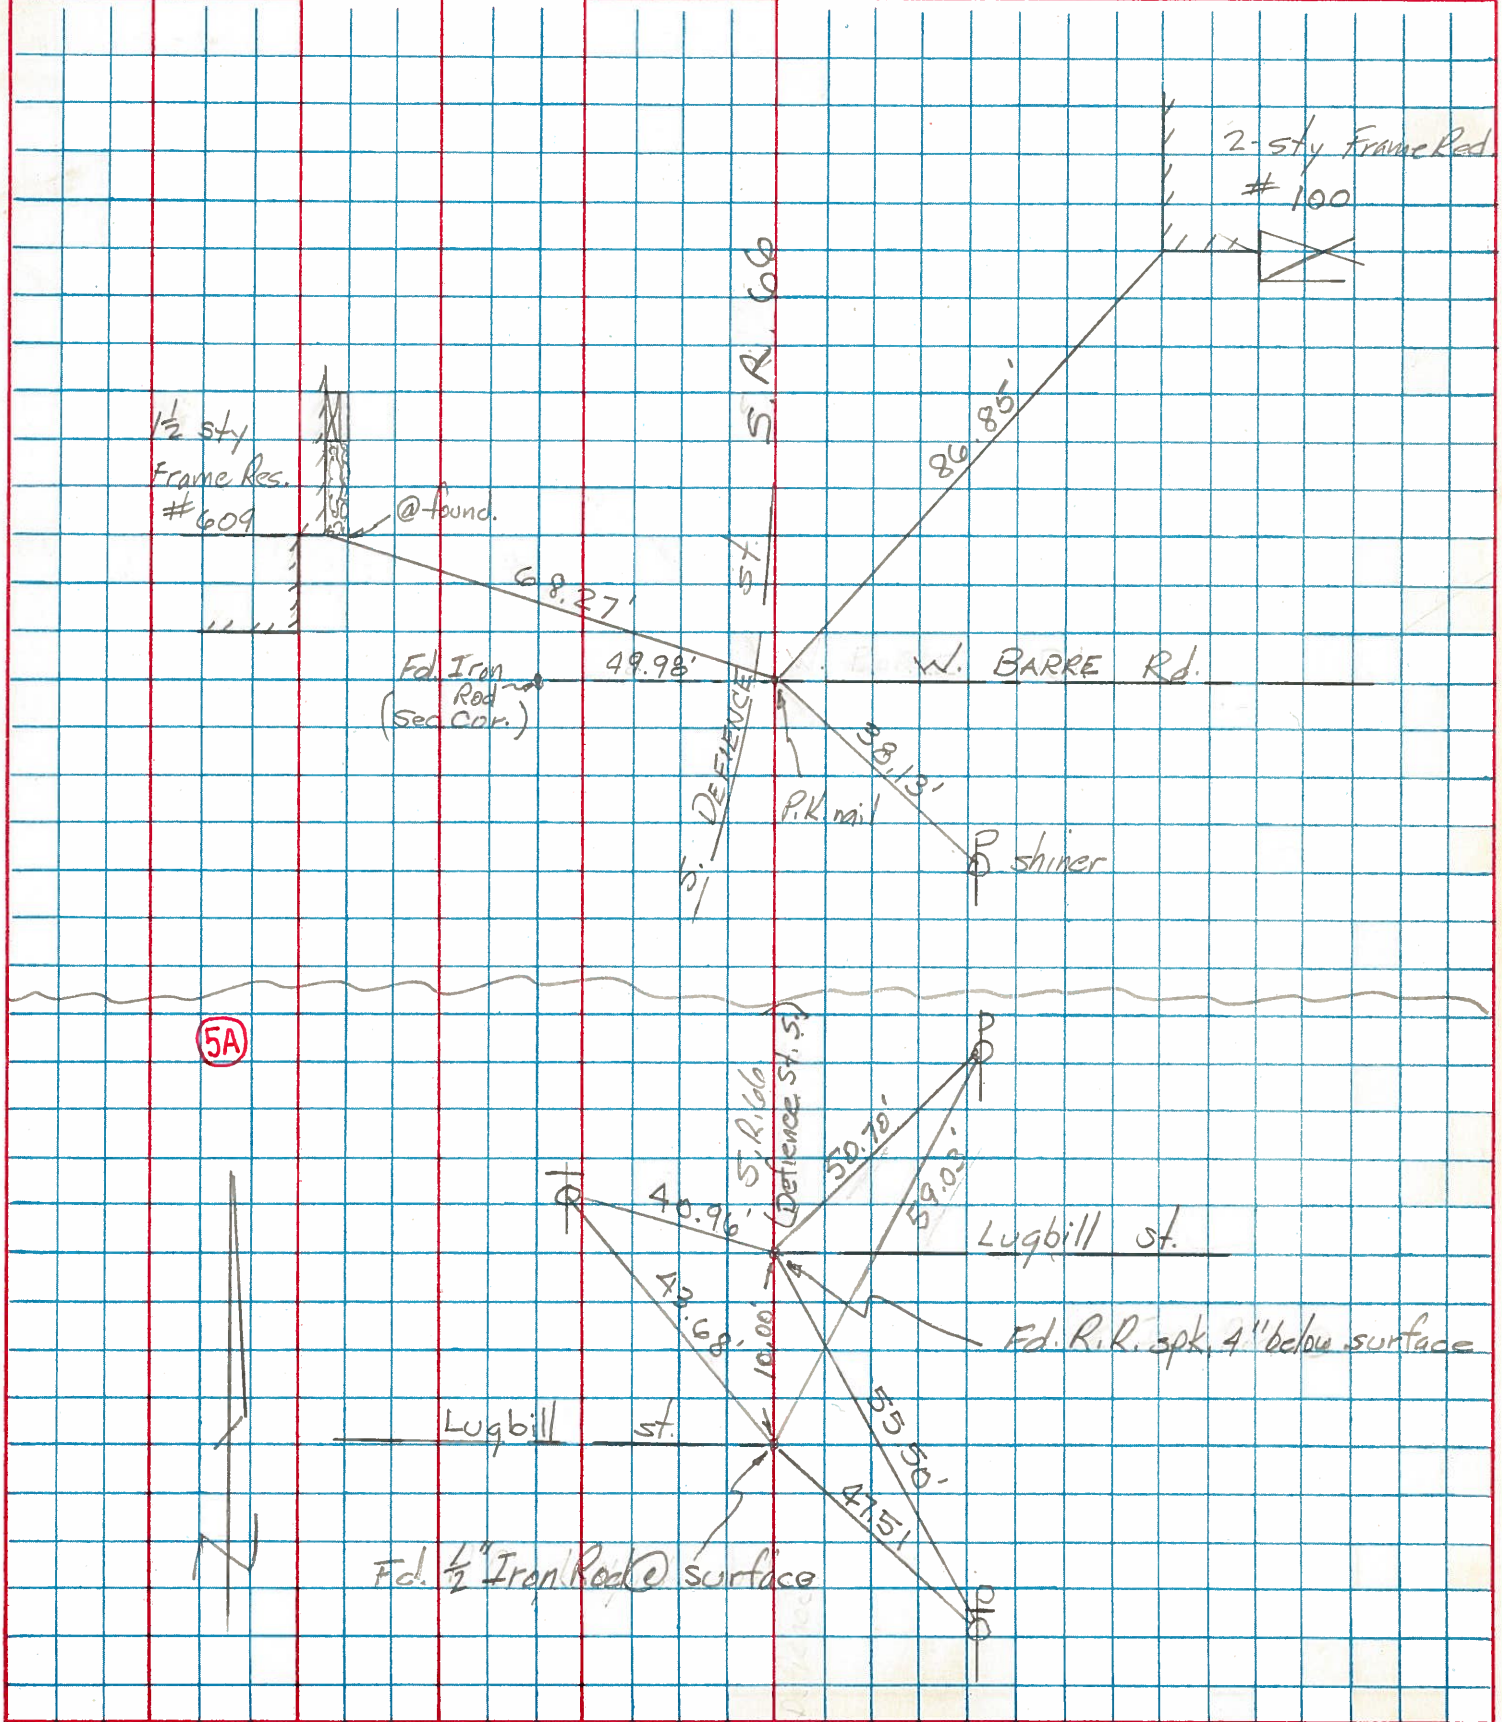

PERSONNEL	TITLE	PERSONNEL	TITLE	COUNTY	DATE	WEATHER	TEMP.
Tamsic				Fulton	MAY 1, 1973		
Nasser				S. R. 66			
Granata				SEC. ARCHBOLD 01			
Vanyo							

DESCRIPTION	LEFT	CENTER LINE	RIGHT	JOB NO.
-------------	------	-------------	-------	---------

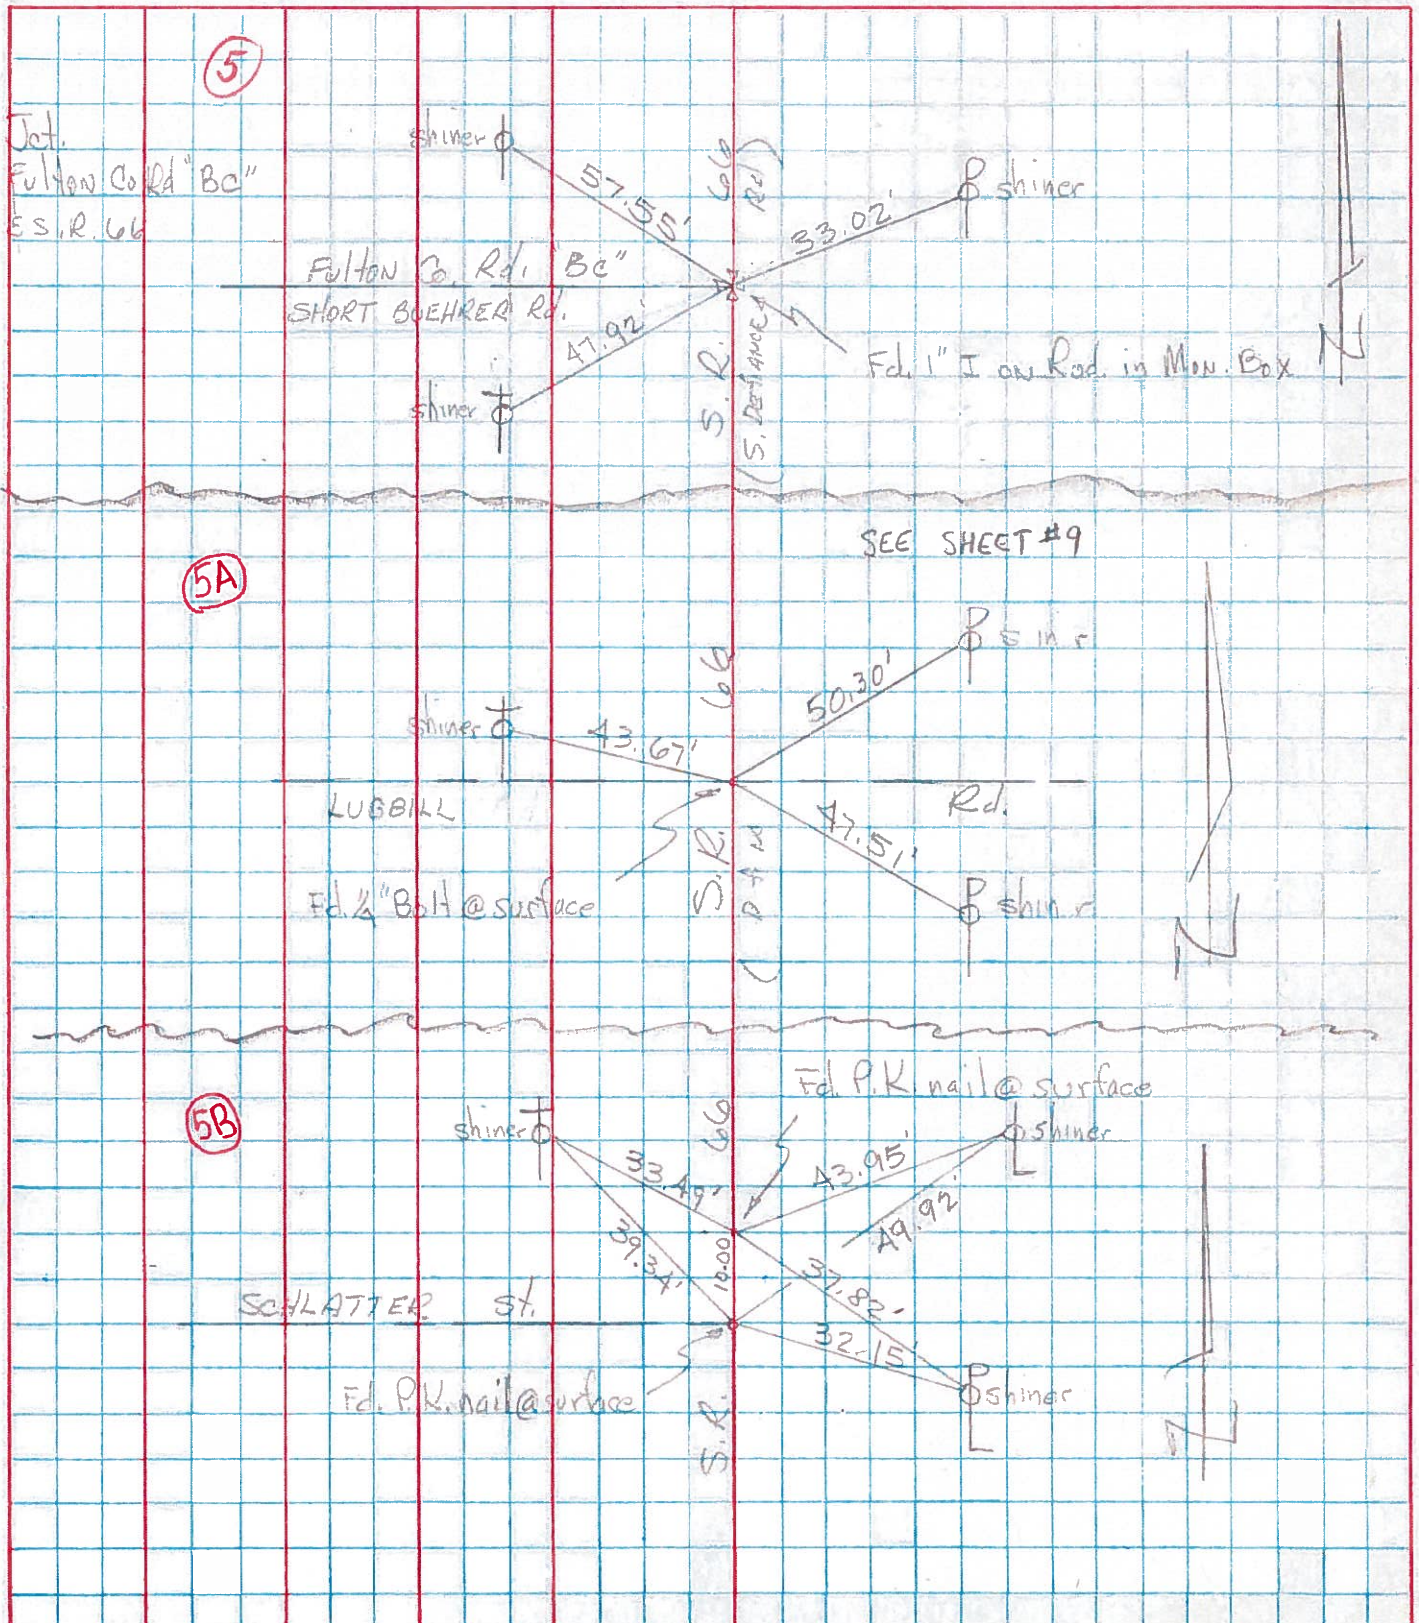

PERSONNEL TITLE PERSONNEL TITLE

Beach
Knape
Gunter

COUNTY Fulton

DATE 14 Oct '59

S. R. 66

WEATHER

SEC Henry-Fulton North

TEMP

DESCRIPTION

CONTROL POINTS

JOB NO.

LEFT

CENTER LINE

RIGHT

