

PERSONNEL TITLE PERSONNEL TITLE

LOUYS
PESSEFALL
WISE
KROHN

COUNTY FU DATE 6-26-58

S. R. 66-7.92 WEATHER FAIR

SEC. _____ TEMP. 75°

DESCRIPTION LEFT CENTER LINE RIGHT JOB NO. _____



C.S. STA 436 + 62.31

P.I. STA 436 + 44.31

SC STA 436 + 23.70

T.S. STA 432 + 23.70

ST STA 425 + 79.19

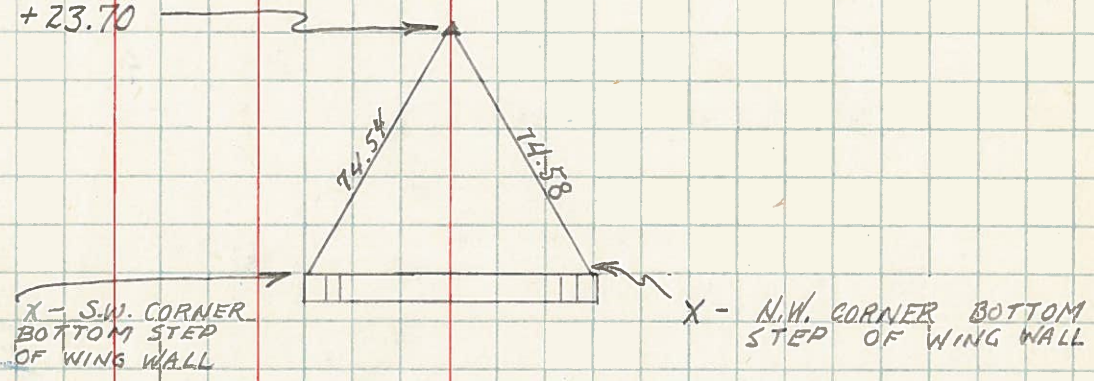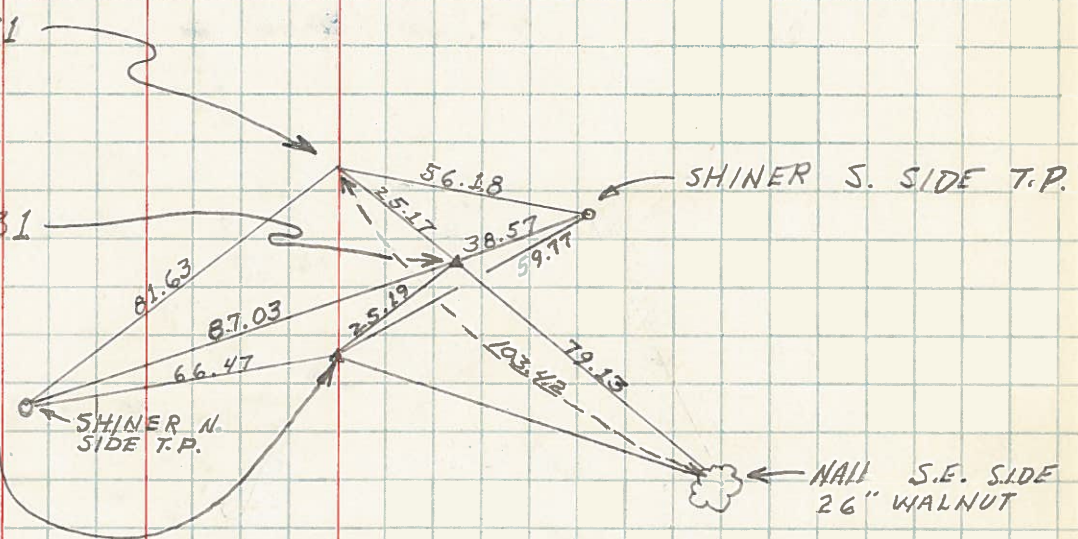

PERSONNEL TITLE PERSONNEL TITLE

LOUYS
PESSEFALL
WISE
KROHN

COUNTY Fu DATE 6-26-58
S. R. 66-7.92 WEATHER FAIR
SEC. _____ TEMP. 75°

DESCRIPTION LEFT CENTER LINE RIGHT JOB NO. _____

