

O.D.O.T. DISTRICT 2 SURVEY OFFICE (USE ONLY)

PERSONNEL

REFERENCE NO. 101B

NOTES NIESE DATE 8/26/25
H.C. NIESE WEATHER CLEAR
R.C. PRESTON-COLVIN TEMP. 55°

ROUTE CR 24
COUNTY FULTON
TOWNSHIP GERMAN
SECTION 8
T 7 N R 5 E

DWG BY BARRIERE PID NO PID

TYPE MONUMENT MONBOX
ON SURFACE - BELOW ON
OFFSET $\oslash$ PAVEMENT ON

STATION: 7+80.00

HORIZ.DATUM: NAD83/FUL OCCS


GEOID: 18

GRID: NORTHING: 701338.908

EASTING: 1468899.173

LDP: NORTHING: 356305.441

EASTING: 115850.525

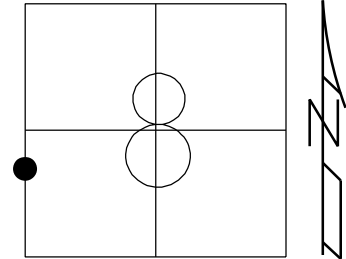

RECORD:
PC STA 7+80 (CR-24)
FUL-66-07.07-1995
FD MONBOX
W/ 1" IPIN
REF101B
8/26/25, TDN

