

O.D.O.T. DISTRICT 2 SURVEY OFFICE (USE ONLY)

PERSONNEL

REFERENCE NO. 110

SHEET 24 OF 49

NOTES RHOADES

DATE 7/9/19

ROUTE SR 66

H.C. O'DONNELL

WEATHER 79°

COUNTY FULTON

R.C. MILLER

TEMP. SUNNY

TOWNSHIP GERMAN

DWG BY NIESE PID 92126

SECTION 8

T 7 N R 5 E

TYPE MONUMENT MONBOX W/ 1" IPIN

ON SURFACE - ~~BELOW~~ ON

OFFSET \odot PAVEMENT ON LT : RT

- TO - EDGE PAVEMENT


STATION: 407+47.43

HORZ.DATUM: NAD83(2011)


GEOID: 2012A

GRID: NORTHING: 704776.830

EASTING: 1468937.842

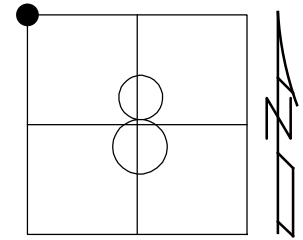

RECORD: P.I.
FD MONBOX
W/ 1" IPIN
CKREF110
9/16/20, JFO

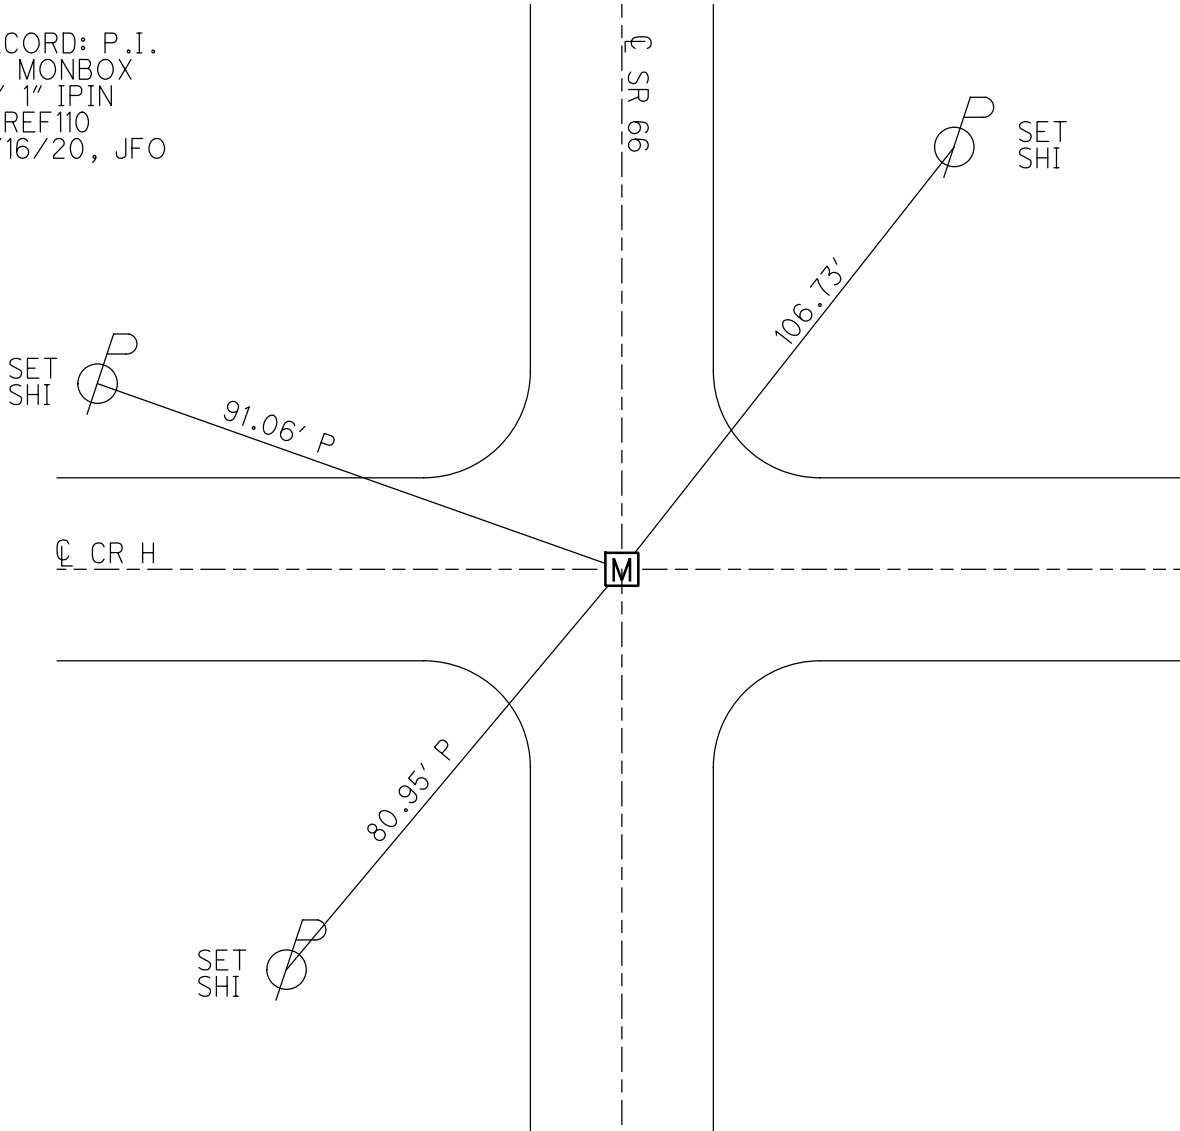

O.D.O.T. DISTRICT 2 SURVEY OFFICE (USE ONLY)

PERSONNEL

REFERENCE NO. 110

SHEET 24 OF 49

NOTES RHOADES

DATE 7/9/19

ROUTE SR 66

H.C. O'DONNELL

WEATHER 79°

COUNTY FULTON

R.C. MILLER

TEMP. SUNNY

TOWNSHIP GERMAN

SECTION 8

DWG BY NIESE PID 92126

T 7 N R 5 E

TYPE MONUMENT MONBOX W/ 1" IPIN

ON SURFACE - ~~BELOW~~ ON

OFFSET ☉ PAVEMENT ON LT : RT

- TO - EDGE PAVEMENT


STATION: 407+47.43

HORZ.DATUM: NAD83(2011)

GEOID: 2012A

GRID: NORTHING: 704776.842

EASTING: 1468937.858

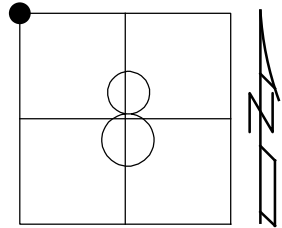

RECORD: P.I.

