

O.D.O.T. DISTRICT 2 SURVEY OFFICE (USE ONLY)

PERSONNEL

REFERENCE NO. 17

SHEET 4 OF 6

NOTES VAN DUSEN

DATE 10/14/93

ROUTE CR 23, OLD SR 66

H.C. BARNHEISEL

WEATHER SUNNY

COUNTY FULTON

R.C. CANTERBURY  
COKES

TEMP. 40°

TOWNSHIP FRANKLIN

DWG BY NIESE

PID 92126

SECTION 5

T 7 N R 5 E

TYPE MONUMENT LARGE R.R. SPIKE

~~ON SURFACE~~ - BELOW 5"

OFFSET ☉ PAVEMENT ON LT : RT 3.7' S  
OF EW ☉

- TO - EDGE PAVEMENT


STATION: 418+14

HORZ. DATUM: -

GEOID: -


GRID: NORTHING: -

EASTING: -

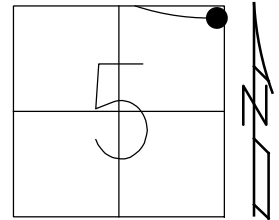

RECORD: P.I.  
SET PK/WASHER  
12/6/93, MC

DIST. 17-17A = 45.96'

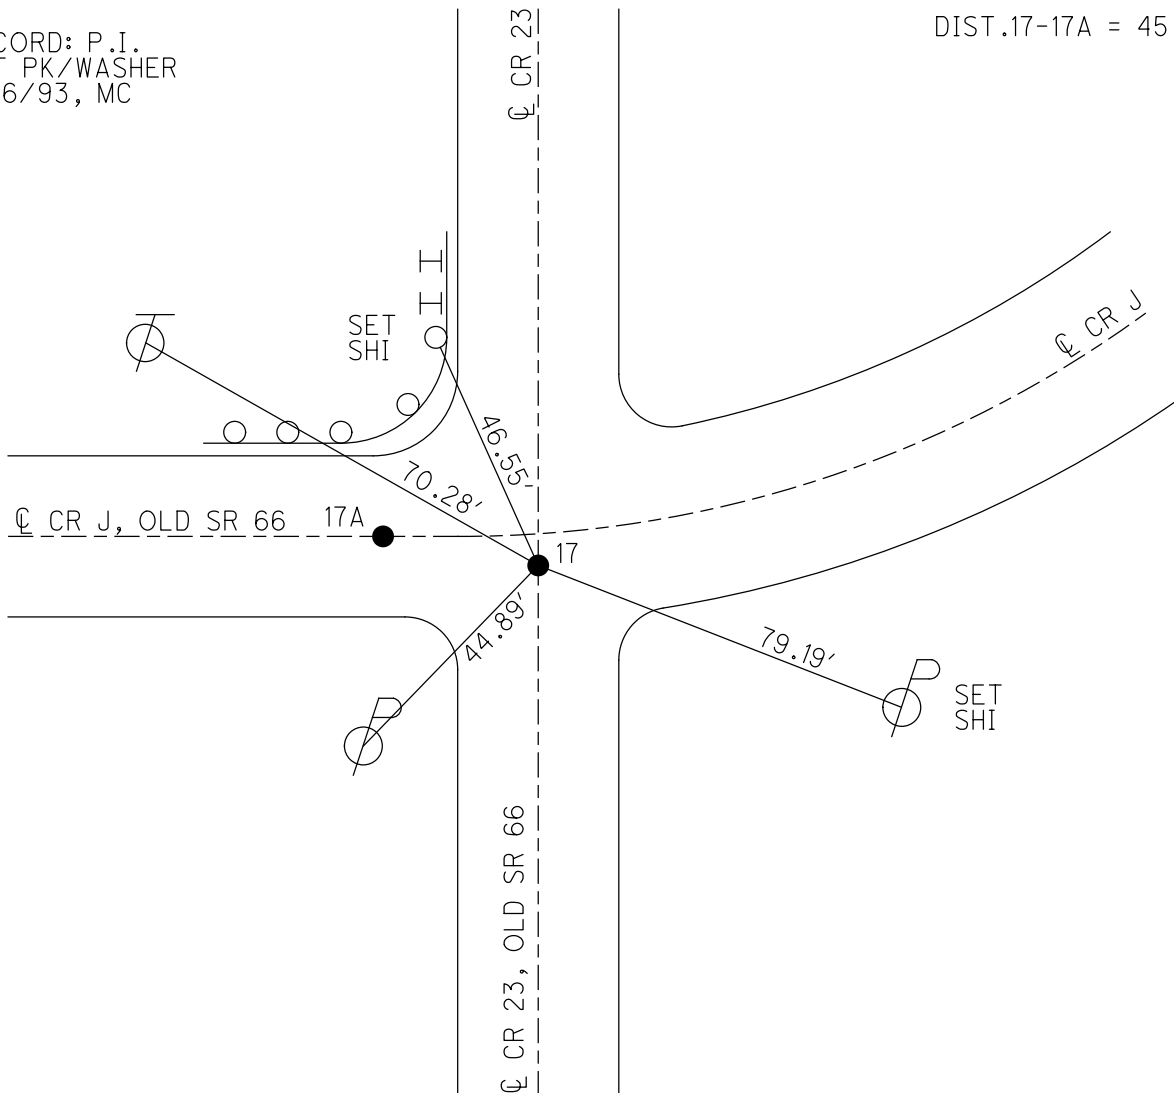

# O.D.O.T. DISTRICT 2 SURVEY OFFICE

PERSONNEL

REFERENCE NO. 17-17-A

SHEET      OF     

NOTES VAN DUSEN

H.C. BARNHISEL

DATE 10-14-93

ROUTE SR 66

R.C. CANTERBURY

WEATHER SUNNY

COUNTY FULTON

CORDS

TEMP. +40°F

TOWNSHIP FRANKLIN

SECTION 5

T 7 N R 5 E

TYPE MONUMENT LARGE RR/SOKS


~~ON SURFACE~~ - BELOW 5"

LEFT - ☉ PAV'T. - RIGHT     

     TO      EDGE PAVEMENT

S.L.M. A = 418+14 B = 418+60


Set PK and washers  
12/6/93  
MC

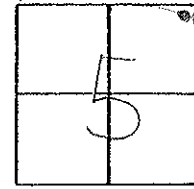

# 17 = "A": 3.7 S of EW ☉  
ON ☉ South

# 17-A = "B": 0.5 L.T. of ☉  
12.6 Rt. E.P.

NOTE: NEITHER POINT #17 OR #17A IS ON THE SECTION LINE. See Point #17-B, ☉ R/W Plan #R1066 #3 FUL-66-7.92 #R1066 #3 Location Plan Sheet 10 of 2 For P.I. & T.S.

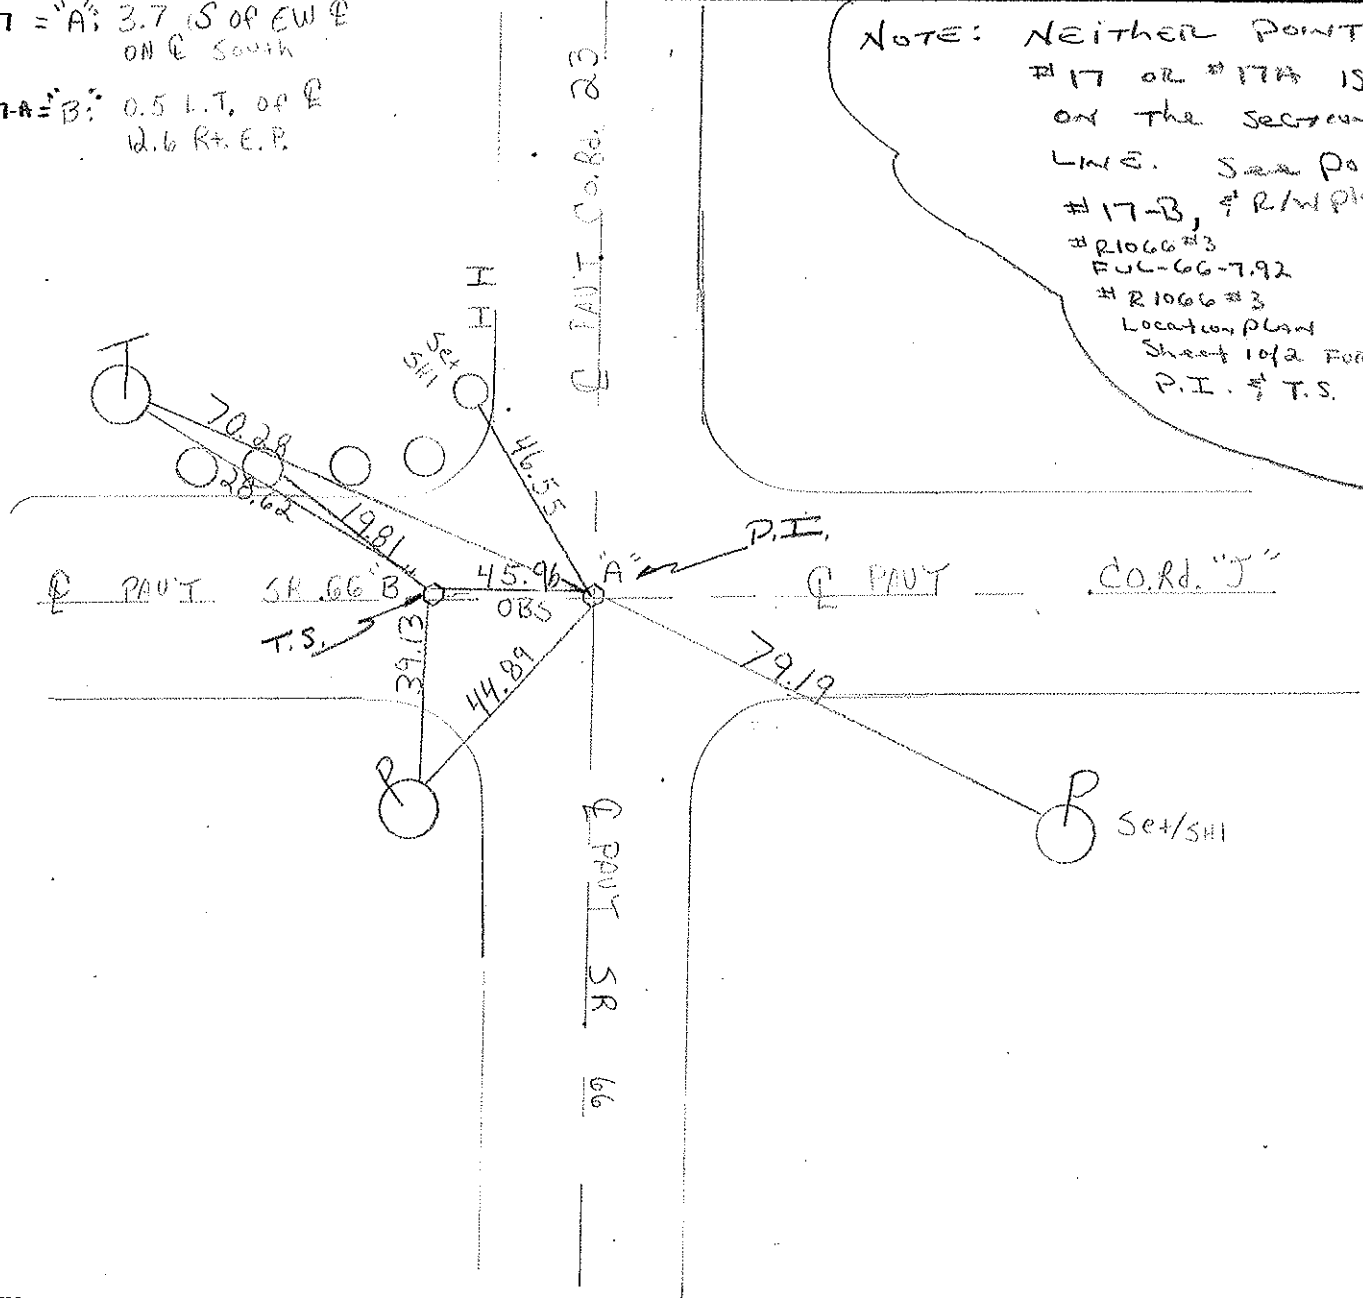

County FULTON S.R. 66

Date 7-6-83

Township FRANKLIN


Weather CLEAR

Section 5

Temp. +68°

T7N, R5E

Personnel Hoffman

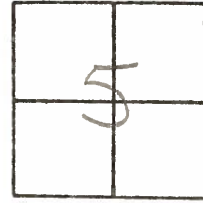


17

CREW

Fd. P.K. SHANK OVER R.R. SPK, 3" down  
1 1/2" down  
ON & PAUT SR 66 SOUTH & WEST

SLM 418+15.5

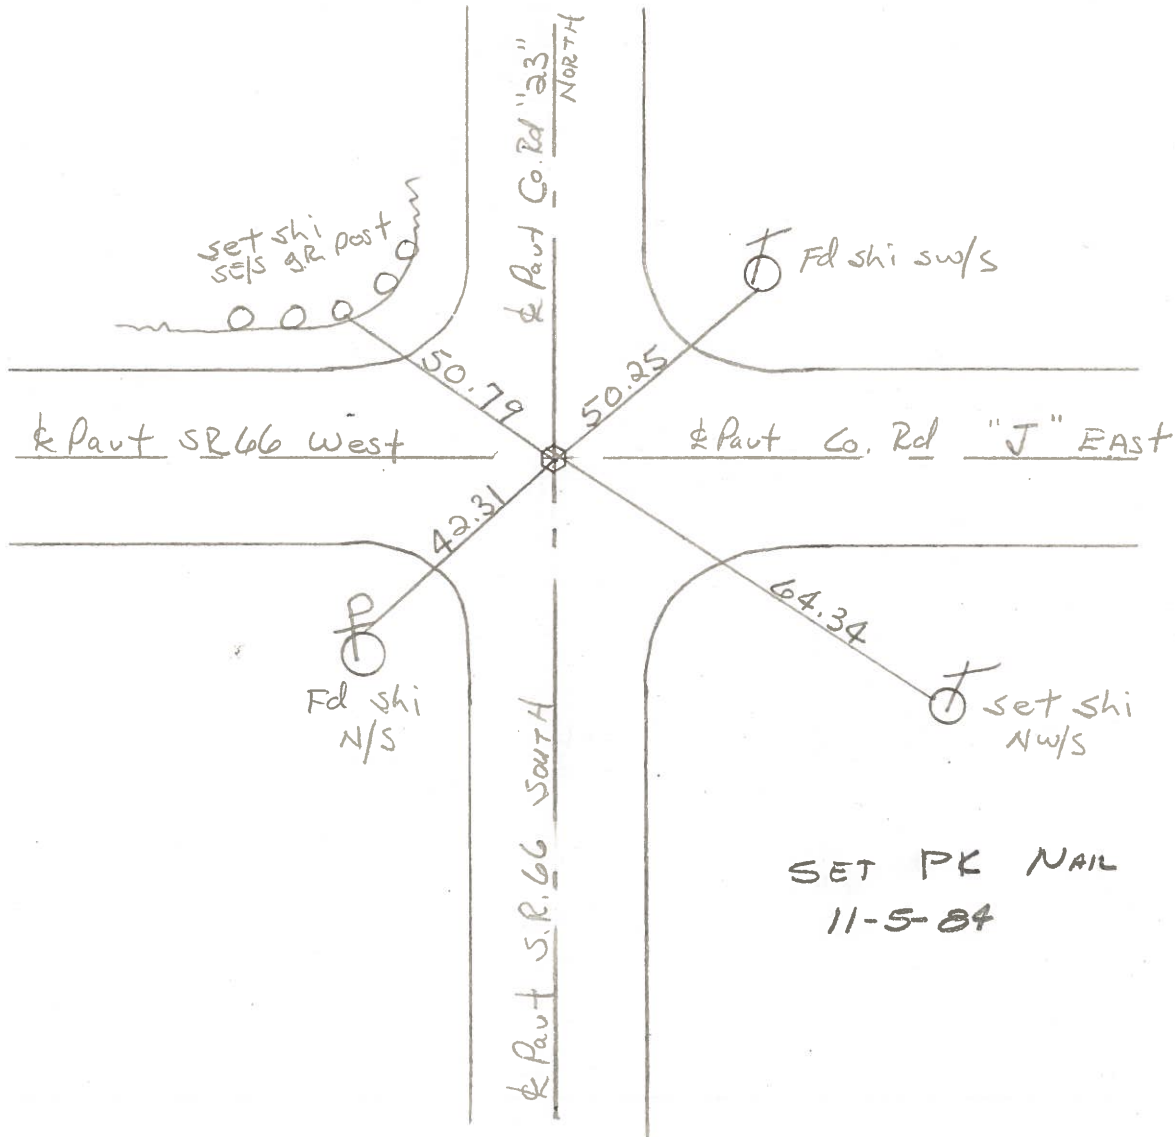

# S.R. 66 FULTON

PERSONNEL	TITLE	PERSONNEL	TITLE
Tomasic		Byrle	
Nouser			
Granata			
Vandy			


COUNTY Fulton DATE July 25, 1973

S. R. 66 WEATHER \_\_\_\_\_

SEC begin Elmira Cor. N TEMP. \_\_\_\_\_

Franklin Twp. JOB NO. \_\_\_\_\_

DESCRIPTION LEFT CENTER LINE RIGHT

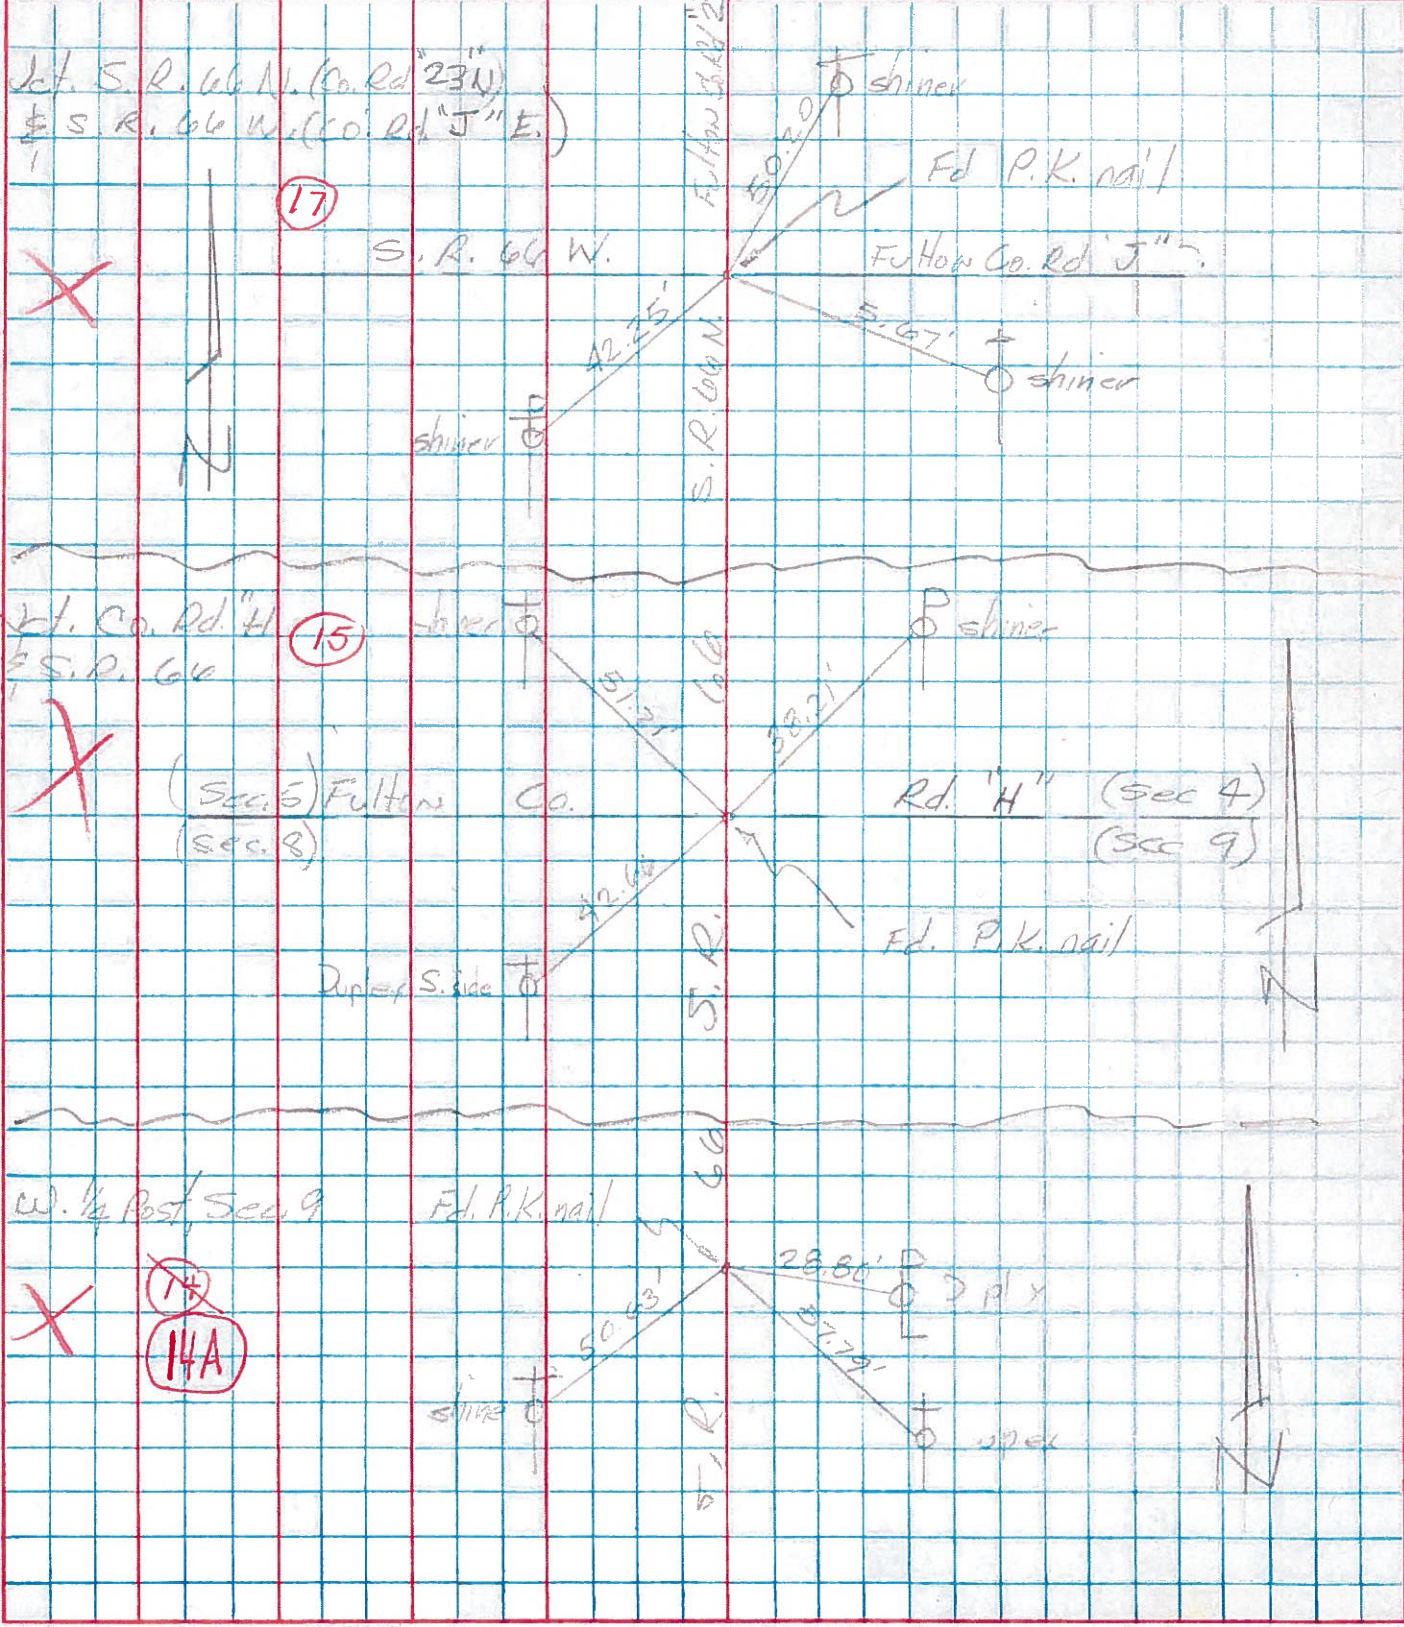

PERSONNEL TITLE PERSONNEL TITLE

COUNTY Fulton DATE July 5, 1966

Denno \_\_\_\_\_

S. R. 66 WEATHER Hot


Curtis \_\_\_\_\_

SEC. \_\_\_\_\_ TEMP. 90°

Granata \_\_\_\_\_

Omay \_\_\_\_\_

DESCRIPTION Monument Ref. SR 66 JOB NO. \_\_\_\_\_

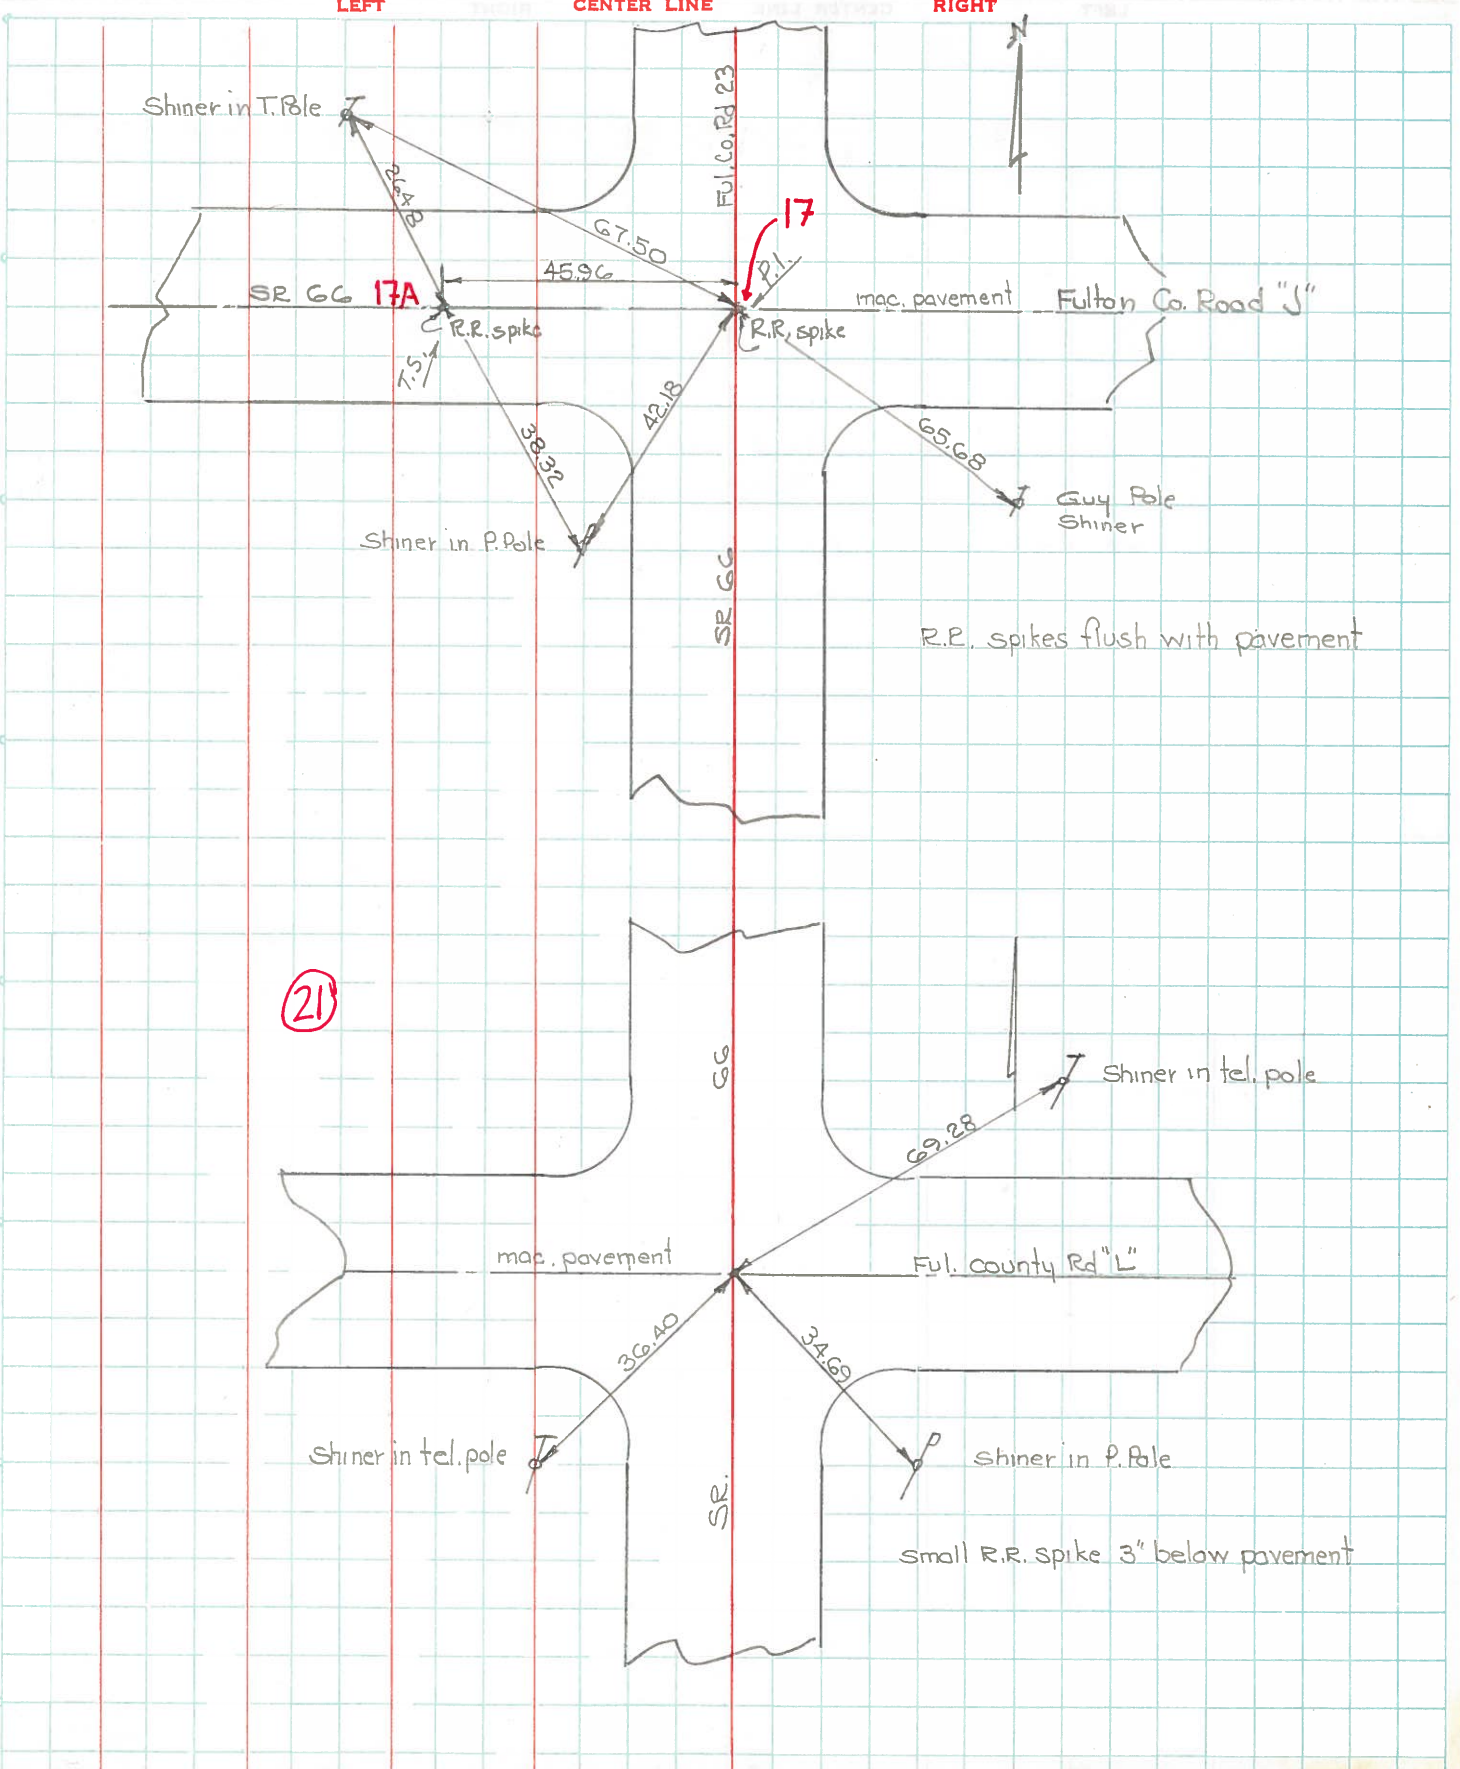

PERSONNEL TITLE PERSONNEL TITLE

LOUYS  
PESSEFALL  
WISE  
KROHN

COUNTY FU DATE 6-26-58

S. R. 66-7.92 WEATHER FAIR

SEC. \_\_\_\_\_ TEMP. 75°

DESCRIPTION \_\_\_\_\_ LEFT \_\_\_\_\_ CENTER LINE \_\_\_\_\_ RIGHT \_\_\_\_\_ JOB NO. \_\_\_\_\_

