

O.D.O.T. DISTRICT 2 SURVEY OFFICE (USE ONLY)

PERSONNEL

REFERENCE NO. 113

SHEET 28 OF 49

NOTES LEU

DATE 7/9/19

ROUTE SR 66

H.C. LEU

WEATHER SUNNY

COUNTY FULTON

R.C. AUBLE

TEMP. 74°

TOWNSHIP GERMAN

SECTION 5

DWG BY NIESE

PID 92126

T 7 N R 5 E

TYPE MONUMENT MONBOX W/ 1" IPIN

ON SURFACE - ~~BELOW~~ ON

OFFSET  $\text{C}$  PAVEMENT 4.0' ~~LT~~ : RT

8.5' TO RT EDGE PAVEMENT



STATION: 455+66.3

HORIZ.DATUM: NAD83(2011)

GEOID: 2012A

GRID: NORTHING: 709595.443

EASTING: 1468986.633

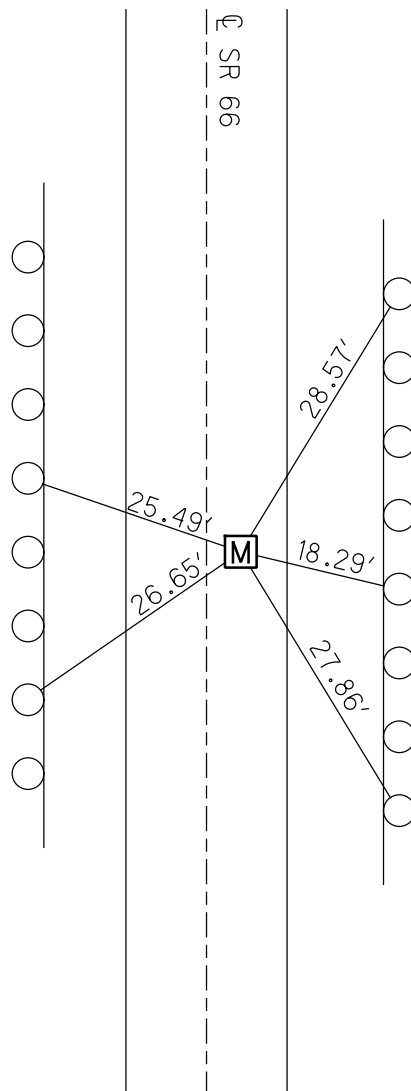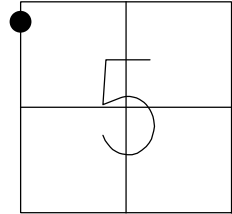

SET SHI'S  
WOOD GR POSTS