

O.D.O.T. DISTRICT 2 SURVEY OFFICE (USE ONLY)

PERSONNEL

REFERENCE NO. 19

SHEET 33 OF 49

NOTES RHOADES

DATE 7/3/18

ROUTE SR 66

H.C. O'DONNELL

WEATHER SUNNY

COUNTY FULTON

R.C. TRENKA

TEMP. 84°

TOWNSHIP FRANKLIN

HAGEMEYER

SECTION 32

DWG BY NIESE PID 102801

T 8 N R 5 E

TYPE MONUMENT MAG/WASHER

ON SURFACE - ~~BELOW~~ ON

OFFSET Q PAVEMENT 2.8' LT : ~~RT~~

7.9' TO LT EDGE PAVEMENT



STATION: 487+33.3

HORZ.DATUM: NAD83(2011)

GEOID: 2012A

GRID: NORTHING: 712759.488

EASTING: 1468987.720

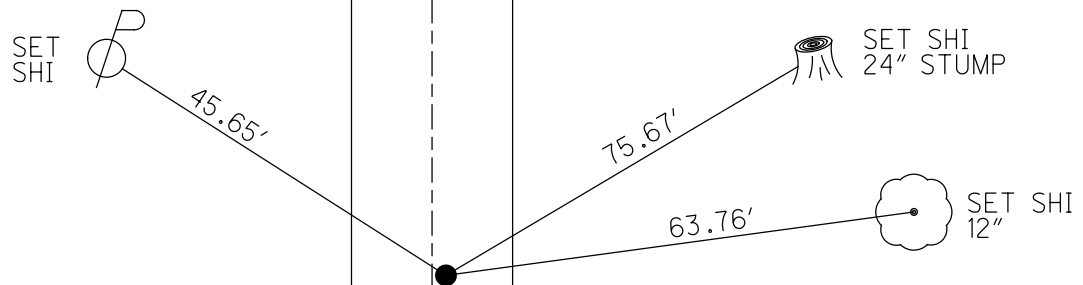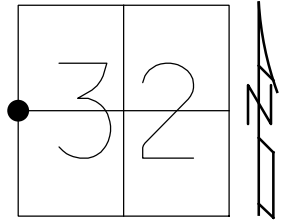

RECORD:
 FD PK/WASHER
 10/13/93, CL
 SET PK/WASHER
 12/6/93, MC
 FD PK/WASHER
 6/15/07, TMR
 SET MAG/WASHER
 8/31/07, MC
 FD MAG/WASHER
 REF19
 12/2/16
 1" DOWN
 7/18/19, JFO

O.D.O.T. DISTRICT 2 SURVEY OFFICE (USE ONLY)

PERSONNEL _____

REFERENCE NO. 19

SHEET 1 OF 12

NOTES HOUESHELL

DATE 06-15-07

ROUTE SR 66

H.C. ROUSOS

WEATHER SUNNY

COUNTY FULTON

R.C. HOUESHELL

TEMP. +80°

TOWNSHIP FRANKLIN

SECTION 32

T 8 N R 5 E

TYPE MONUMENT PK/WASHER


ON SURFACE - ~~BELOW~~ ON SURFACE

LEFT - ~~C PAV'T~~ = ~~RIGHT~~ 2.8' LT.


7.9' TO LT. EDGE PAVEMENT

S.L.M. 489+45 (SV4)

Grid: Northing: 712759.520 Easting: 1468987.725

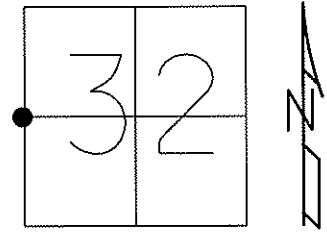

FD. PK/WASHER
10-13-93 CL
SET PK/WASHER
12-06-93 MC
SET MAG/WASHER
08-31-07 MC

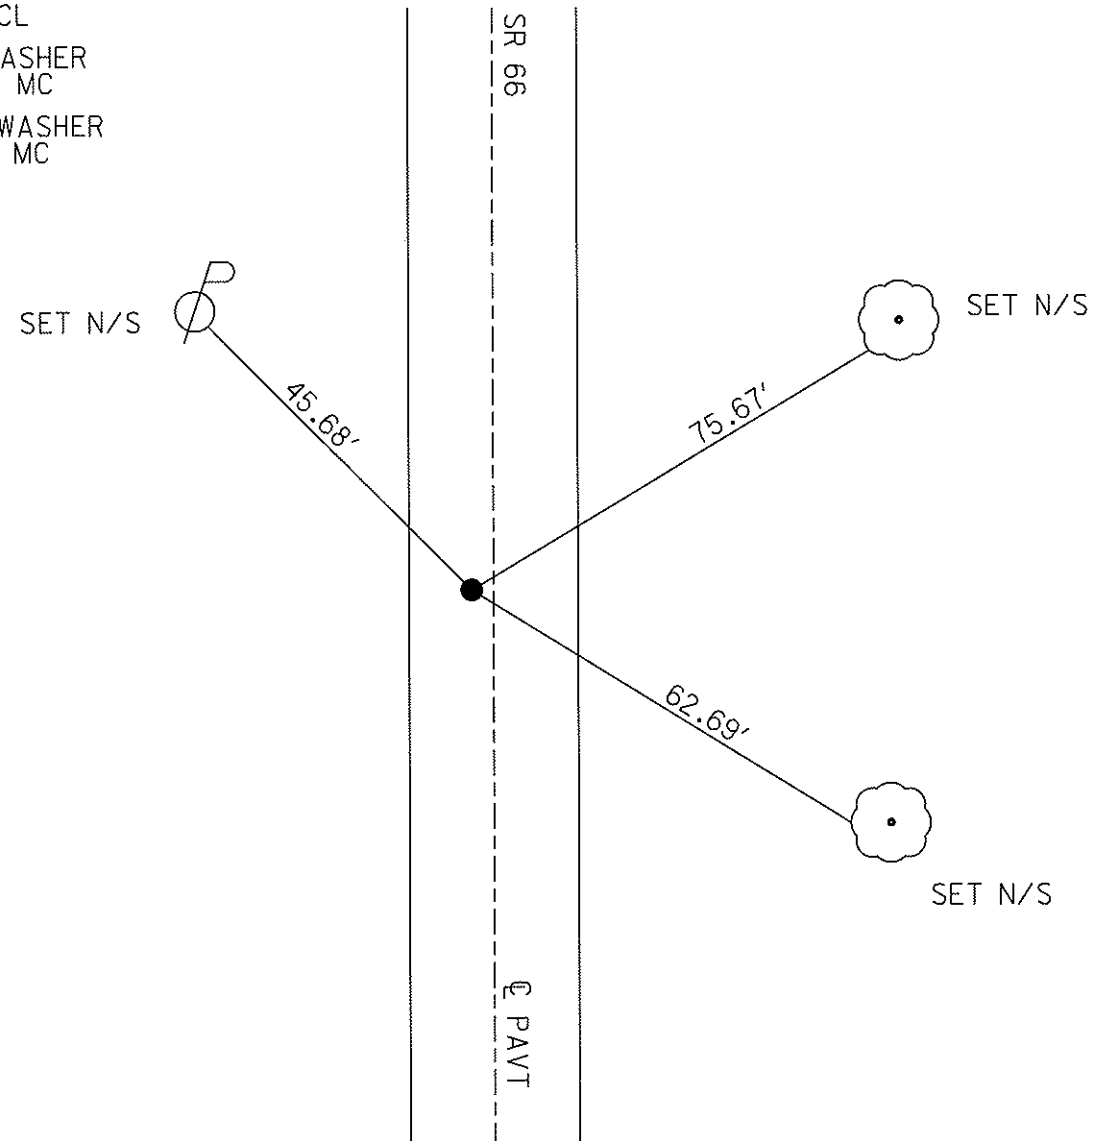

O.D.O.T. DISTRICT 2 SURVEY OFFICE

PERSONNEL

REFERENCE NO. 19

SHEET 11 OF 22

NOTES D. CURTIS

H.C. Loehrke

DATE 10-13-93

ROUTE S.R. 66

R.C. Canterbury

WEATHER Sunny

COUNTY FULTON

TEMP. +50

TOWNSHIP FRANKLIN

SECTION 31-32

T B N R S E

TYPE MONUMENT P.K. NAIL



Set PK/Washer
12/6/93
ML

ON SURFACE - ~~BELOW~~ ON SURFACE

LEFT - ~~PAV'T.~~ - RIGHT 2.8' LEFT

7.9 TO LT. EDGE PAVEMENT

S.L.M. 498 + 33

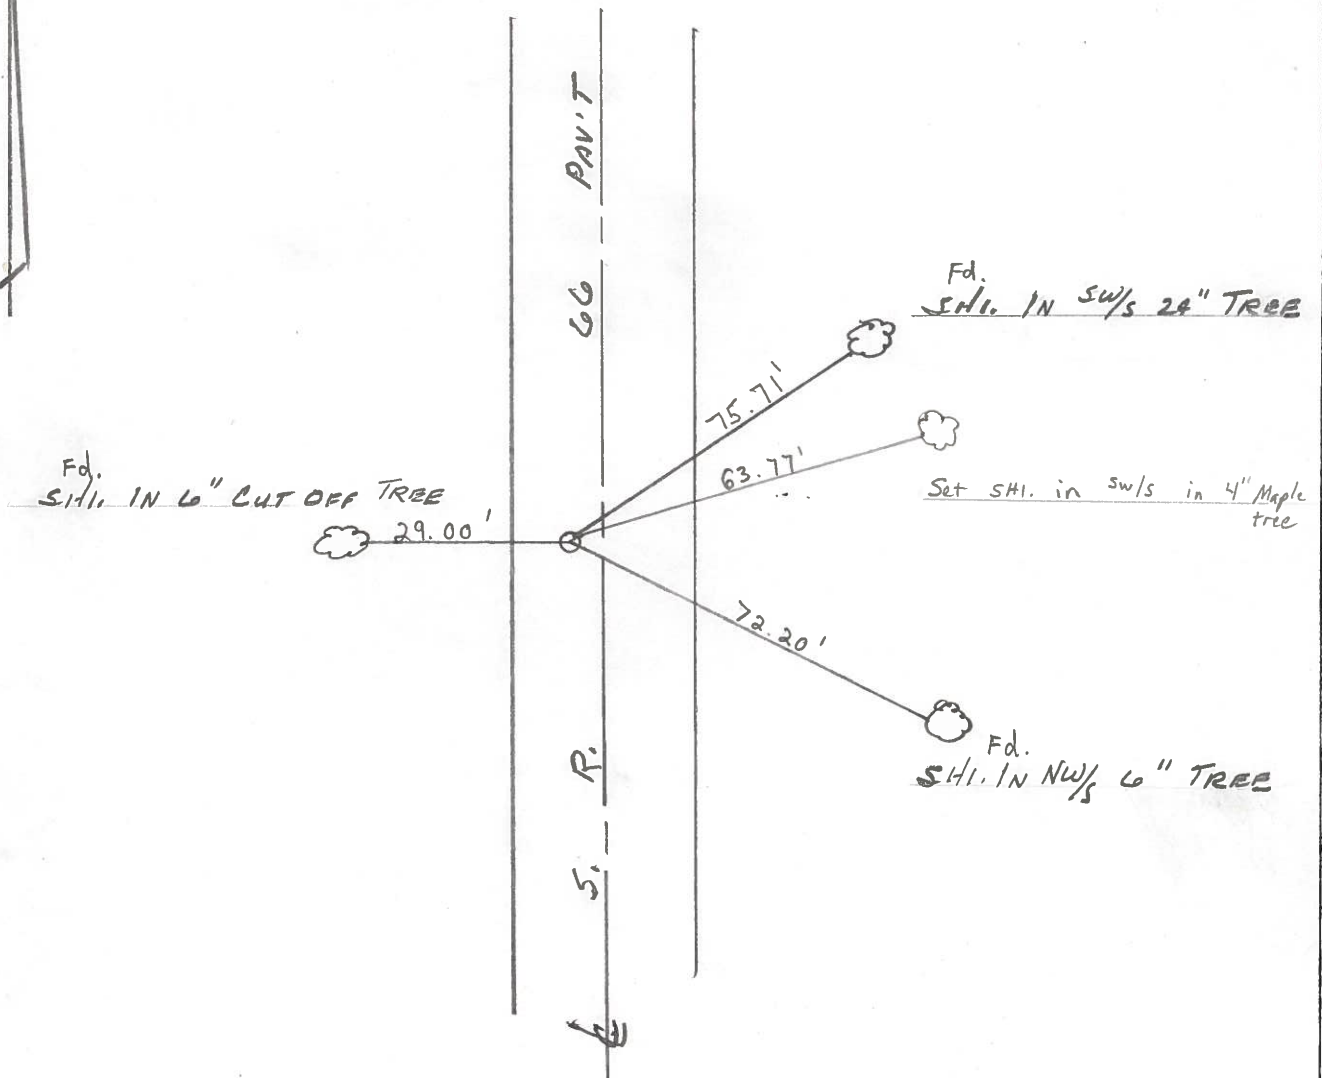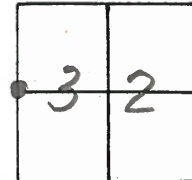

Resurveyed (Booked 1-21-09)

County Fulton S.R. 66

Date 9 Aug. 84

Township Franklin

Weather M0994

Section 31-32

Temp. 79°


T N, R E

Personnel L. Stone

P. Neuser

R. Michalak

19

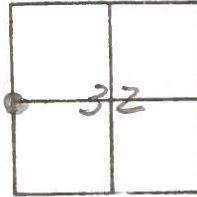


SLM STA. 498+28

REF. NO. 20



Shino' in
6" Tree

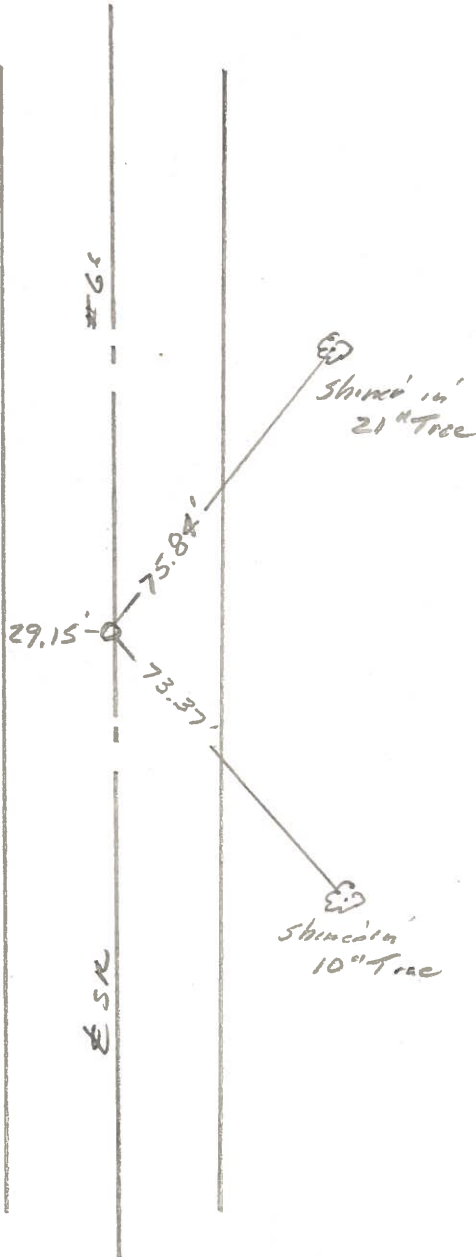

Fd. Small RR Spk To Surface
 1/2 mile North Co. Rd "J"
 1/4 Cor. Sec. 31-32
 Set RR Nail 11/05/84

PERSONNEL	TITLE	PERSONNEL	TITLE	COUNTY	DATE	WEATHER	TEMP.
TAMSIK				Fulton	July 25, 1973		
Houser				S. R. 66			
Granata				SEC. Franklin Twp.			
Wuyno							

DESCRIPTION LEFT CENTER LINE RIGHT JOB NO.

