

1988 TWO-LANE RESURFACING PROGRAM

PRIORITY NO. 31 PART OF SHEET OF
 COUNTY Fulton ROUTE SR 108 SECTION 00.00
 BEGIN LOG (SLM) 0.00 TERMINII Henry County Line (Butt)
 END LOG (SLM) 4.00 TERMINII Leggett Street 211+20 (Calc.) (Cont.)
 TOTAL LENGTH 4.00 MILES
 MUNICIPALITY Wauseon BEGIN LOG (SLM) 3.02 END LOG (SLM) 4.00
 MUNICIPALITY BEGIN LOG (SLM) END LOG (SLM)
 PROPOSED WORK:
 PAVEMENT 1 1/2" - 404 SHOULDER 1 1/2" - 404, 617
 OTHER

EXISTING DATA:

SLM <u>0.00</u> TO <u>3.02</u> ;	PAV'T WIDTH <u>20'</u> (type <u>404</u>),	SHLD WIDTH <u>20'24"</u> (type <u>404</u>)
SLM <u>3.02</u> TO <u>4.00</u> ;	PAV'T WIDTH <u>21'</u> (type <u>404</u>),	SHLD WIDTH <u> </u> (type <u> </u>)
SLM <u> </u> TO <u> </u> ;	PAV'T WIDTH <u> </u> (type <u> </u>),	SHLD WIDTH <u> </u> (type <u> </u>)
SLM <u> </u> TO <u> </u> ;	PAV'T WIDTH <u> </u> (type <u> </u>),	SHLD WIDTH <u> </u> (type <u> </u>)
STRUCTURES:

STR. NO. <u>None</u> ,	WIDTH <u> </u> ,	LENGTH <u> </u> ,	PROP. WORK <u> </u>
STR. NO. <u> </u> ,	WIDTH <u> </u> ,	LENGTH <u> </u> ,	PROP. WORK <u> </u>
STR. NO. <u> </u> ,	WIDTH <u> </u> ,	LENGTH <u> </u> ,	PROP. WORK <u> </u>
RAILROAD CROSSING:


NAME <u>None</u>	STATION <u> </u>	NO. TRACKS <u> </u>	LENGTH ALONG C L <u> </u> ft
NAME <u> </u>	STATION <u> </u>	NO. TRACKS <u> </u>	LENGTH ALONG C L <u> </u> ft
NAME <u> </u>	STATION <u> </u>	NO. TRACKS <u> </u>	LENGTH ALONG C L <u> </u> ft

MISCELLANEOUS:

NO. RAISED PAVEMENT MARKERS; EDGE OF PAVEMENT None , CENTERLINE None
 NO. MAILBOX APPROACHES None , AVERAGE AREA

REMARKS:

PERSONNEL	TITLE	PERSONNEL	TITLE	COUNTY	DATE
<u>Stone</u>				<u>Fulton</u>	<u>5 March 87</u>
<u>E</u>				S. R. <u>#108</u>	WEATHER <u>Snow</u>
<u>Crow</u>				SEC. <u>0.00 - 4.00</u>	TEMP. <u>32°</u>
DESCRIPTION <u>Pavement Widths</u>				JOB NO. _____	
LEFT		CENTER LINE		RIGHT	

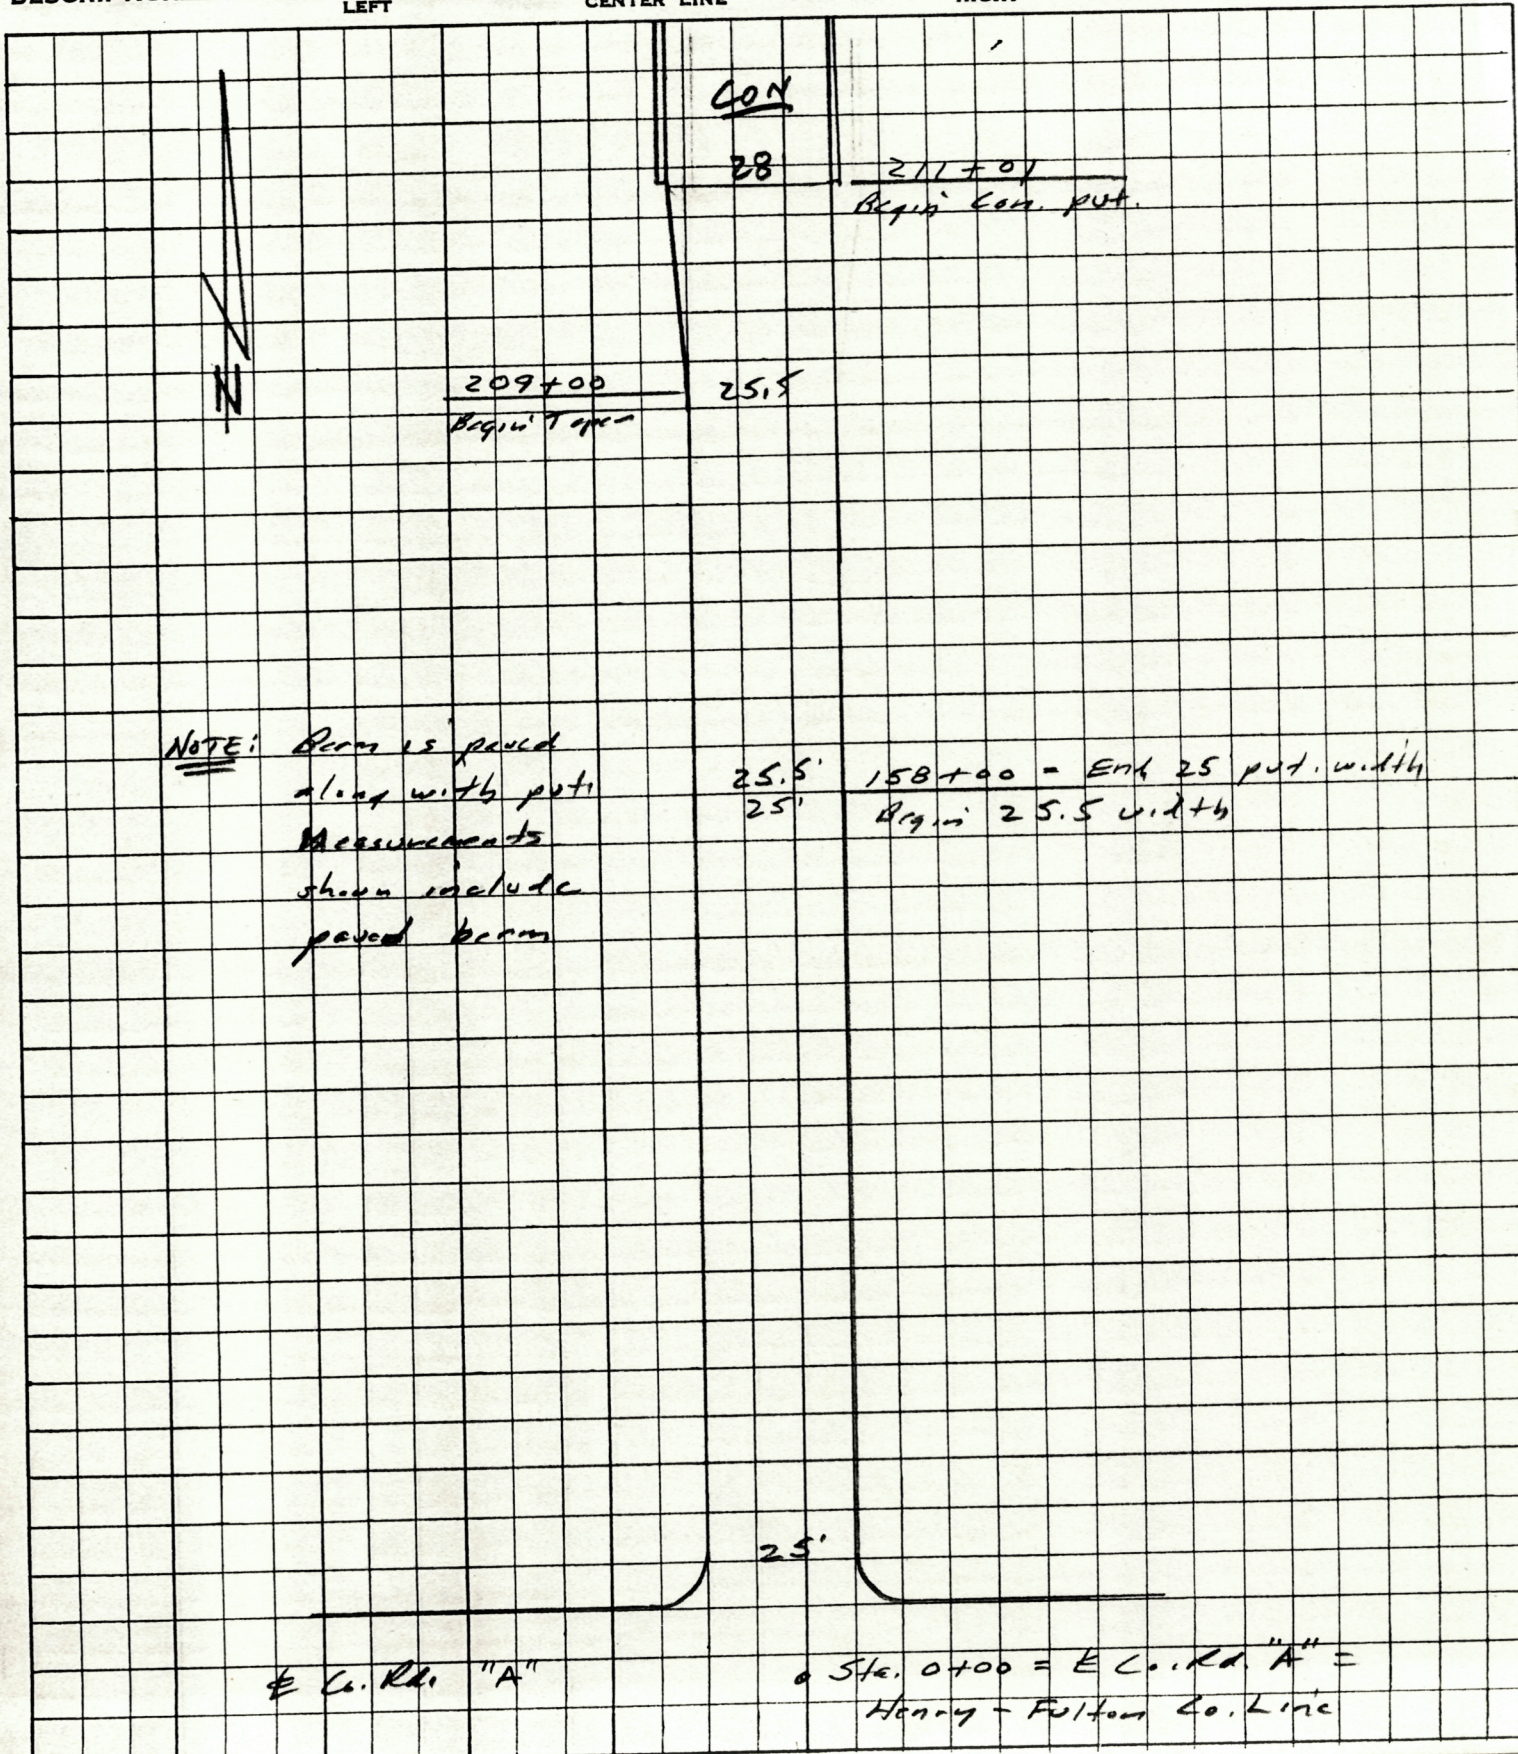

SECTION 0.00 - 4.00

[illegible]

SECTION 0.00 - 4.00

[illegible]