

PRIORITY NO. _____ PART _____ OF _____ SHEET 1 OF 5COUNTY Fulton ROUTE SR 108 SECTION 6.44BEGIN LOG (SLM) 6.44 TERMINII USR 20AEND LOG (SLM) 9.82 TERMINII N. Old State Line Rd.TOTAL LENGTH 3.38 MILES

MUNICIPALITY _____ BEGIN LOG (SLM) _____ END LOG (SLM) _____

MUNICIPALITY _____ BEGIN LOG (SLM) _____ END LOG (SLM) _____

PROPOSED WORK:
PAVEMENT 1 3/4" 402, 1 1/4" 404 SHOULDER 1 3/4" 402, 1 1/4" 404, 617

OTHER _____

EXISTING DATA: see sheet 3
SLM TO _____; PAV'T WIDTH _____ (type _____), SHLD WIDTH _____ (type _____)
SLM TO _____; PAV'T WIDTH _____ (type _____), SHLD WIDTH _____ (type _____)
SLM TO _____; PAV'T WIDTH _____ (type _____), SHLD WIDTH _____ (type _____)STRUCTURES:
STR. NO. NONE, WIDTH _____, LENGTH _____, PROP. WORK _____
STR. NO. _____, WIDTH _____, LENGTH _____, PROP. WORK _____
STR. NO. _____, WIDTH _____, LENGTH _____, PROP. WORK _____
STR. NO. _____, WIDTH _____, LENGTH _____, PROP. WORK _____
STR. NO. _____, WIDTH _____, LENGTH _____, PROP. WORK _____
STR. NO. _____, WIDTH _____, LENGTH _____, PROP. WORK _____RAILROAD CROSSING:
NAME NONE STATION _____ NO. TRACKS _____ LENGTH ALONG C L _____ ft (no work)
NAME _____ STATION _____ NO. TRACKS _____ LENGTH ALONG C L _____ ft
NAME _____ STATION _____ NO. TRACKS _____ LENGTH ALONG C L _____ ftMISCELLANEOUS:
NO. RAISED PAVEMENT MARKERS; EDGE OF PAVEMENT 47, CENTERLINE 318
NO. MAILBOX APPROACHES 0, MAILBOX SUPPORTS 0REMARKS: CK VERTICAL ON TURNPIKE AFTER RESURFACE

1990 TWO-LANE RESURFACING PROGRAM

SHEET 2 OF 5

APPROACHES (INTERSECTIONS & DRIVES)

COUNTY Fulton

ROUTE SR 108

SECTION 6.44-9.82

L = Prop Pav't Depth (in.) x .10; W = Width @ Mouth; $W-1$ = Width @ Throat

[illegible][illegible]

PERSONNEL	TITLE	PERSONNEL	TITLE	COUNTY	DATE
Hoffman	M			Fulton	12-7-88/41
Loehrer	H.C.			S. R.	108
Darville	E.C.			WEATHER	Cloudy
				SEC.	6.44 - 9.82
				TEMP.	35°

DESCRIPTION

Paint Details

JOB NO.


	LEFT	CENTER LINE	RIGHT
Paint	widths	ALL 404	
Sta	Lt. Berm	90% white line	Rt. Berm
341+00	3.5	37.0	3.2'
343+00	4.4	36.1	3.4'
345+00	3.0	35.0	3.3'
347+00	3.3	28.5	3.7'
349+00	3.0	24.0	3.2'
369+29 mm 7	3.0	23.9	3.0'
402+00	3.0	24.1	3.0'
404+00	2.7	33.8	3.0
414+00	2.9	23.3	3.1
422+27 mm 8	3.3	23.4	3.0
430+77 mm 9	2.3	23.3	1.9
518+51	2.7	23.4	2.2
Berms change from 3'± to 2'± at Road "J"			
Const. Joint.			
Rough Paint AREAS - MILL & LEVEL COURSE			
340+72 TO 349+00	37' wide - TO 24' wide	ALL 3 LANES	
402+00 TO 408+00	Lt. Lane - outside edge - 8' wide	FALLING OFF - Needs Level Course	

PERSONNEL	TITLE	PERSONNEL	TITLE	COUNTY	DATE	WEATHER	TEMP.
HOFFMAN				FULTON	12-7-88	CLOUDY	+40°
BARNHISEL				S. R. 108			
LOEHRKE				SEC. 6.44 - 9.82			

DESCRIPTION 1990 RESURFACING - PAVEMENT DETAILS

LEFT CENTER LINE RIGHT

JOB NO.

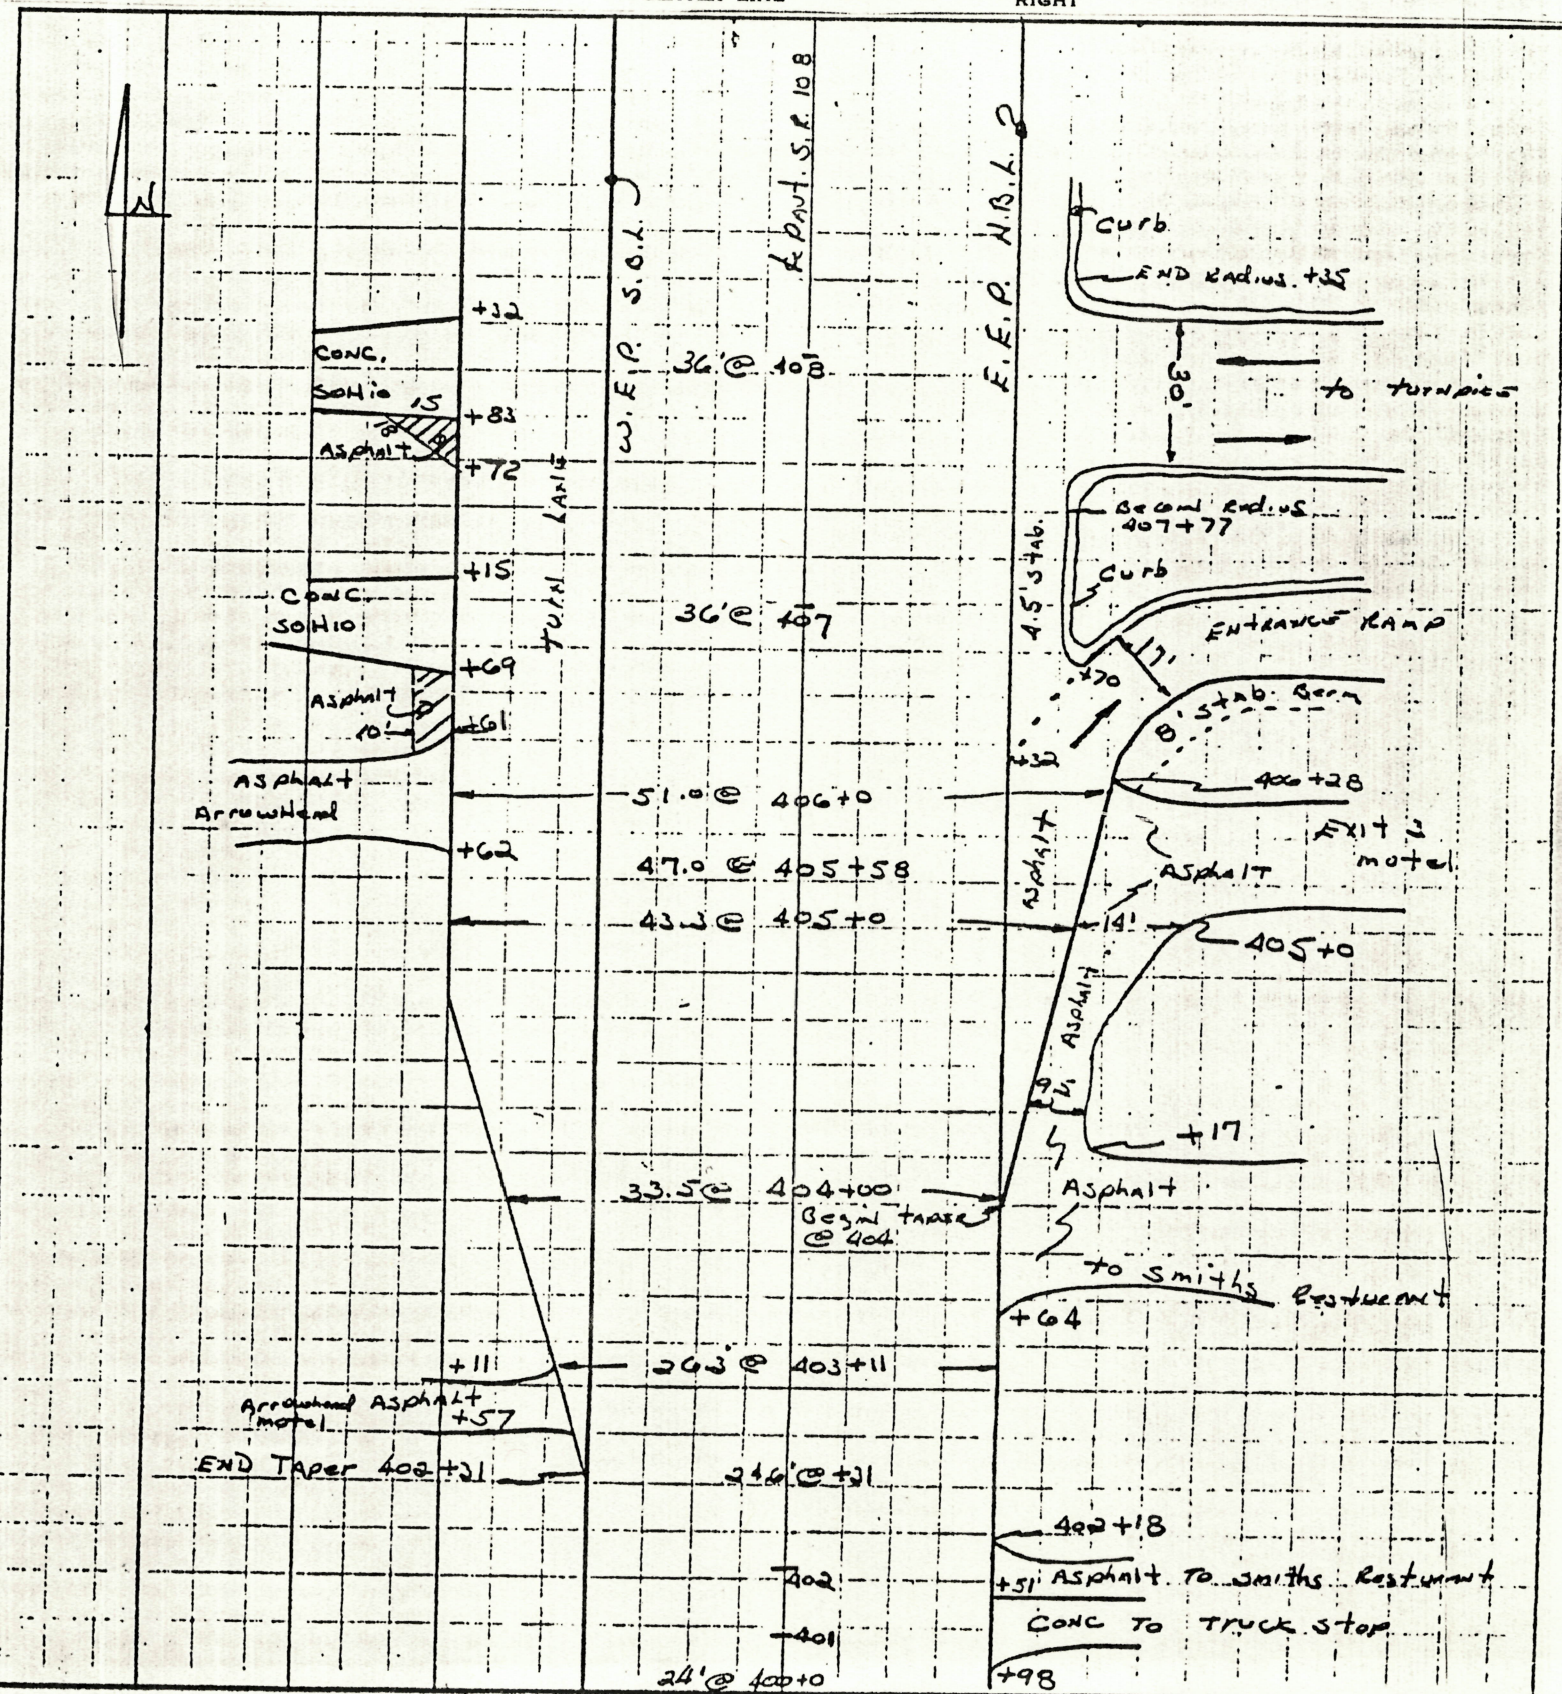

PERSONNEL	TITLE	PERSONNEL	TITLE
HOFFMAN			
LOEHRKE			
BARNHISEL			

COUNTY FULTON DATE 12-7-88

S. R. 108 WEATHER CLOUDY

SEC. 6.44-9.82 TEMP +40°

DESCRIPTION 1990 RESURFACING - PAVEMENT DETAILS JOB NO. _____

LEFT CENTER LINE RIGHT

