

ODOT (D-2)

1992 TWO-LANE RESURFACING PROGRAM

PRIORITY NO. 35 17 PART 1 OF 2 SHEET 1 OF 6
 COUNTY Fulton ROUTE SR 108 SECTION 6.44
 BEGIN LOG (SLM) 6.44 A ³⁴⁰⁺⁰³ TERMINII US 20A* MEASURED 350+00
 END LOG (SLM) 9.82 ^{CALC 518+50} TERMINII Const joint MEASURED 518+52
 TOTAL LENGTH 3.38 MILES

MUNICIPALITY _____ BEGIN LOG (SLM) _____ END LOG (SLM) _____

MUNICIPALITY _____ BEGIN LOG (SLM) _____ END LOG (SLM) _____

PROPOSED WORK:

PAVEMENT 1 1/2" 404 SHOULDER SAME, 607OTHER *Butt joint @ Const joint N of US 20A Measured 350+00

EXISTING DATA: See Add PAVT WIDTHS Sheet

SLM <u>340+00</u>	TO <u>402+30</u>	PAV'T WIDTH <u>24.0</u>	(type _____)	SHLD WIDTH <u>2.8 ft</u>	(type <u>PAVED</u>)
SLM <u>369+30</u>	TO <u>m.m. 7</u>	PAV'T WIDTH <u>23.9</u>	(type _____)	SHLD WIDTH <u>3.0 ft</u>	(type <u>PAVED</u>)
SLM <u>422+26</u>	TO <u>m.m. 8</u>	PAV'T WIDTH <u>23.5</u>	(type _____)	SHLD WIDTH <u>3.0 ft</u>	(type <u>PAVED</u>)
SLM <u>480+00</u>	TO <u>m.m. 9</u>	PAV'T WIDTH <u>23.4</u>	(type _____)	SHLD WIDTH <u>2.1 ft</u>	(type <u>PAVED</u>)
SLM <u>518+52</u>	TO <u>Joint</u>	PAV'T WIDTH <u>23.4</u>	(type _____)	SHLD WIDTH <u>1.8 ft</u>	(type <u>PAVED</u>)
SLM _____	TO _____	PAV'T WIDTH _____	(type _____)	SHLD WIDTH _____	(type _____)
SLM _____	TO _____	PAV'T WIDTH _____	(type _____)	SHLD WIDTH _____	(type _____)
STRUCTURES: NONE

STR. NO. _____	WIDTH _____	LENGTH _____	PROP. WORK _____
STR. NO. _____	WIDTH _____	LENGTH _____	PROP. WORK _____
RAILROAD CROSSING: NONE (no work)
 NAME _____ STATION _____ NO. TRACKS _____ LENGTH ALONG C L _____ ft
 NAME _____ STATION _____ NO. TRACKS _____ LENGTH ALONG C L _____ ft
 NAME _____ STATION _____ NO. TRACKS _____ LENGTH ALONG C L _____ ft

MISCELLANEOUS:

NO. RAISED PAVEMENT MARKERS; EDGE OF PAVEMENT 0, CENTERLINE 262
 NO. MAILBOX APPROACHES NONE, MAILBOX SUPPORTS _____
 REMARKS: Berm WIDTH CHANGES N. SIDE of Co. Rd. J From +3' to +2'

ROUGH PAVT & Berm 402+00 to 408+00 Lt LANE, outer Edge

8' WIDE, FALLING off - Needs Leveling Course

ROUGH PAVT. HAS BEEN WEDGED

COUNTY Fulton

ROUTE SR108

SECTION 6.44

L = Prop Pav't Depth(in.) x 10; W = Width @ Mouth; W-1 = Width @ Throat


INTERSECTIONS							NOT Needed DRIVES					
STATION	SIDE	NAME OR NO.	L	W	W-1	ASPH	CONC	STATION	SIDE	W	ASPH	CONC
392+77	Lt	Co. Rd. "H"	15'	94'	41'	X						
392+77	Rt	Co. Rd. "H"	15'	94'	43'	X						
For Turnpike Ramps - SEE Additional PAVT WIDTH Sheet sheet #												
420+56	Lt	South ENT. to FAIR GROUNDS	15'	165'	120'	X		SEE Sheet # 2 of 5 1990 Two LANE Resurf. Note				
432+70	Lt	NORTH ENT. to FAIR GROUNDS	15'	118'	69'	X						
446+25	Lt	Co. Rd. J	15'	105'	45'	X						
446+25	Rt	Co. Rd. J	15'	101'	45'	X						
501+30	Lt	Co. Rd. K	15'	86'	43'	X						
501+30	Rt	Co. Rd. K	15'	86'	37'	X						
514+70	Lt	Co. Rd. 15	15'	136'	51'	X						
			</									

COUNTY Fulton ROUTE SR 108 SECTION 6.44



[illegible]

PERSONNEL	TITLE	PERSONNEL	TITLE	COUNTY	DATE
LOGHAYE	□			FULTON	3-3-92
CURTIS	Q			S. R. 108	WEATHER Pt CLOUDY
Dodds	Q			SEC. 16.44	TEMP. +40


DESCRIPTION	PAVT	MARKING	LEFT	CENTER LINE	RIGHT	JOB NO.
-------------	------	---------	------	-------------	-------	---------

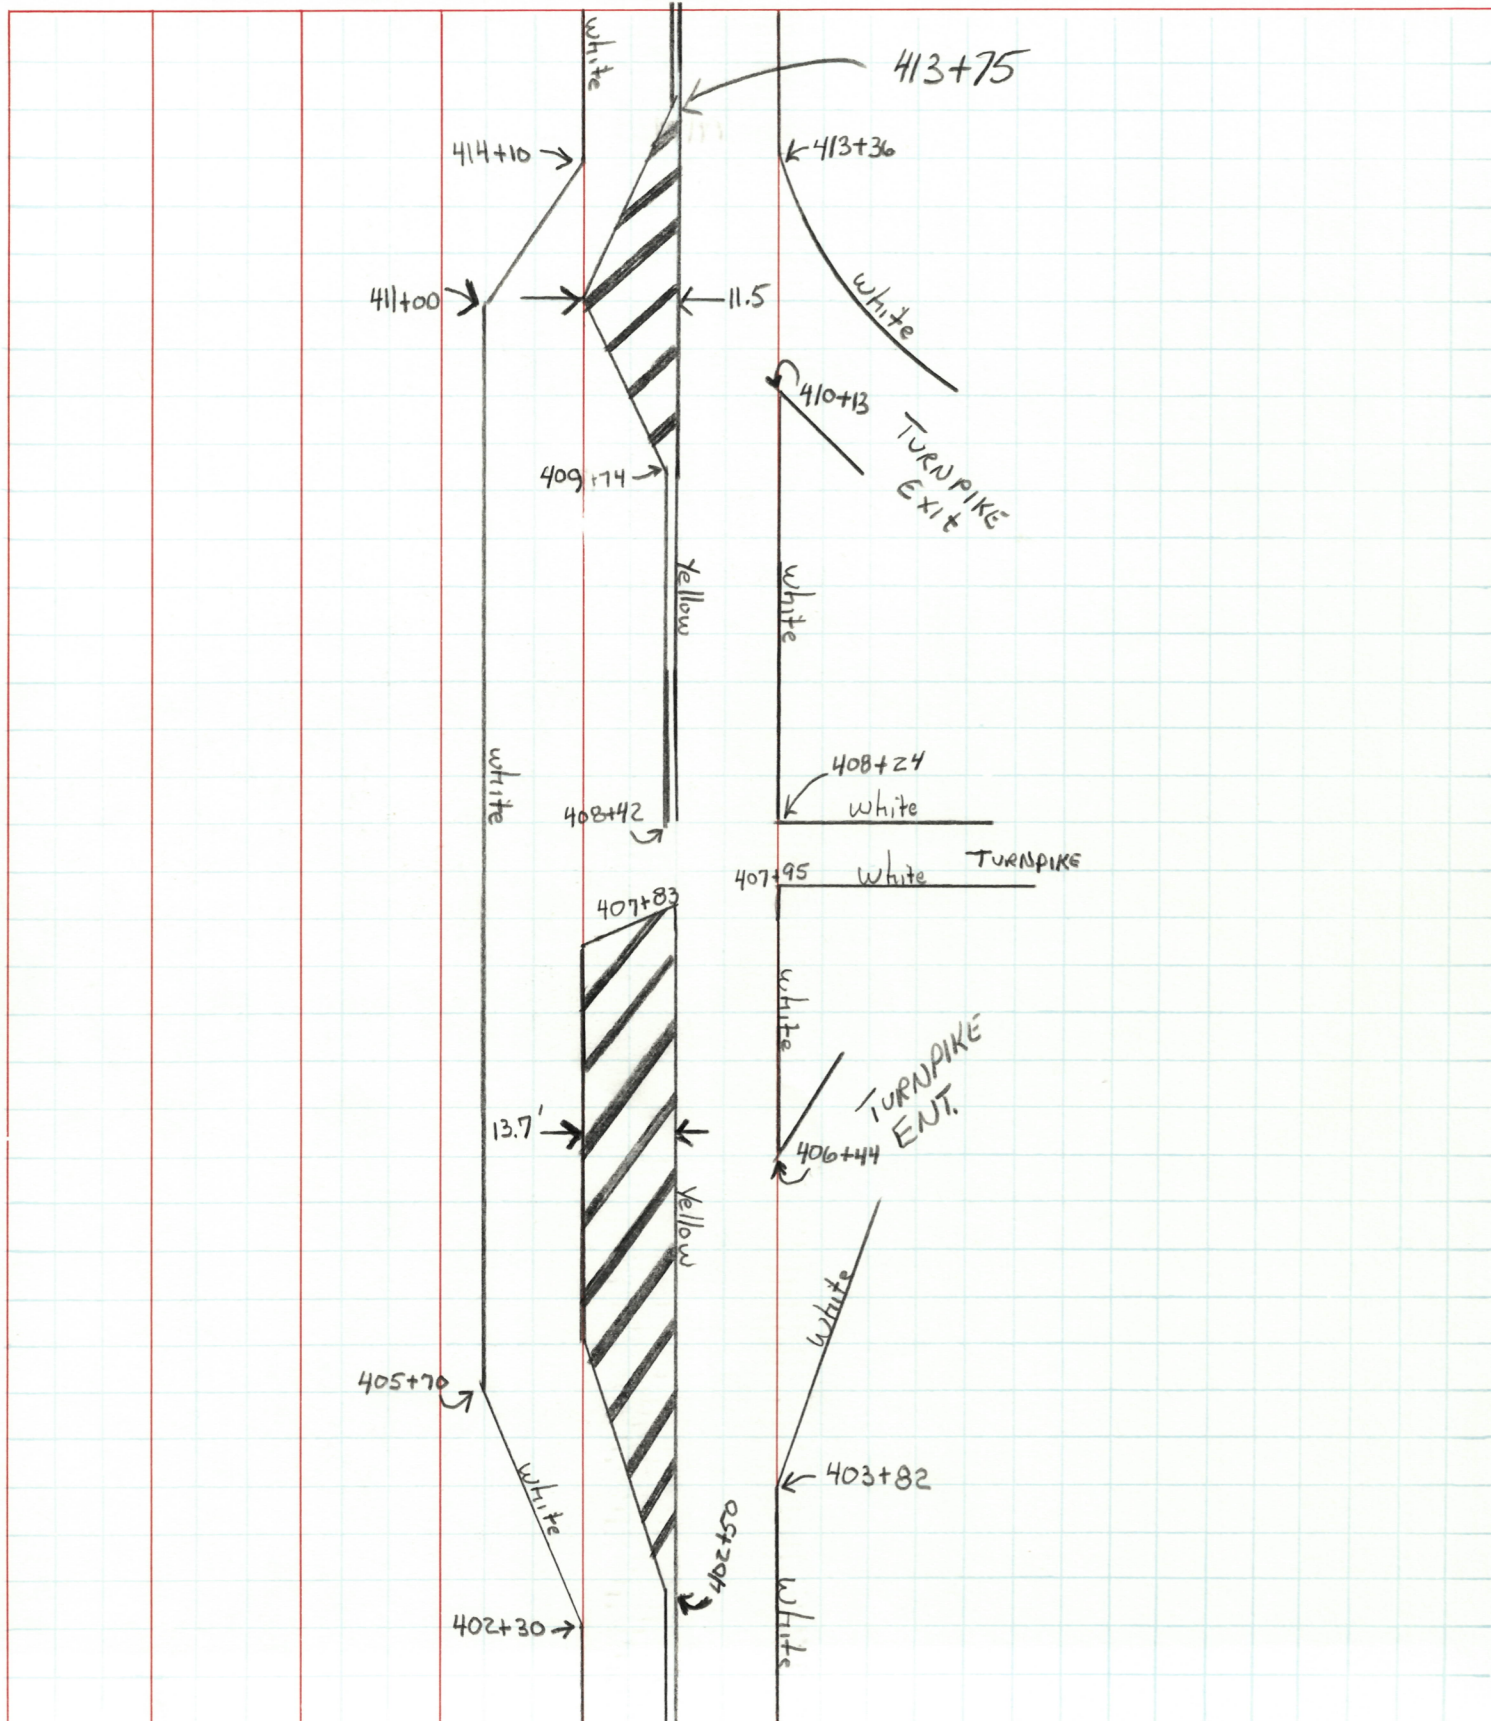

PERSONNEL	TITLE	PERSONNEL	TITLE	COUNTY	FULTON	DATE	3-3-92
LOEHARKE	TD			S. R.	108	WEATHER	CLEARING
CURTIS	Rod			SEC.	UNDER OHIO TURNPIKE	TEMP.	+48
DODDS	Rod			DESCRIPTION <u>Minimum Vert. Distance under bridges</u> JOB NO.			

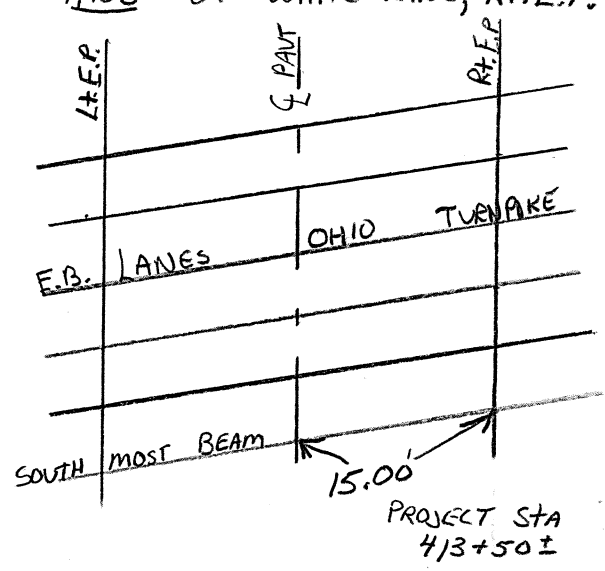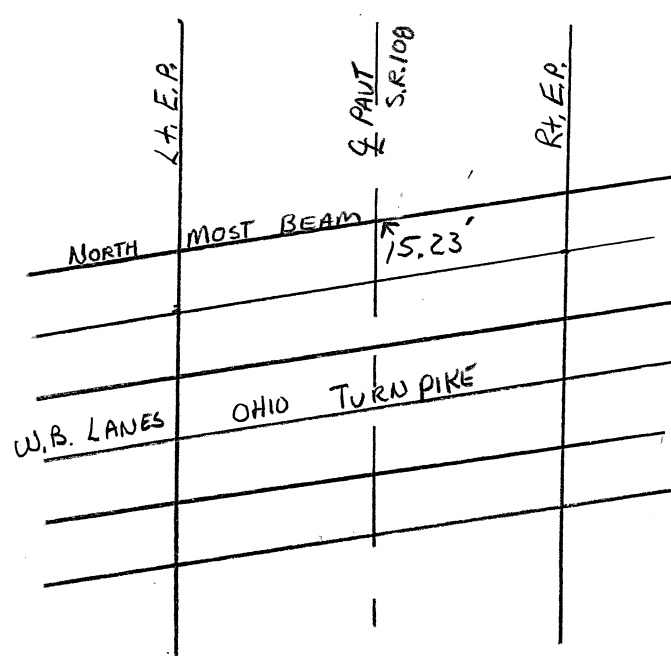
S.R.	S.L.M.	Vert. Dist.	Date Checked	Remarks
108	07.85	15.00	3-3-92	SOUTH MOST BEAM, OVER $\frac{1}{2}$ PAVT AND of White Line, Rt. E.P. 
S.R. 108	07.86	15.23	3-3-92	NORTH MOST BEAM @ $\frac{1}{2}$ PAVT Project Sta 414+80± 

PERSONNEL	TITLE	PERSONNEL	TITLE	COUNTY	DATE	S. R.	WEATHER	SEC.	TEMP.	DESCRIPTION	LEFT	CENTER LINE	RIGHT	JOB NO.
LOENRKE				FULTON	4-24-92	S.R. 108	RAIN	6.44	+45	Shorts for J. Huss - Pavt. WIDTH				
CURTIS														
ROMETO														

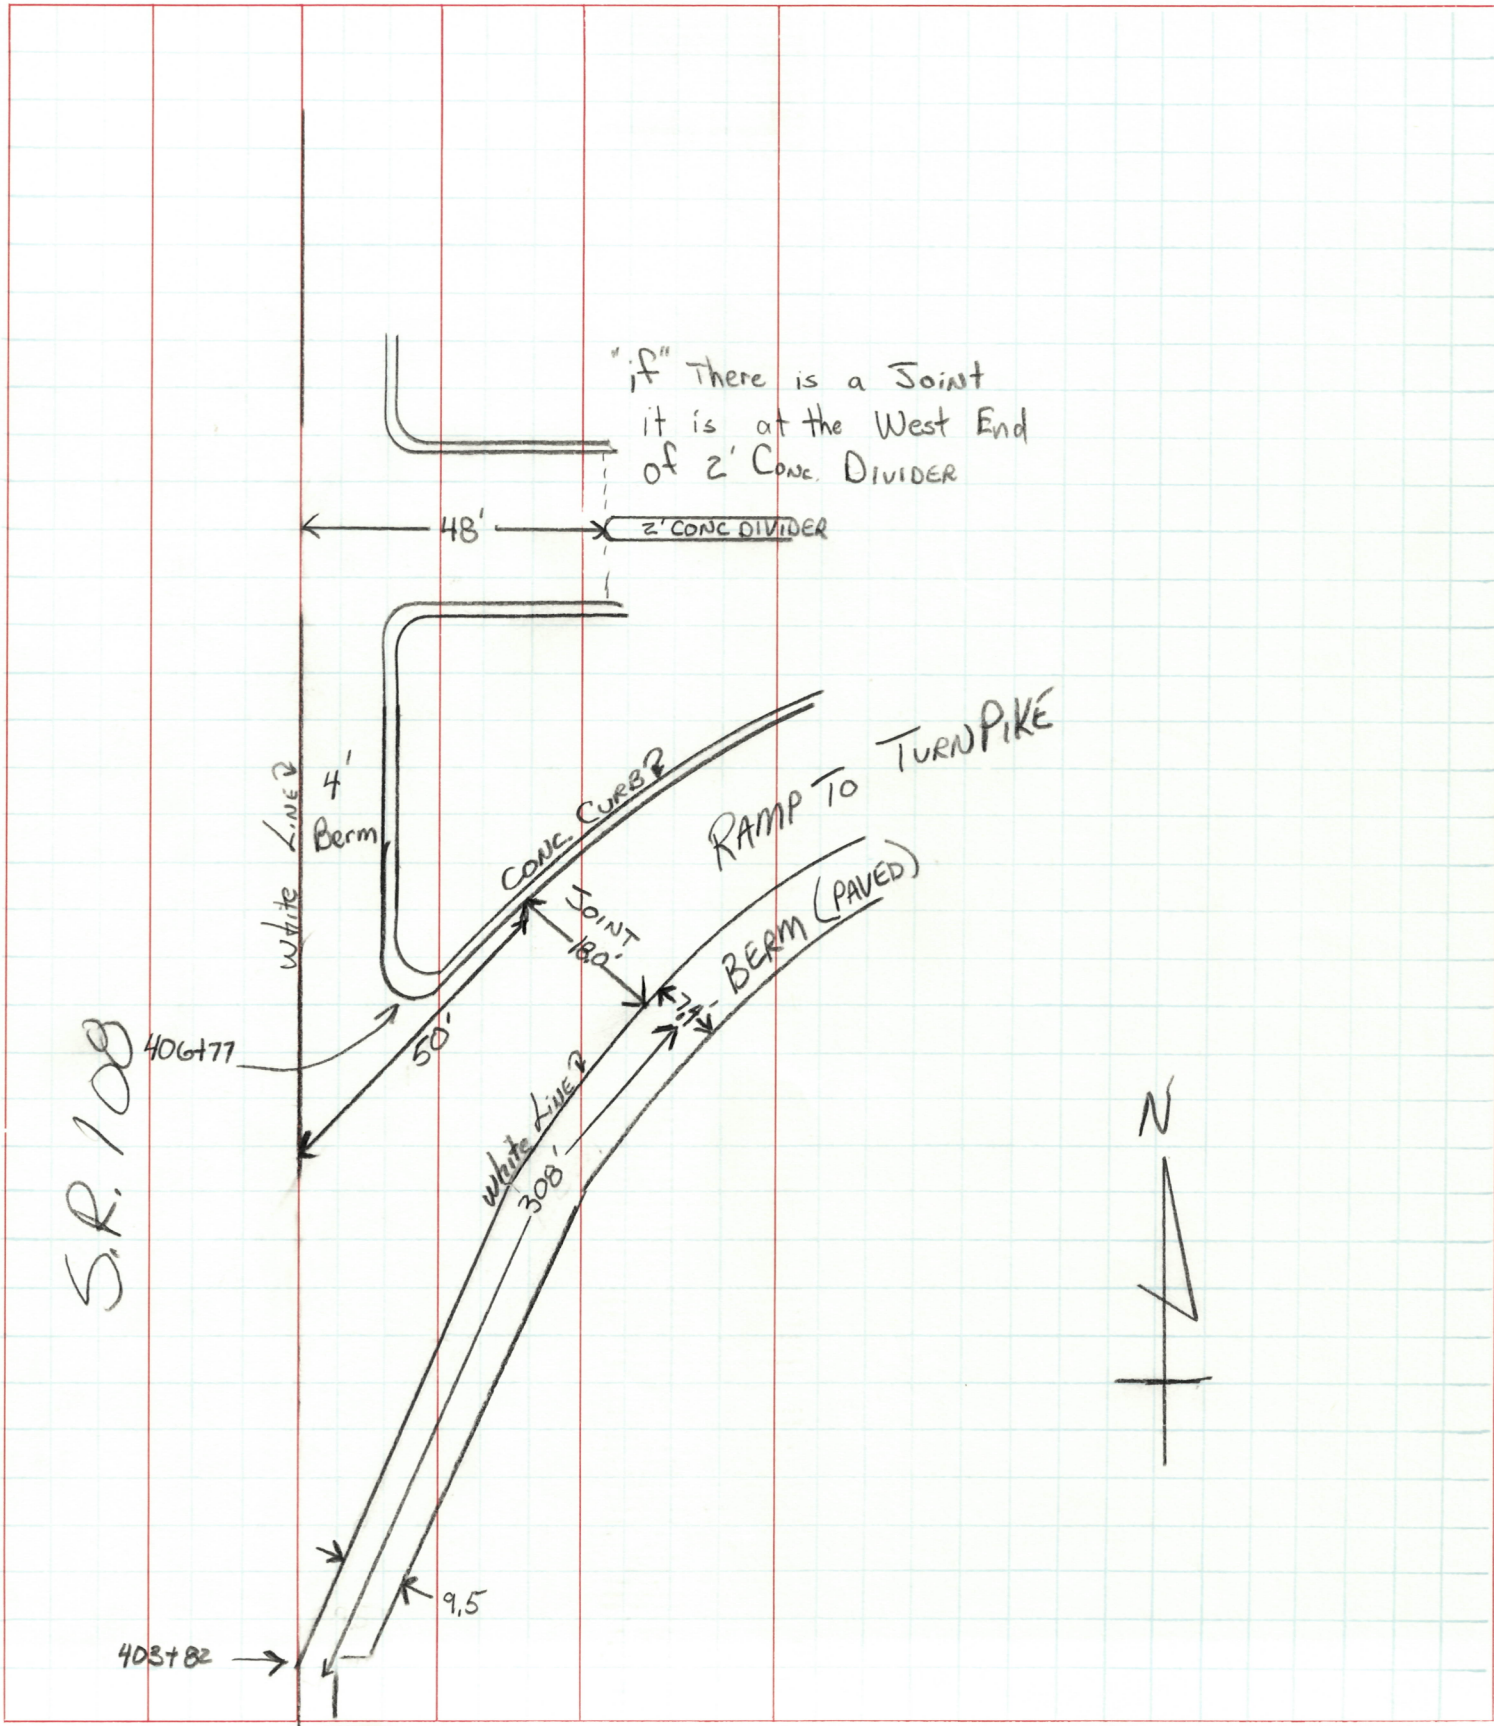

PERSONNEL	TITLE	PERSONNEL	TITLE	COUNTY	DATE	S. R.	WEATHER	SEC.	TEMP.
LOEHRKE				FULTON	4-24-92	S.R. 100	RAIN	6.44	+45
CWATIS									
Romero									

DESCRIPTION	LEFT	CENTER LINE	RIGHT	JOB NO.
Shorts for J. Huss.				

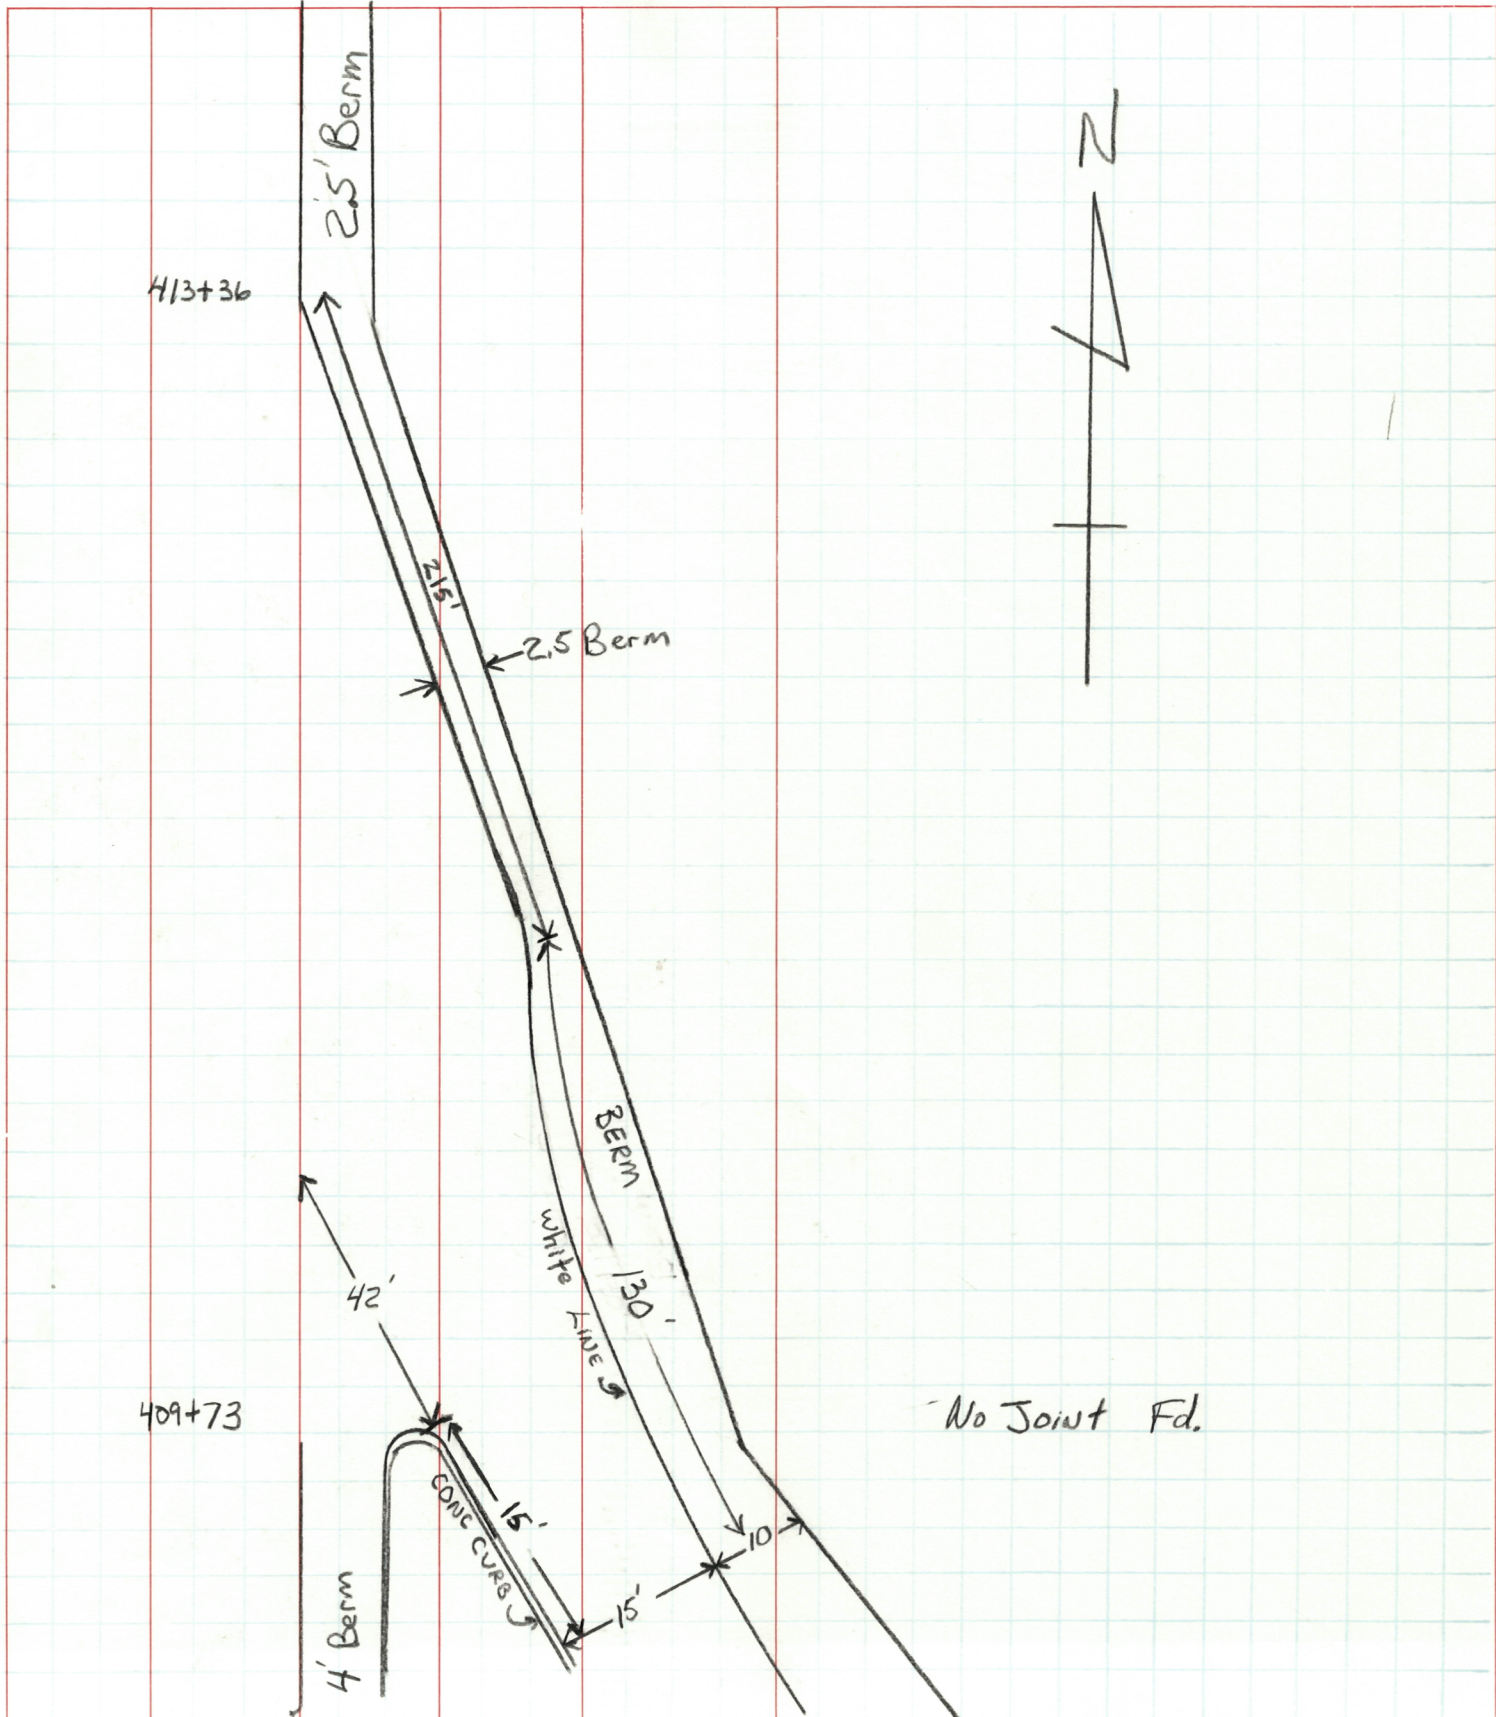

1990 TWO-LANE RESURFACING PROGRAM

PRIORITY NO. NOPART WORK REQUIRED OFSHEET 1 OF 5COUNTY FultonROUTE SR 108SECTION 6.44BEGIN LOG (SLM) 6.44TERMINII USR 20AEND LOG (SLM) 9.82TERMINII N. Old State Line Rd.TOTAL LENGTH 3.38

MILES

MUNICIPALITY _____

BEGIN LOG (SLM) _____ END LOG (SLM) _____

MUNICIPALITY _____

BEGIN LOG (SLM) _____ END LOG (SLM) _____

PROPOSED WORK:

PAVEMENT 1 3/4" 402, 1 1/4" 404 SHOULDER 1 3/4" 402, 1 1/4" 404, 617

OTHER _____

EXISTING DATA: see sheet 3

SLM	TO	PAV'T	WIDTH	(type)	SHLD WIDTH	(type)
SLM	TO	PAV'T				
SLM	TO	PAV'T				
THIS DATA WAS GATHERED
& TURNED IN BUT THEY
NEVER MADE A PLAN.

STRUCTURES:

STR. NO. NONE, WI
 STR. NO. _____, WI
 STR. NO. _____, WI
USE THIS TO CHECK THE
EXISTING ROAD

RAILROAD CROSSING:

NAME	STATION	NO. TRACKS	LENGTH ALONG C L	(no work)
NAME <u>NONE</u>	STATION _____	NO. TRACKS _____	LENGTH ALONG C L _____	ft
NAME _____	STATION _____	NO. TRACKS _____	LENGTH ALONG C L _____	ft
NAME _____	STATION _____	NO. TRACKS _____	LENGTH ALONG C L _____	ft

MISCELLANEOUS:

NO. RAISED PAVEMENT MARKERS; EDGE OF PAVEMENT 47, CENTERLINE 318
 NO. MAILBOX APPROACHES 0, MAILBOX SUPPORTS 0

REMARKS: CK VERTICAL ON TURNPIKE AFTER RESURFACE

Had 10-6-89
BAC


APPROACHES (INTERSECTIONS & DRIVES)

COUNTY Fulton

ROUTE SR 108

SECTION 6.44-9.82

L = Prop Pav't Depth (in.) x .10; W = Width @ Mouth; W-1 = Width @ Throat

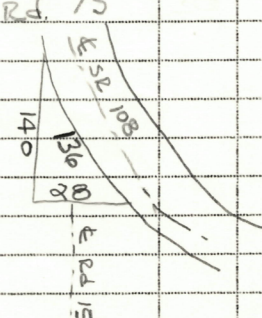INTERSECTIONS								DRIVES				
STATION	SIDE	NAME OR NO.	L	W	W-1	ASPH	CONC	STATION	SIDE	W	ASPH	CONC
392+77	RT	Co. Road	30	94	28	X						
"	LT	"A"	30	94	23	X						
406+00		ENTRANCE Ramp										
408+04		ENTRANCE Exit Ramp										
410+80		Exit Ramp										
446+25	RT	Co Rd.	30	100	28	X						
"	LT	"J"	30	105	25	X						
501+21	RT	Co Rd.	30	86	28	X						
"	LT	"K"	30	86	20	X						
514+70	LT	Co Rd. "15"				X						
												
420+50	LT	SOUTH ENTRANCE TO FAIRGROUNDS	24'	165	80	X						
* Should be Feathered - Levelled - There is a nasty Drop-off Here Now												
432+70	LT	Center ENTRANCE TO FAIR Grounds	24'	118	40	X						
* SAME SITUATION AS ABOVE												

PERSONNEL TITLE PERSONNEL TITLE COUNTY FULTON DATE 12-7-88/41
HOFFMAN III LOEHLKE H.C. S. R. 108 WEATHER Cloudy
DARNALISE P.C. SEC. 6.44 - 9.82 TEMP. 35°

DESCRIPTION

Pavt Details


JOB NO.

LEFT

CENTER LINE

RIGHT

Pavt	widths	ALL	404
Sta	Lt. Berm	white line	Rt. Berm
341+00	3.5	37.0	3.2'
343+00	4.4	36.1	3.4'
345+00	3.0	35.0	3.3'
347+00	3.3	28.5	3.7'
349+00	3.0	24.0	3.2'
369+29 mm 7	3.0	23.9	3.0'
402+00	3.0	24.1	3.0'
404+00	2.7	33.8	3.0
414+00	2.9	23.3	3.1
422+27 mm 8	3.3	23.4	3.0
480+77 mm 9	2.3	23.3	1.9
518+51	2.7	23.4	2.2

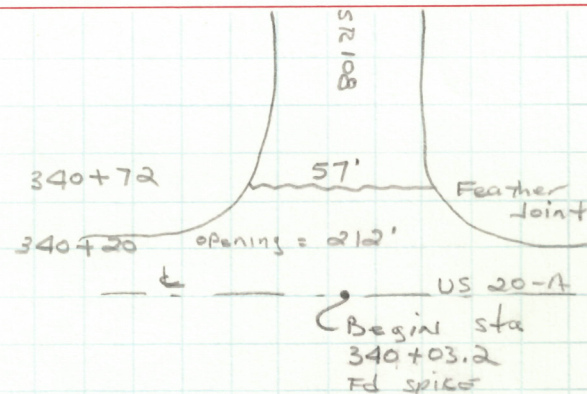


Berms change FROM 3'± TO 2'±
at Road "J"

const. joint.

Rough Pavt AREAS - MILL & LEVEL COURSE
 340+72 37' WIDE - ALL 3 LANES
 TO 24' WIDE
 349+00

402+00 TO 408+00 Lt. LANE - outside EDGE - 8' WIDE FALLING OFF - Needs Level Course

PERSONNEL	TITLE	PERSONNEL	TITLE	COUNTY	DATE	WEATHER	TEMP.
HOFFMAN				FULTON	12-7-88	CLOUDY	+40°
BARNHISEL				S. R. 108			
LOEHRKE				SEC. 6.44 - 9.82			
DESCRIPTION 1990 RESURFACING - PAVEMENT DETAILS				JOB NO.			
LEFT		CENTER LINE		RIGHT			

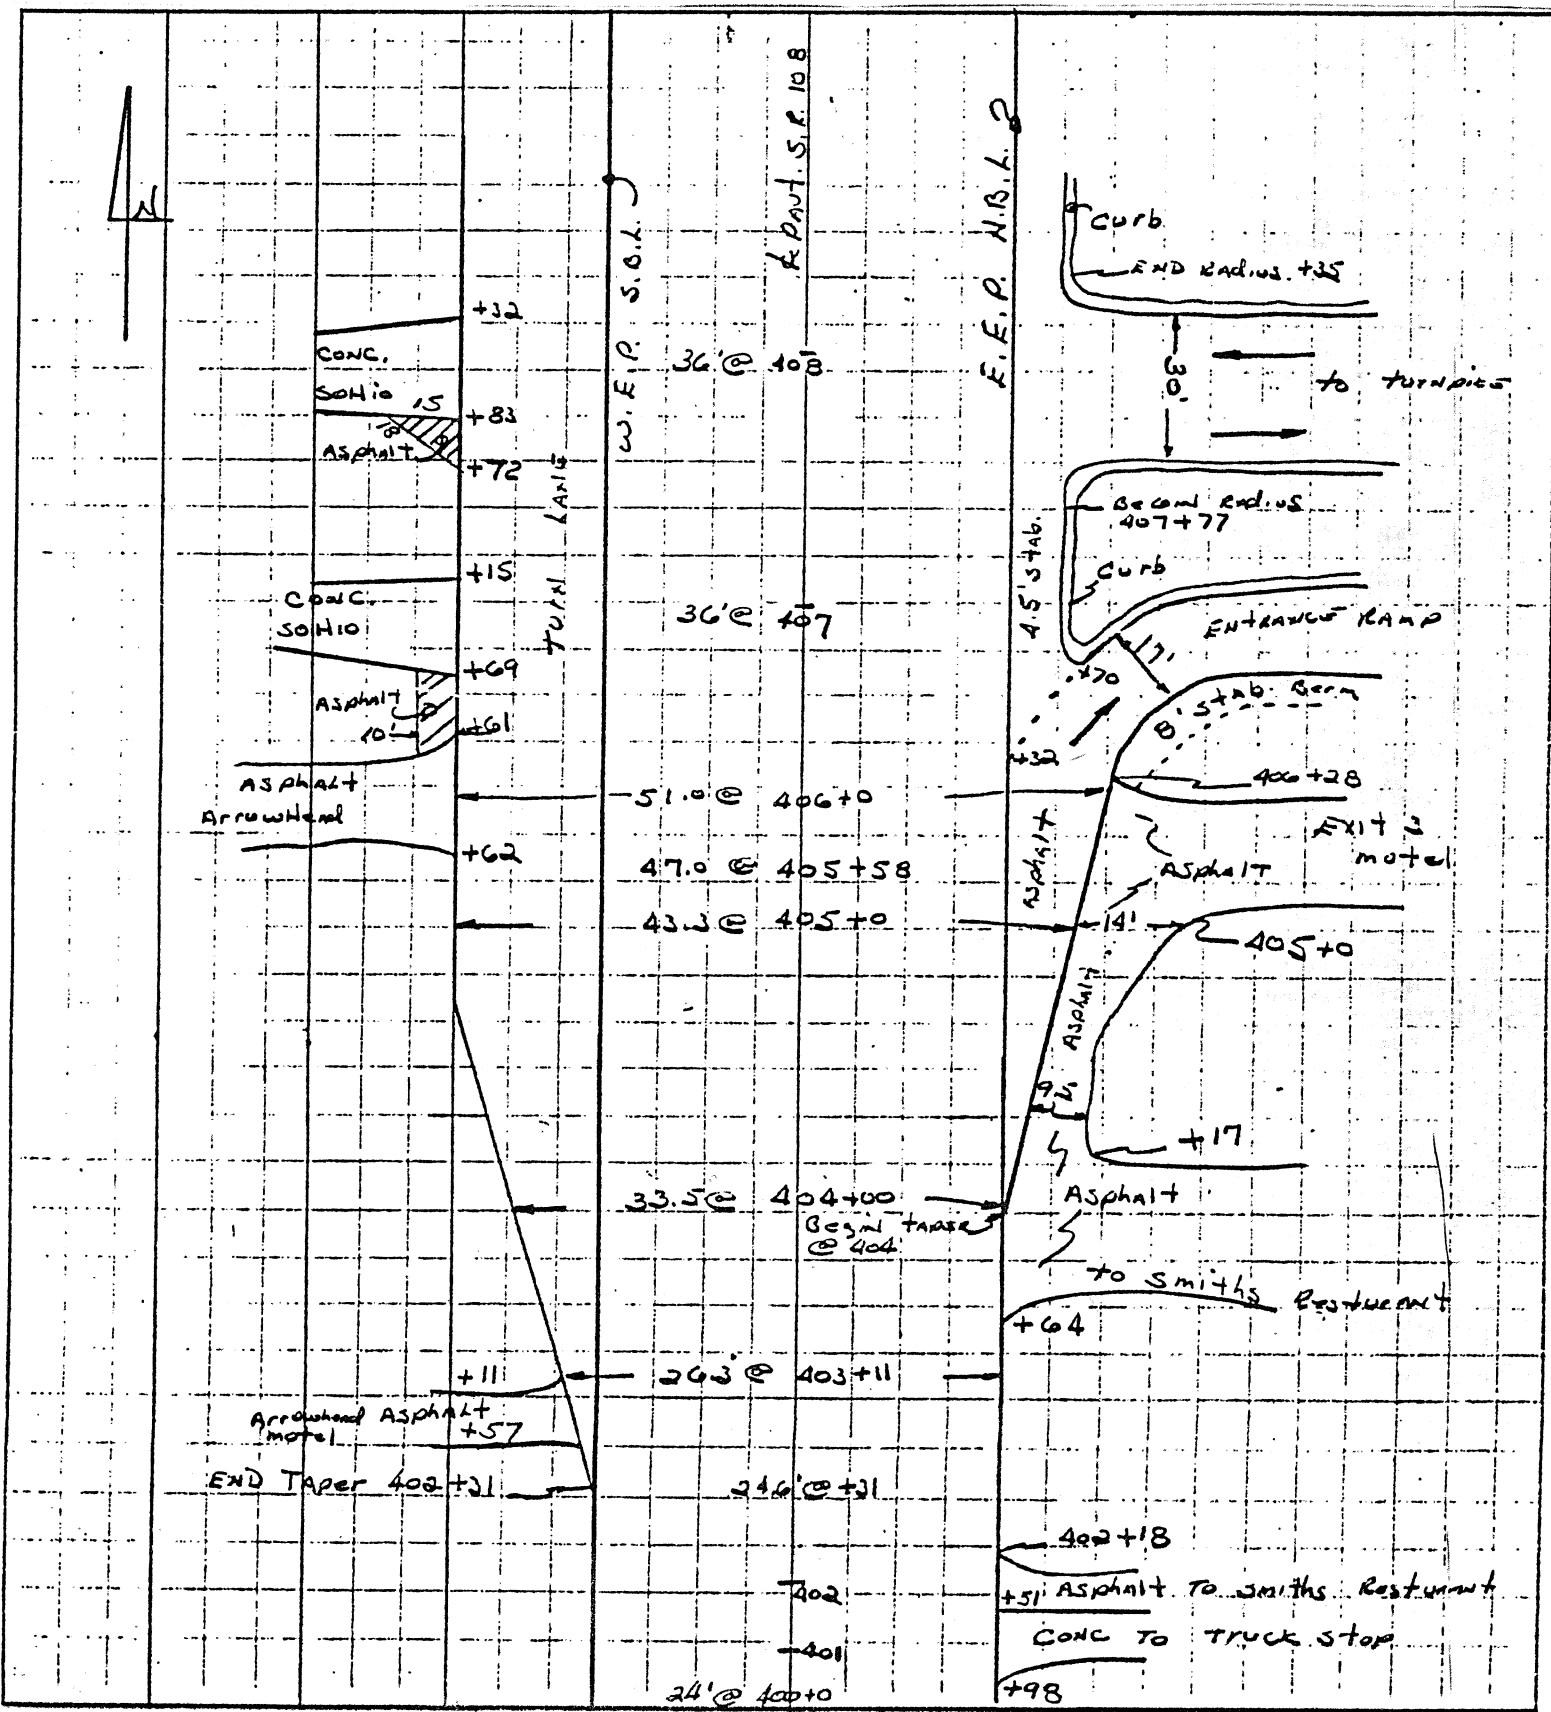

PERSONNEL TITLE PERSONNEL TITLE

SHEET NO. 545

HOFFMAN
LOEHRKE
BARNHISEL

COUNTY FULTON

DATE 12-7-88

S. R. 108

WEATHER CLOUDY

SEC. 6.44-9.82

TEMP. +40°

DESCRIPTION 1990 RESURFACING - PAVEMENT DETAILS

JOB NO.

LEFT

CENTER LINE

RIGHT

