


O.D.O.T. DISTRICT 2 SURVEY OFFICE (USE ONLY)


PERSONNEL	REFERENCE NO. <u>2</u>	SHEET <u>2</u> OF <u>17</u>
NOTES <u>AUBLE</u>	DATE <u>7/19/21</u>	ROUTE <u>SR 108</u>
H.C. <u>NIESE</u>	WEATHER <u>FAIR</u>	COUNTY <u>FULTON</u>
R.C. <u>AUBLE</u>	TEMP. <u>73°</u>	TOWNSHIP <u>CLINTON</u>
		SECTION <u>12</u>
DWG BY <u>WHITAKER</u>	PID <u>92361</u>	T <u>6</u> N R <u>6</u> E

TYPE MONUMENT P.K./WASHER
 ON SURFACE - ~~BELOW~~ ON
 OFFSET CL PAVEMENT 1.0' ~~LT~~ : RT
9.7' TO RT EDGE PAVEMENT
 STATION: 26+58

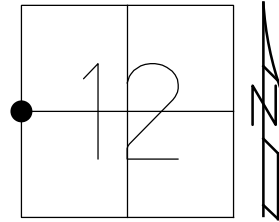

HORZ.DATUM: NAD83 (2011) GEOID: 2012A
 GRID: NORTHING: 669701.465 EASTING: 1520845.933

RECORD:
 FD P.K./WASHER
 7/14/00, KPM
 SET P.K./WASHER
 8/4/00, KPM
 FD P.K./WASHER
 REF2
 9/16/19, JFO
 SET MAG/WASHER
 REF2
 7/19/22, TDN

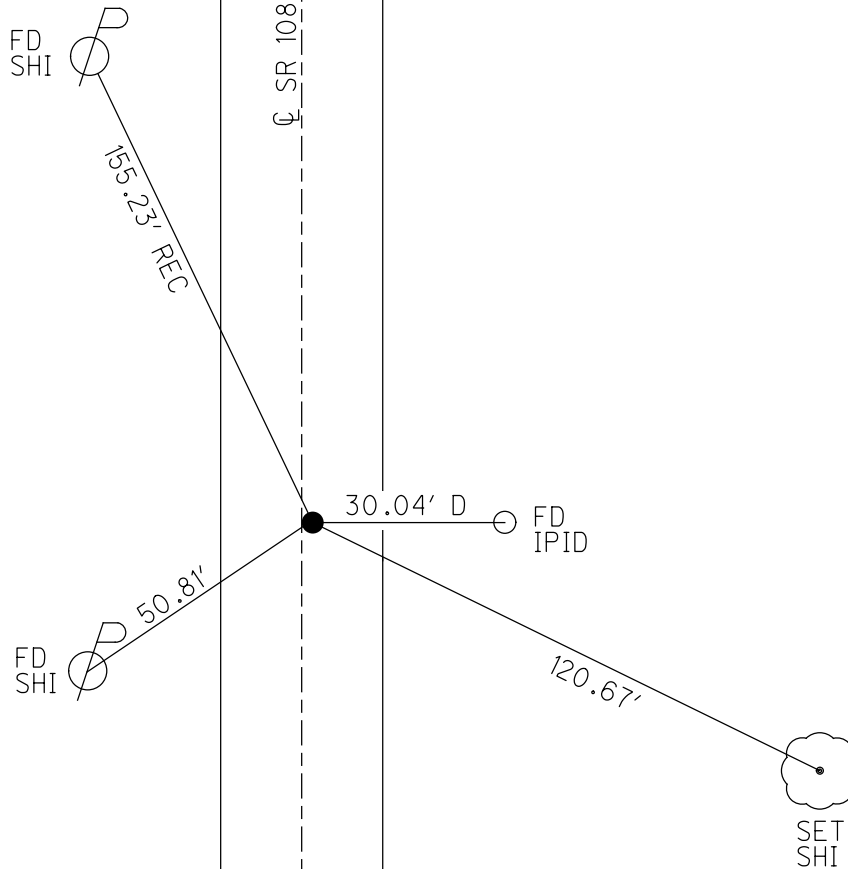

O.D.O.T. DISTRICT 2 SURVEY OFFICE (USE ONLY)

PERSONNEL

REFERENCE NO. 2

SHEET 2 OF 17

NOTES MOSER DATE 7/14/00
 H.C. BARNHISEL WEATHER FAIR
 R.C. CANTERBURY TEMP. 78°

ROUTE SR 108
 COUNTY FULTON
 TOWNSHIP CLINTON
 SECTION 12

DWG BY NIESE PID _____

T 6 N R 6 E

TYPE MONUMENT P.K./WASHER

ON SURFACE - ~~BELOW~~ ON

OFFSET C PAVEMENT 1.0' ~~RT~~ : RT

9.7' TO RT EDGE PAVEMENT


STATION: 26+58

HORZ.DATUM: _____

GEOID: _____

GRID: NORTHING: _____

EASTING: _____

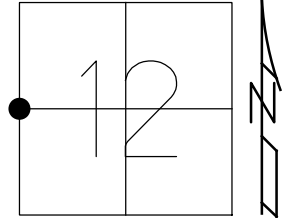

RECORD:
 FD P.K./WASHER
 7/14/00, KPM
 SET P.K./WASHER
 8/4/00, KPM



155.23' REC

C SR 108

54.21'

SET SHI
 12" TWIN CEDAR

30.00' P FD
 IPID



50.86'

O.D.O.T. DISTRICT 2 SURVEY OFFICE

PERSONNEL _____

REFERENCE NO. 2

SHEET 2 OF 10

NOTES Moser

H.C. Barnhisel

R.C. Canterbury

DATE 7-14-00

WEATHER Fair

TEMP. +78°F

ROUTE SR-108

COUNTY Fulton

TOWNSHIP Clinton

SECTION 12

T6 N R 6 E



TYPE MONUMENT PK/w

ON SURFACE - ~~BELOW~~ Surface

~~LEFT~~ - PAV'T. - (RIGHT) 1.0'

9.7' TO RT EDGE PAVEMENT

S.L.M. 26+58

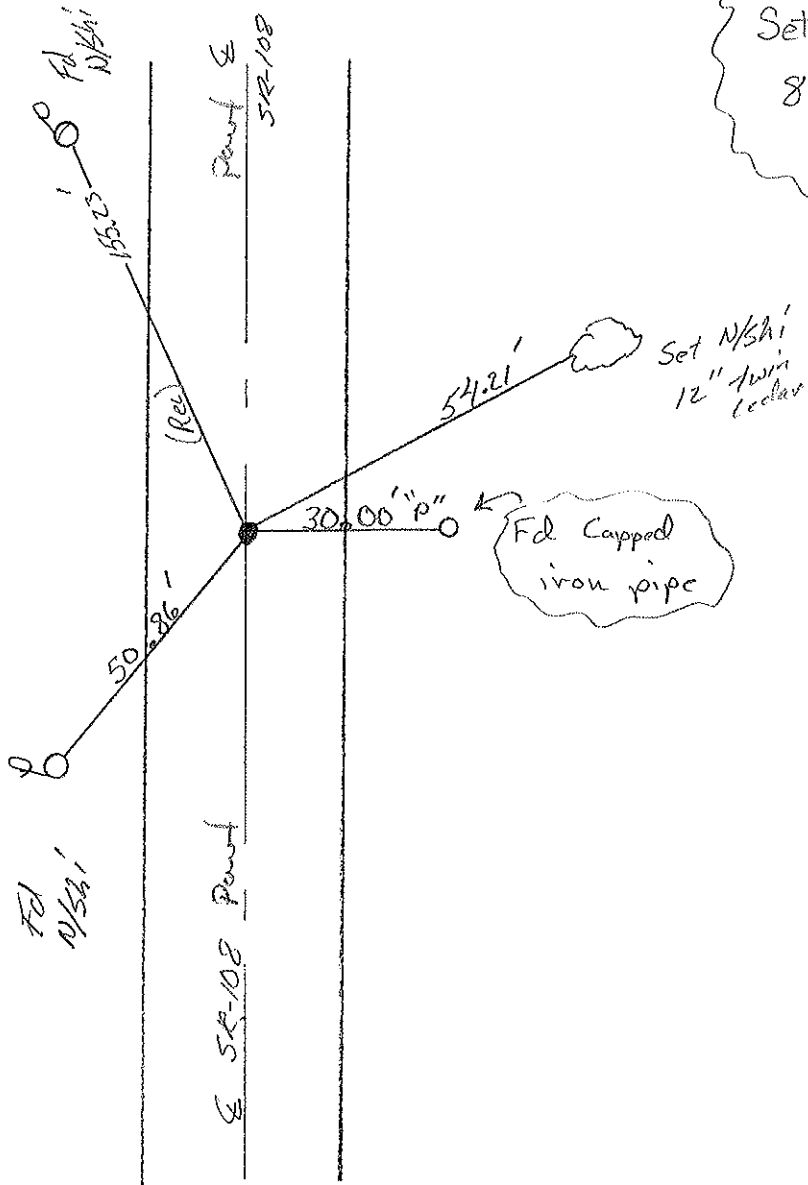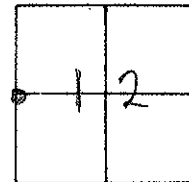

O.D.O.T. DISTRICT 2 SURVEY OFFICE

PERSONNEL _____

REFERENCE NO. 2

SHEET 2 OF _____

NOTES 1. Stone

H.C. D. Curtis

R.C. J. Householder

DATE 19 Oct. 88

WEATHER Cool

TEMP. 78°

ROUTE SR #108

COUNTY Fulton

TOWNSHIP Clinton

SECTION 12

T _____ R _____


TYPE MONUMENT PK Nail

ON SURFACE - BELOW Surface


LEFT - \odot PAV'T. - RIGHT _____

_____ TO _____ EDGE PAVEMENT

S.L.M. 26+47

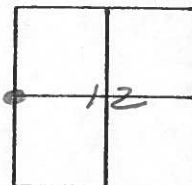

OK 6/6/89 I.R.S.

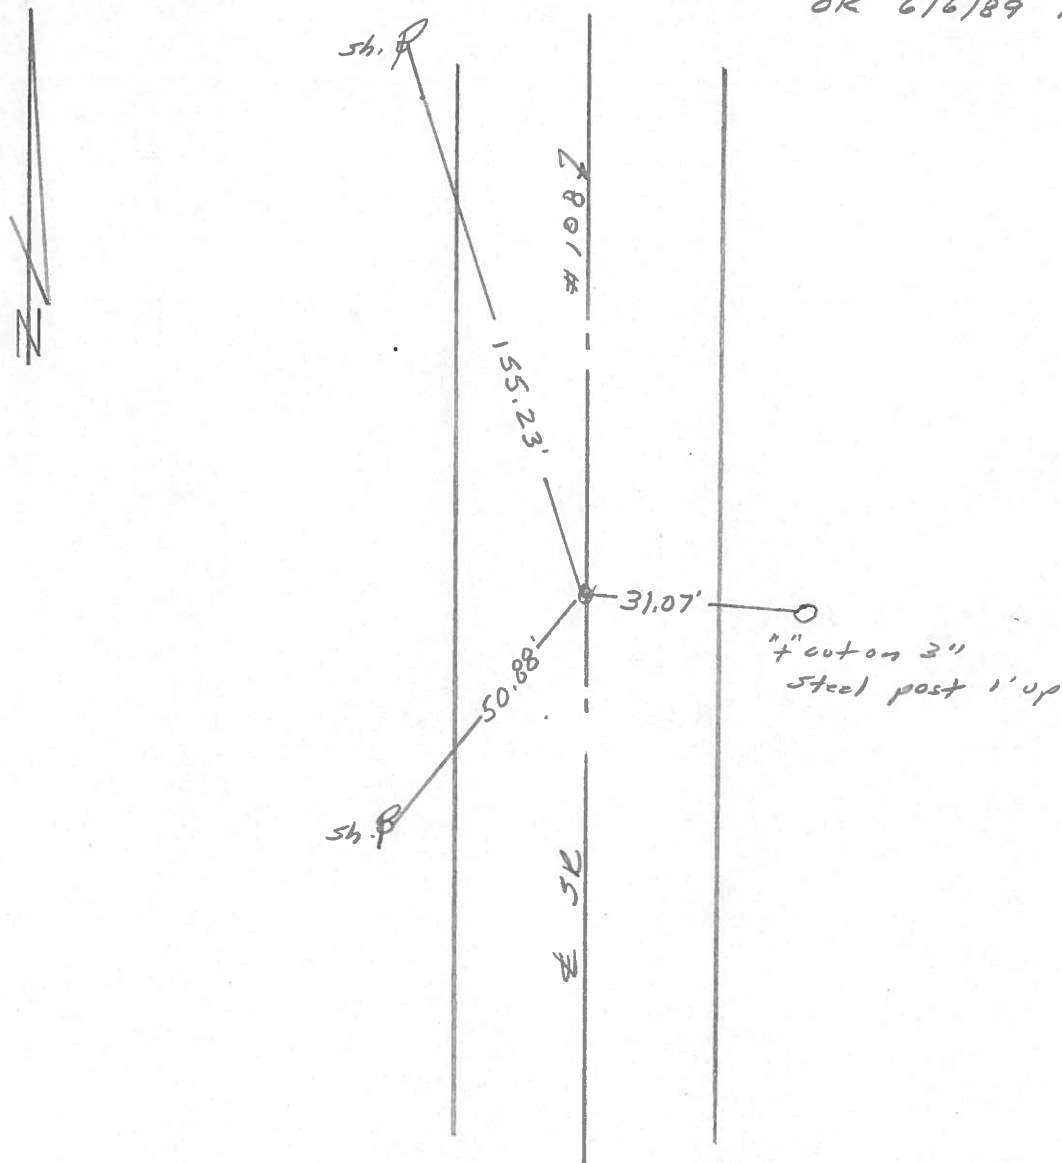

County FULTON S.R. 108

Township Clinton

Section 12

T N, R E

Personnel I. Stone

P. Neuser


R. Michalak

D. Curtis


Date 29 Sept. 80

Weather Fair

Temp. 73°

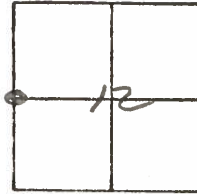

REF. NO. 2

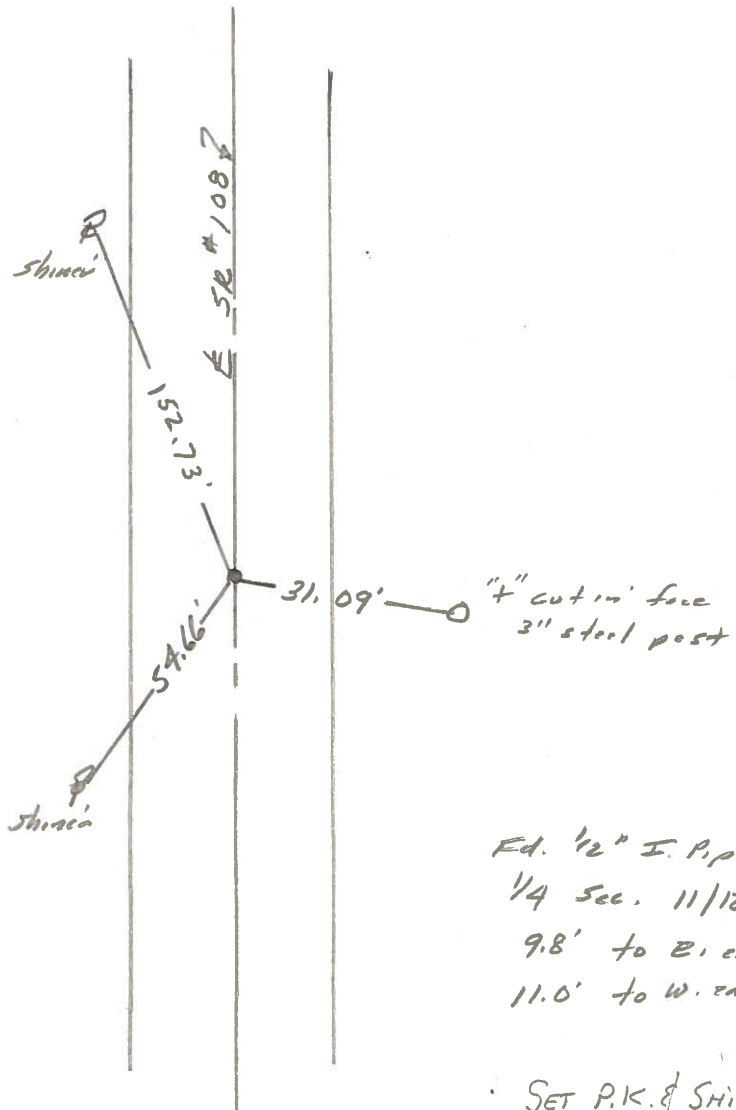

PERSONNEL TITLE PERSONNEL TITLE
 Tomsic _____
 Neuser _____
 Granata _____
 Vanyo _____

COUNTY Fulton DATE April 19, 1973
 S. R. 108 WEATHER _____
 SEC. _____ TEMP. _____

DESCRIPTION LEFT CENTER LINE RIGHT JOB NO.

