

O.D.O.T. DISTRICT 2 SURVEY OFFICE (USE ONLY)

PERSONNEL _____

REFERENCE NO. 3

SHEET 3 OF 17

NOTES AUBLE DATE 7/19/21
 H.C. NIESE WEATHER FAIR
 R.C. AUBLE TEMP. 73°

ROUTE SR 108
 COUNTY FULTON
 TOWNSHIP CLINTON
 SECTION 12
 T 6 N R 6 E

DWG BY WHITAKER PID 92361

TYPE MONUMENT MAG/WASHER

ON SURFACE - ~~BELOW~~ ON

OFFSET ☉ PAVEMENT 1.0' LT : ~~RT~~

- TO - EDGE PAVEMENT


STATION: 53+42

HORZ. DATUM: NAD83 (2011)


GEOID: 2012A

GRID: NORTHING: 672376.142

EASTING: 1520869.821

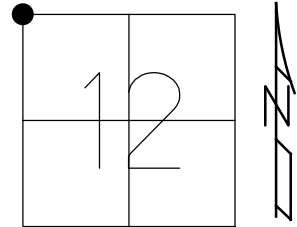

RECORD:
 FD P.K./WASHER
 7/14/00, KPM
 SET P.K./WASHER
 8/4/00, KPM
 FD MAG NAIL
 REF3
 9/16/19, JFO
 SET MAG/WASHER
 REF3
 7/19/22, TDN

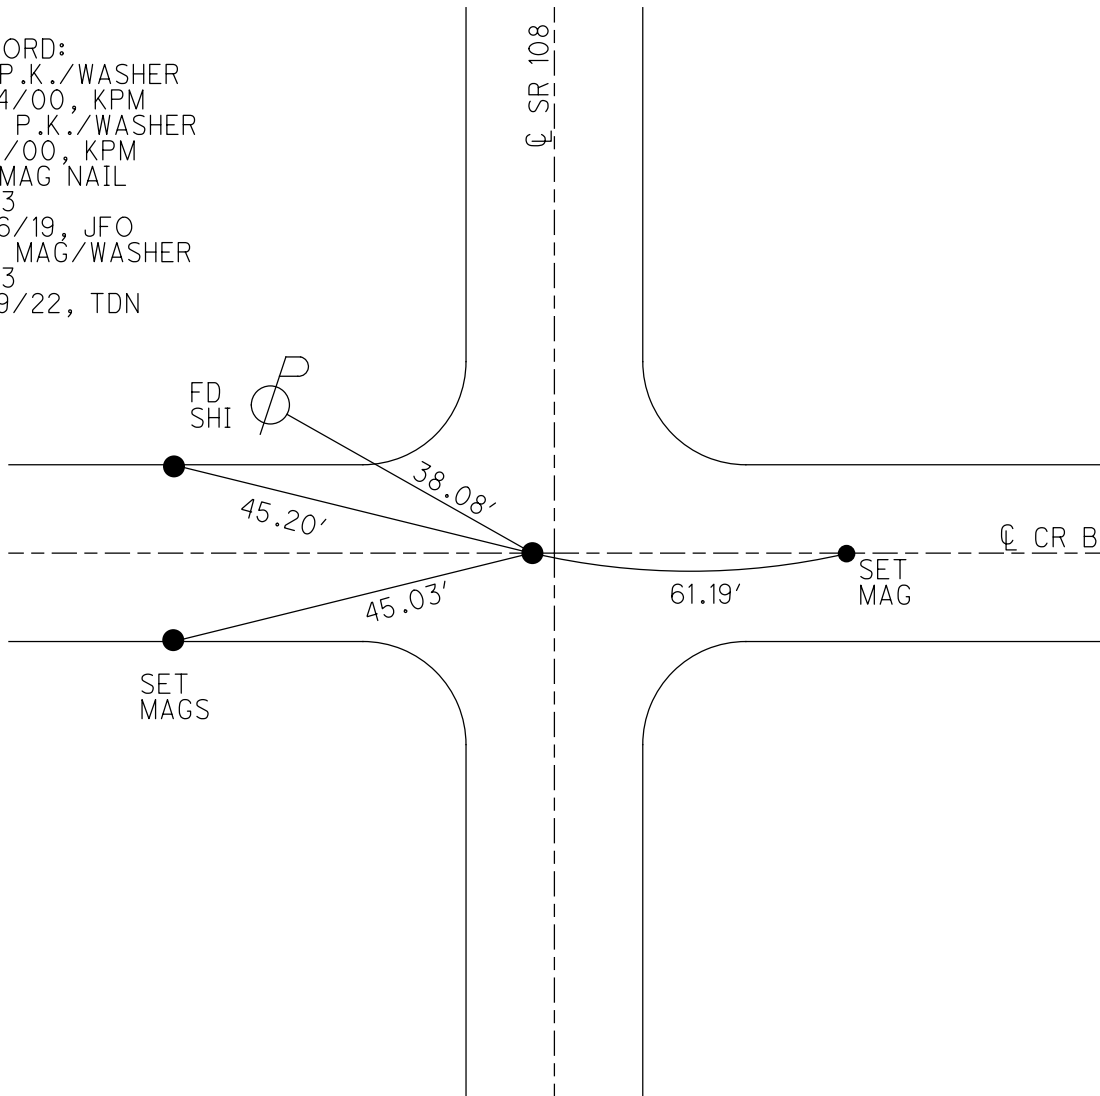

O.D.O.T. DISTRICT 2 SURVEY OFFICE (USE ONLY)

PERSONNEL _____

REFERENCE NO. 3

SHEET 3 OF 17

NOTES MOSE DATE 7/14/00
 H.C. BARNHISEL WEATHER FAIR
 R.C. CANTERBURY TEMP. 78°

ROUTE SR 108
 COUNTY FULTON
 TOWNSHIP CLINTON
 SECTION 12
 T 6 N R 6 E

DWG BY NIESE PID _____

TYPE MONUMENT P.K./WASHER

ON SURFACE - ~~BELOW~~ ON _____


OFFSET CL PAVEMENT 1.0' LT : ~~RT~~

- TO - EDGE PAVEMENT


STATION: 53+42

HORIZ.DATUM: _____ GEOID: _____

GRID: NORTHING: _____ EASTING: _____

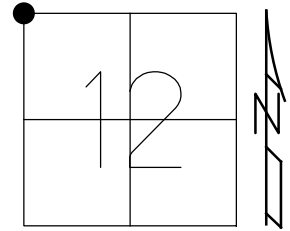

RECORD:
 FD P.K./WASHER
 7/14/00, KPM
 SET P.K./WASHER
 8/4/00, KPM

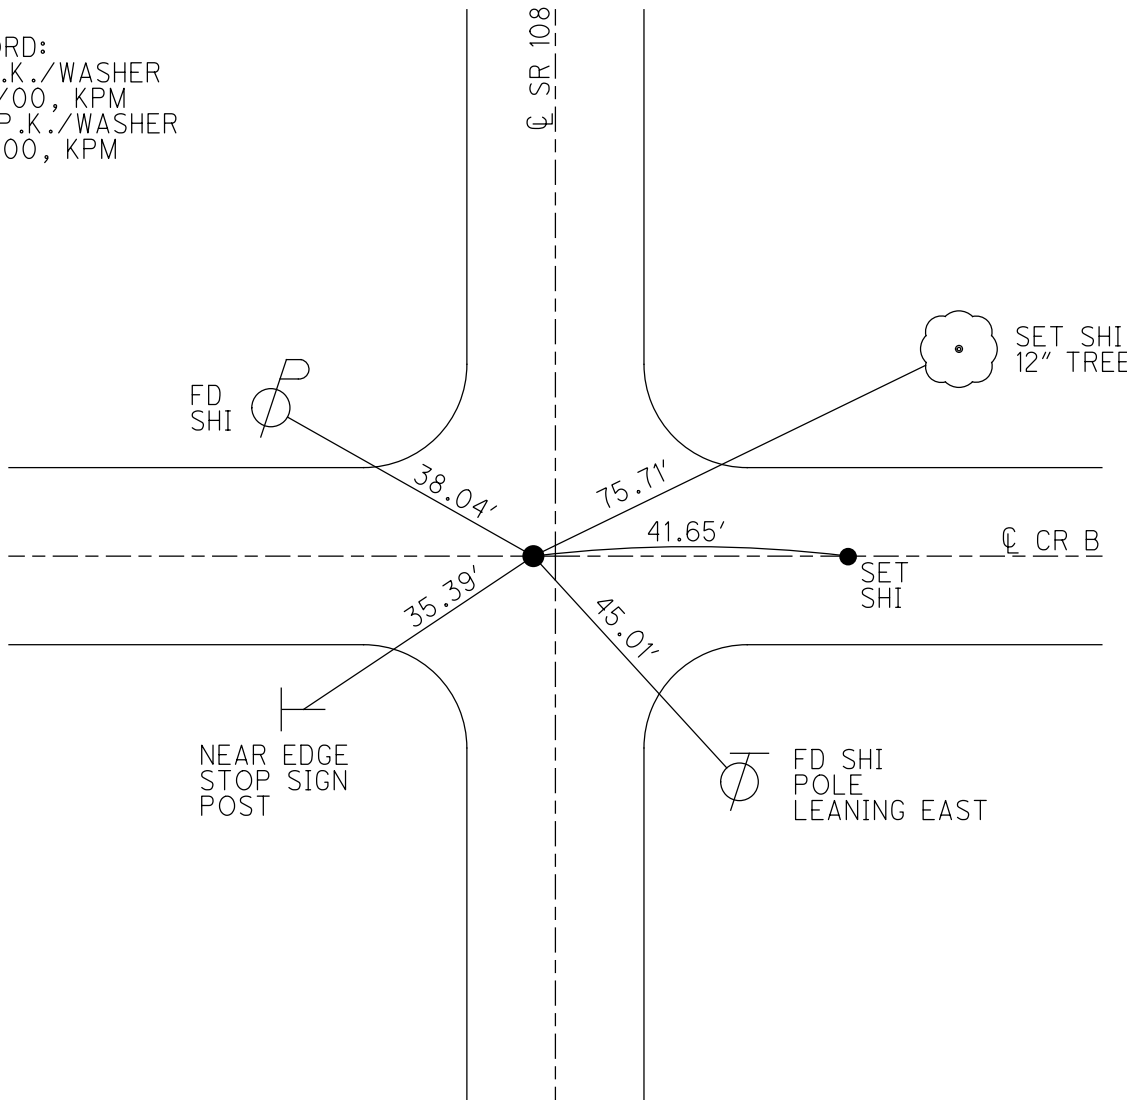

O.D.O.T. DISTRICT 2 SURVEY OFFICE

PERSONNEL _____

REFERENCE NO. 3

SHEET 3 OF 10

NOTES Mosar

H.C. Barnhisel

R.C. Canterbury

DATE 7-14-00

WEATHER Fair

TEMP. +78°F

ROUTE SR-108

COUNTY Fulton

TOWNSHIP Clinton

SECTION _____

T 6 N R 6 E

TYPE MONUMENT PK/W


ON SURFACE - BELOW Surface

LEFT ~~PAV~~ RIGHT 1'0 on E E. C.R. B

TO EDGE PAVEMENT

S.L.M. 53+42

2	1
11	12

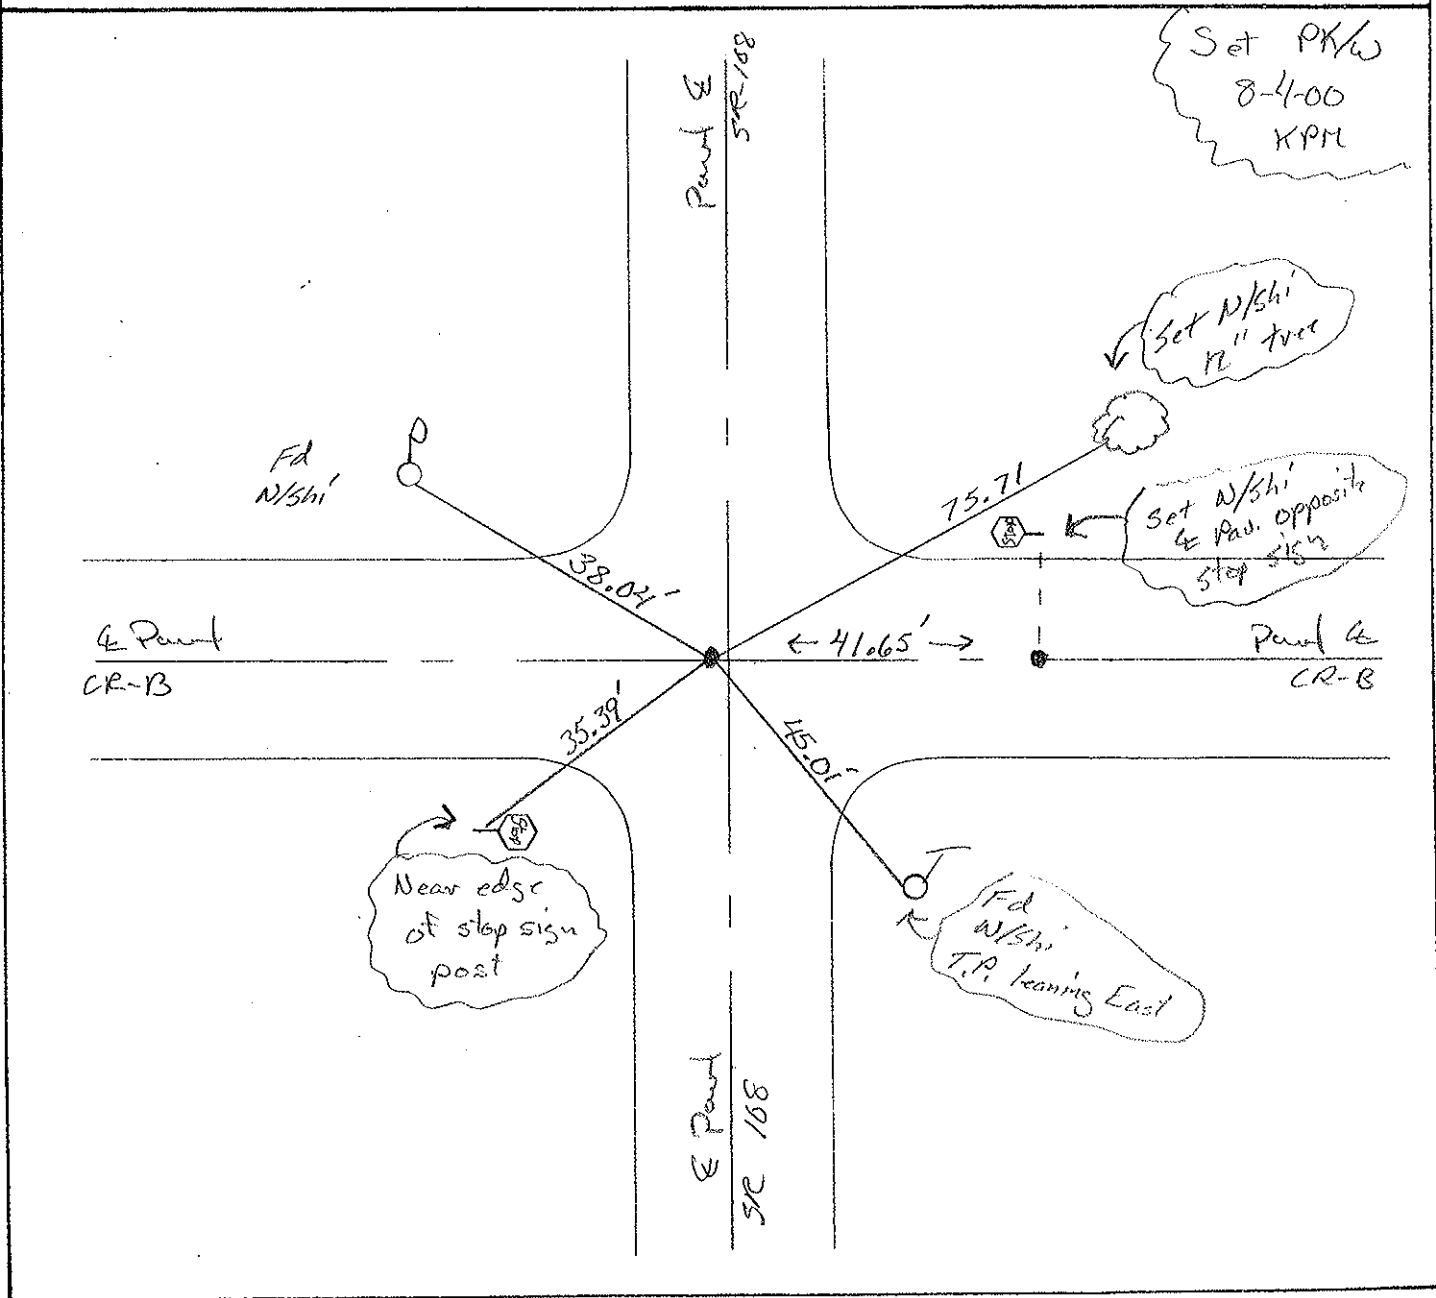

O.D.O.T. DISTRICT 2 SURVEY OFFICE

PERSONNEL _____

REFERENCE NO. 3

SHEET 3 OF _____

NOTES 1. Stone

H.C. D. Curtis

R.C. J. Hausholder

DATE 19 Oct. 88

WEATHER Cool

TEMP. 48°

ROUTE SR#108

COUNTY Fulton

TOWNSHIP Clinton

SECTION 1-2-11-12

T _____ R _____


TYPE MONUMENT PK Nail

ON SURFACE - BELOW Surface


LEFT - & PAV'T. - RIGHT _____

TO _____ EDGE PAVEMENT

S.L.M. 53+22

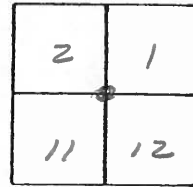

OK 6/7/89 IRS

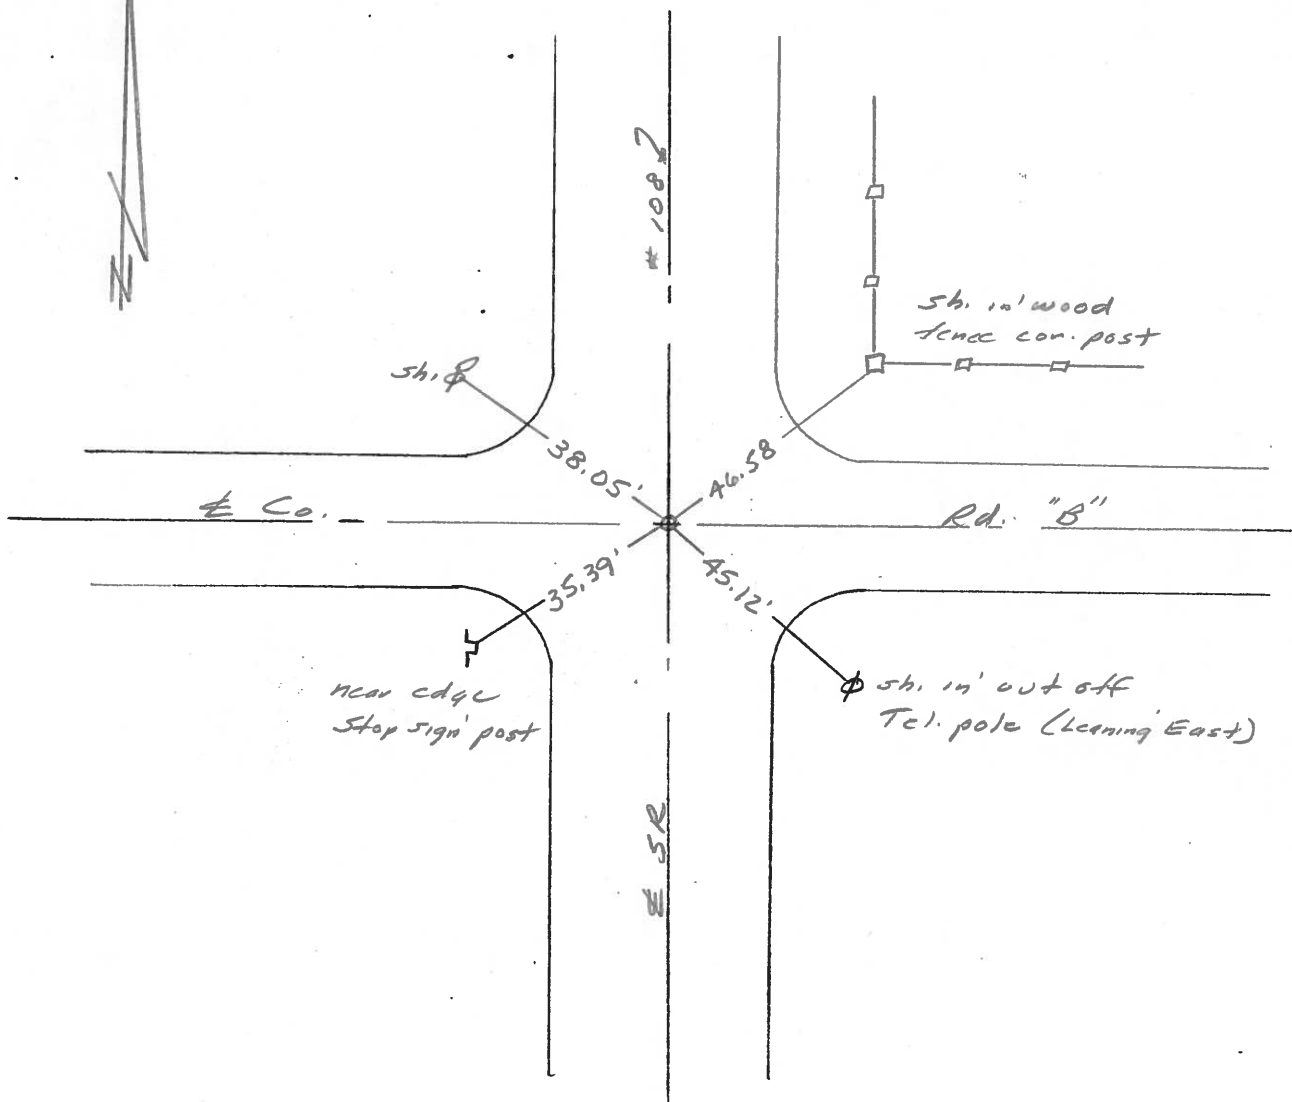

O.D.O.T. DISTRICT 2 SURVEY OFFICE

SHEET 3 OF

County Fulton S.R. 108

Date 29 Sept. 80
OK-10-17-80-Bowers

Township Clinton

Weather Clear

Section 1-2-11-12

Temp. 74°

T_N, R_E

Personnel W. Stone

R. Michalak


P. Neuse

D. Curtis

2	1
11	12



REF. NO. 3

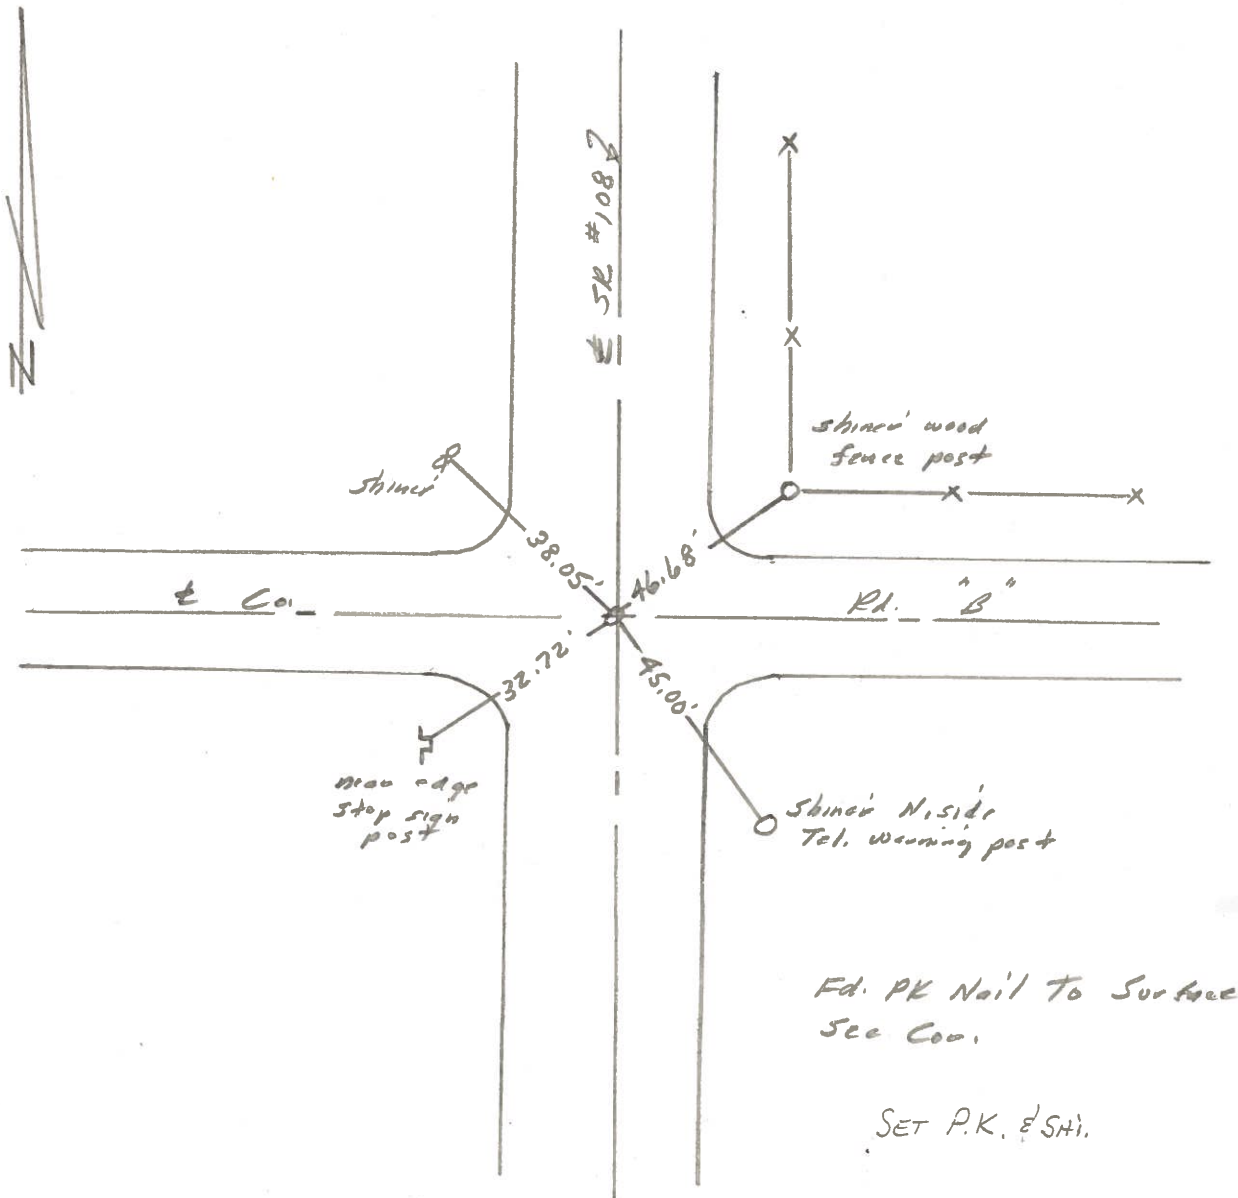

PERSONNEL TITLE PERSONNEL TITLE
 Tomsic _____
 Neuser _____
 Granata _____
 Vanyo _____

COUNTY Fulton DATE April 19, 1973
 S. R. 108 WEATHER _____
 SEC. _____ TEMP. _____

DESCRIPTION LEFT CENTER LINE RIGHT JOB NO.

