

O.D.O.T. DISTRICT 2 SURVEY OFFICE (USE ONLY)

PERSONNEL

REFERENCE NO. 4

SHEET 4 OF 17

NOTES AUBLE DATE 7/19/21
 H.C. NIESE WEATHER FAIR
 R.C. AUBLE TEMP. 73°

ROUTE SR 108
 COUNTY FULTON
 TOWNSHIP CLINTON
 SECTION 1

DWG BY WHITAKER PID 92361

T 6 N R 6 E

TYPE MONUMENT P.K./WASHER

ON SURFACE - ~~BELOW~~ ON

OFFSET 0.6' LT : ~~RT~~

- TO - EDGE PAVEMENT


STATION: 78+96

HORZ.DATUM: NAD83 (2011)


GEOID: 2012A

GRID: NORTHING: 674920.339

EASTING: 1520927.913

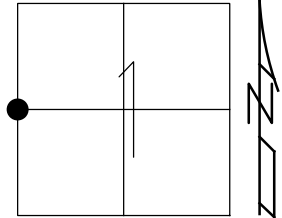

RECORD:
 FD P.K./WASHER
 7/14/00, KPM
 SET P.K./WASHER
 8/4/00, KPM
 FD P.K. NAIL
 REF4
 9/16/19, JFO
 SET MAG/WASHER
 REF4
 7/19/22, TDN

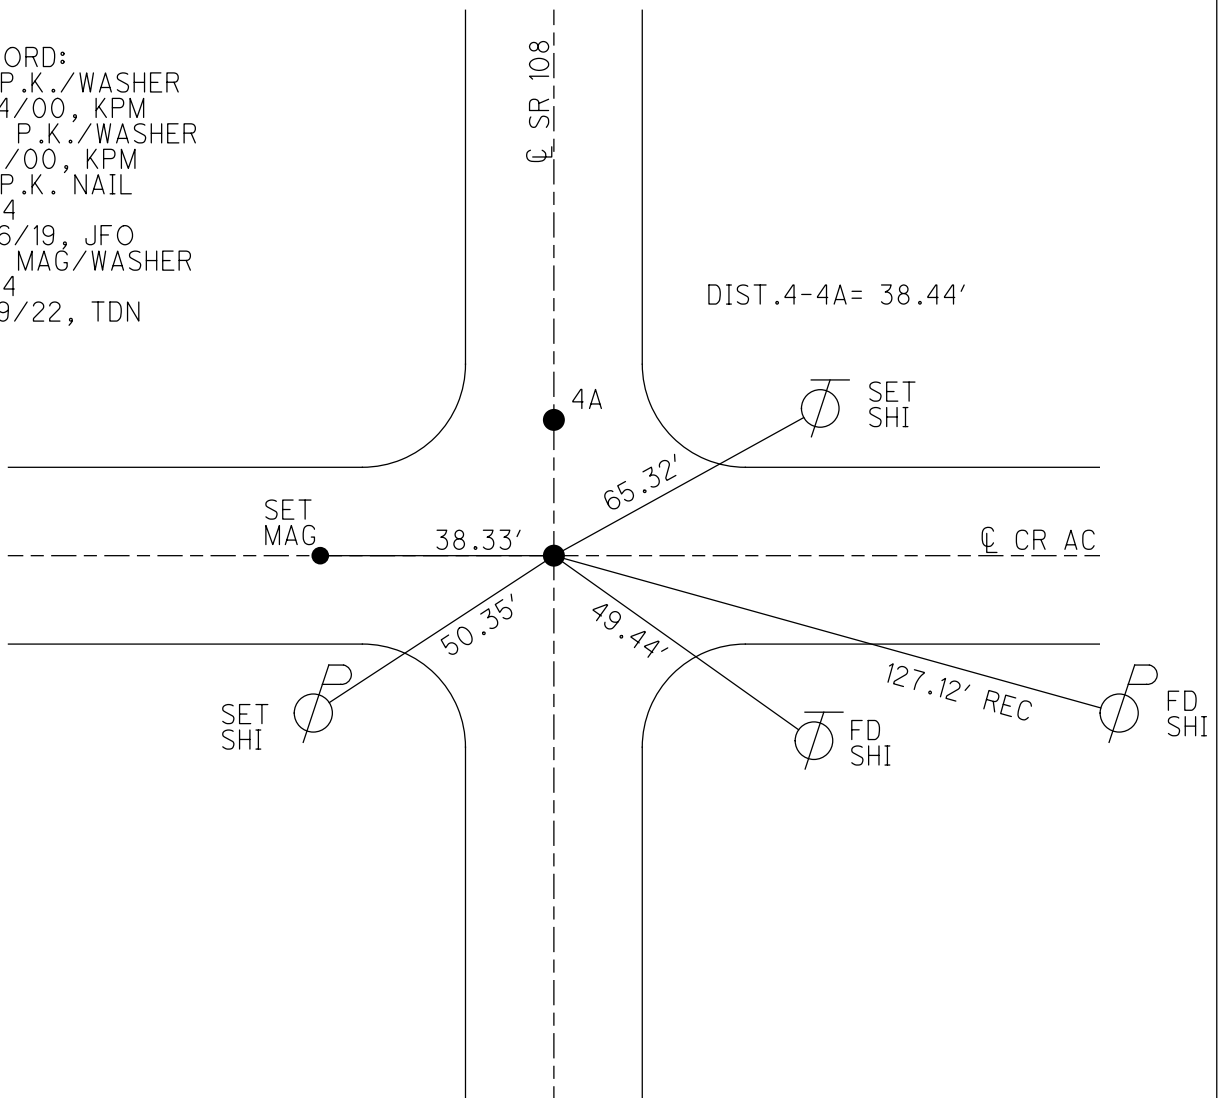

O.D.O.T. DISTRICT 2 SURVEY OFFICE (USE ONLY)

PERSONNEL _____

REFERENCE NO. 4

SHEET 4 OF 17

NOTES MOSE DATE 7/14/00
 H.C. BARNHISEL WEATHER FAIR
 R.C. CANTERBURY TEMP. 78°

ROUTE SR 108
 COUNTY FULTON
 TOWNSHIP CLINTON
 SECTION 1
 T 6 N R 6 E

DWG BY NIESE PID _____

TYPE MONUMENT P.K./WASHER

ON SURFACE - ~~BELOW~~ ON


OFFSET 0.6' LT : ~~RT~~

- TO - EDGE PAVEMENT

STATION: 78+96


HORIZ.DATUM: _____ GEOID: _____

GRID: NORTHING: _____ EASTING: _____

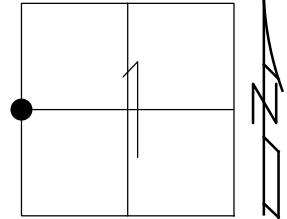

RECORD:
 FD P.K./WASHER
 7/14/00, KPM
 SET P.K./WASHER
 8/4/00, KPM

DIST. 4-4A = 38.22'

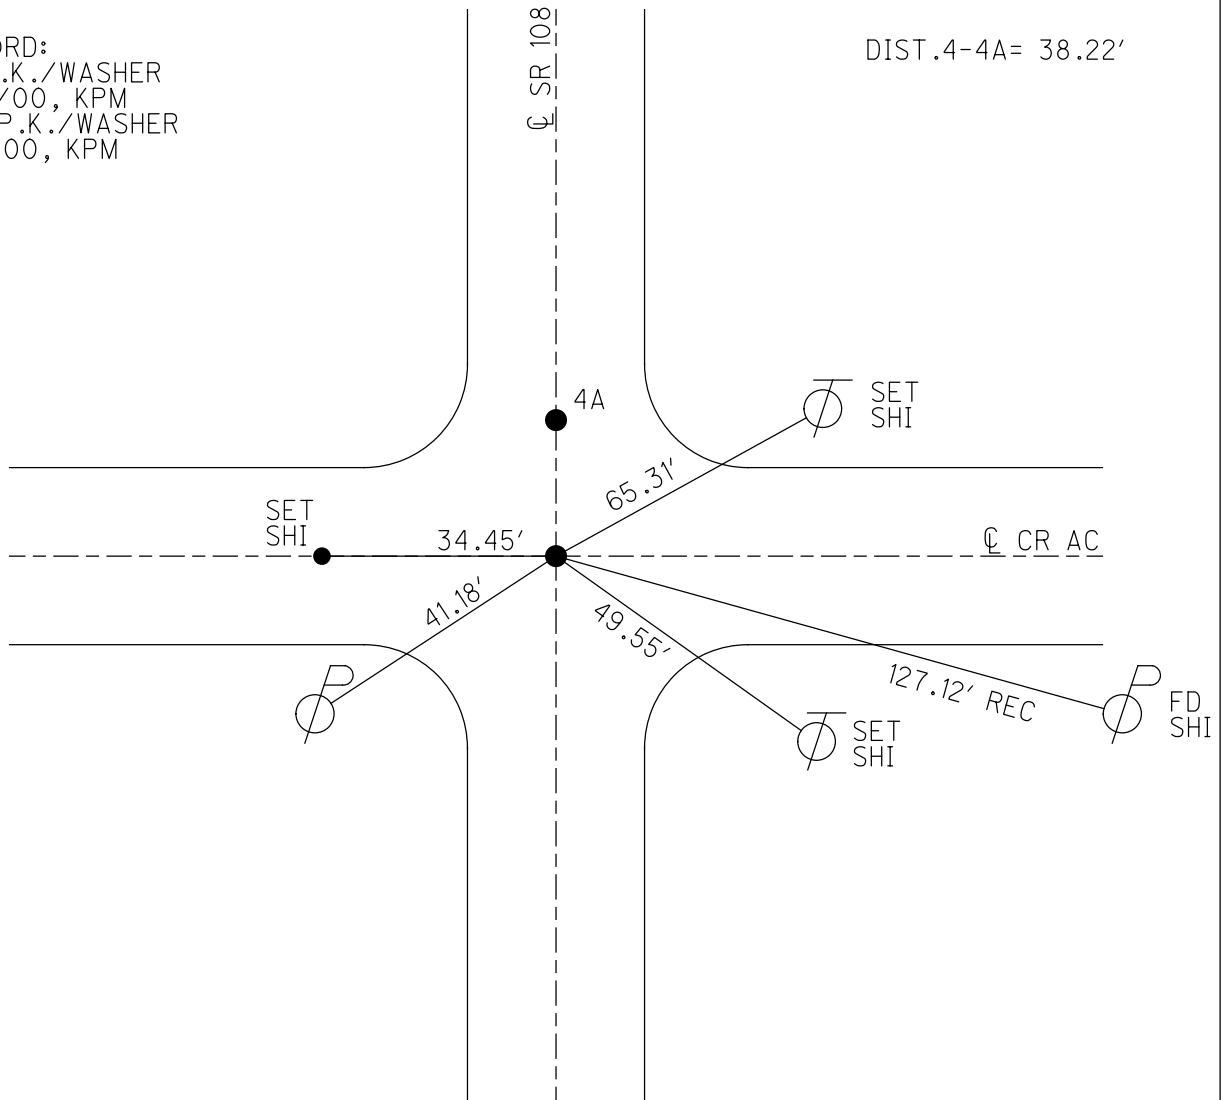

O.D.O.T. DISTRICT 2 SURVEY OFFICE

PERSONNEL

REFERENCE NO. 4

SHEET 4 OF 10

NOTES Moser

H.C. Barnhisel

R.C. Canterbury

DATE 7-14-00

WEATHER Fair

TEMP. +78°F

ROUTE Sr-108



COUNTY Fulton

TOWNSHIP Clinton

SECTION 1

T. 6 N. R. 6 E.

TYPE MONUMENT (A) PK/W (B) - PK/W
ON SURFACE - BELOW (A)-(B) - Surface
 LEFT - ☉ PAV'T. - RIGHT (A) - .6'± (B) - ☉
TO EDGE PAVEMENT
 S.L.M. (A) 78+96 (B) 79+34

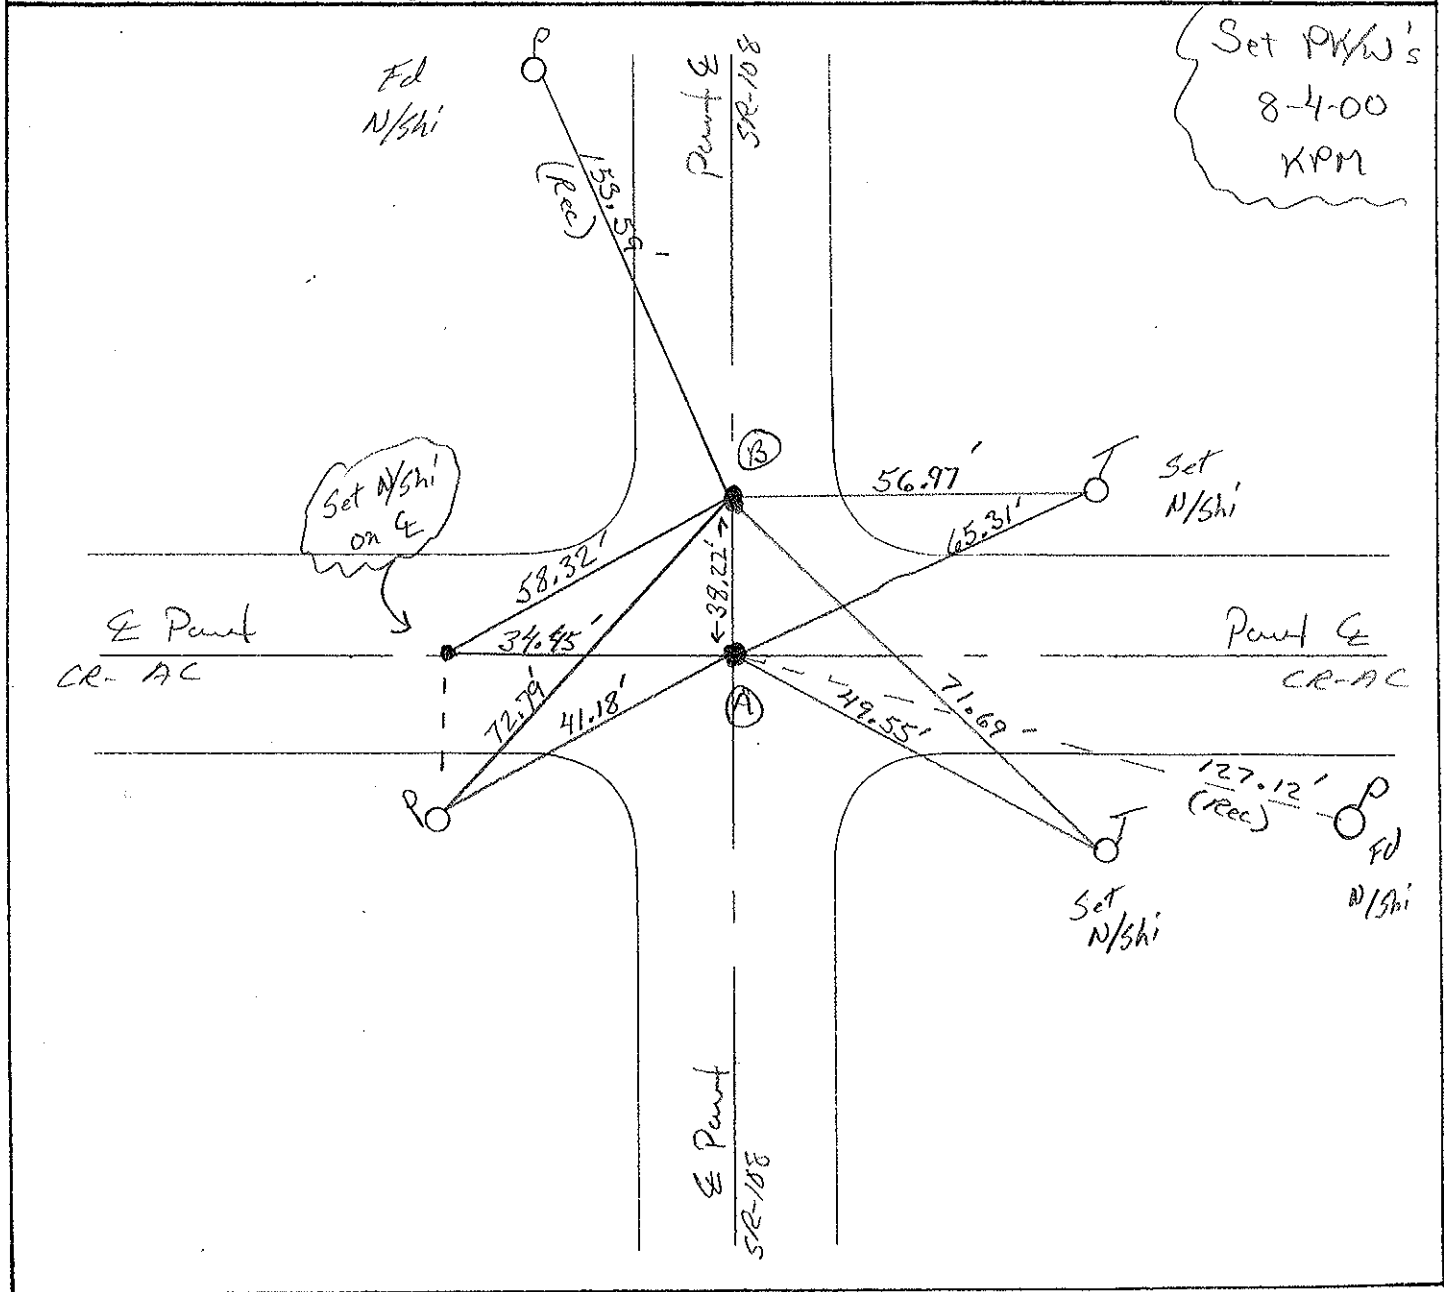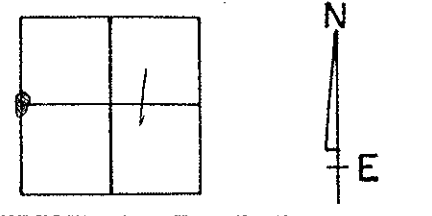

O.D.O.T. DISTRICT 2 SURVEY OFFICE

PERSONNEL _____

REFERENCE NO. 4

SHEET 4 OF _____

NOTES 1. Stone

H.C. D. Curtis

DATE 19 Oct. 88

ROUTE SR#108

R.C. T. Householder

WEATHER Cool

COUNTY Fulton

TEMP. 49.0

TOWNSHIP Clinton

SECTION 1

T _____ R _____


TYPE MONUMENT ⊙ = PK Nail

ON SURFACE - BELOW Bath - Surface


LEFT - ⊙ PAV'T. - RIGHT _____

TO _____ EDGE PAVEMENT

S.L.M. A = 78+66 - B = 79+04.5

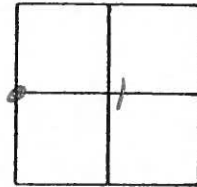

OK 6/7/89 IRS

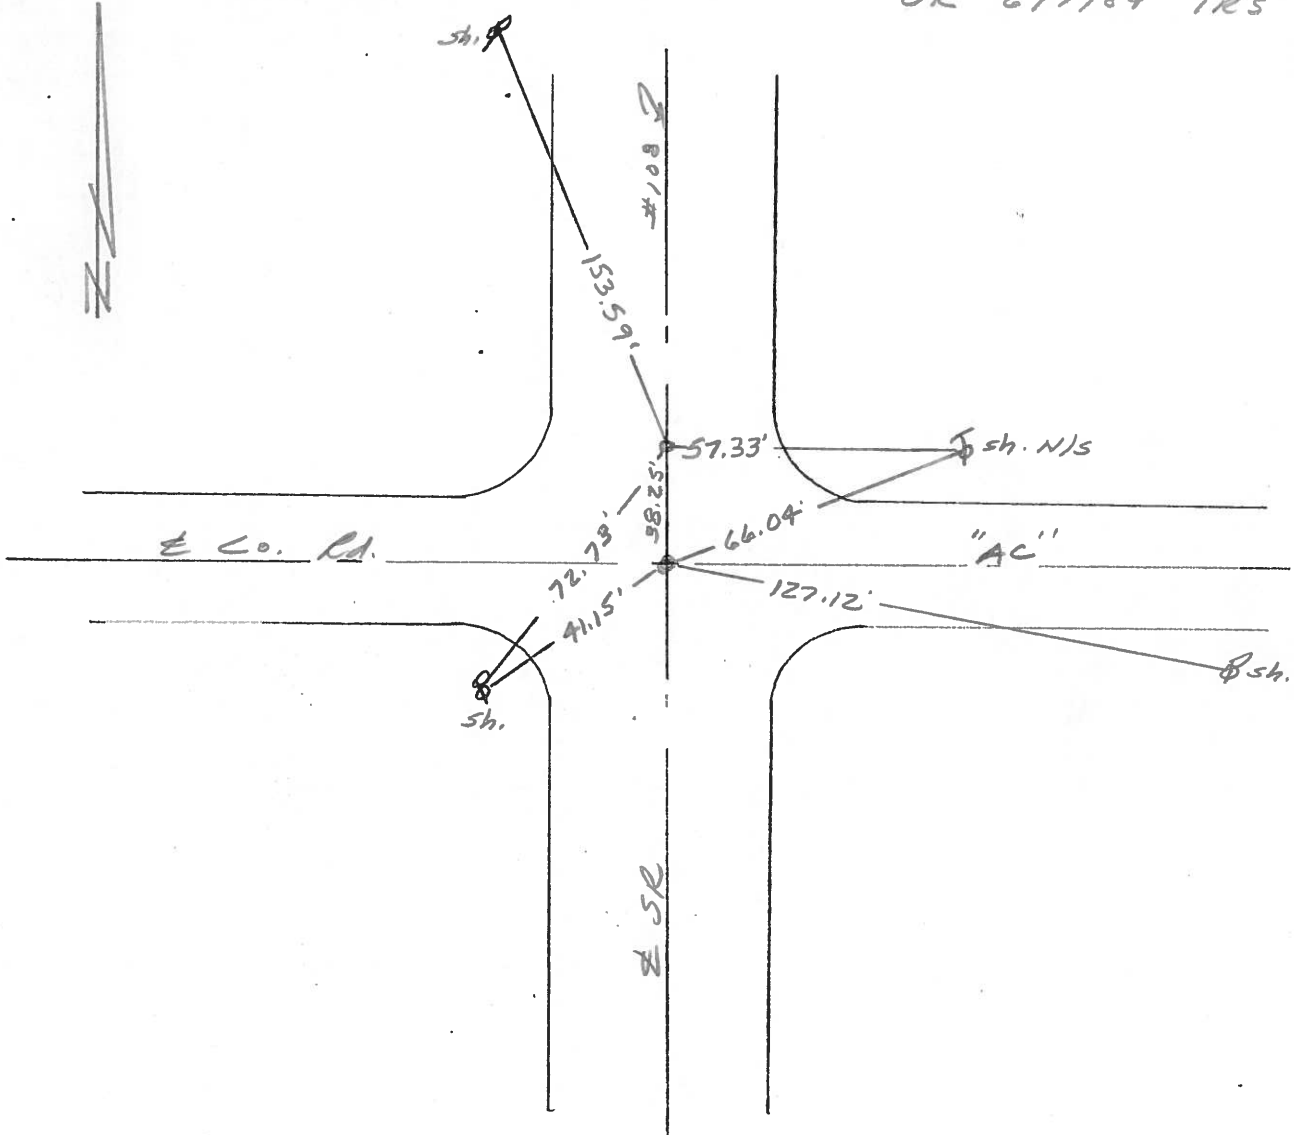

County Fulton S.R. 108

Date 29 Sept. 80
OK-10-17-80-Bowers

Township Clinton

Weather Fair

Section 1

Temp. 74°


T N, R E

Personnel I. Stone


P. Neuser

R. Michalek

D. Curtis

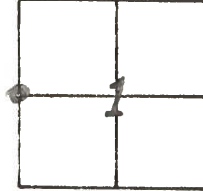

REF. NO. 4

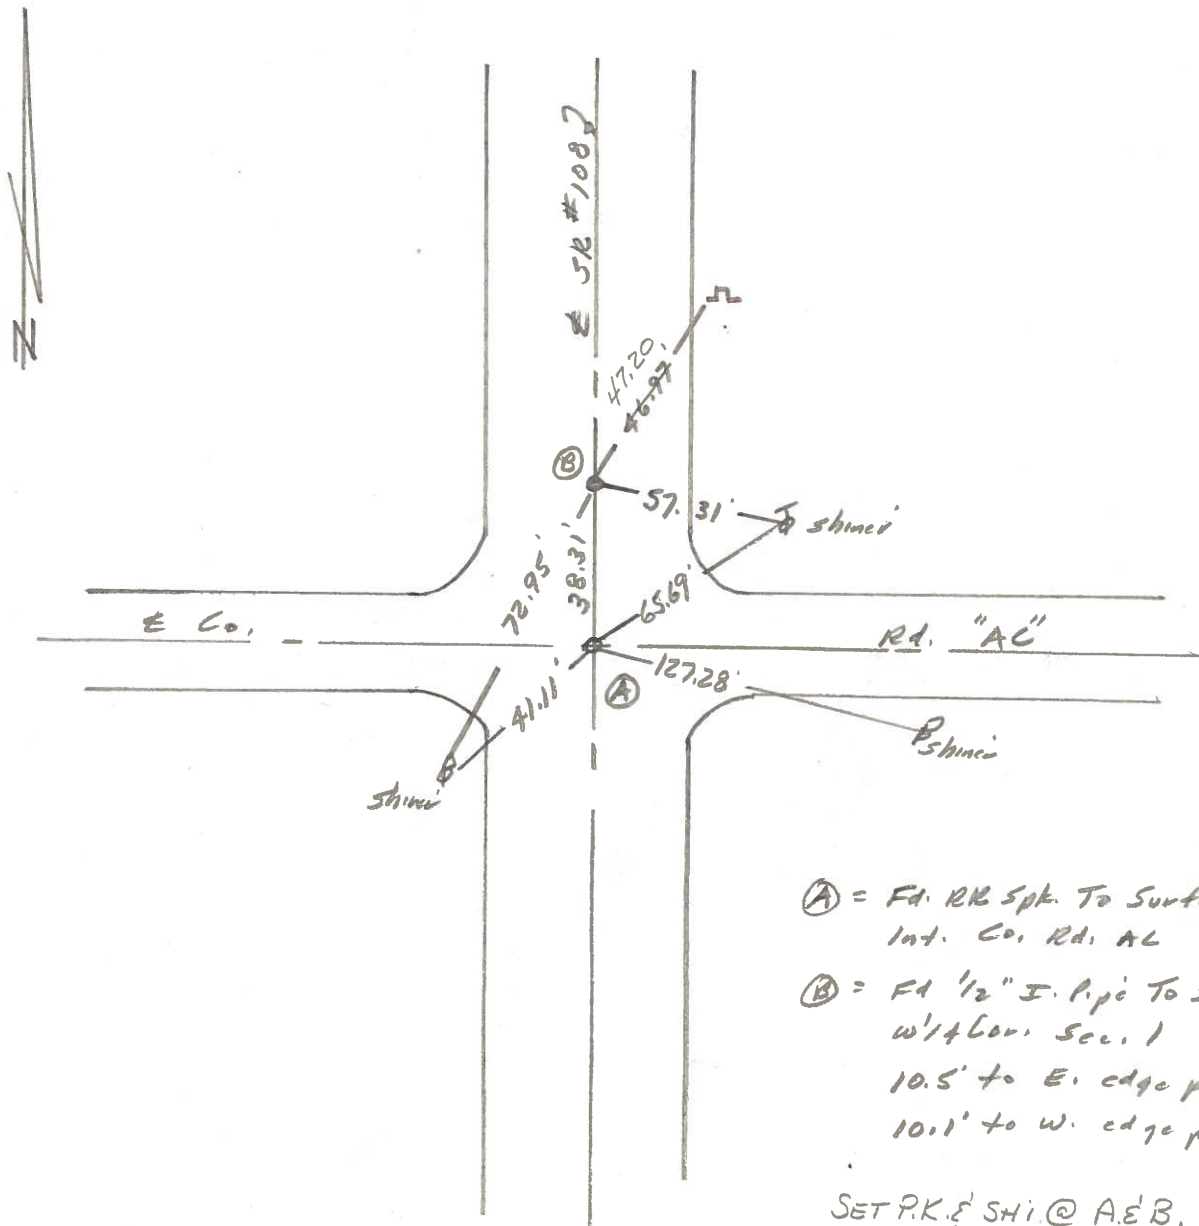


- Ⓐ = Fd. RR Spk. To Surface Int. Co. Rd. AC
- Ⓑ = Fd. 1/2" I. Pipe To Surface w/4 Cor. Sec. 1
10.5' to E. edge put.
10.1' to W. edge put.

SET P.K. & SHI. @ A & B.

| PERSONNEL | TITLE | PERSONNEL | TITLE |
|-----------|-------|-----------|-------|
| Tomsic | | | |
| Neuser | | | |
| Granata | | | |
| Jay | | | |

COUNTY Fulton DATE April 20, 1973
 S. R. 108 WEATHER _____
 SEC. _____ TEMP. _____

DESCRIPTION _____ LEFT _____ CENTER LINE _____ RIGHT _____ JOB NO. _____

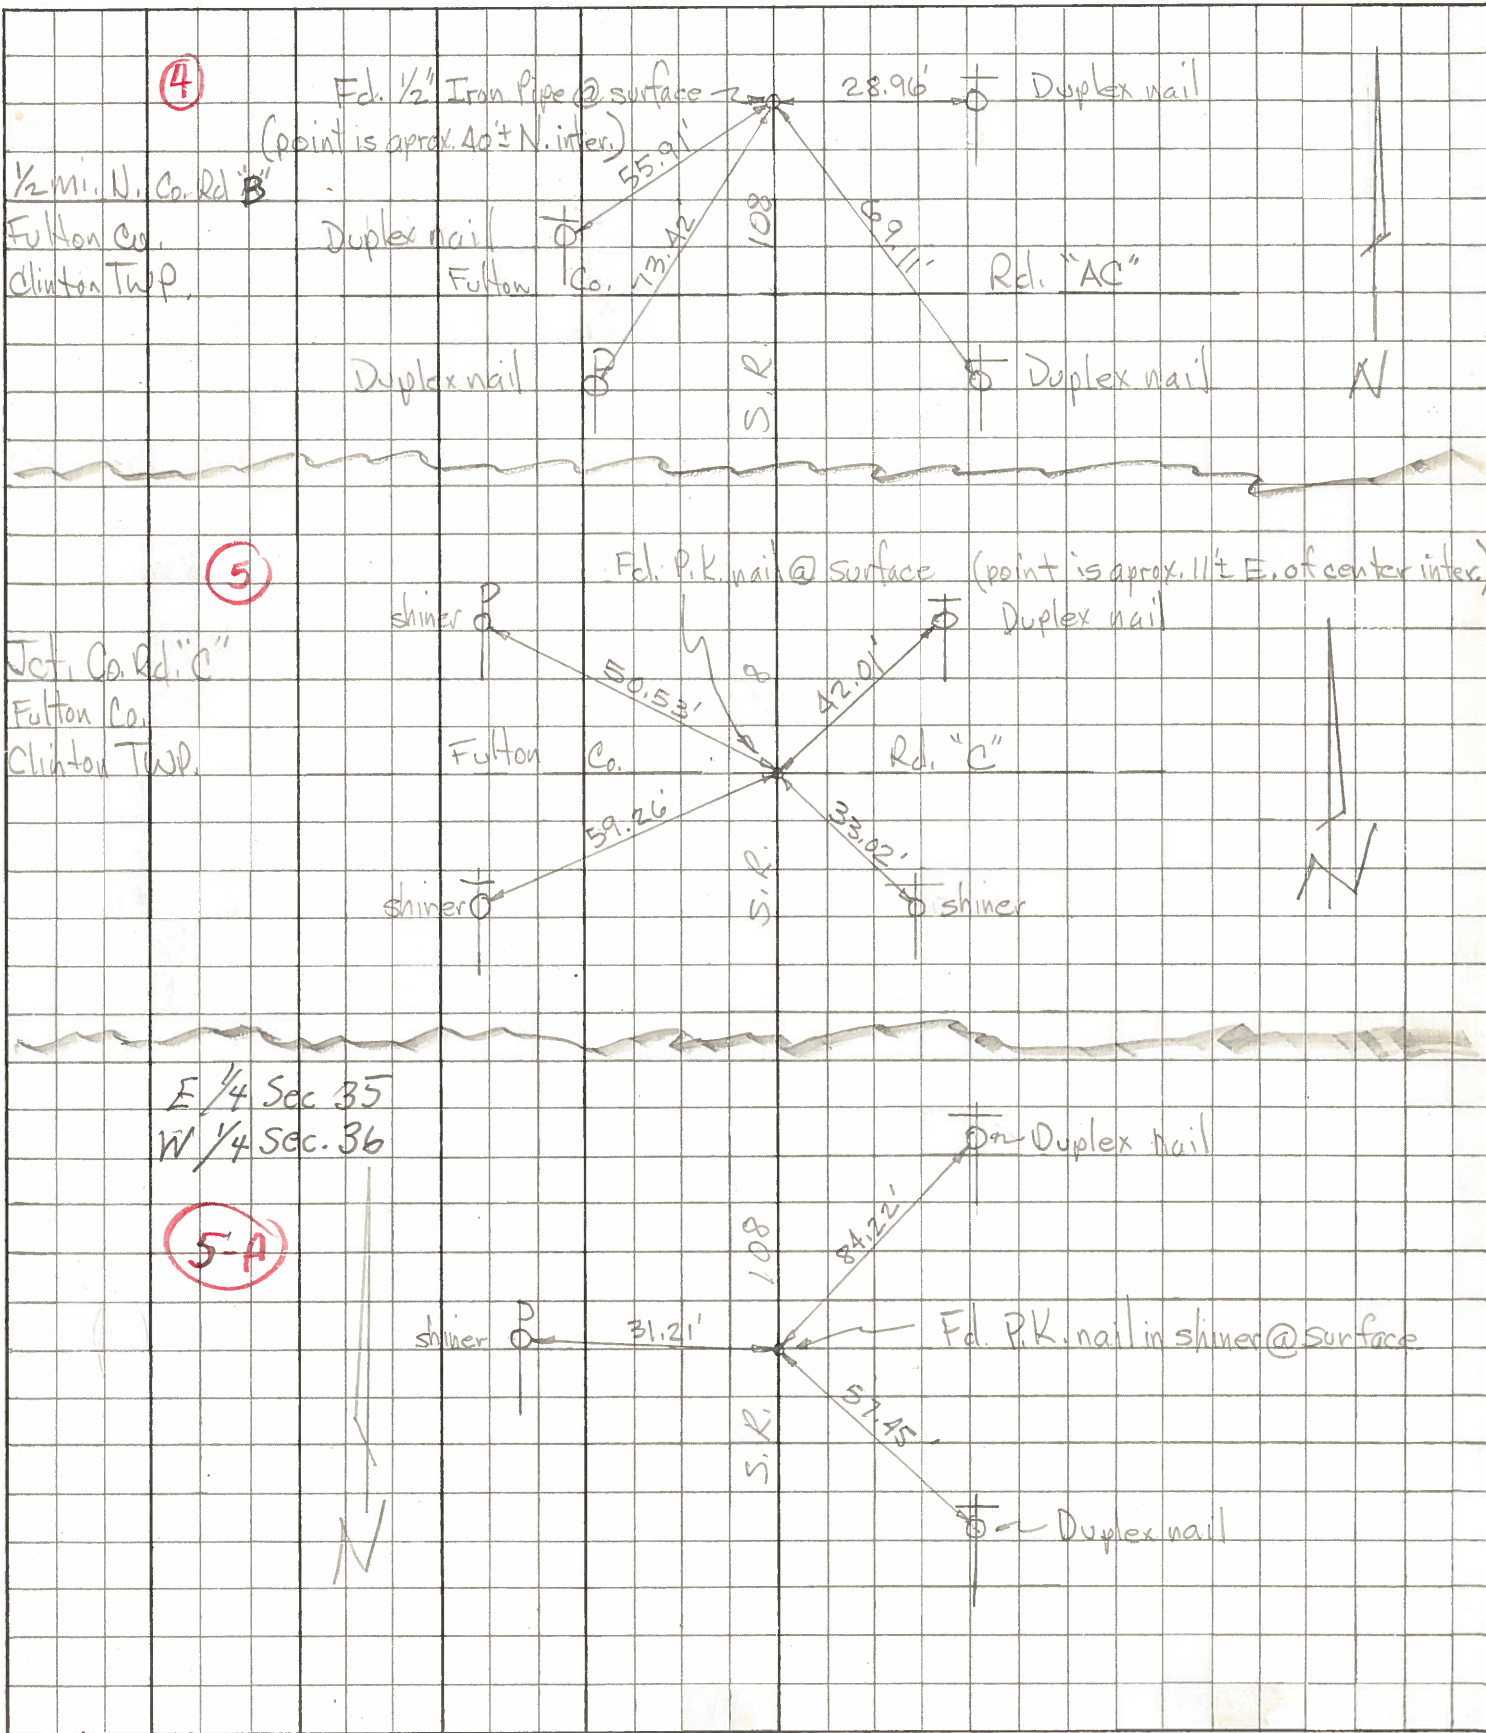


| PERSONNEL | TITLE | PERSONNEL | TITLE | COUNTY | DATE |
|-----------|-------|-----------|-------|------------------------------|---------------|
| Red Beach | | | | Fulton | 18 May 1970 |
| Newcomb | | | | S. R. 108 | WEATHER _____ |
| Knape | | | | SEC. Clinton Twp T-6-N R-6-E | TEMP. _____ |
| Wise | | | | | |

DESCRIPTION CONTROL POINTS JOB NO. _____

LEFT CENTER LINE 1. Pin RIGHT 1. Pin

E Co Rd "C" → Sec. 35 Sec. 2 23.58' Sec. 36 Sec. 1

4-5

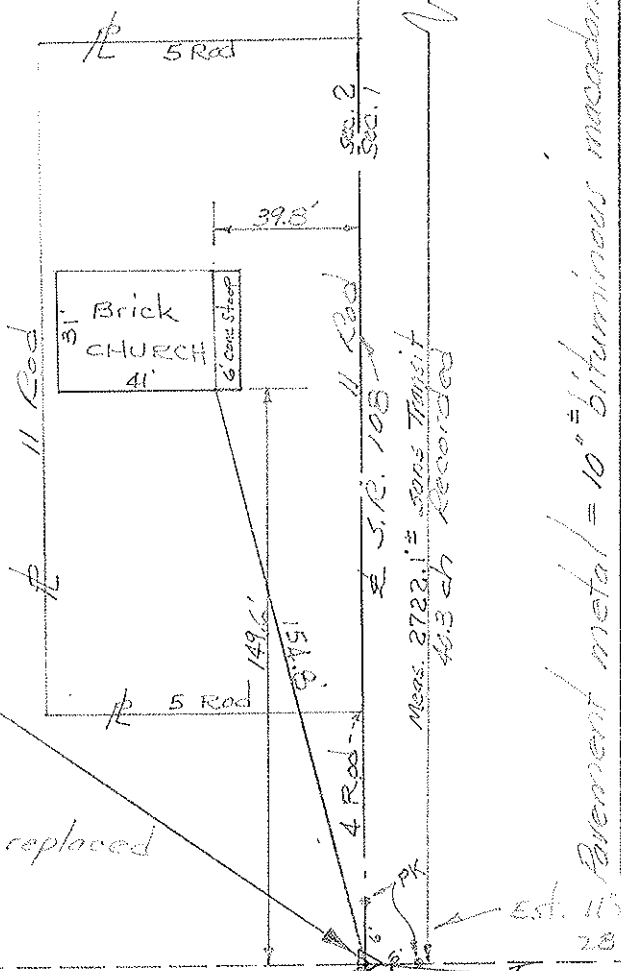

Found Stone with brick
 35 1/4" below pav't. surface.
 Stone is 21' west of ctr.
 of 20' Bit. Mac. pav't.
 Found 10"x1" pipe inside
 a 26"x1 1/2" pipe over stone.
 26" pipe 3 1/2" below surface.
 Removed 10"x1" pipe and replaced
 with a 30"x1" pipe.

E-W 1/2 Sec. Line 7

Est. 11"x1" pipe on resurface
 28 Aug 70

55.52' Dup. NW/S
 73.42' Dup. SE 1/2 AP
 42.1' Dup. W/S
 28.75' Dup. S/S

E Ridge Rd. AC 7

Block Foundation
 Frame Residence

SEC 2 Clinton Twp
 SEC 1 Clinton Twp