

O.D.O.T. DISTRICT 2 SURVEY OFFICE (USE ONLY)

PERSONNEL _____

REFERENCE NO. 5

SHEET 7 OF 17

NOTES AUBLE

DATE 7/19/21

ROUTE SR 108

H.C. NIESE

WEATHER FAIR

COUNTY FULTON

R.C. AUBLE

TEMP. 69°

TOWNSHIP CLINTON

SECTION 1

DWG BY WHITAKER PID 92361

T 6 N R 6 E

TYPE MONUMENT P.K./WASHER

ON SURFACE - ~~BELOW~~ ON

OFFSET ☉ PAVEMENT ON LT : RT

- TO - EDGE PAVEMENT


STATION: 106+68

HORIZ.DATUM: NAD83 (2011)


GEOID: 2012A

GRID: NORTHING: 677680.128

EASTING: 1520979.077

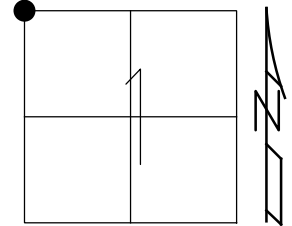

RECORD:
 FD P.K./WASHER
 7/14/00, KPM
 SET P.K./WASHER
 8/4/00, KPM
 FD P.K. SHANK
 REFAA5
 9/16/19, JFO
 SET MAG/WASHER
 7/19/22, TDN

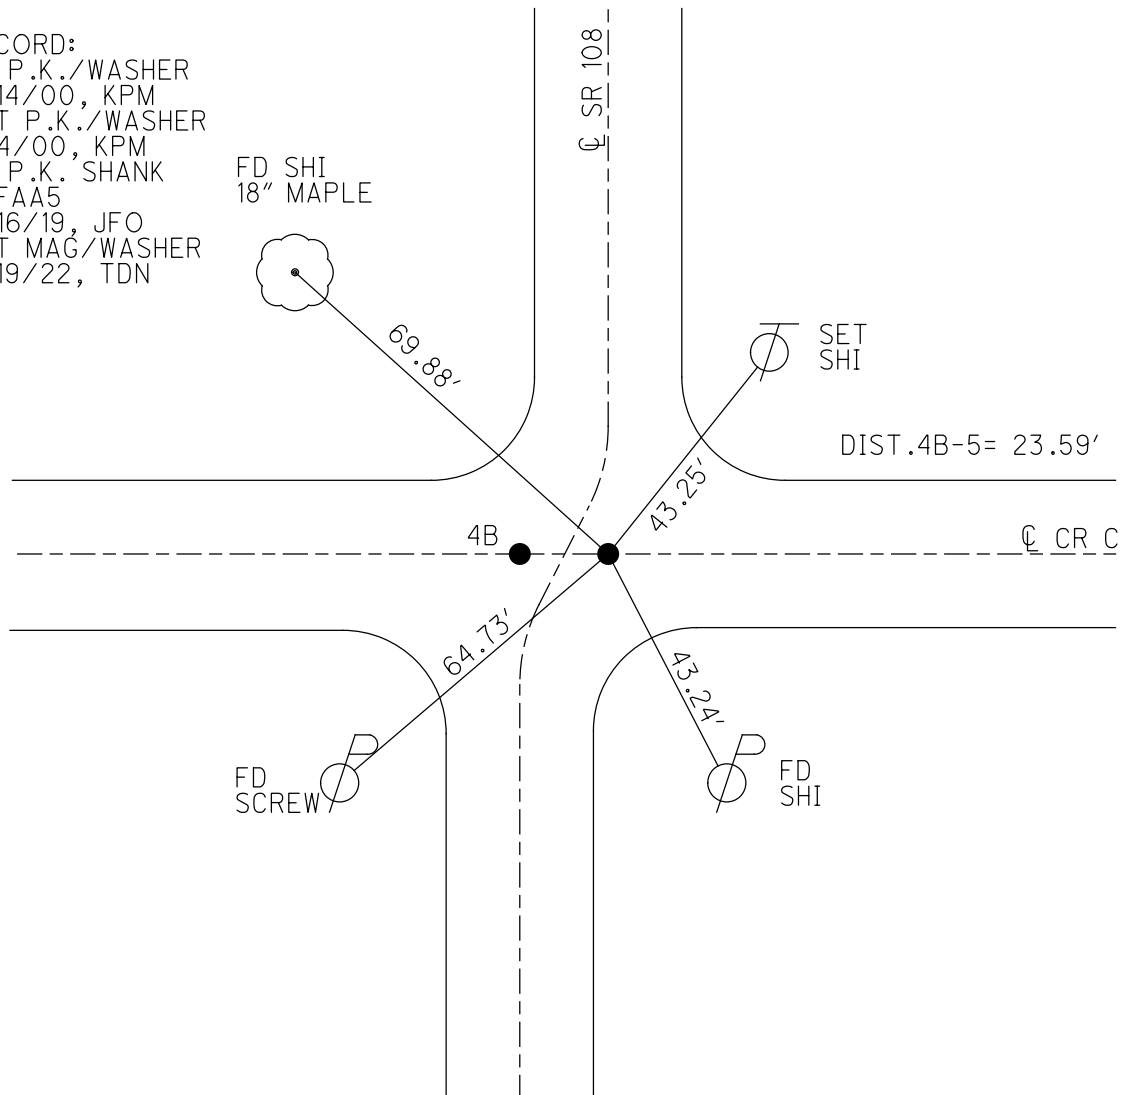

O.D.O.T. DISTRICT 2 SURVEY OFFICE (USE ONLY)

PERSONNEL _____ REFERENCE NO. 5 SHEET 7 OF 17
 NOTES MOSE DATE 7/14/00 ROUTE SR 108
 H.C. BARNHISEL WEATHER FAIR COUNTY FULTON
 R.C. CANTERBURY TEMP. 78° TOWNSHIP CLINTON
 SECTION 1
 DWG BY NIESE PID _____ T 6 N R 6 E

TYPE MONUMENT P.K./WASHER

ON SURFACE - ~~BELOW~~ ON


OFFSET Q PAVEMENT ON LT : RT

- TO - EDGE PAVEMENT

STATION: 106+68


HORIZ.DATUM: _____ GEOID: _____

GRID: NORTHING: _____ EASTING: _____

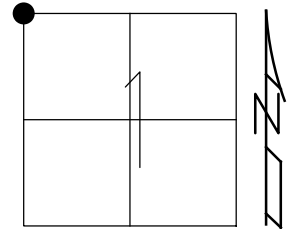

RECORD:
 FD P.K./WASHER
 7/14/00, KPM
 SET P.K./WASHER
 8/4/00, KPM

DIST.4B-5= 23.59'

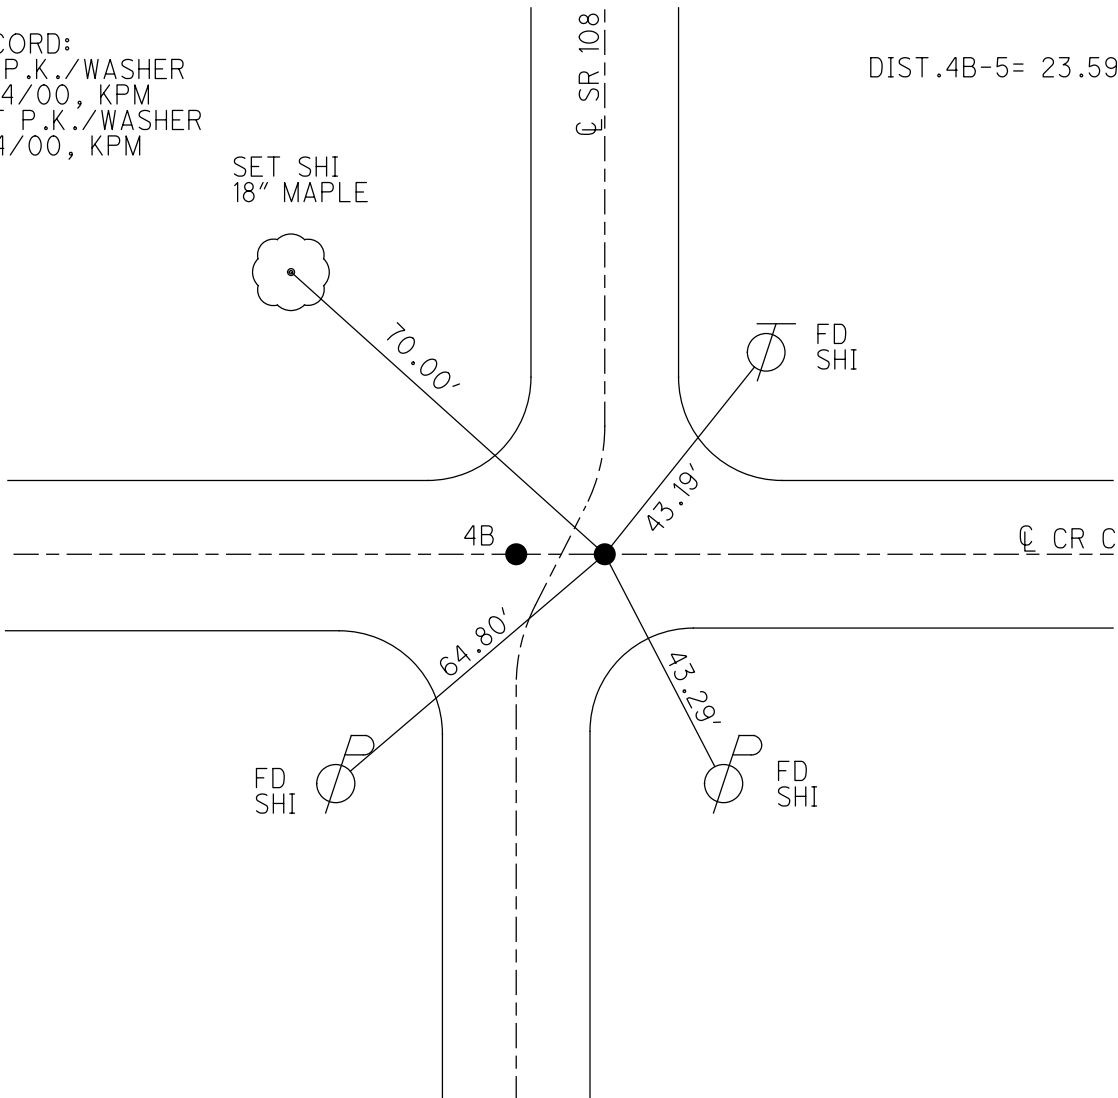

O.D.O.T. DISTRICT 2 SURVEY OFFICE

PERSONNEL _____

REFERENCE NO. 5

SHEET 5 OF 10

NOTES Mosen

H.C. Barnhisel

R.C. Canterbury

DATE 7-14-00

WEATHER Fair

TEMP. +78°F

ROUTE SR-108

COUNTY Fulton

TOWNSHIP Clinton

SECTION _____

T 7 N R 6 E

TYPE MONUMENT (A)(B) PK/w's

ON SURFACE - ~~BENCH~~ surface

~~LEFT - E PAV'T - RIGHT~~ on E's


TO - EDGE PAVEMENT

S.L.M. (A) - 106+68 (B) - 106+68

35	36
2	1



Set PK Washer 8-400 KPM

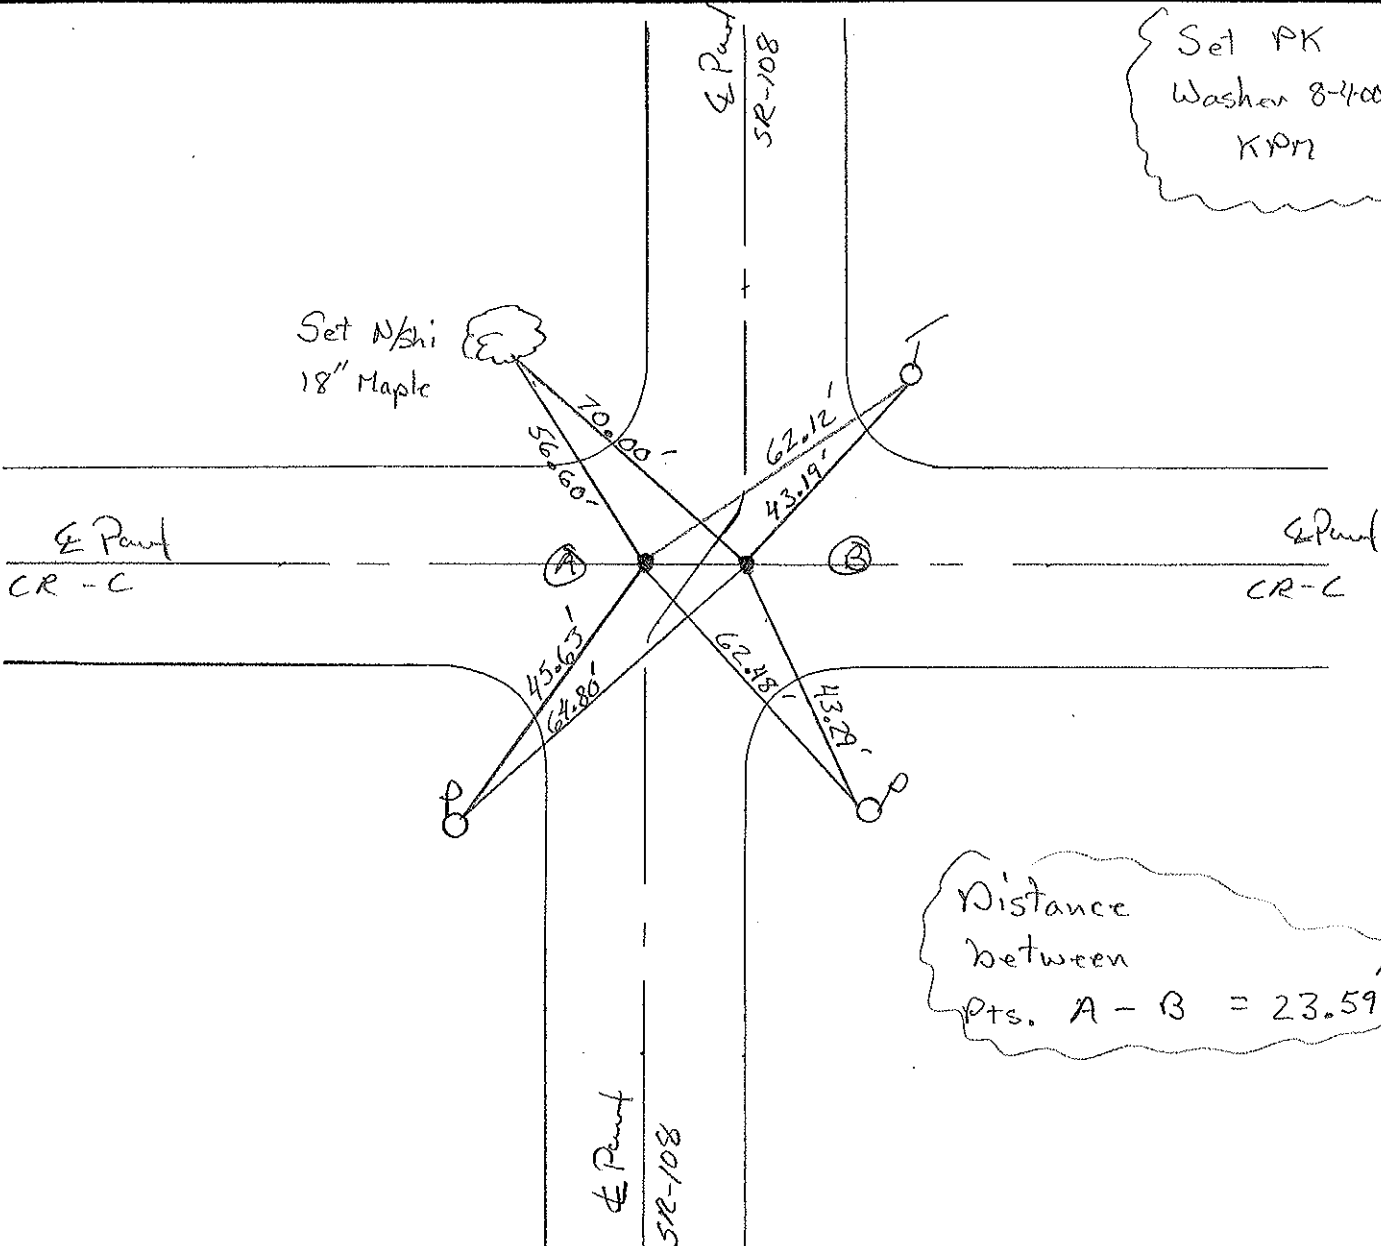

O.D.O.T. DISTRICT 2 SURVEY OFFICE

PERSONNEL _____

REFERENCE NO. 5

SHEET 5 OF _____

NOTES 1. Stone

H.C. D. Lurdis

R.C. J. Hauscholder

DATE 19 Oct. 88

WEATHER Cool

TEMP. 50°

ROUTE SR #108

COUNTY Fulton

TOWNSHIP Clinton

SECTION 1-2-35-36

T _____ R _____

TYPE MONUMENT A = PK Nail
B = PK Nail

ON SURFACE - BELOW Surface

LEFT - \odot PAV'T. - RIGHT _____


_____ TO _____ EDGE PAVEMENT

S.L.M. A = 106+27 B = 106+27

35	36
2	1



OK 6/7/89 IRS

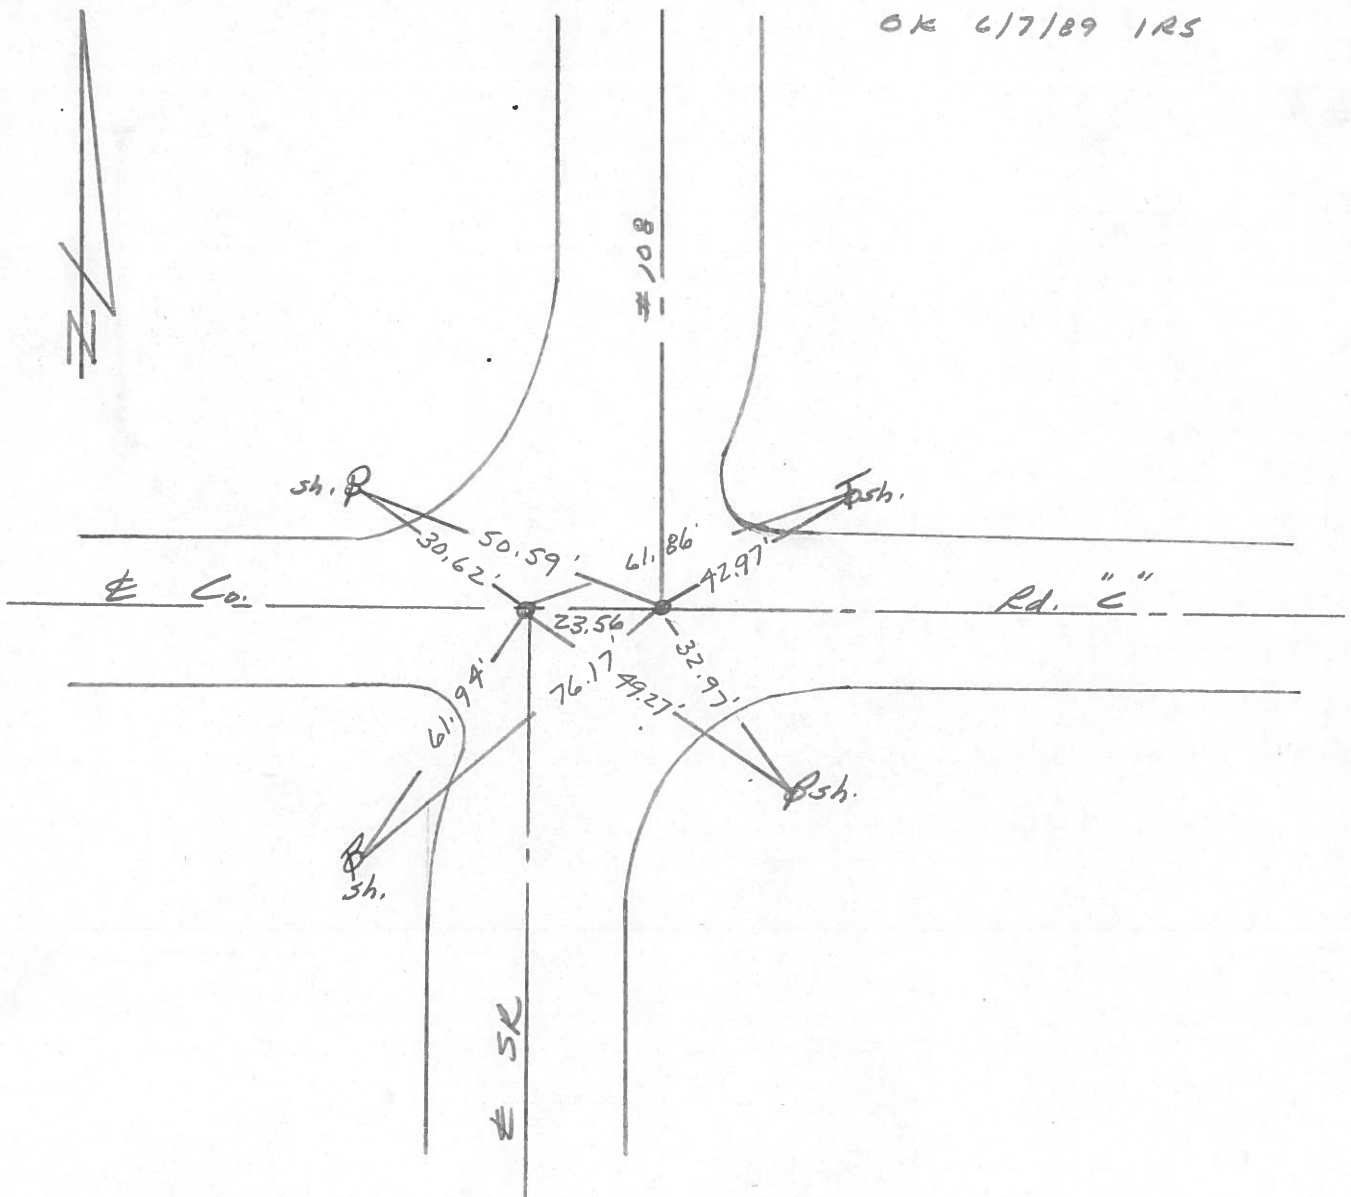

O.D.O.T. DISTRICT 2 SURVEY OFFICE

SHEET 5 OF

OK-10-23-80-BOWERS

County Fulton S.R. 108

Date 30 Sept. 80

Township Clinton


Weather Clear

Section 1-2-35-36

Temp. 65°


T N, R E

Personnel I. Stone

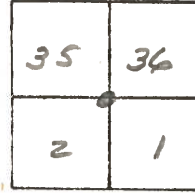

P. Neuse
D. Curtis

REF. NO. 5

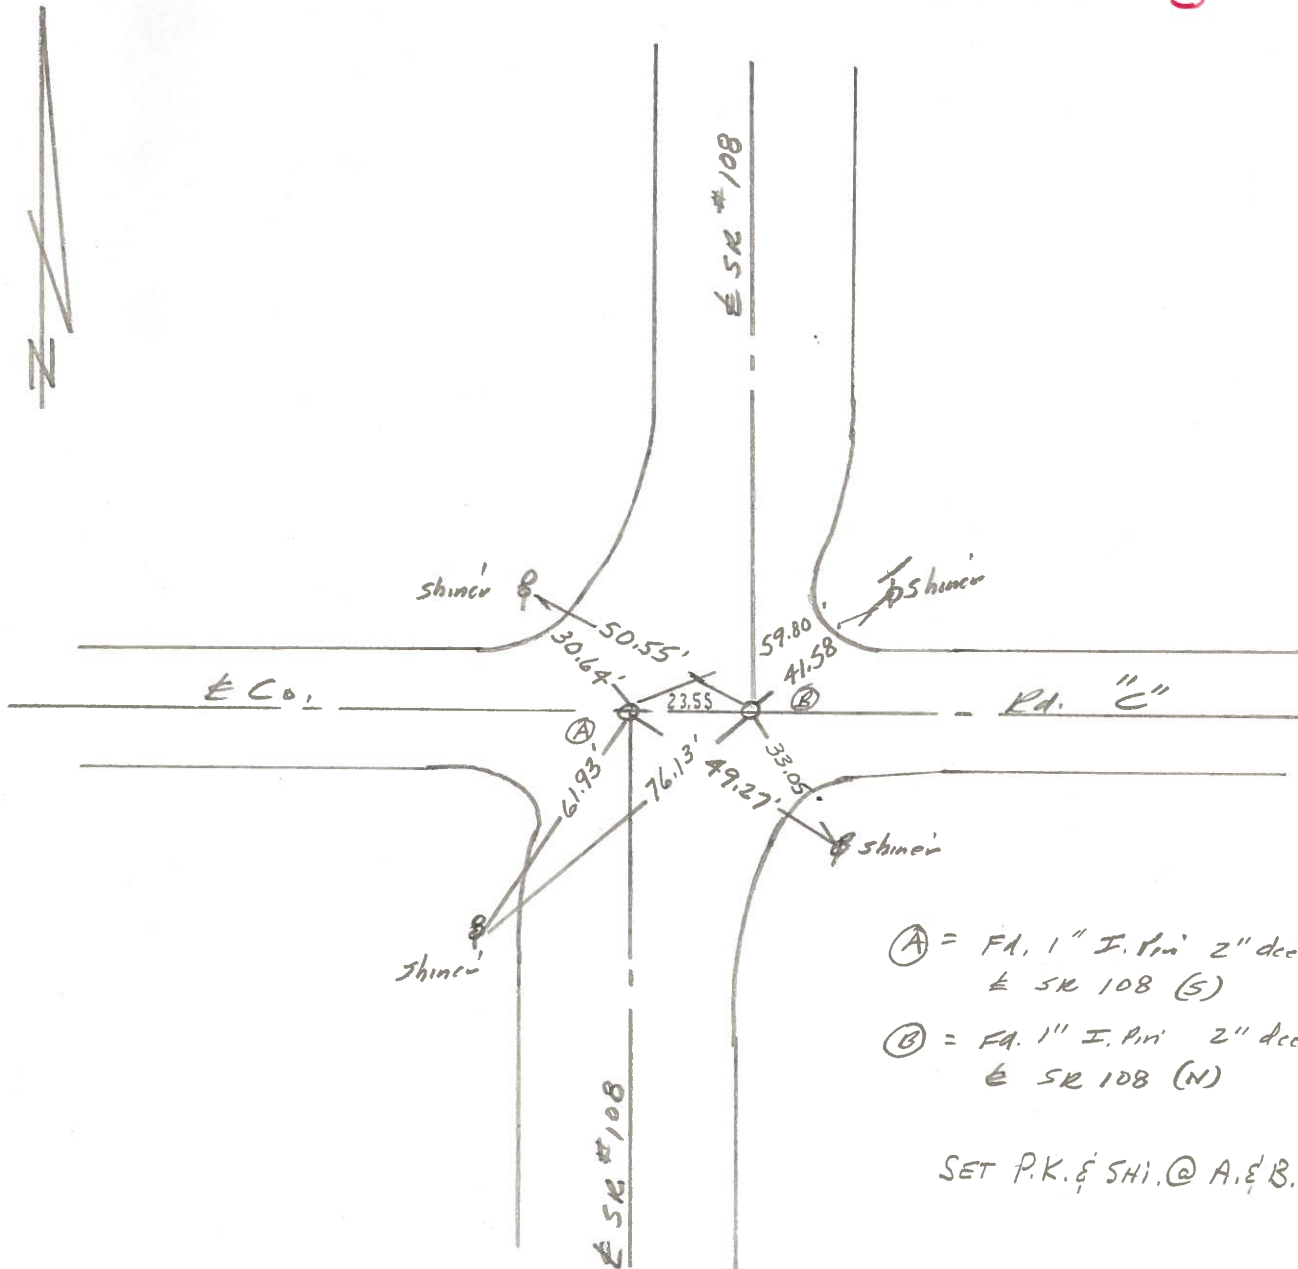


- Ⓐ = FA. 1" I. Pin 2" deep =
 € SR 108 (S)
- Ⓑ = FA. 1" I. Pin 2" deep =
 € SR 108 (N)

SET P.K. & SHI. @ A. & B.


PERSONNEL	TITLE	PERSONNEL	TITLE
Tomsic			
Newsler			
Granata			
Van yo			

COUNTY Fulton DATE April 20, 1978
 S. R. 108 WEATHER
 SEC. TEMP.

DESCRIPTION LEFT CENTER LINE RIGHT JOB NO.

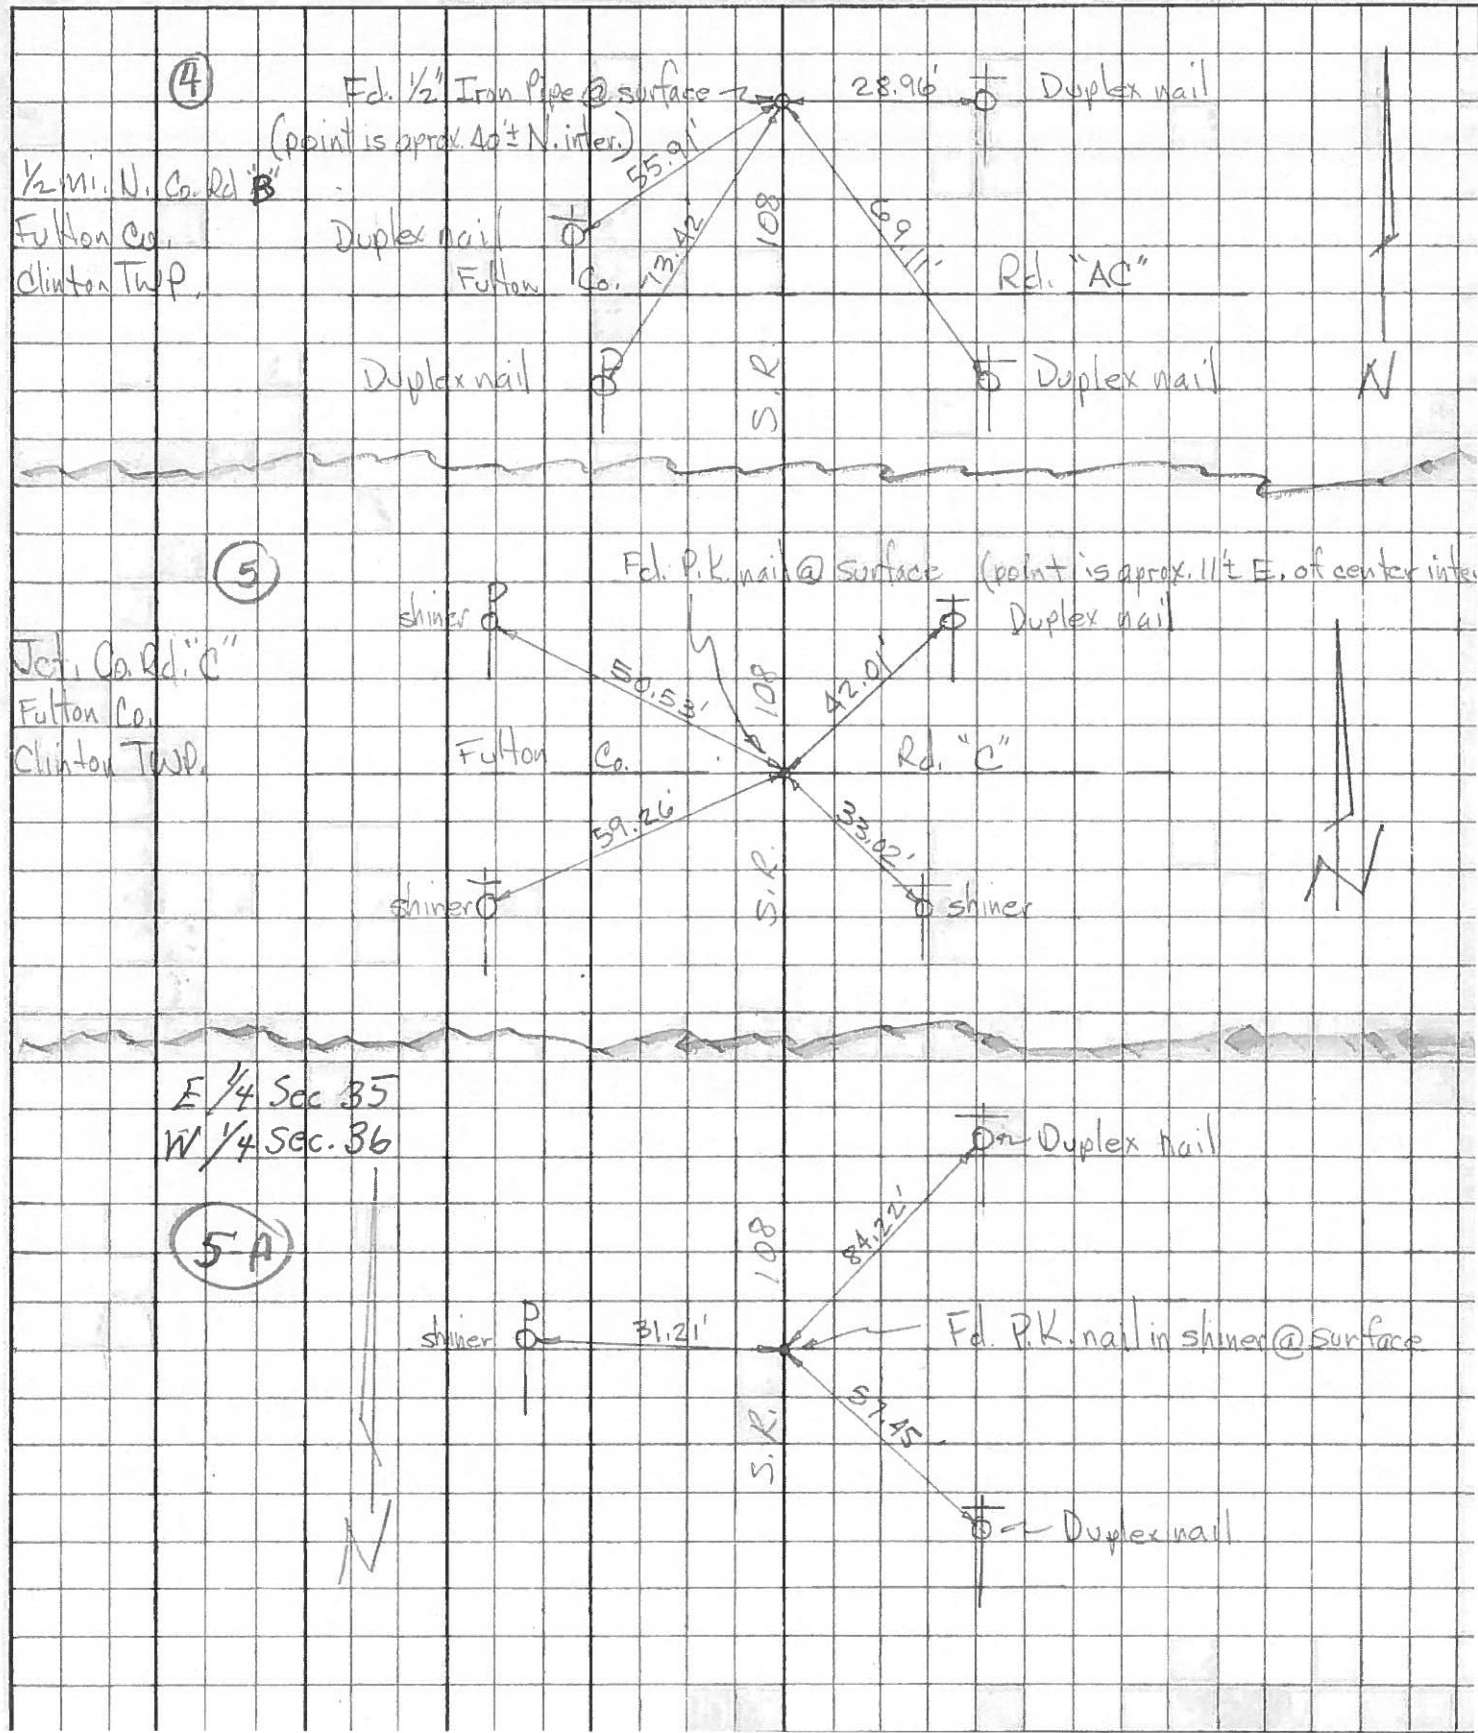

①

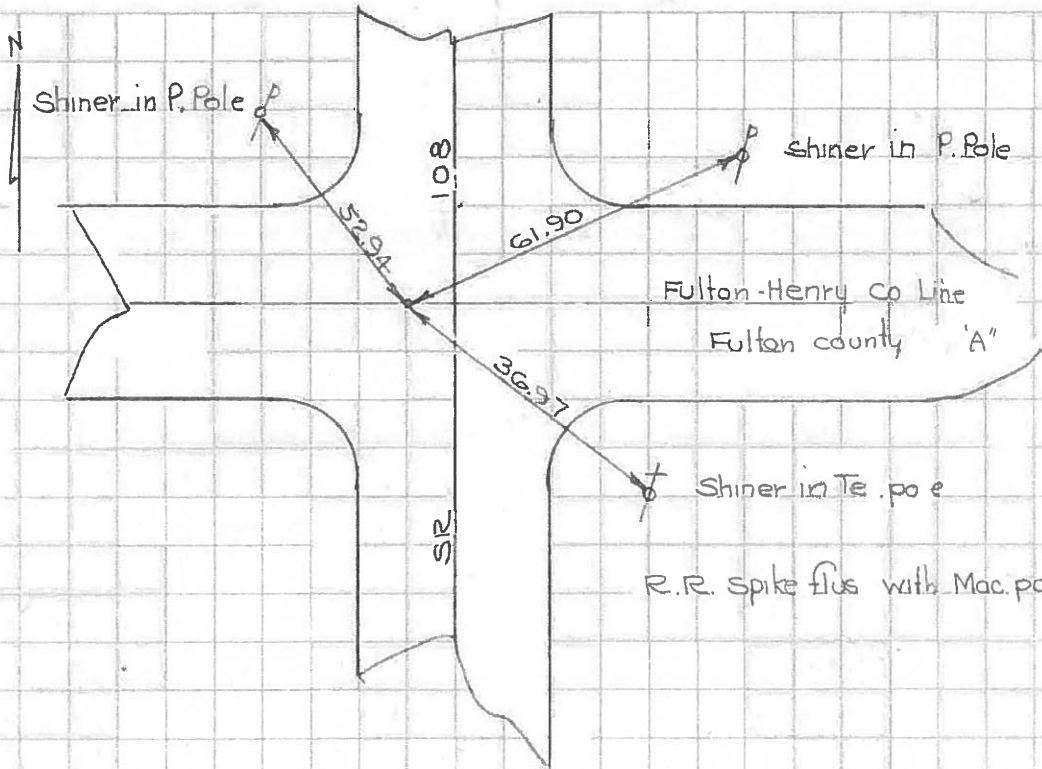

⑤

