

O.D.O.T. DISTRICT 2 SURVEY OFFICE (USE ONLY)

PERSONNEL

REFERENCE NO. 6

SHEET 9 OF 17

NOTES RHOADES

DATE 7/14/21

ROUTE SR 108

H.C. NIESE

WEATHER HUMID

COUNTY FULTON

R.C. AUBLE

TEMP. 81°

TOWNSHIP CLINTON

SECTION 36

DWG BY WHITAKER

PID 92361

T 7 N R 6 E

TYPE MONUMENT P.K. SHANK

ON SURFACE - ~~BELOW~~ ON

OFFSET 0.9' LT : ~~RT~~

- TO - EDGE PAVEMENT



STATION: 159+85

HORZ.DATUM: NAD83 (2011)

GEOID: 2012A

GRID: NORTHING: 682975.881

EASTING: 1521066.736

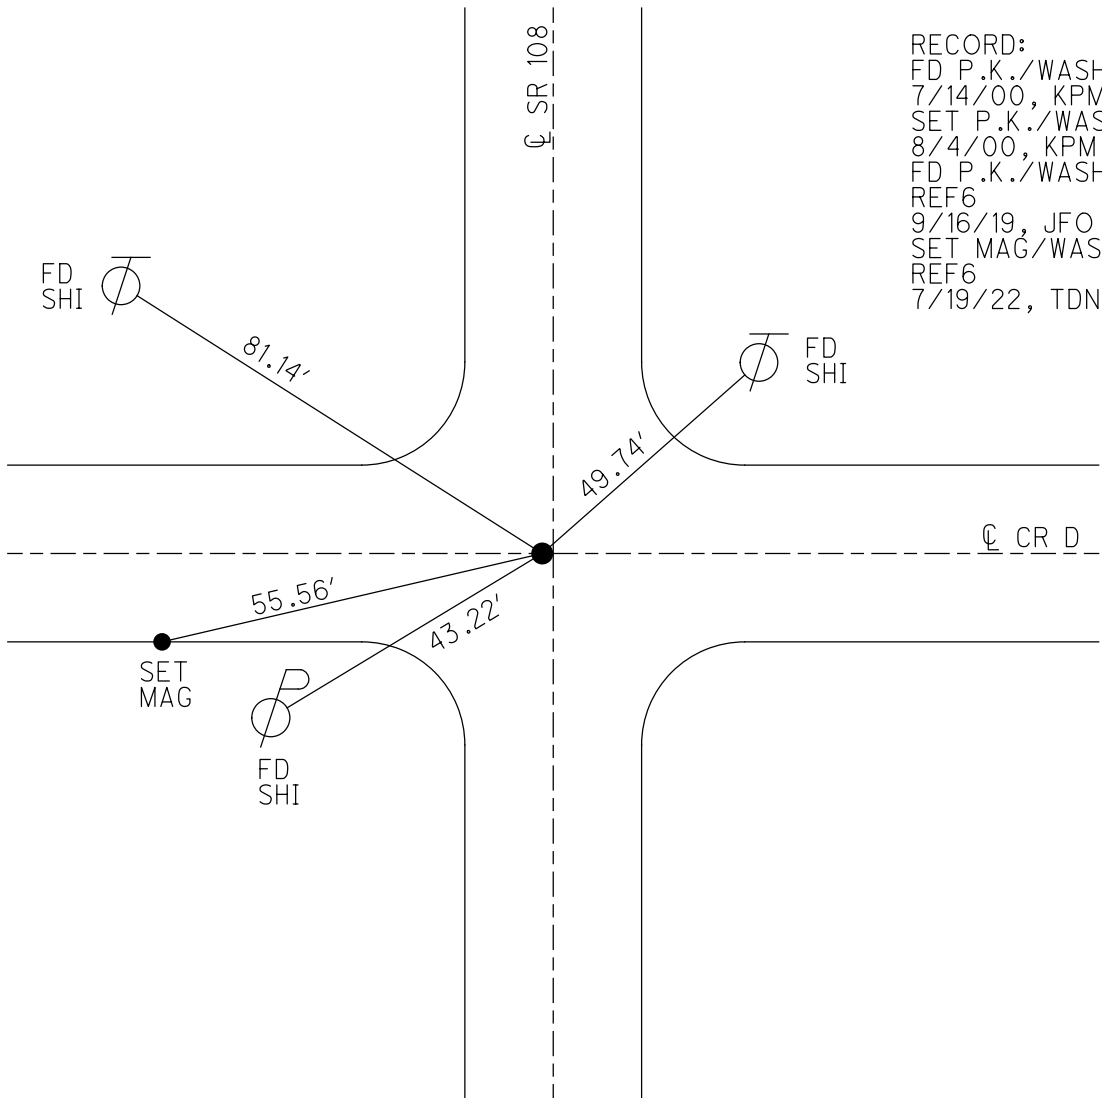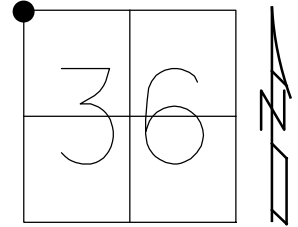

RECORD:
 FD P.K./WASHER
 7/14/00, KPM
 SET P.K./WASHER
 8/4/00, KPM
 FD P.K./WASHER
 REF6
 9/16/19, JFO
 SET MAG/WASHER
 REF6
 7/19/22, TDN

O.D.O.T. DISTRICT 2 SURVEY OFFICE (USE ONLY)

PERSONNEL _____

REFERENCE NO. 6

SHEET 9 OF 17

NOTES MOSE

DATE 7/14/00

ROUTE SR 108

H.C. BARNHISEL

WEATHER FAIR

COUNTY FULTON

R.C. CANTERBURY

TEMP. 78°

TOWNSHIP CLINTON

SECTION 36

DWG BY NIESE PID _____

T 7 N R 6 E

TYPE MONUMENT P.K./WASHER

ON SURFACE - ~~BELOW~~ ON

OFFSET 0.9' LT : ~~RT~~

- TO - EDGE PAVEMENT


STATION: 159+85

HORIZ.DATUM: _____


GEOID: _____

GRID: NORTHING: _____

EASTING: _____

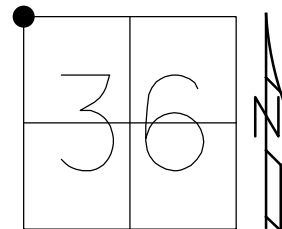

RECORD:
FD P.K./WASHER
7/14/00, KPM
SET P.K./WASHER
8/4/00, KPM

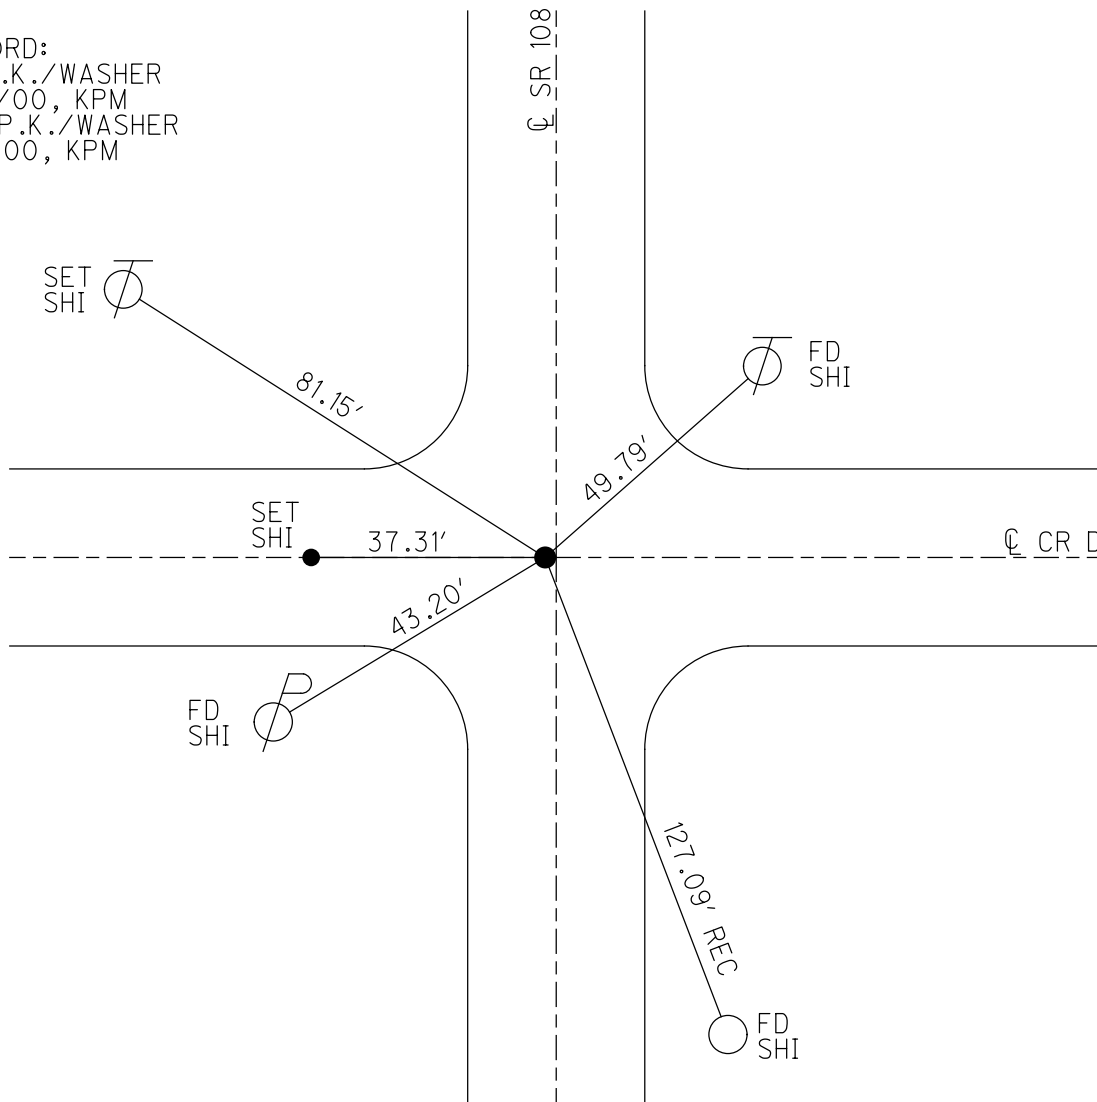

O.D.O.T. DISTRICT 2 SURVEY OFFICE

PERSONNEL _____

REFERENCE NO. 6

SHEET 7 OF 10

NOTES Moser

H.C. Down hisel

R.C. Centerline

DATE 7-14-00

WEATHER Fair

TEMP. +78°F

ROUTE SR-108

COUNTY Fulton

TOWNSHIP Clinton

SECTION _____

T 7 N R 6 E

TYPE MONUMENT PK/w

~~ON SURFACE~~ - ~~BELOW~~ Surface

~~LEFT~~ - ~~PAV'T~~ - ~~RIGHT~~ 0.9' Lt & 108


- TO - EDGE PAVEMENT

S.L.M. 159 + 85

26	25
35	36



Set PK/w
8-4-00
KPM

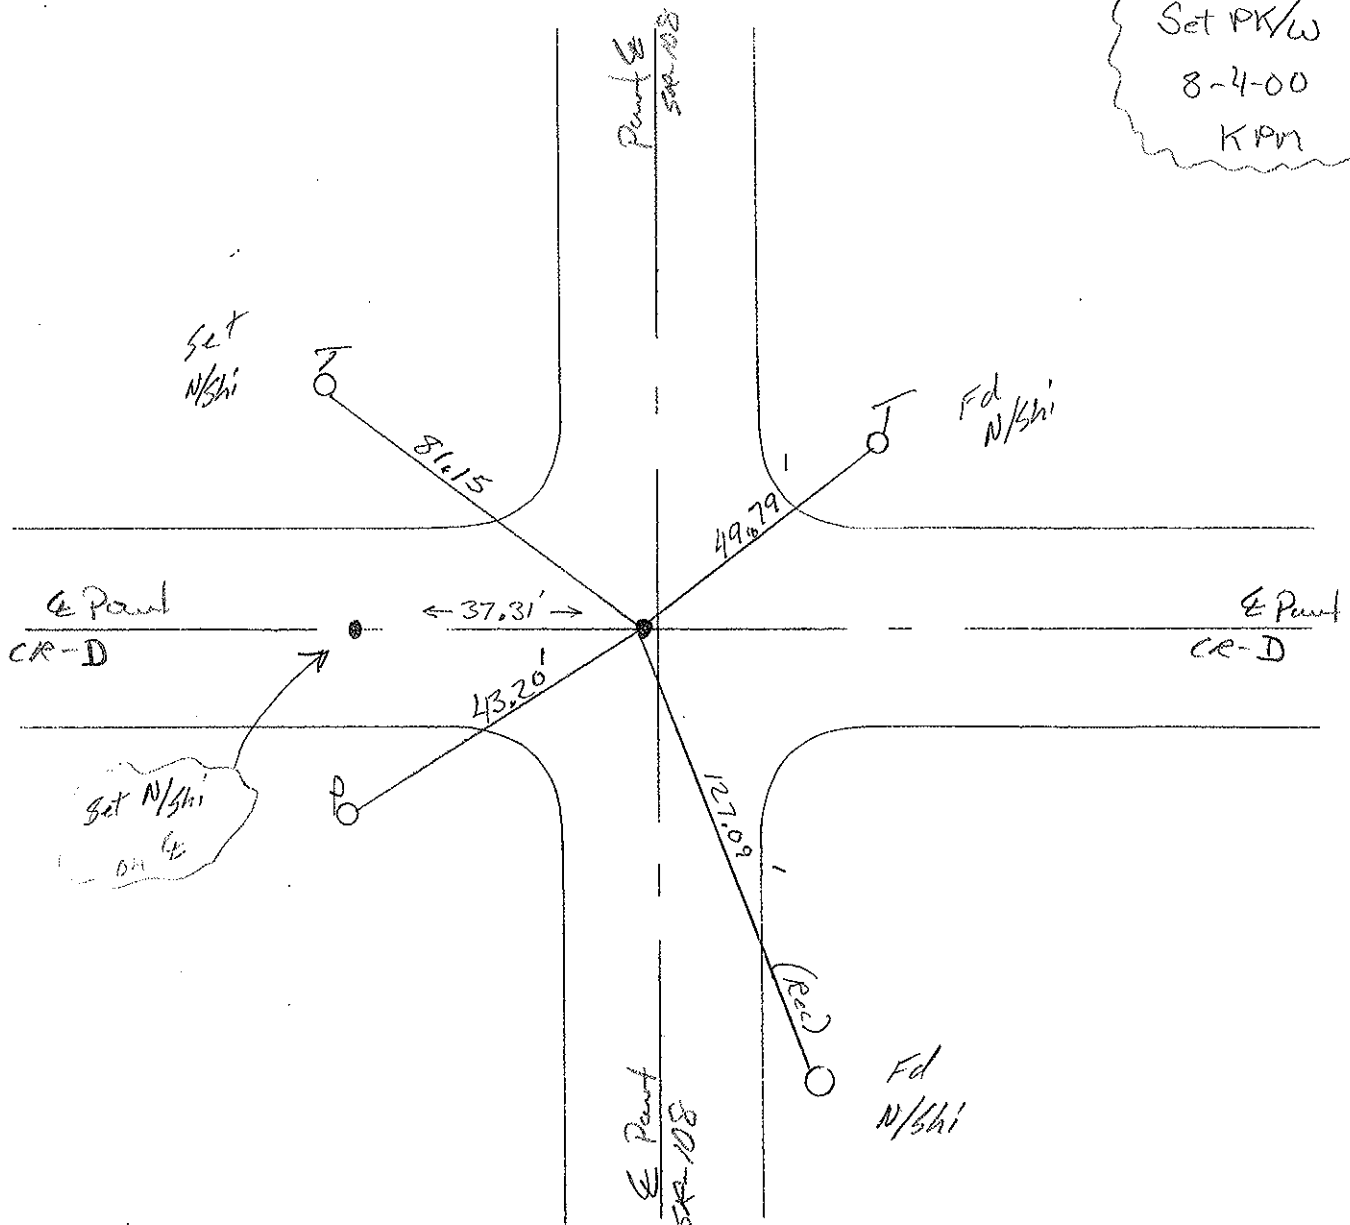

O.D.O.T. DISTRICT 2 SURVEY OFFICE

PERSONNEL _____

REFERENCE NO. 6

SHEET 7 OF _____

NOTES L. Stone

H.C. D. Curtis

R.C. J. Hauscholder

DATE 19 Oct 88

WEATHER Cool

TEMP. 500

ROUTE SR #108

COUNTY Fulton

TOWNSHIP Clinton

SECTION 25-26-35-36

T _____ R _____

TYPE MONUMENT PK Nail

ON SURFACE - BELOW Surface

LEFT - \odot PAV'T. - RIGHT _____


_____ TO _____ EDGE PAVEMENT

S.L.M. 159+24

26	25
35	36



OK 6/7/89 IRS

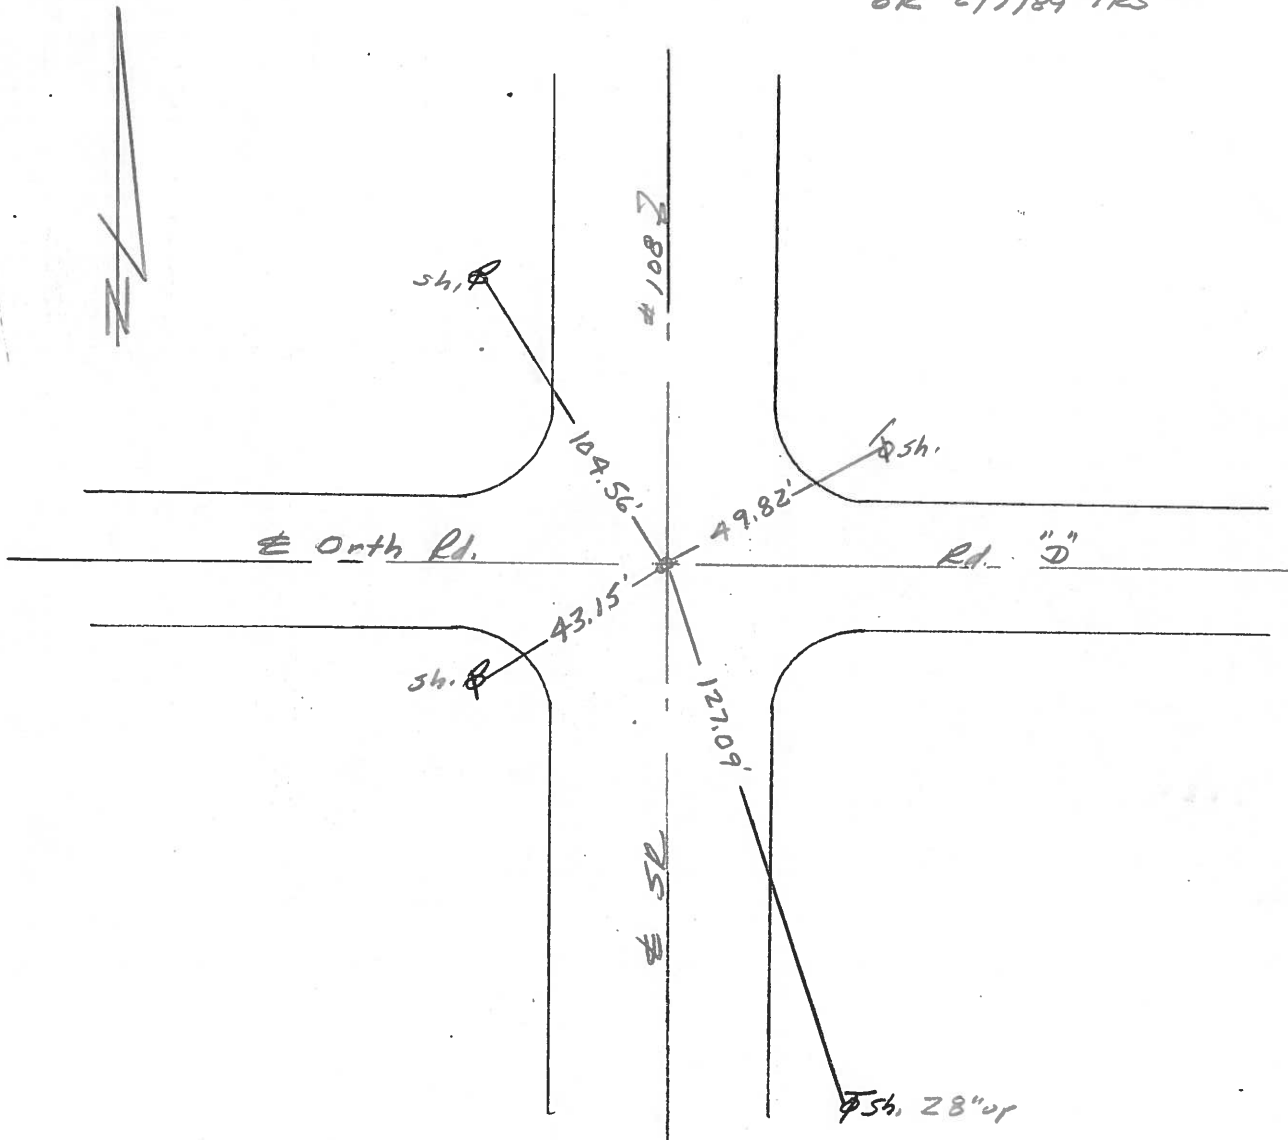

County Fulton S.R. 108

Township Clinton

Section 25-26-35-36

T N, R E

Personnel I. Stone

P. Newser

D. Curtis

OK-10-23-80
Date 30 Sept. 80


Weather Clear




Temp. 65°

26	25
35	36



REF. NO. 6

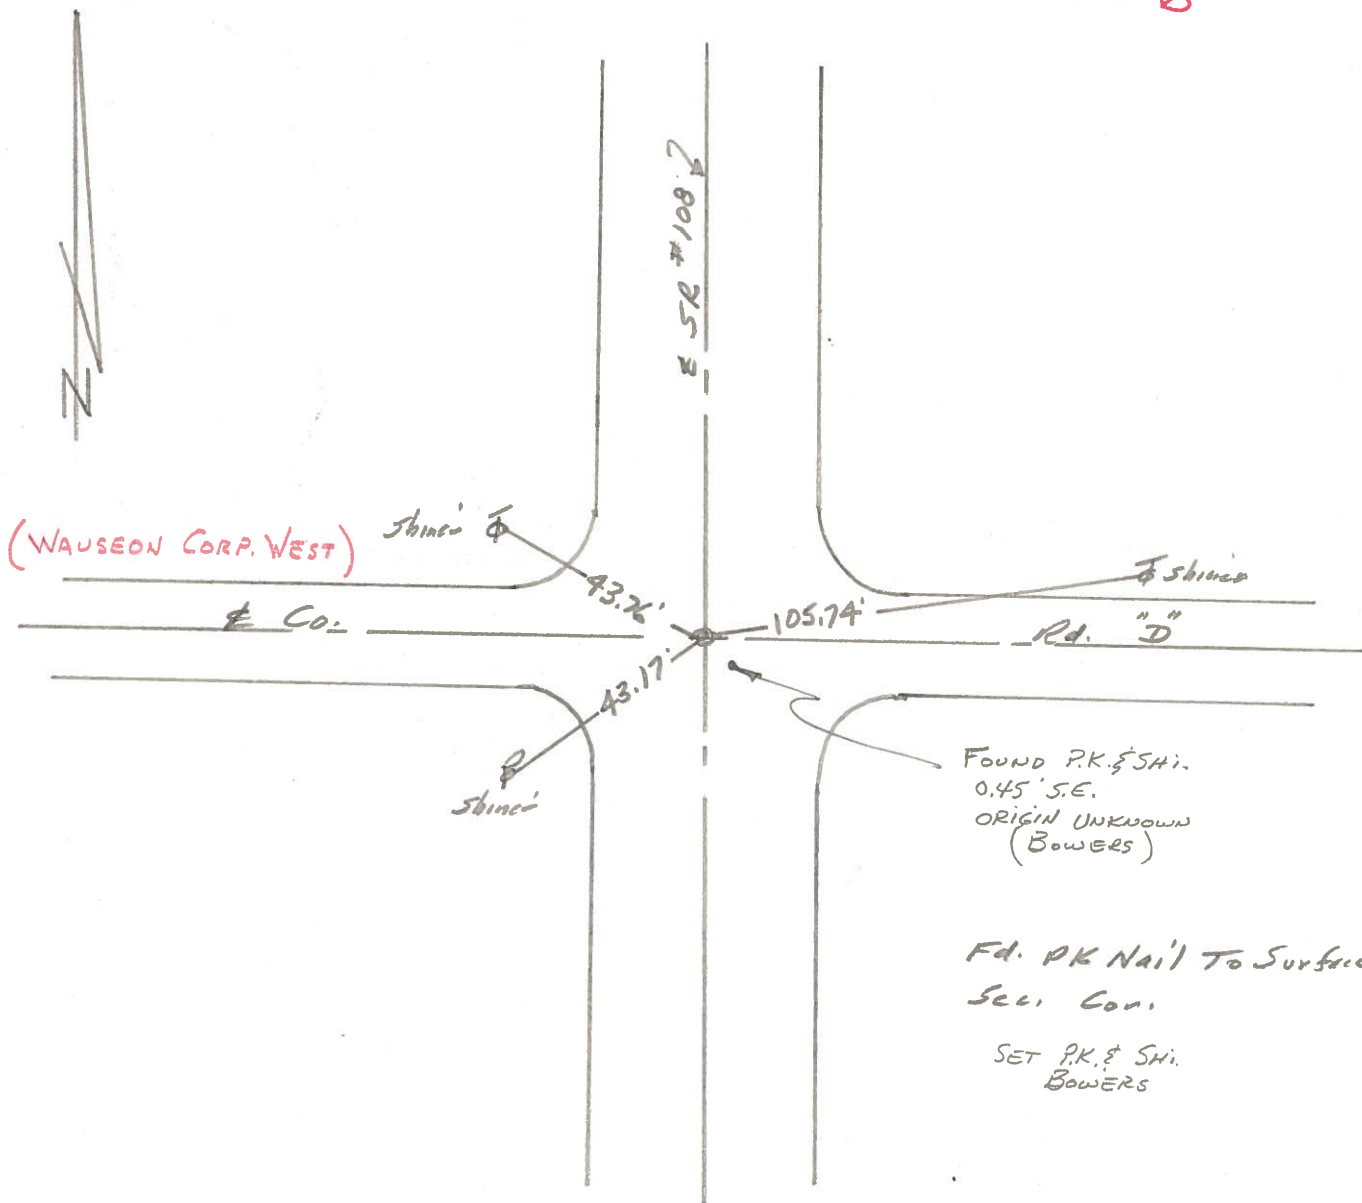


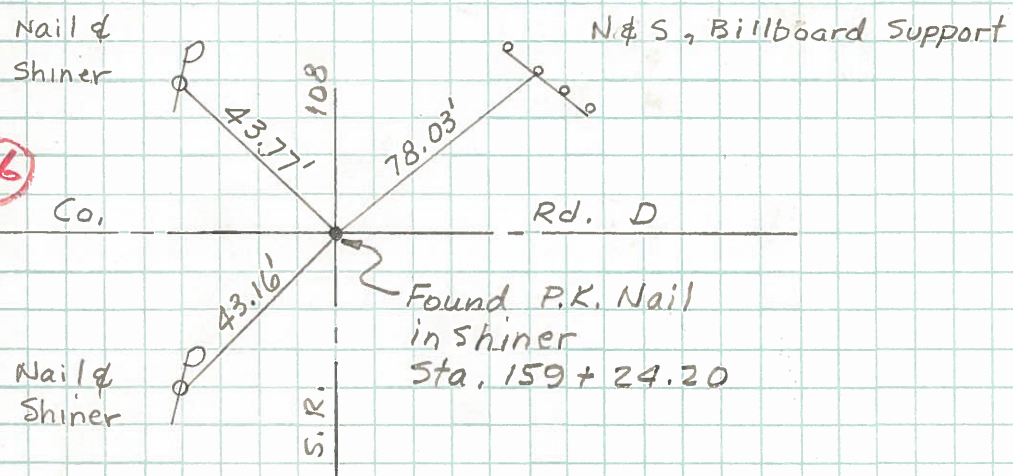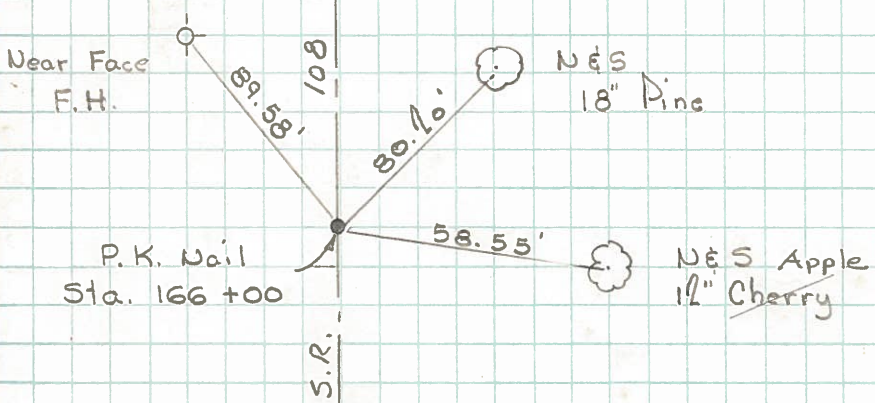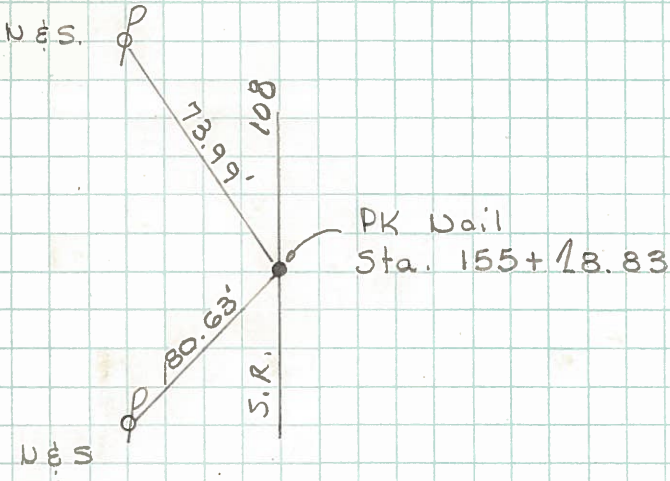

DESIGN BY RVE DATE 4-15-78 CHECKED BY _____ DATE _____

SUBJECT Ful. Co. 108 - Alignment


REFERENCE _____ NOTE FILE NO _____ COMM. NO 7811

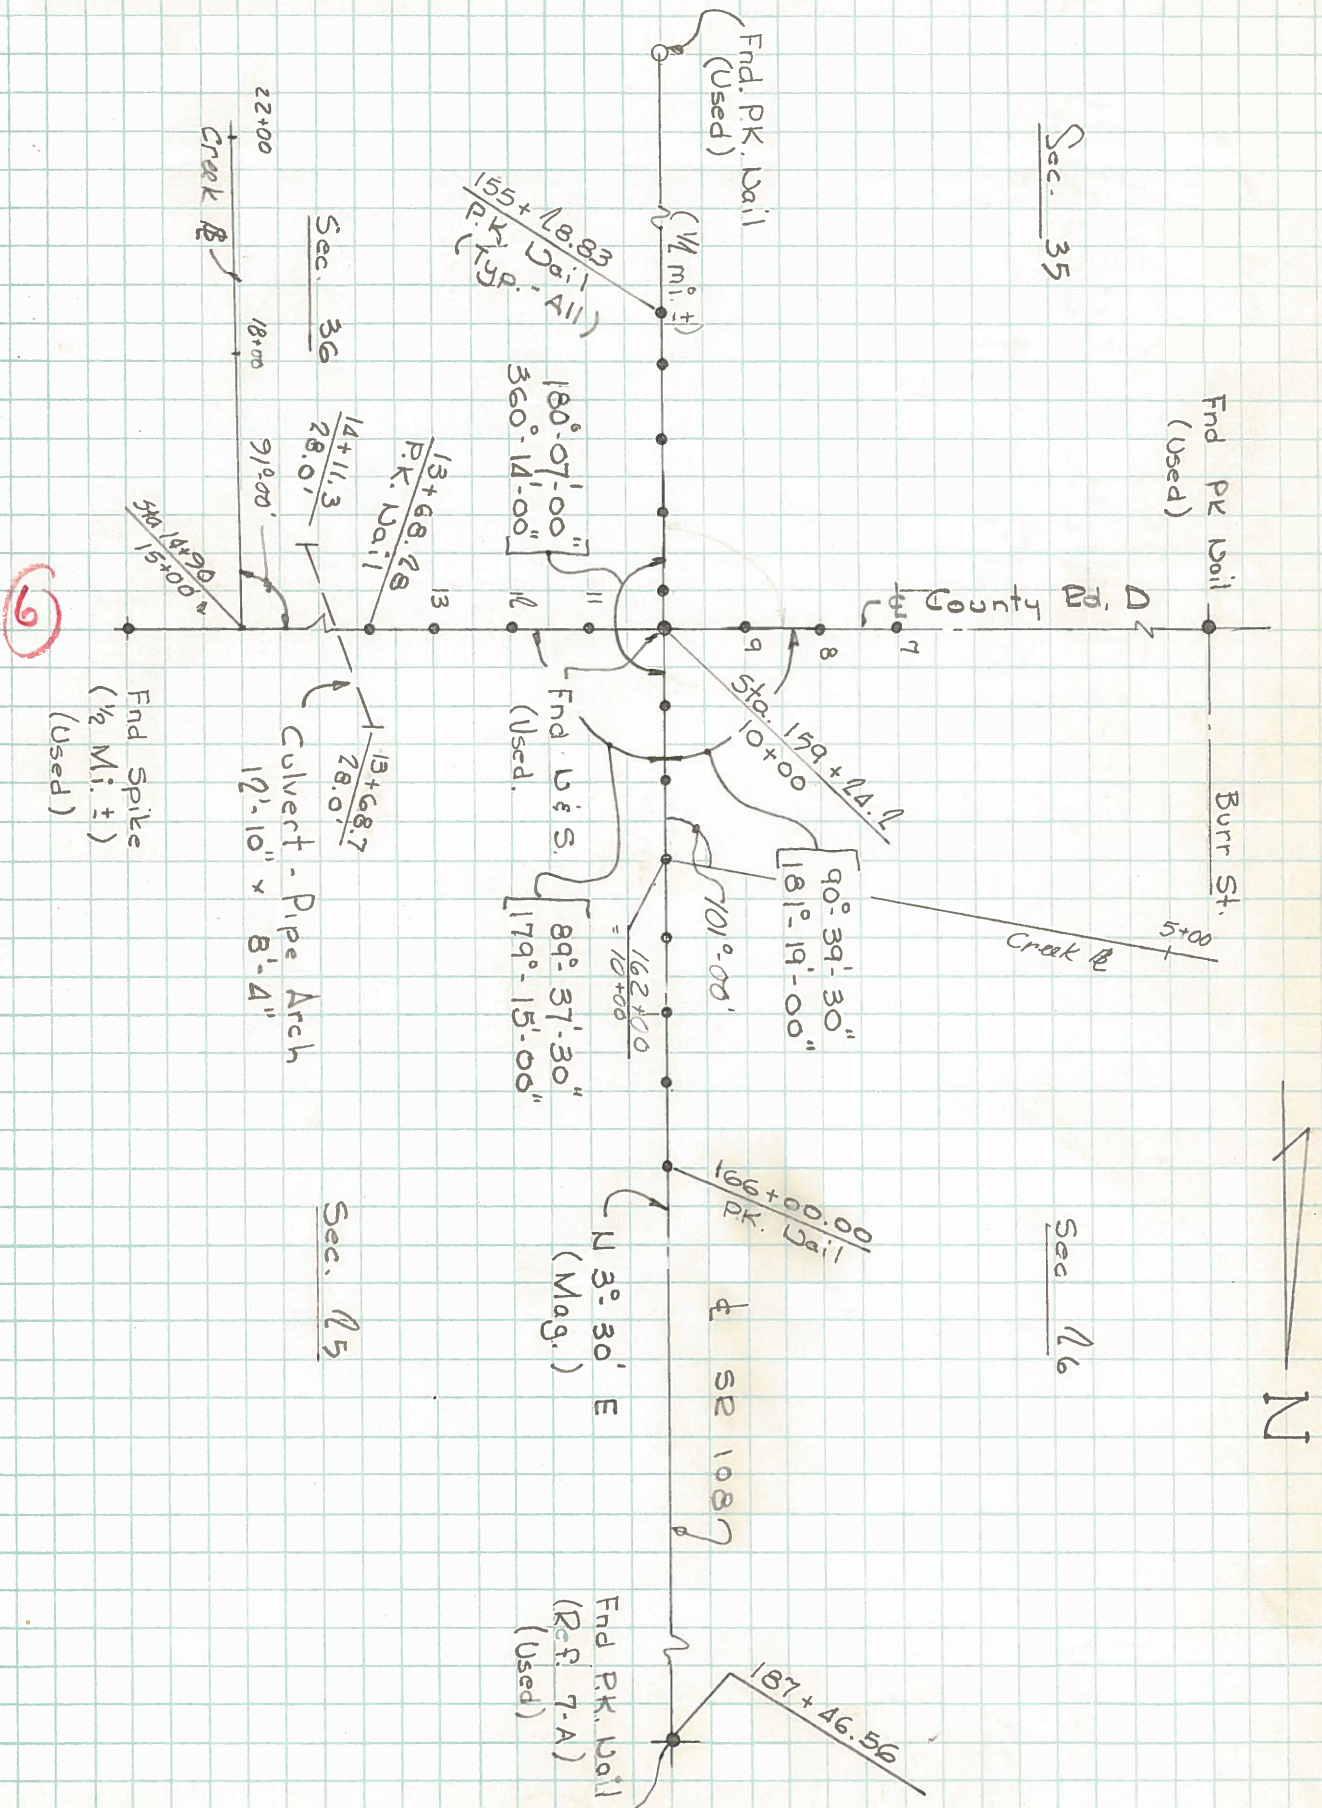

PERSONNEL	TITLE	PERSONNEL	TITLE
Tomsic			
Neuser			
Granata			
Vauyo			

COUNTY Fulton DATE April 20, 1973
 S. R. 108 WEATHER _____
 SEC. _____ TEMP. _____





DESCRIPTION _____ LEFT _____ CENTER LINE _____ RIGHT _____ JOB NO. _____

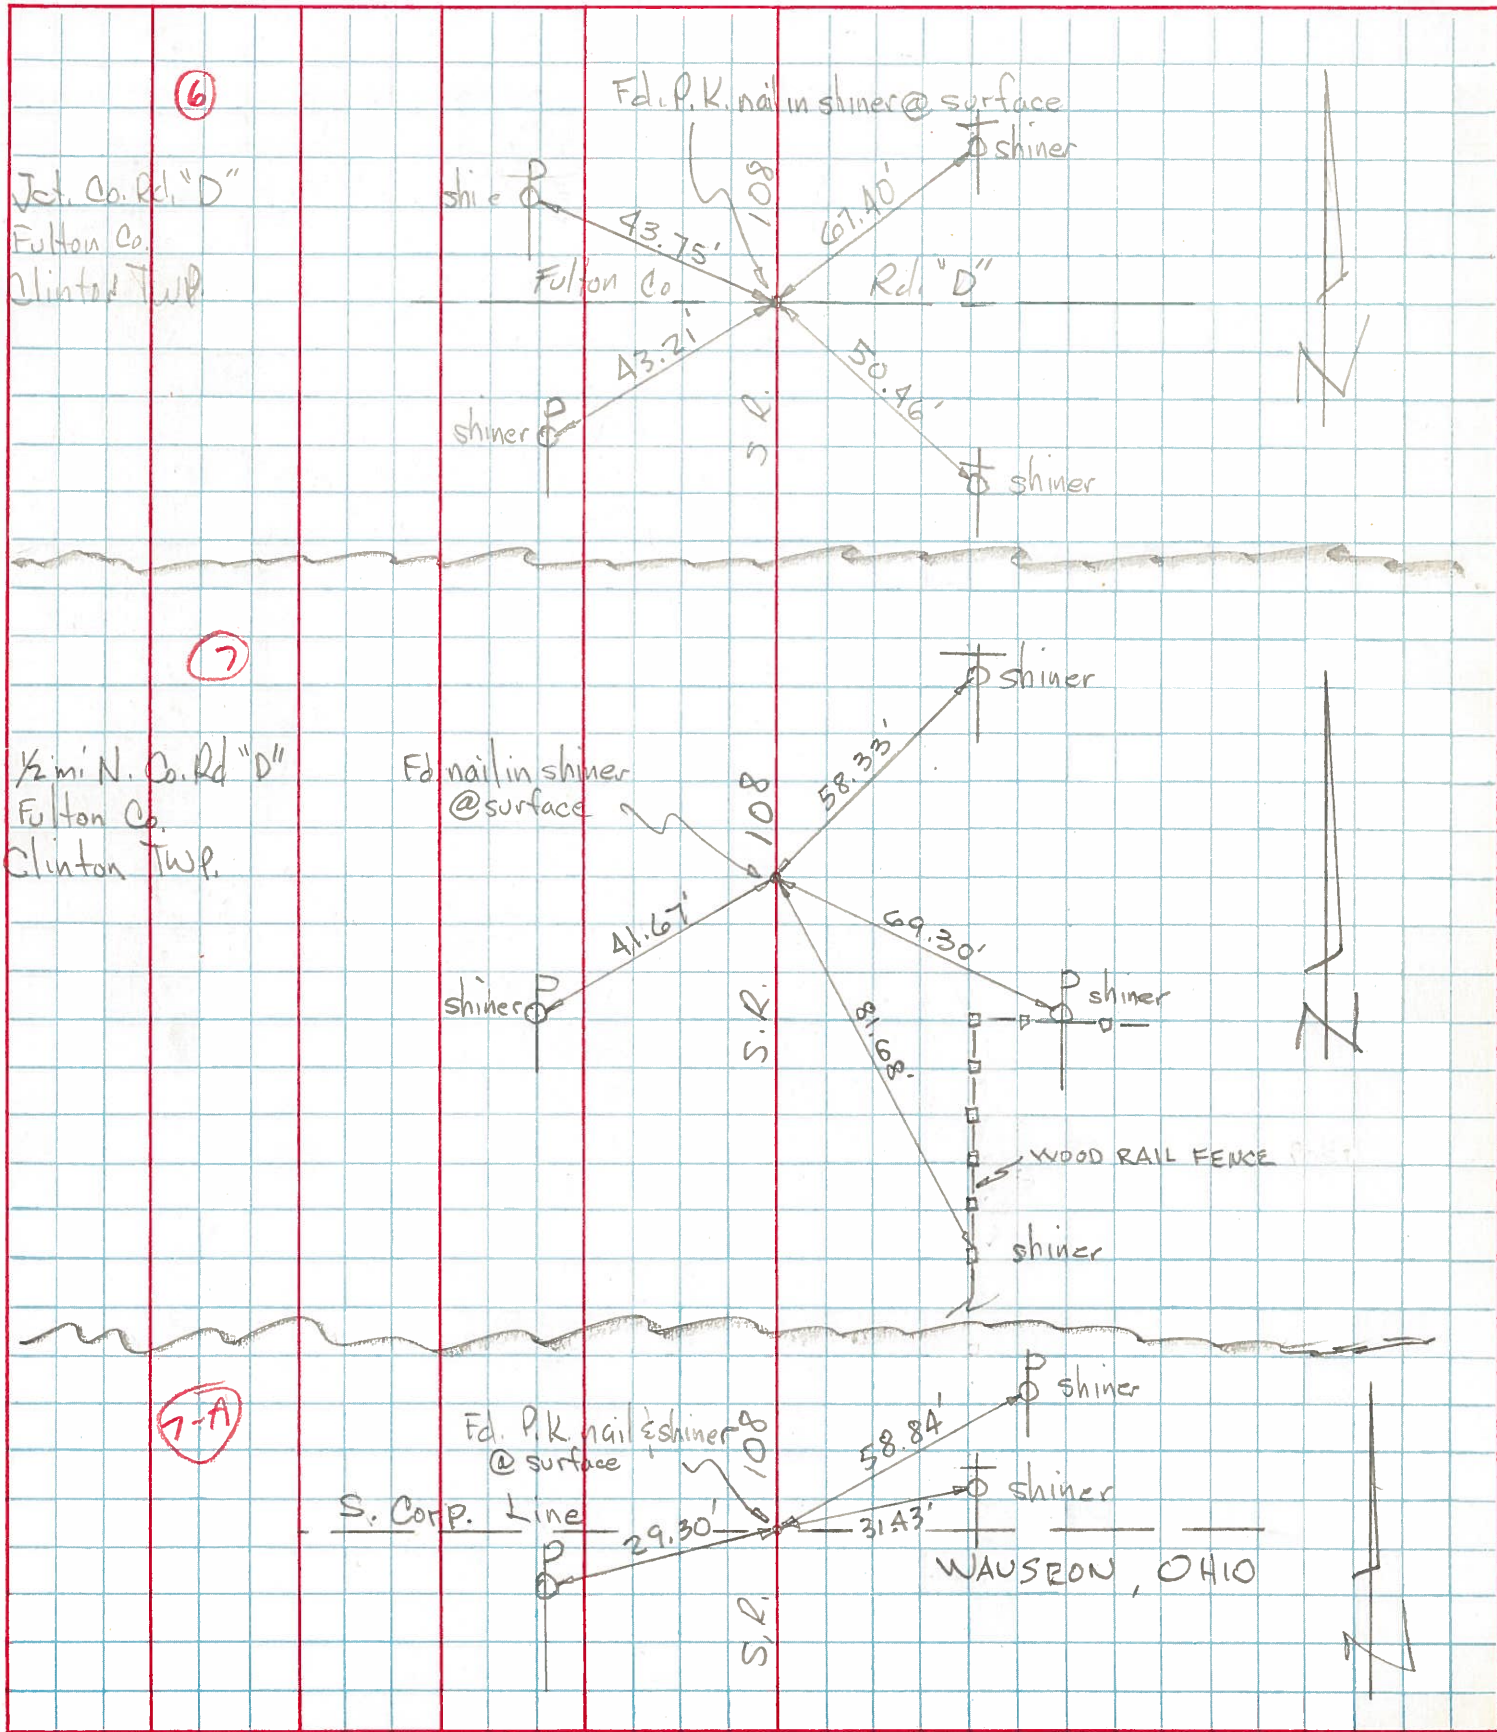

PERSONNEL TITLE PERSONNEL TITLE
Red Beach
Newcomb
Knape
Wise

COUNTY FULTON DATE 30 May 1970
 S. R. 108 WEATHER _____
 SEC. Clinton Twp. T-7-N R-6E TEMP. _____

DESCRIPTION CONTROL POINTS LEFT CENTER LINE RIGHT JOB NO.

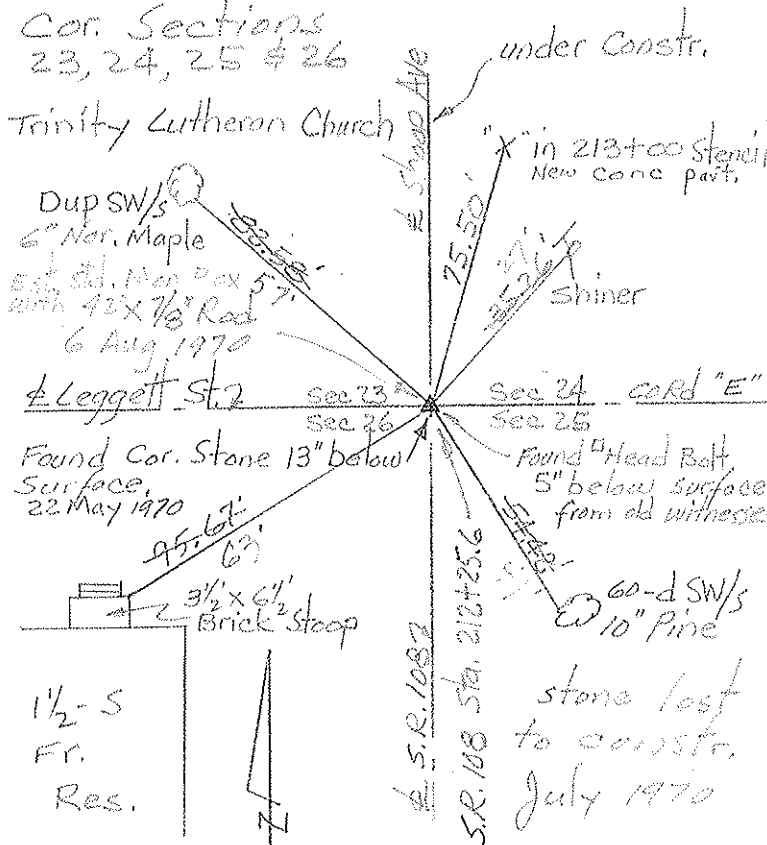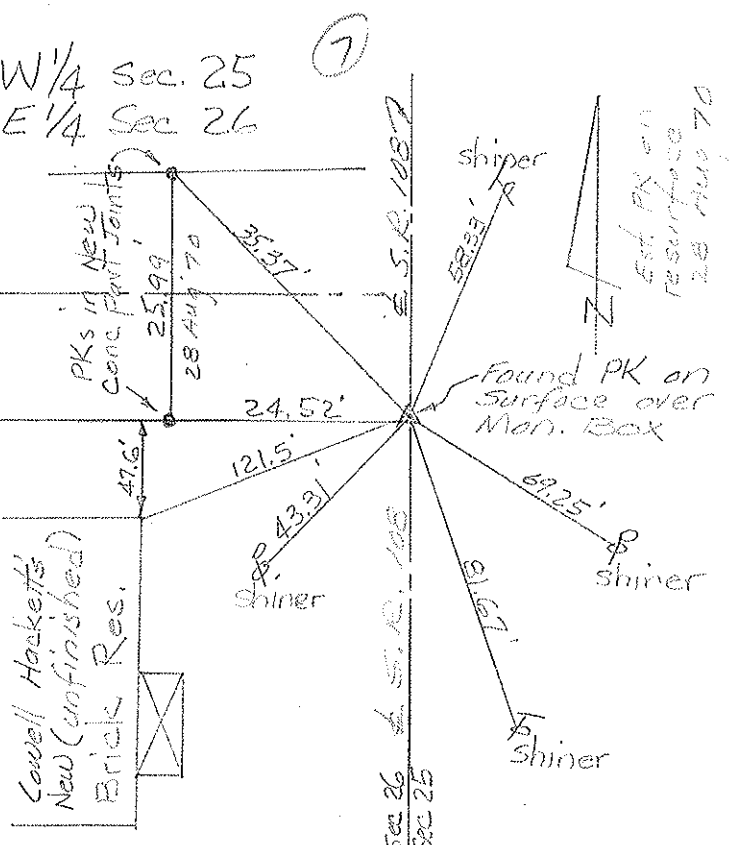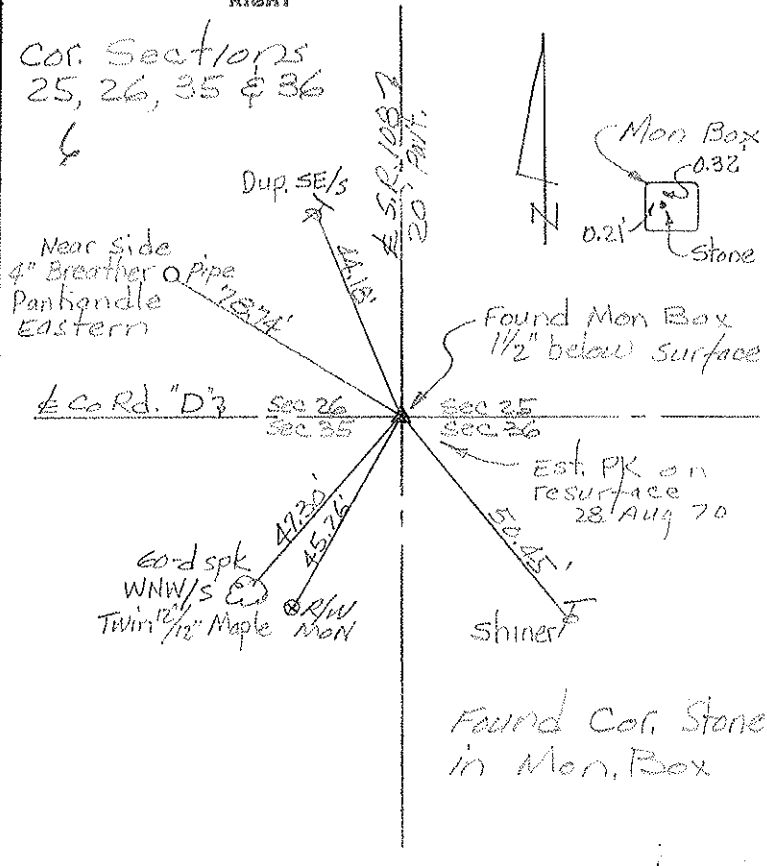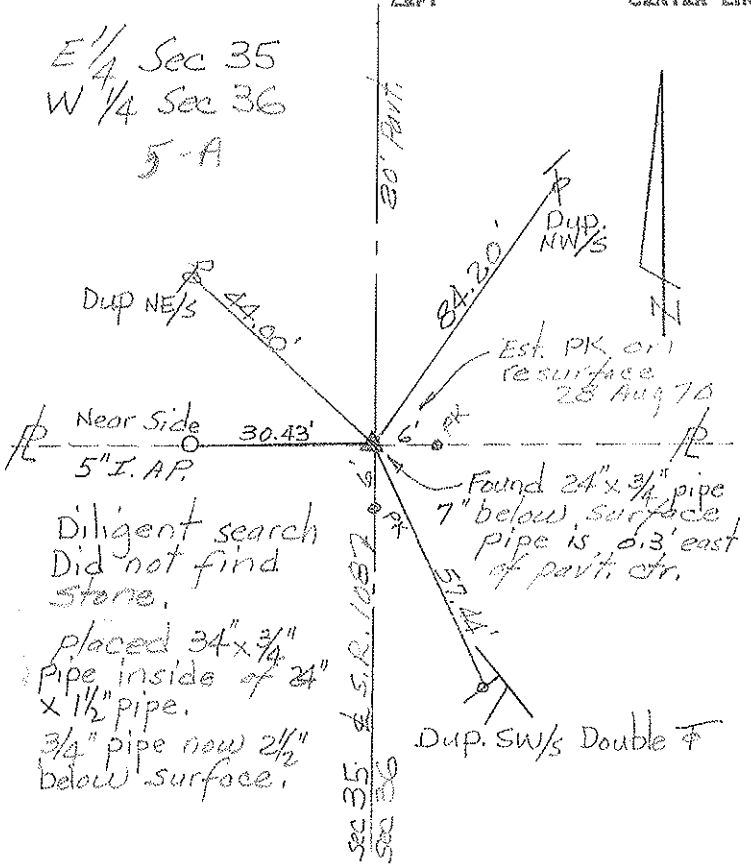

COMPUTATION SHEET

STATE OF OHIO - DEPARTMENT OF HIGHWAYS - BUREAU OF LOCATION AND DESIGN _____ COLUMBUS, OHIO
BY Denno - Curtis - Granata - Omev DATE June 9, 1966 NO. _____ OF _____ SHEETS
COUNTY Fulton SECTION _____
DIV. NO. _____ S.R. 108 U.S.R. _____ I. R. _____
SUBJECT OF THIS SHEET Ref. Monument SR 108

(6)

