

O.D.O.T. DISTRICT 2 SURVEY OFFICE (USE ONLY)

PERSONNEL _____

REFERENCE NO. 6 A

SHEET 10 OF 17

NOTES RHOADES

DATE 7/14/21

ROUTE SR 108

H.C. NIESE

WEATHER HUMID

COUNTY FULTON

R.C. AUBLE

TEMP. 73°

TOWNSHIP CLINTON

DWG BY WHITAKER

PID 92361

SECTION 25

T 7 N R 6 E

TYPE MONUMENT P.K. SHANK

ON SURFACE - ~~BELOW~~ ON

OFFSET C PAVEMENT ON LT : RT

10.4' TO RT EDGE PAVEMENT


STATION: 186+47

HORZ.DATUM: NAD83 (2011)


GEOID: 2012A

GRID: NORTHING: 685629.705

EASTING: 1521106.002

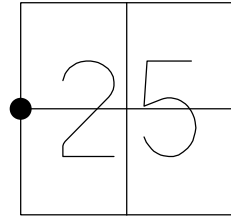

RECORD:
 FD P.K./WASHER
 7/14/00, KPM
 SET P.K./WASHER
 8/4/00, KPM
 FD P.K.SHANK
 REF7
 9/16/19, JFO
 SET MAG/WASHER
 7/19/22, TDN

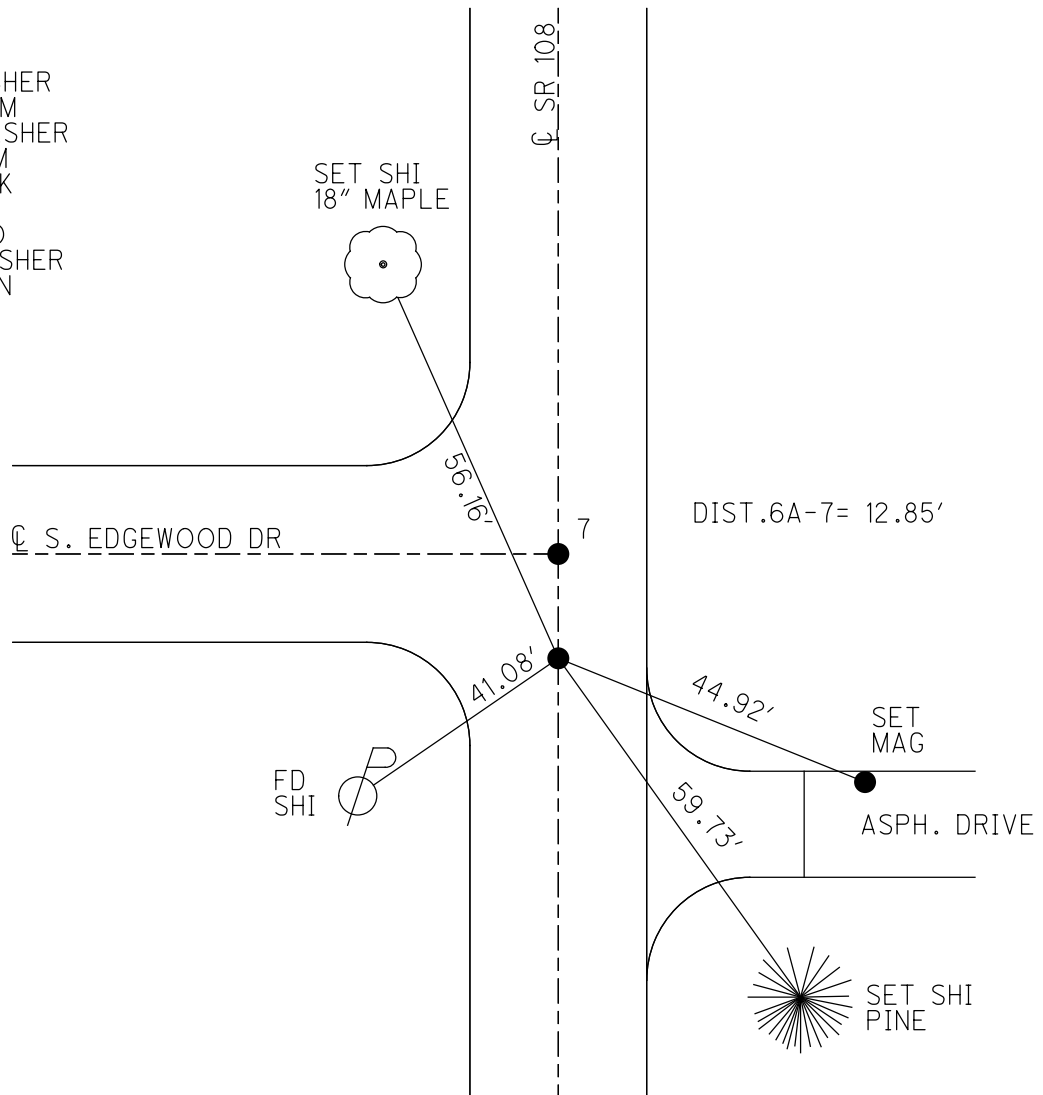

O.D.O.T. DISTRICT 2 SURVEY OFFICE (USE ONLY)

PERSONNEL

REFERENCE NO. 6 A

SHEET 10 OF 17

NOTES MOSER
 H.C. BARNHISEL
 R.C. CANTERBURY

DATE 7/14/00
 WEATHER FAIR
 TEMP. 78°

ROUTE SR 108
 COUNTY FULTON
 TOWNSHIP CLINTON
 SECTION 25
 T 7 N R 6 E

DWG BY NIESE PID _____

TYPE MONUMENT P.K./WASHER

ON SURFACE - ~~BELOW~~ ON

OFFSET \odot PAVEMENT ON LT : RT

10.4' TO RT EDGE PAVEMENT


STATION: 186+47

HORZ. DATUM: _____


GEOID: _____

GRID: NORTHING: _____

EASTING: _____

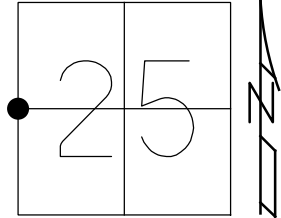

RECORD:
 FD P.K./WASHER
 7/14/00, KPM
 SET P.K./WASHER
 8/4/00, KPM

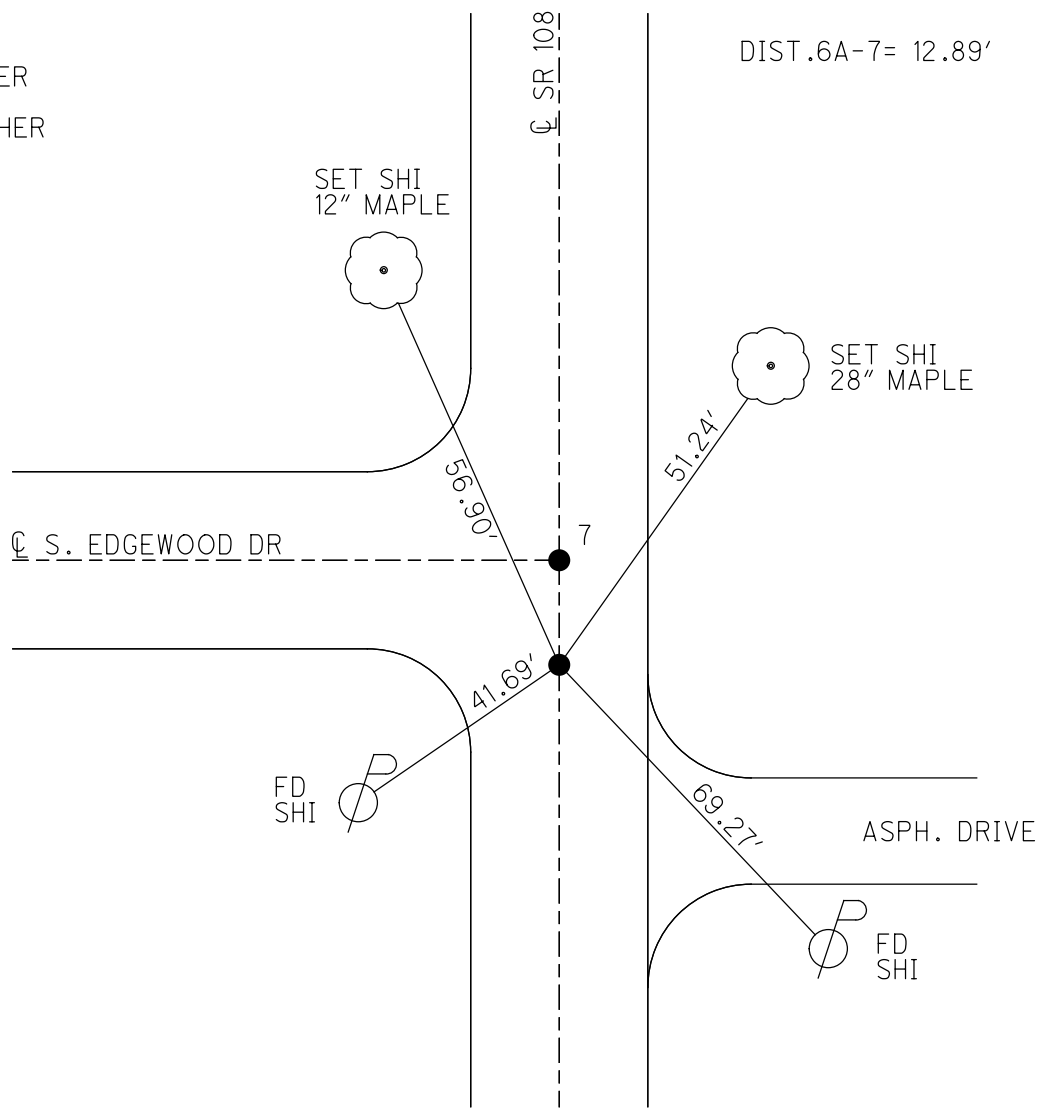

O.D.O.T. DISTRICT 2 SURVEY OFFICE

PERSONNEL _____

REFERENCE NO. 7

SHEET 8 OF 10

NOTES Moser

H.C. Barnhisel

R.C. Canterbury

DATE 7-14-00

WEATHER Fair

TEMP. +78°F

ROUTE SR-108



COUNTY Fulton

TOWNSHIP Clinton

SECTION 25

T 7 N R 6 E

TYPE MONUMENT (A), (B) - PK/W's
 ON SURFACE - BELOW surface
 LEFT - PAV'T. - RIGHT on E
10.4' TO RT. EDGE PAVEMENT
 S.L.M. (A) - 186+47 (B) - 186+70

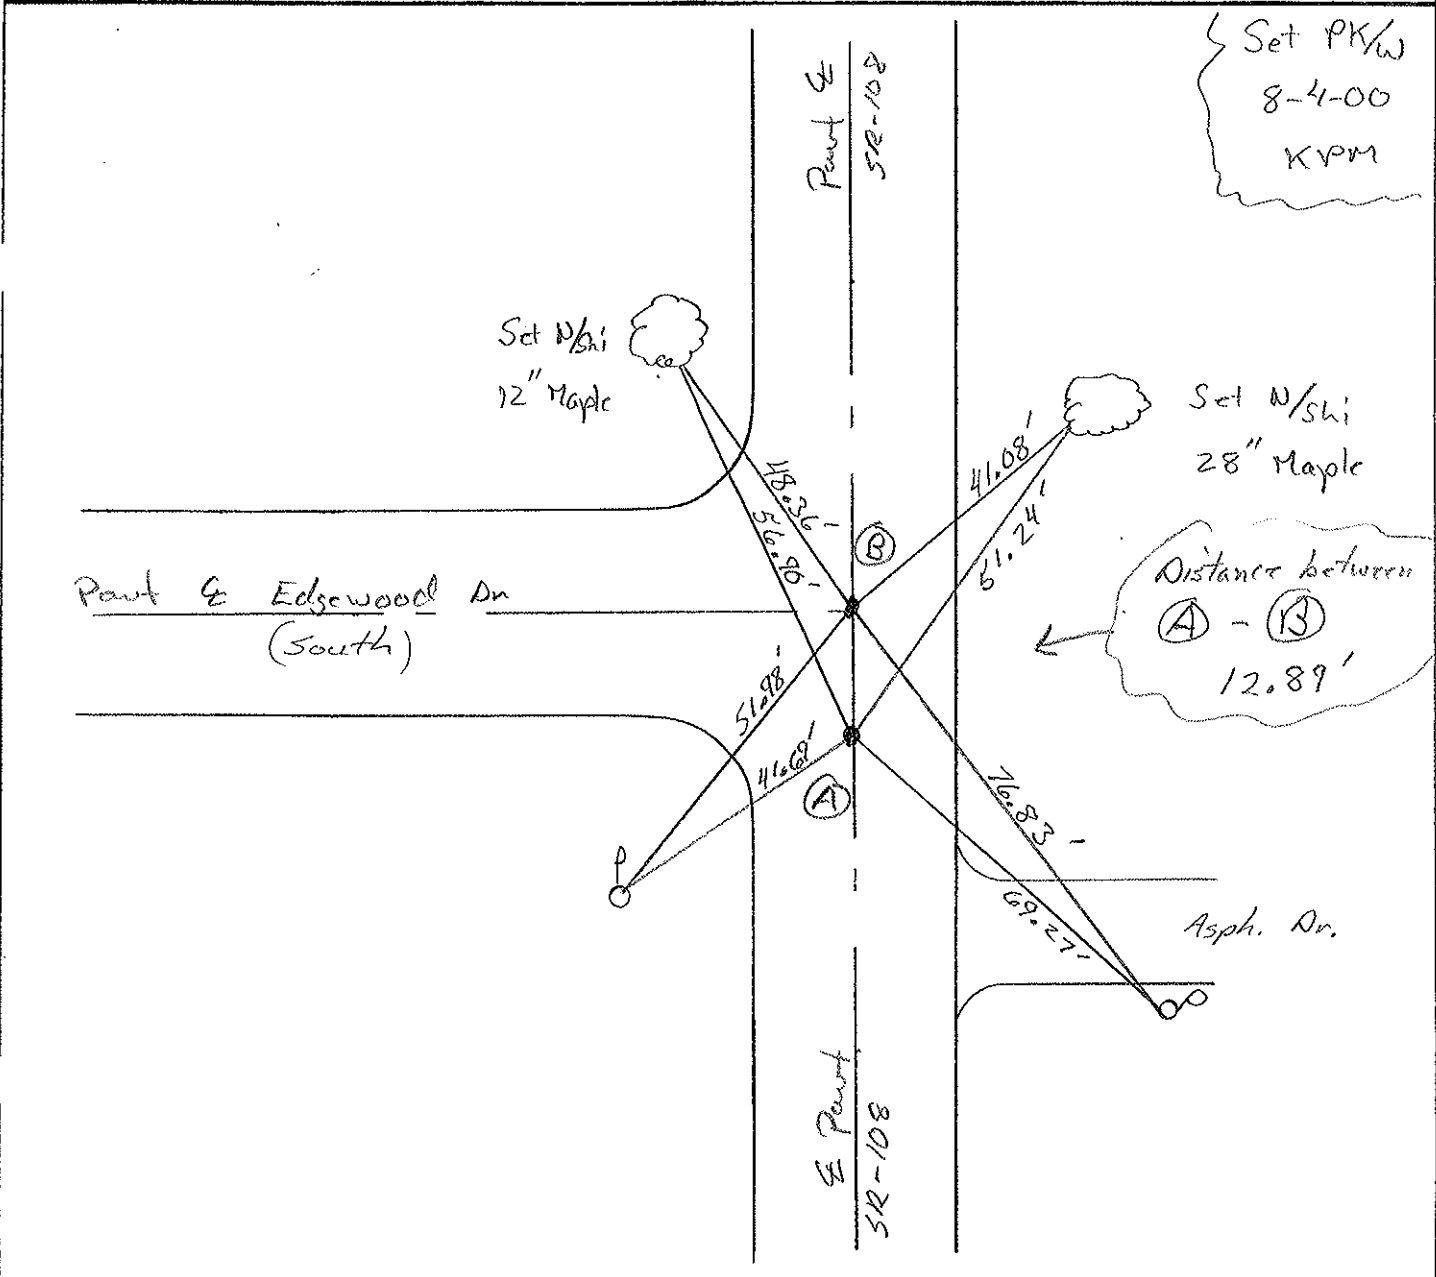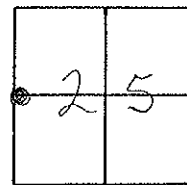

O.D.O.T. DISTRICT 2 SURVEY OFFICE

PERSONNEL _____

REFERENCE NO. 7

SHEET 8 OF _____

NOTES 1. Stone

H.C. D. Curtis

R.C. J. Hausholder

DATE 19 Oct. 88

WEATHER Coal

TEMP. 50°

ROUTE SR#108

COUNTY Fulton

TOWNSHIP Clifton

SECTION 25

T _____ R _____


TYPE MONUMENT A = PK Nail
B = PK Nail

ON SURFACE - BELOW Surface


LEFT - \odot PAW'T. - RIGHT _____

TO _____ EDGE PAVEMENT

S.L.M. A = 185+78 B = 185+91

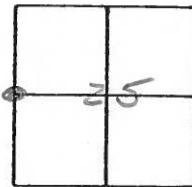

OK 6/7/89 IRS

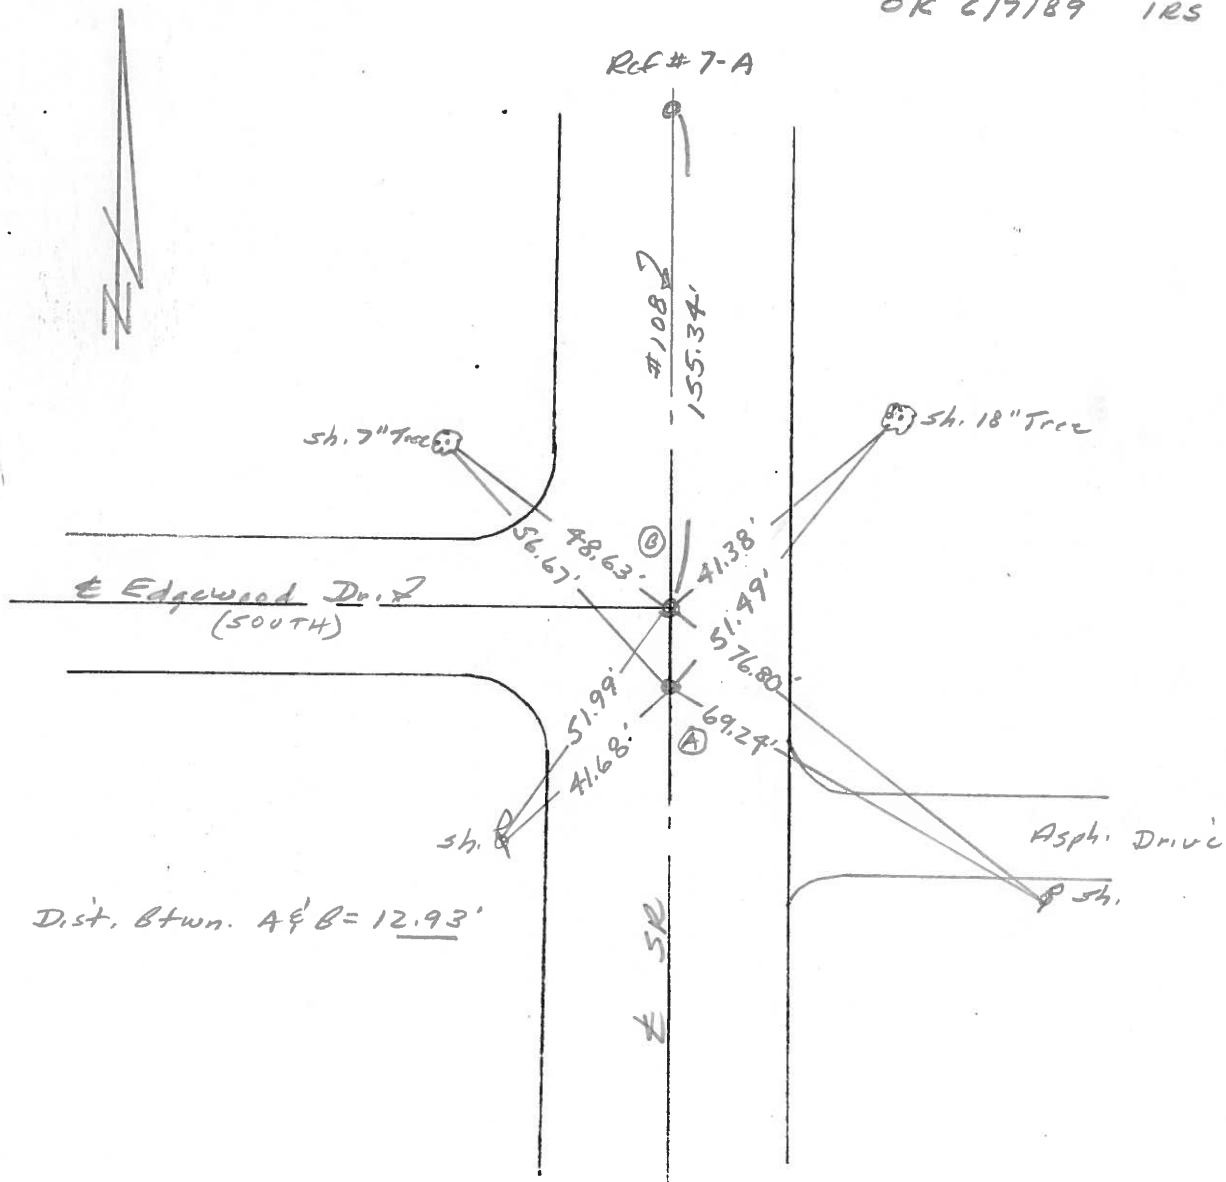

County Fulton S.R. 108

Township Clinton

Section 25

T N, R E

Personnel I. Stone


P. Newser

D. Curtis


Date OK-10-23-80 Bowers
30 Sept. 80

Weather Clear


Temp. 67°

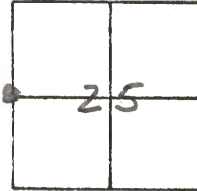

REF. NO. 7

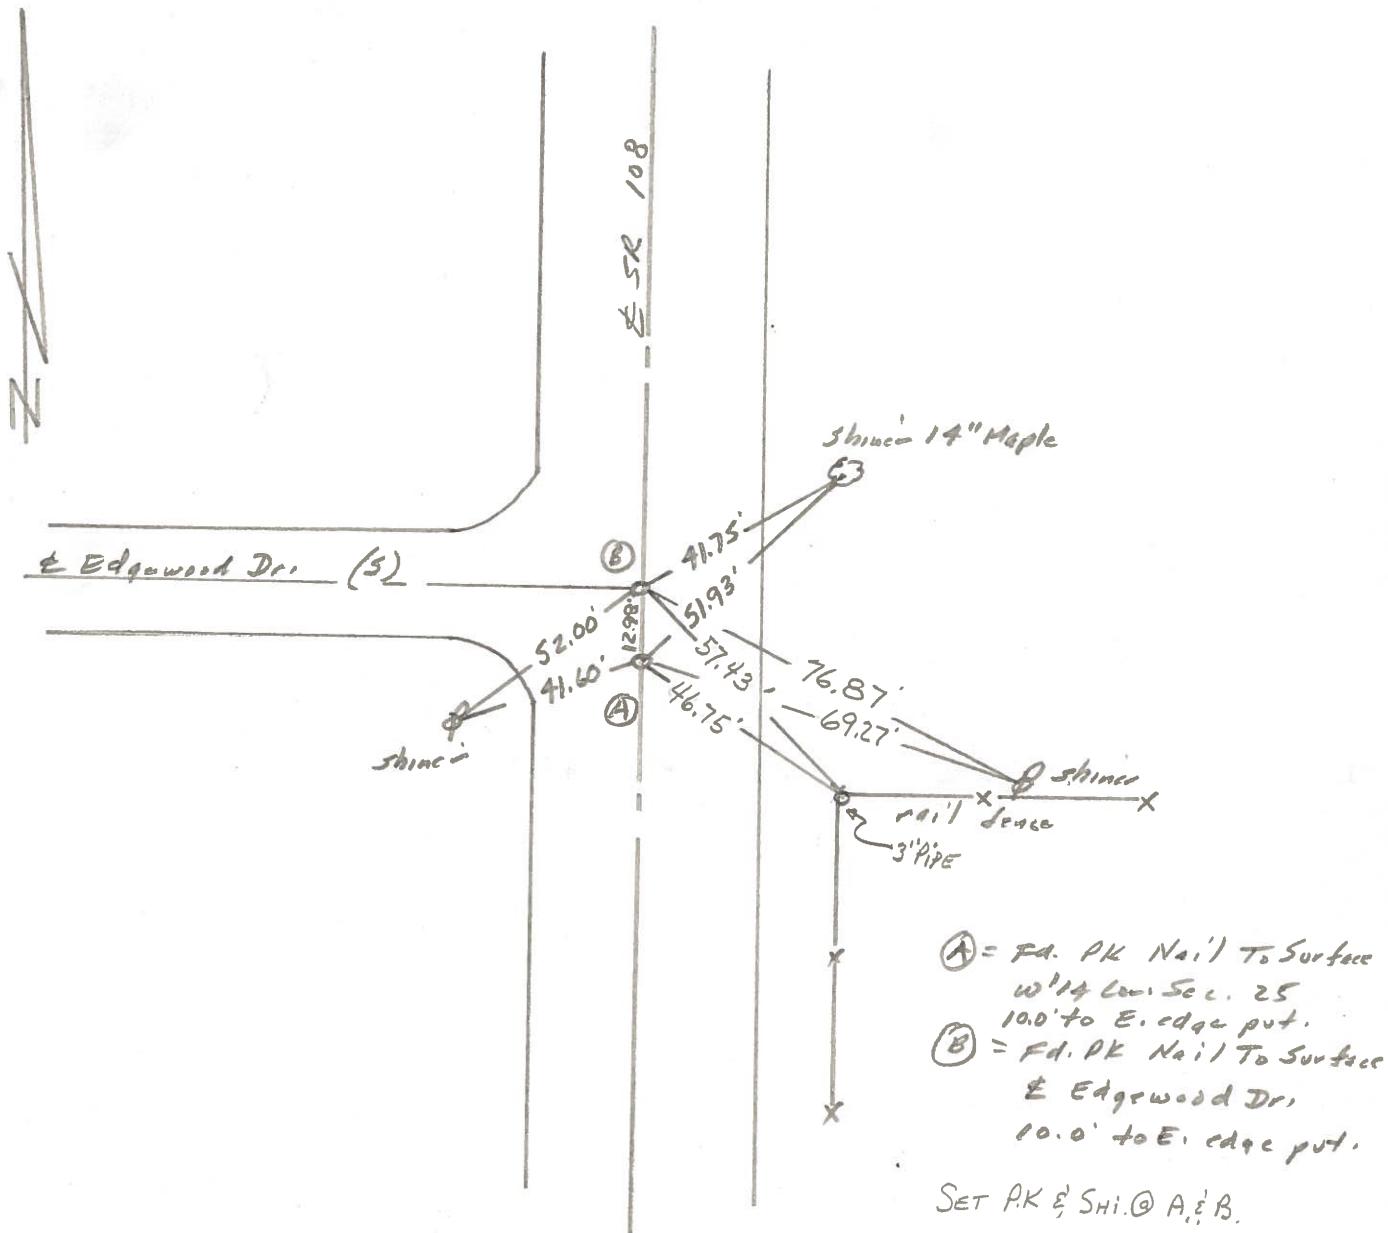

PERSONNEL	TITLE	PERSONNEL	TITLE	COUNTY	DATE	WEATHER	TEMP.
Tomsic				Fulton	April 20, 1973		
Weuser				S. R. 108			
Granata							
Vanyo							

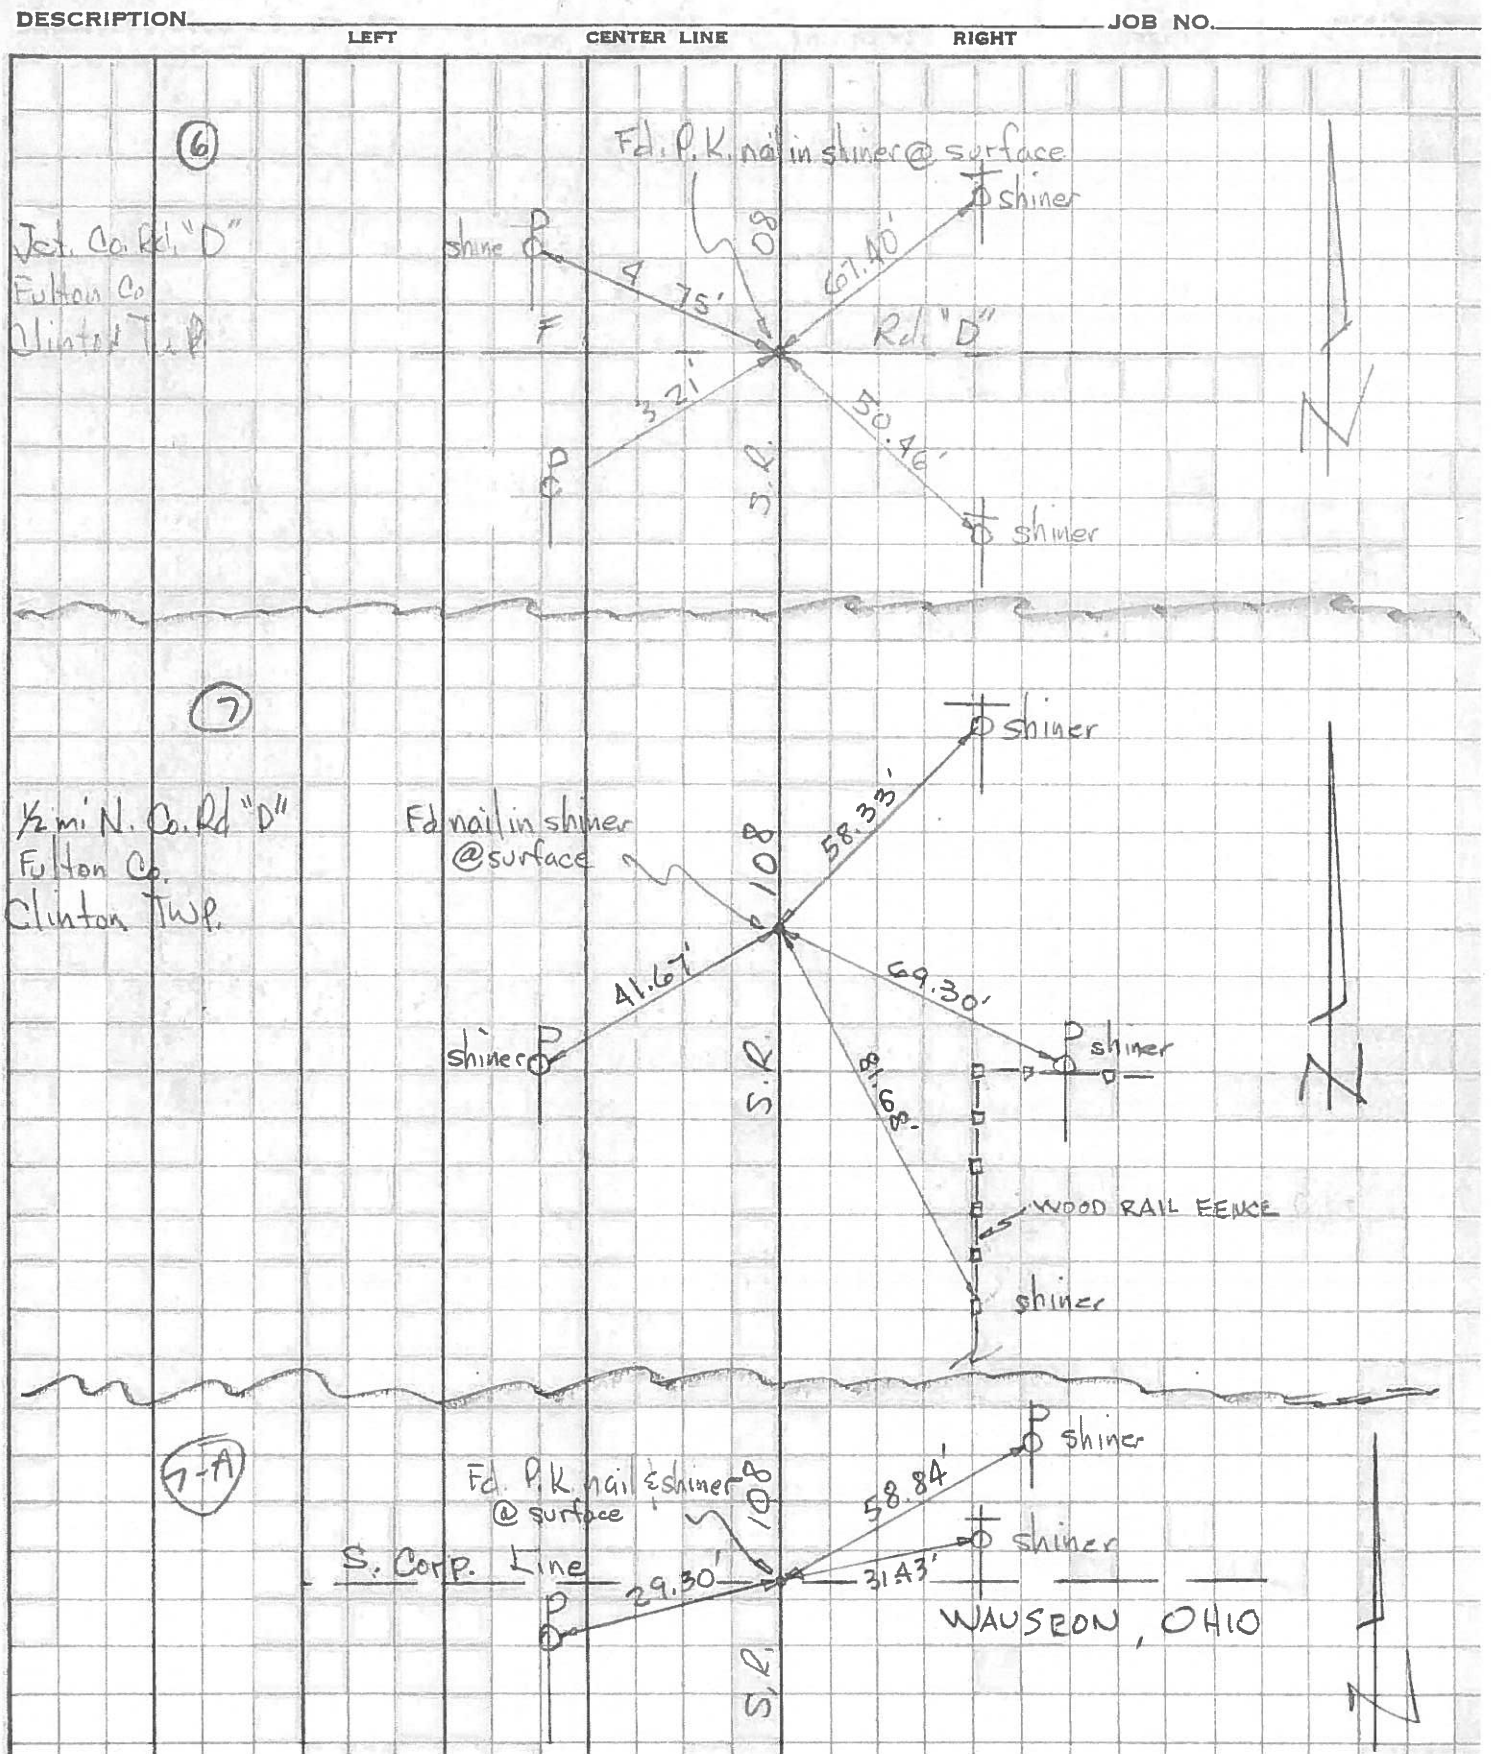

PERSONNEL	TITLE	PERSONNEL	TITLE	COUNTY	DATE
Langandor				Fulton	Aug. 11, 1958
Breese				S. R. 108 & 2	WEATHER Clear
Enyart				SEC. Wauseon	TEMP. 80°+
Robinson					
Williams					
DESCRIPTION	Men. References			JOB NO.	02292

