


O.D.O.T. DISTRICT 2 SURVEY OFFICE (USE ONLY)


PERSONNEL _____ REFERENCE NO. 7 SHEET 11 OF 17
 NOTES RHOADES DATE 7/14/21 ROUTE SR 108
 H.C. NIESE WEATHER HUMID COUNTY FULTON
 R.C. AUBLE TEMP. 73° TOWNSHIP CLINTON
 DWG BY WHITAKER PID 92361 SECTION 25
 T 7 N R 6 E

TYPE MONUMENT MAG NAIL
 ON SURFACE - ~~BELOW~~ ON
 OFFSET ☉ PAVEMENT ON LT : RT
10.4' TO RT EDGE PAVEMENT
 STATION: 186+70

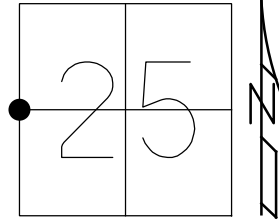

HORZ.DATUM: NAD83 (2011) GEOID: 2012A
 GRID: NORTHING: 685642.602 EASTING: 1521106.158

RECORD:
 FD P.K./WASHER
 7/14/00, KPM
 SET P.K./WASHER
 8/4/00, KPM
 FD MAG NAIL
 REFAA7
 9/16/19, JFO
 SET MAG/WASHER
 REFAA7
 7/19/22, TDN

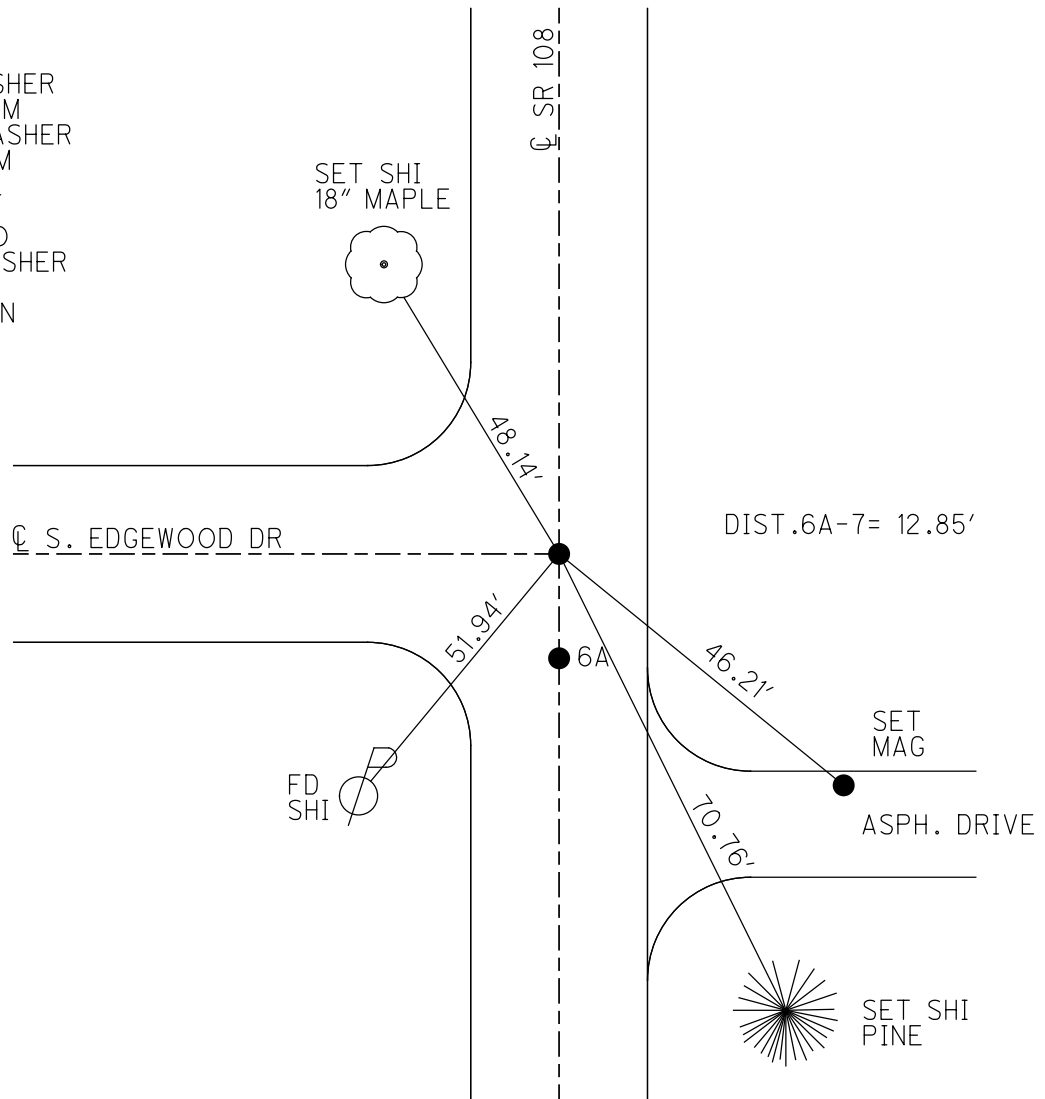

O.D.O.T. DISTRICT 2 SURVEY OFFICE (USE ONLY)

PERSONNEL _____

REFERENCE NO. 7

SHEET 11 OF 17

NOTES MOSER DATE 7/14/00
 H.C. BARNHEISEL WEATHER FAIR
 R.C. CANTERBURY TEMP. 78°

ROUTE SR 108
 COUNTY FULTON
 TOWNSHIP CLINTON
 SECTION 25
 T 7 N R 6 E

DWG BY NIESE PID _____

TYPE MONUMENT P.K./WASHER

ON SURFACE - ~~BELOW~~ ON


OFFSET Q PAVEMENT ON LT : RT

10.4' TO RT EDGE PAVEMENT

STATION: 186+70


HORZ.DATUM: _____ GEOID: _____

GRID: NORTHING: _____ EASTING: _____

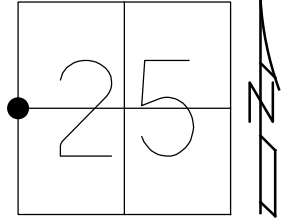

RECORD:
 FD P.K./WASHER
 7/14/00, KPM
 SET P.K./WASHER
 8/4/00, KPM

DIST. 6A-7 = 12.89'

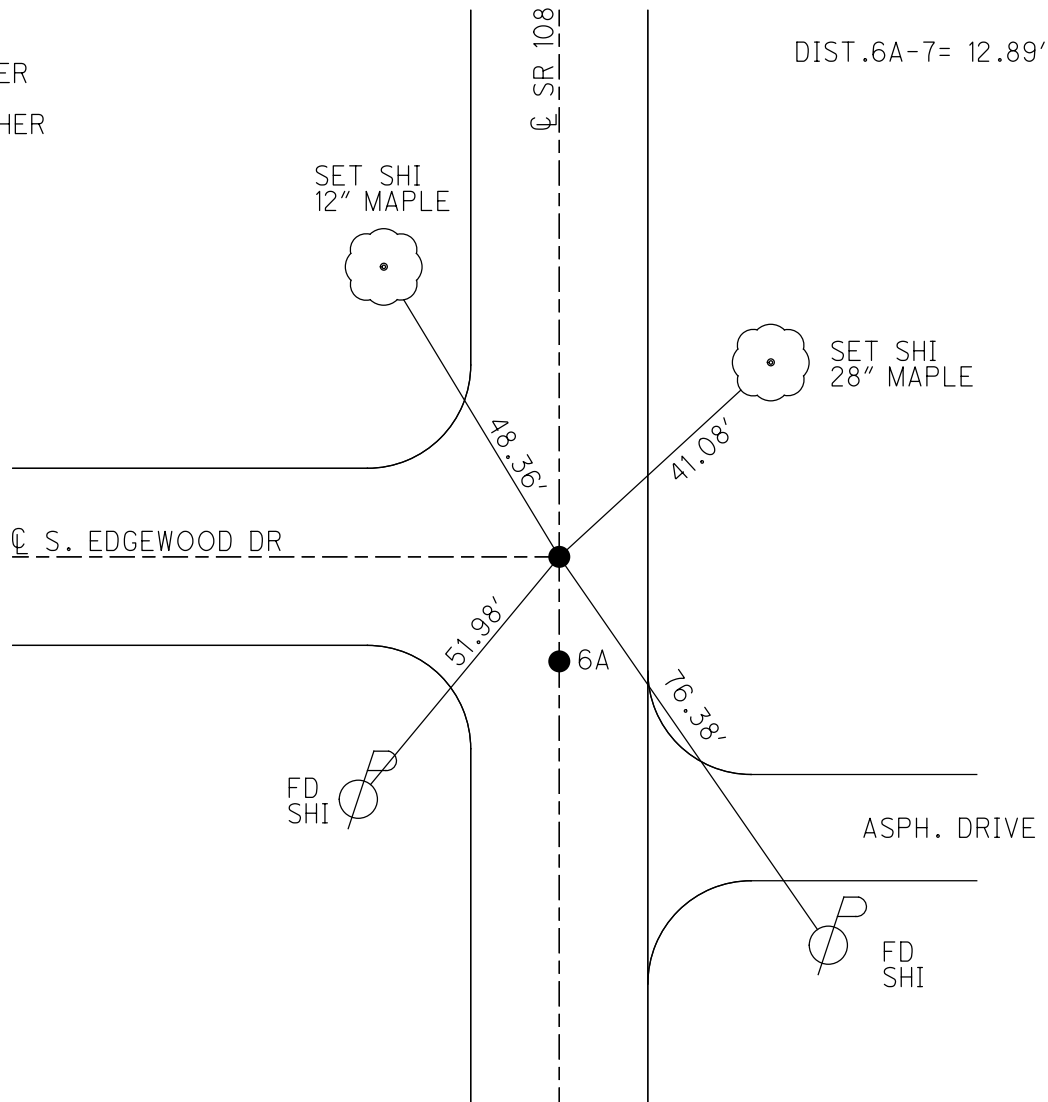

O.D.O.T. DISTRICT 2 SURVEY OFFICE

PERSONNEL _____

REFERENCE NO. 7

SHEET 8 OF 10

NOTES Moser

H.C. Barnhisel

R.C. Canterbury

DATE 7-14-00

WEATHER Fair

TEMP. +78°F

ROUTE SR-108


COUNTY Fulton

TOWNSHIP Clinton

SECTION 25

T 7 N R 6 E

TYPE MONUMENT (A), (B) - PK/W's
 ON SURFACE - BELOW surface
 LEFT - PAV'T. - RIGHT on E
10.4' TO RT. EDGE PAVEMENT
 S.L.M. (A) - 186+47 (B) - 186+70

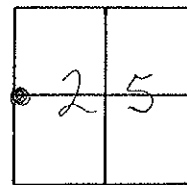

Set PK/W
 8-4-00
 KVM


Set N/shi
 12" Maple

Set N/shi
 28" Maple

Distance between
(A) - (B)
12.89'

Paint & Edgewood Dr
 (South)

Asph. Dr.

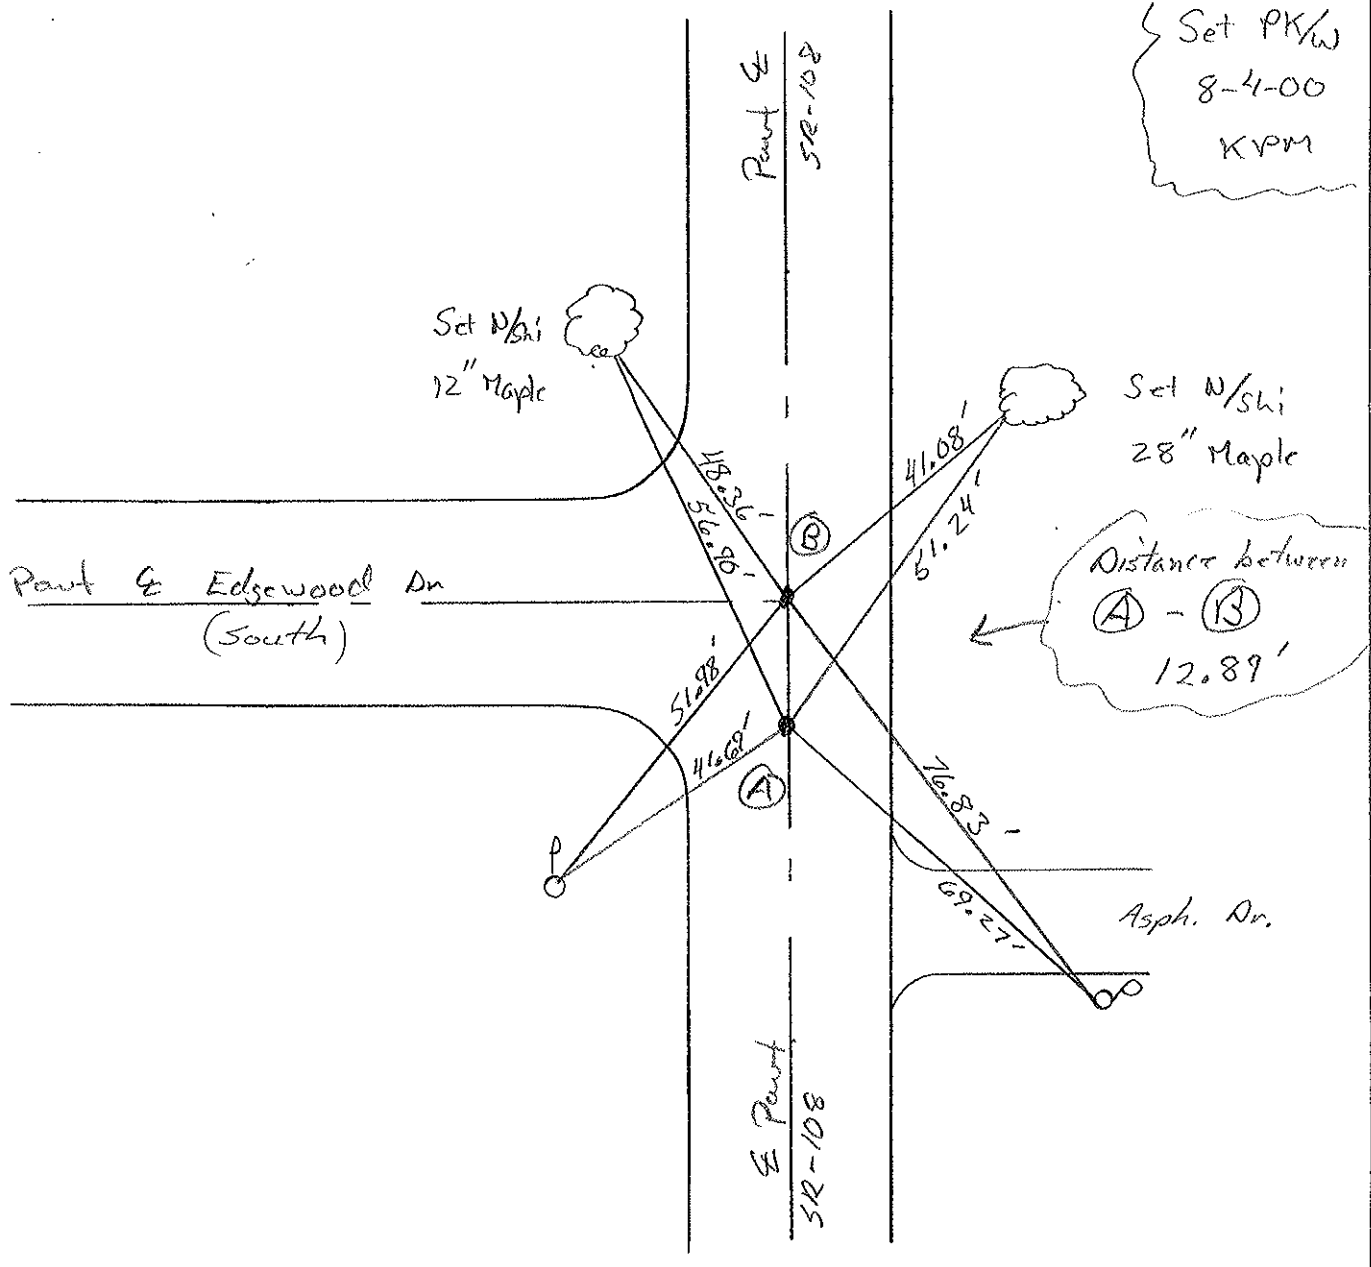

O.D.O.T. DISTRICT 2 SURVEY OFFICE

PERSONNEL _____

REFERENCE NO. 7

SHEET 8 OF _____

NOTES 1. Stone

H.C. D. Curtis

DATE 19 Oct. 88

ROUTE SR#108

R.C. J. Hausholder

WEATHER Coal

COUNTY Fulton

TEMP. 50°

TOWNSHIP Clifton

SECTION 25

T _____ R _____


TYPE MONUMENT A = PK Nail
B = PK Nail

ON SURFACE - BELOW Surface


LEFT - \odot PAW'T. - RIGHT _____

TO _____ EDGE PAVEMENT

S.L.M. A = 185+78 B = 185+91

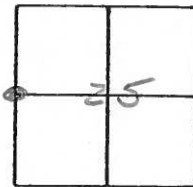

OK 6/7/89 IRS

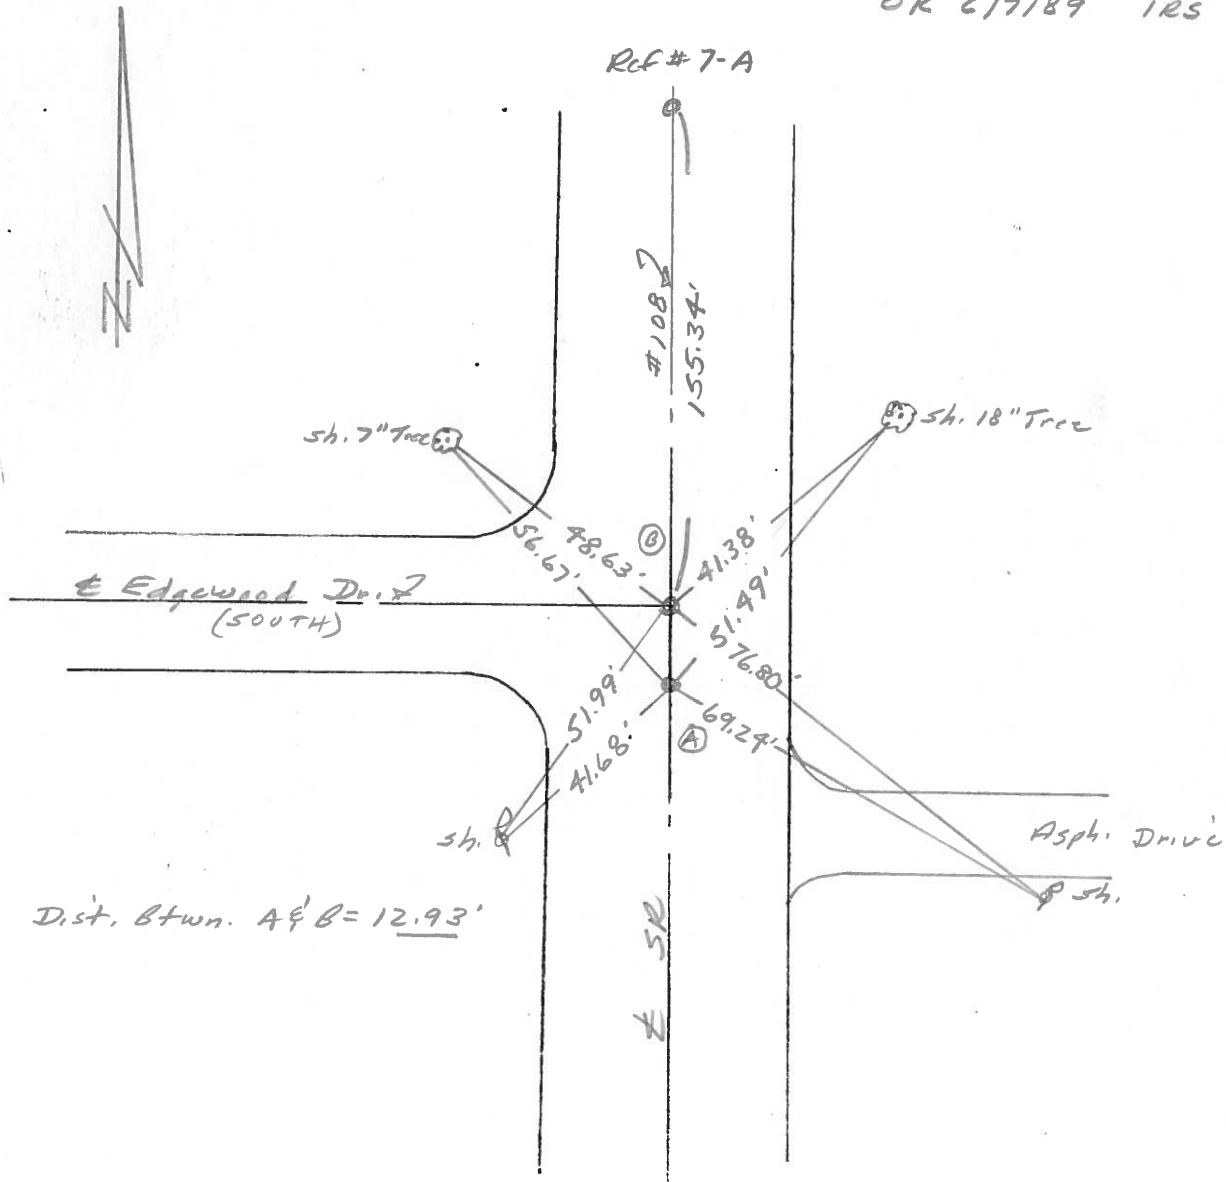

Dist. btwn. A & B = 12.93'

County Fulton S.R. 108

Township Clinton

Section 25

T N, R E

Personnel I. Stone


P. Newser

D. Curtis


Date OK-10-23-80 Bowers
30 Sept. 80

Weather Clear

Temp. 67°

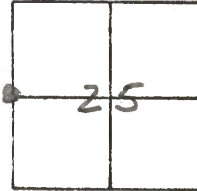


REF. NO. 7

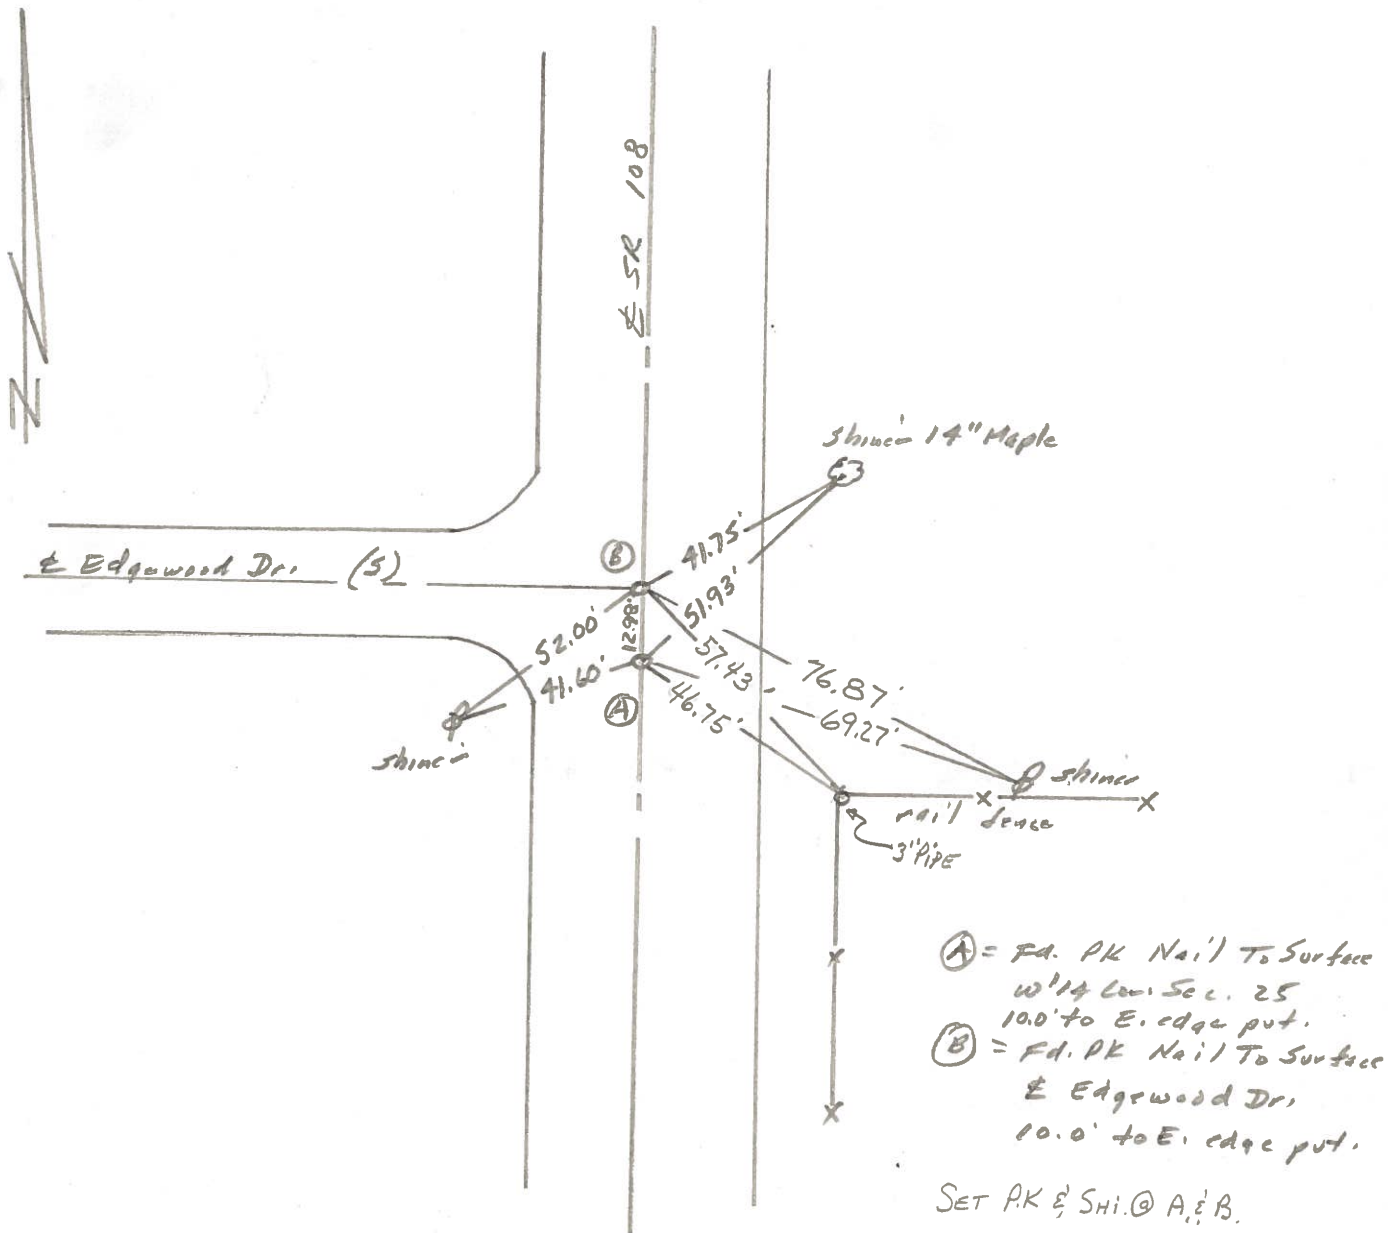

PERSONNEL	TITLE	PERSONNEL	TITLE	COUNTY	DATE	WEATHER	TEMP.
Tomsic				Fulton	April 20, 1973		
Weuser				S. R. 108			
Granata							
Vanyo							

DESCRIPTION	LEFT	CENTER LINE	RIGHT	JOB NO.
-------------	------	-------------	-------	---------

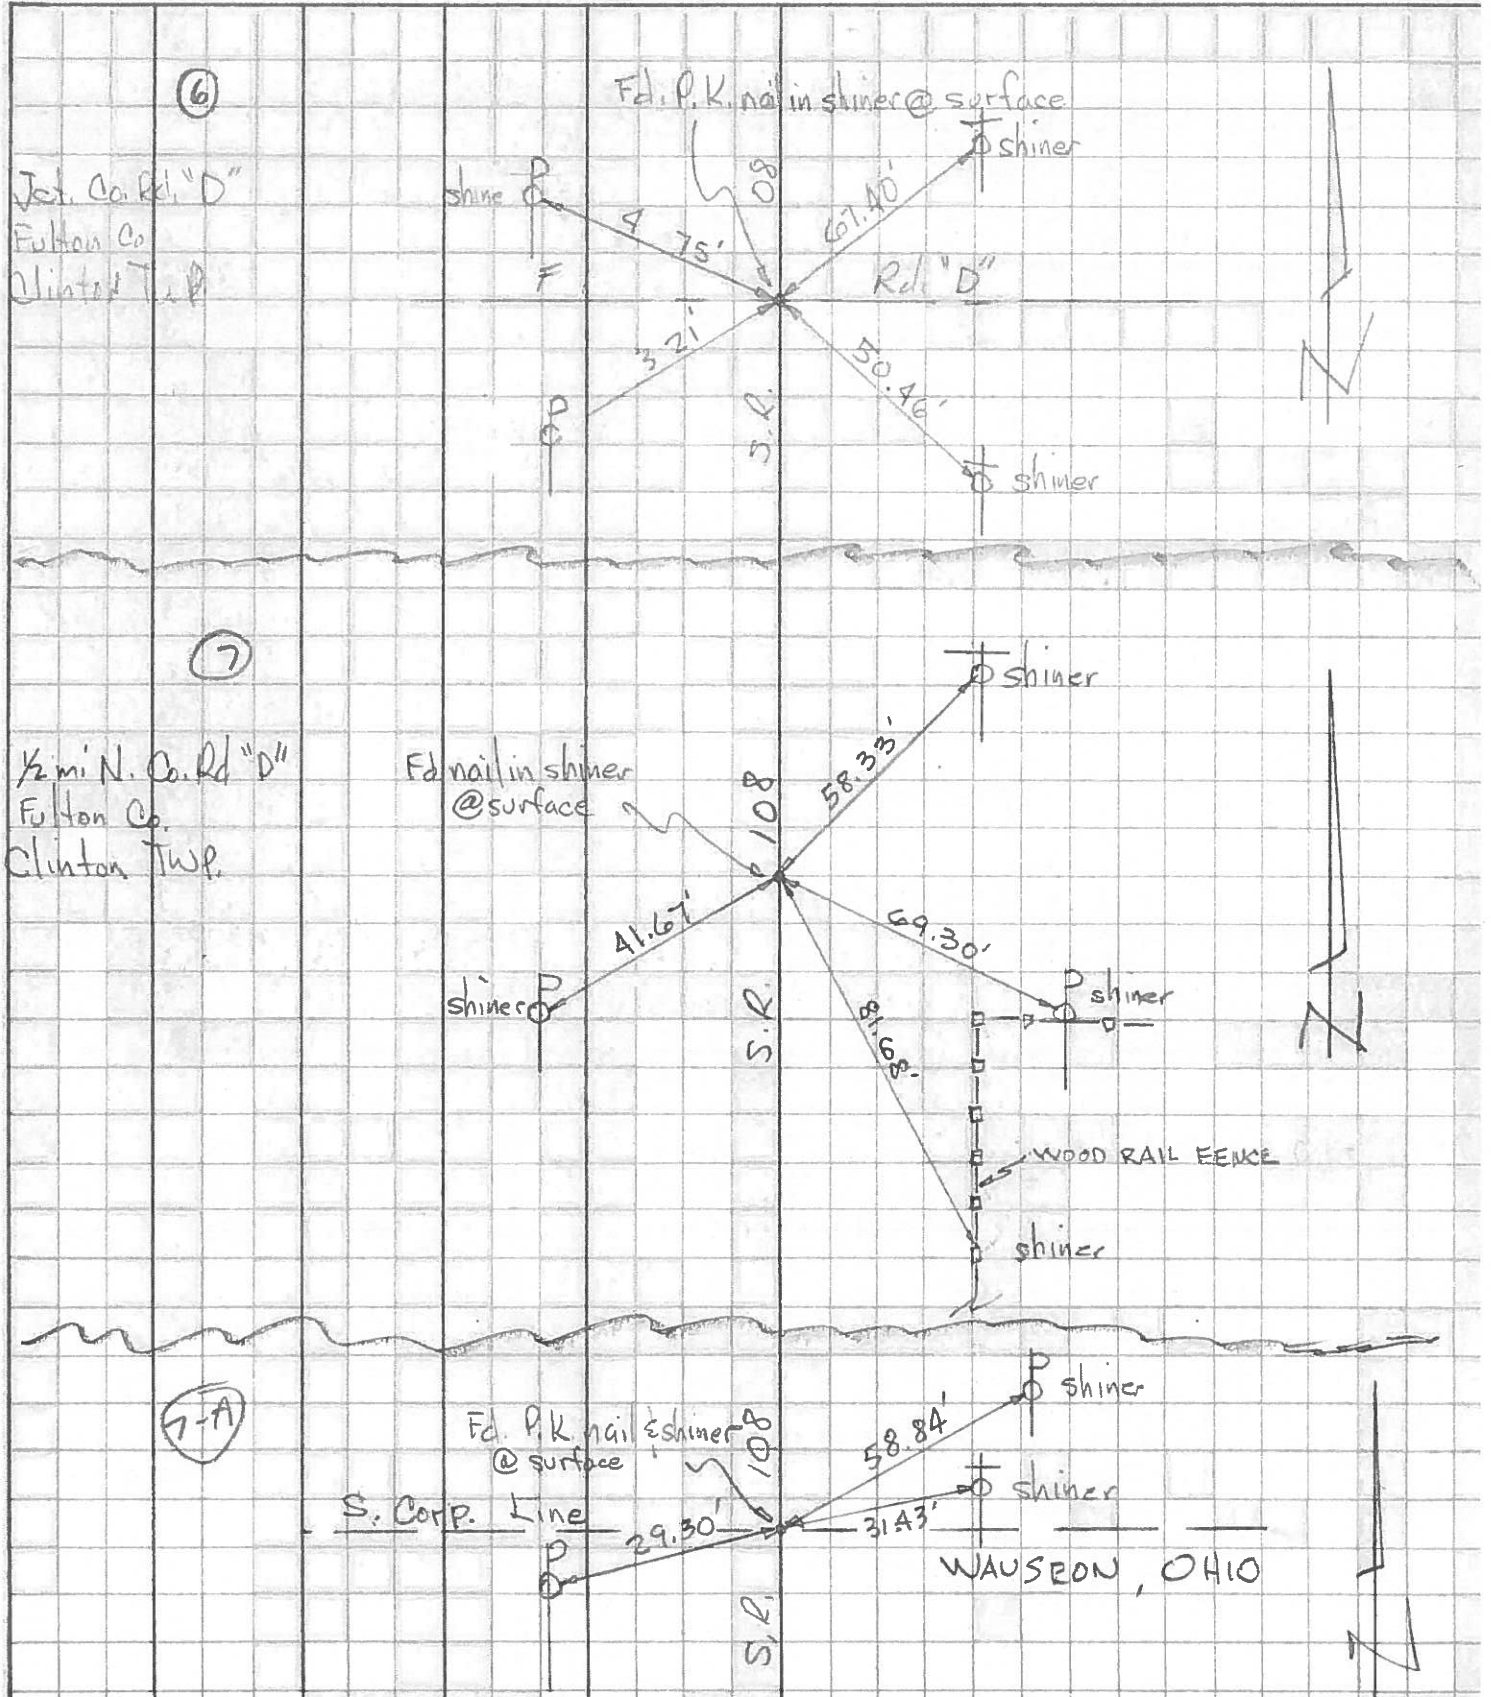

PERSONNEL	TITLE	PERSONNEL	TITLE	COUNTY	DATE
Langandor				Fulton	Aug. 11, 1958
Breese				S. R. 108 & 2	WEATHER Clear
Enyart				SEC. Wauseon	TEMP. 80°+
Robinson					
Williams					
DESCRIPTION	Men. References			JOB NO.	02292

