

O.D.O.T. DISTRICT 2 SURVEY OFFICE (USE ONLY)

PERSONNEL

REFERENCE NO. 7 B

SHEET 13 OF 17

NOTES RHOADES

DATE 7/14/21

ROUTE SR 108

H.C. NIESE

WEATHER HUMID

COUNTY FULTON

R.C. AUBLE

TEMP. 73°

TOWNSHIP CLINTON

SECTION 25

DWG BY WHITAKER

PID 92361

T 7 N R 6 E

TYPE MONUMENT P.K. NAIL

ON SURFACE - ~~BELOW~~ ON

OFFSET ☉ PAVEMENT ON LT : RT

10.4' TO RT EDGE PAVEMENT


STATION: 189+58

HORZ.DATUM: NAD83 (2011)


GEOID: 2012A

GRID: NORTHING: 685940.655

EASTING: 1521110.334

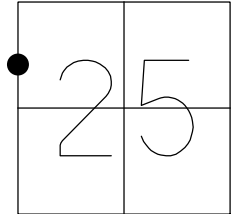

RECORD:  
 FD P.K./WASHER  
 7/14/00, KPM  
 SET P.K./WASHER  
 8/4/00, KPM  
 FD P.K. NAIL  
 REFB7  
 9/16/19, JFO  
 SET MAG/WASHER  
 REFB7  
 7/19/22, TDN

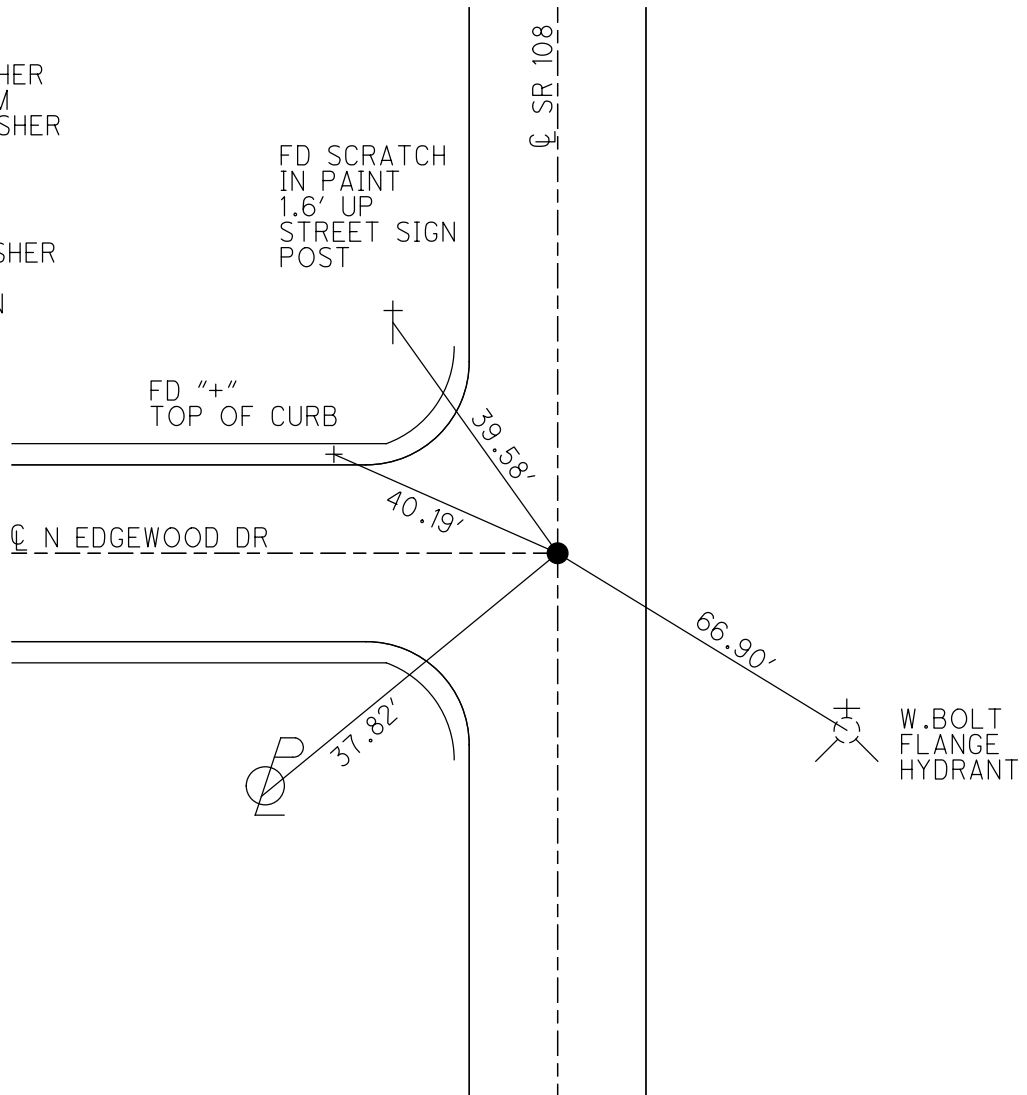

O.D.O.T. DISTRICT 2 SURVEY OFFICE (USE ONLY)

PERSONNEL

REFERENCE NO. 7 B

SHEET 13 OF 17

NOTES MOSE

DATE 7/14/00

ROUTE SR 108

H.C. BARNHISEL

WEATHER FAIR

COUNTY FULTON

R.C. CANTERBURY

TEMP. 78°

TOWNSHIP CLINTON

DWG BY NIESE PID \_\_\_\_\_

SECTION 25

T 7 N R 6 E

TYPE MONUMENT P.K./WASHER

ON SURFACE - ~~BELOW~~ ON

OFFSET Q PAVEMENT ON LT : RT

10.4' TO RT EDGE PAVEMENT


STATION: 189+58

HORZ.DATUM: \_\_\_\_\_


GEOID: \_\_\_\_\_

GRID: NORTHING: \_\_\_\_\_

EASTING: \_\_\_\_\_

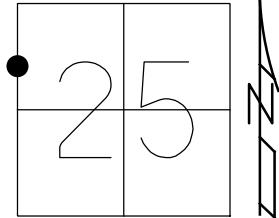

RECORD:  
FD P.K./WASHER  
7/14/00, KPM  
SET P.K./WASHER  
8/4/00, KPM

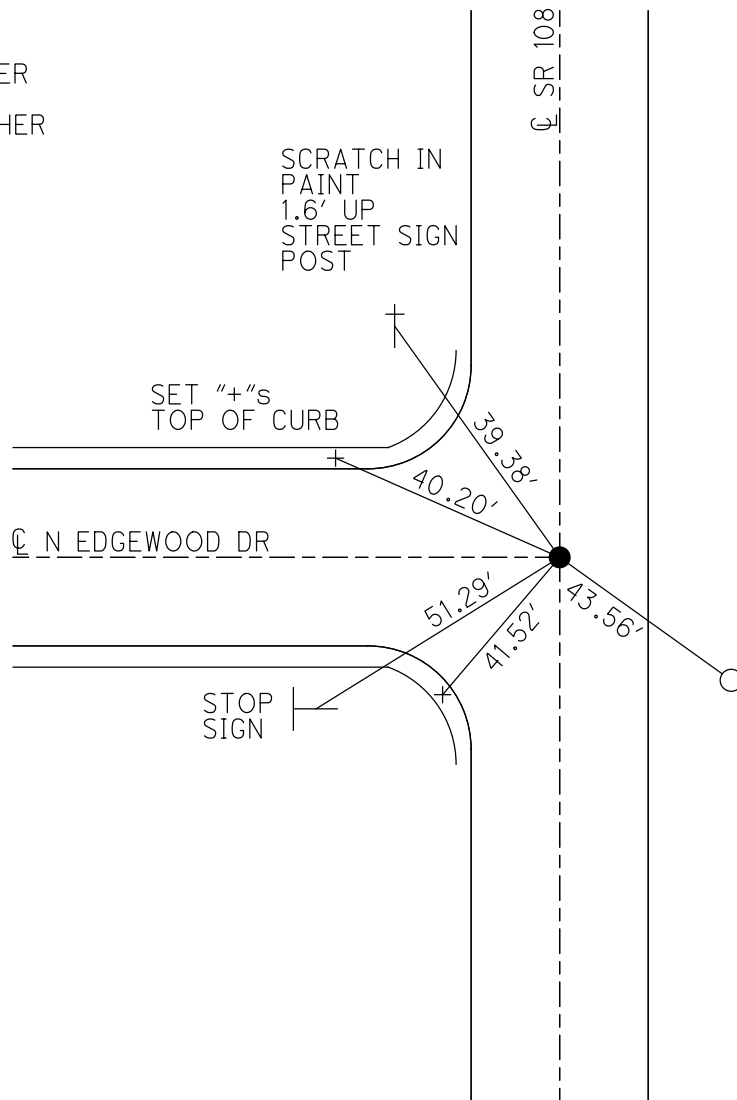

# O.D.O.T. DISTRICT 2 SURVEY OFFICE

PERSONNEL \_\_\_\_\_

REFERENCE NO. 7-B

SHEET 10 OF 10

NOTES Moser

H.C. Barnhisel

R.C. Canterbury

DATE 7-14-60

WEATHER Fair

TEMP. 178°F

ROUTE SR-108

COUNTY Fulton

TOWNSHIP Clinton

SECTION 25

T 7 N R 6 E


TYPE MONUMENT PK/W

ON SURFACE - BELOW Surface


LEFT - ☉ PAV'T. - RIGHT ☉

10.4 TO Rt EDGE PAVEMENT

S.L.M. 189 + 58

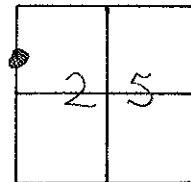

Set PK/W  
8-4-00  
K.P.M.

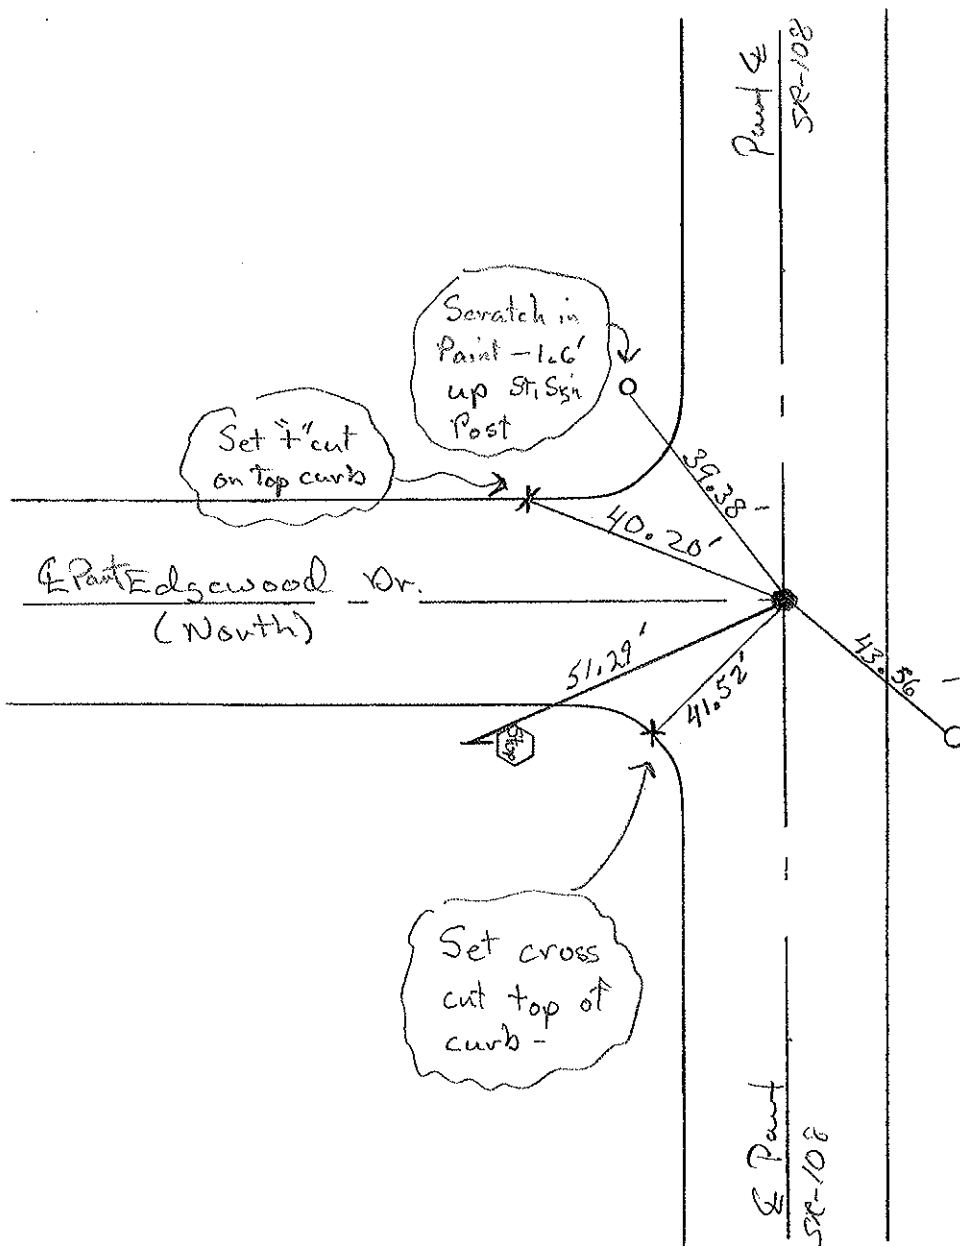

# O.D.O.T. DISTRICT 2 SURVEY OFFICE

PERSONNEL \_\_\_\_\_

REFERENCE NO. 7-B

SHEET 10 OF \_\_\_\_\_

NOTES 1. Stone

H.C. D. Curtis

DATE 19 Oct. 88

ROUTE SR #108

R.C. J. Householder

WEATHER Cool

COUNTY Fulton

TEMP. 51°

TOWNSHIP Clinton

SECTION 25

T. \_\_\_\_\_ R. \_\_\_\_\_


TYPE MONUMENT PK Nail

ON SURFACE - BELOW Surface


LEFT -  $\odot$  PAV'T. - RIGHT \_\_\_\_\_

\_\_\_\_\_ TO \_\_\_\_\_ EDGE PAVEMENT

S.L.M. 188 + 89

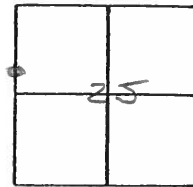

OK 6/7/89 1RS

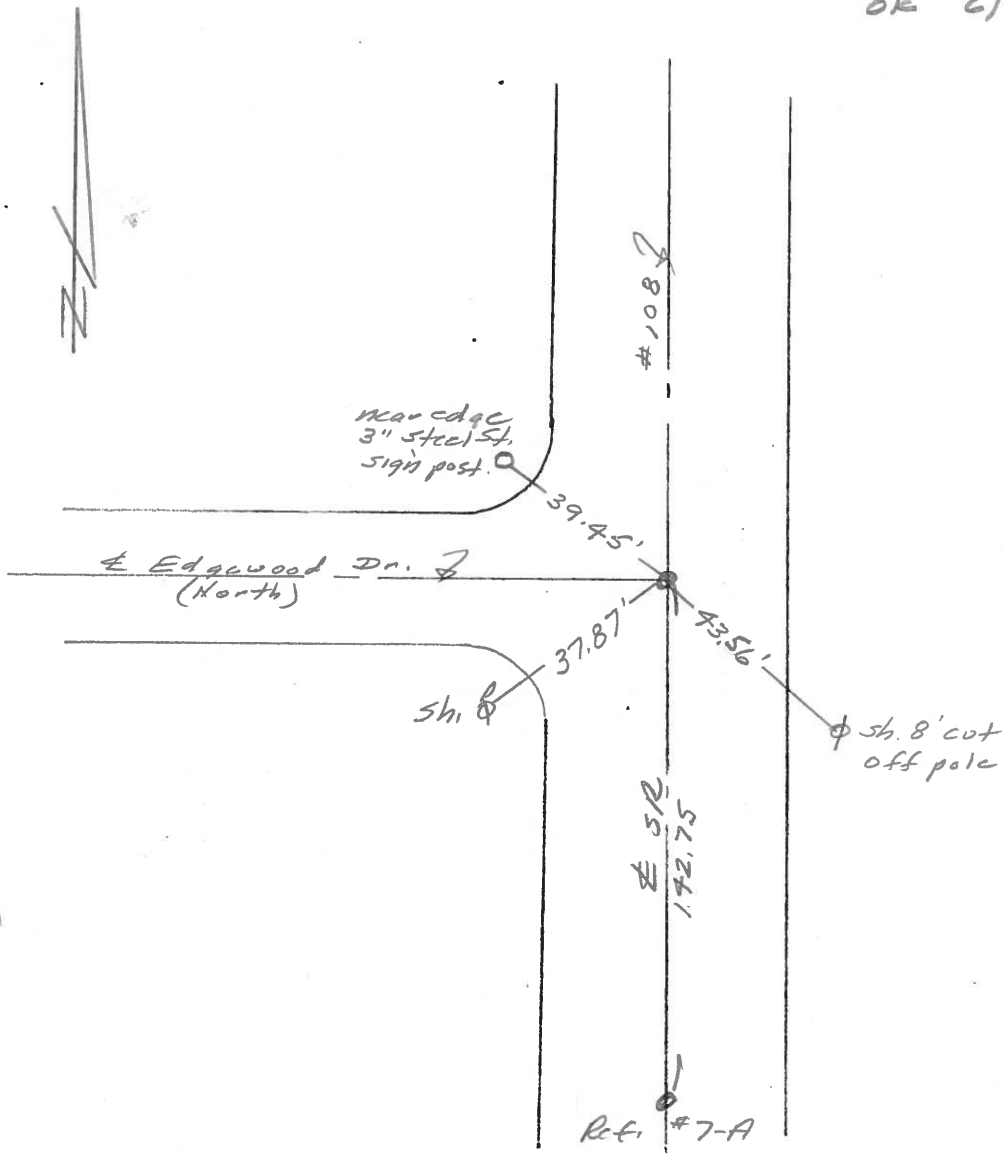

O.D.O.T. DISTRICT 2 SURVEY OFFICE

SHEET 10 OF

County Fulton S.R. 108

Township Clinton

Section 25

T    N, R    E

Personnel I. Stone

P. Neuse

D. Curtis


                  

Date 30 Sept. 80


Weather Clear

Temp. 69°

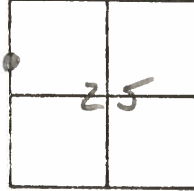

(END POINT CHECK)

REF. NO. 7-B

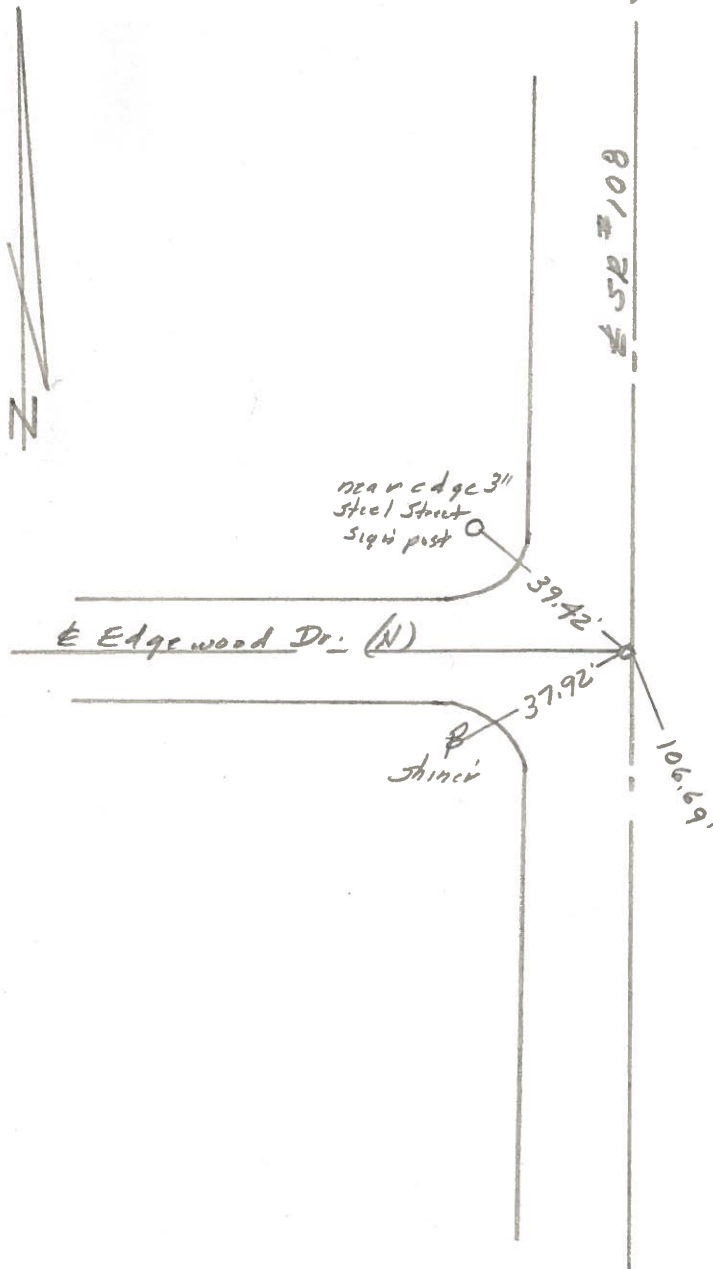

FD. PK Nail To Surface  
10.4' to E. edge put.

SET P.K. & SHI.

shim