


O.D.O.T. DISTRICT 2 SURVEY OFFICE (USE ONLY)


PERSONNEL _____ REFERENCE NO. 7 C SHEET 14 OF 17
 NOTES RHOADES DATE 7/14/21 ROUTE SR 108
 H.C. NIESE WEATHER CLOUDY COUNTY FULTON
 R.C. AUBLE TEMP. 73° TOWNSHIP CLINTON
 DWG BY WHITAKER PID 92361 SECTION 24
 T 7 N R 6 E

TYPE MONUMENT MONBOX W/ 1" IPIN
~~ON SURFACE~~ - BELOW 0.2'
 OFFSET ϕ PAVEMENT 4.1' \pm : RT
 - TO - EDGE PAVEMENT
 STATION: 212+25.6

HORZ.DATUM: NAD83(2011) GEOID: 2012A
 GRID: NORTHING: 688277.325 EASTING: 1521144.156

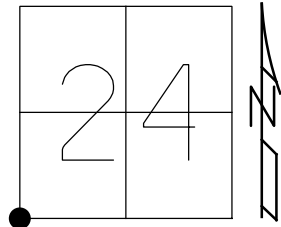

RECORD:
 MONBOX
 W/ 1" IPIN
 3/6/02, MB
 REFC7
 9/16/19, JFO
 7/19/22, TDN

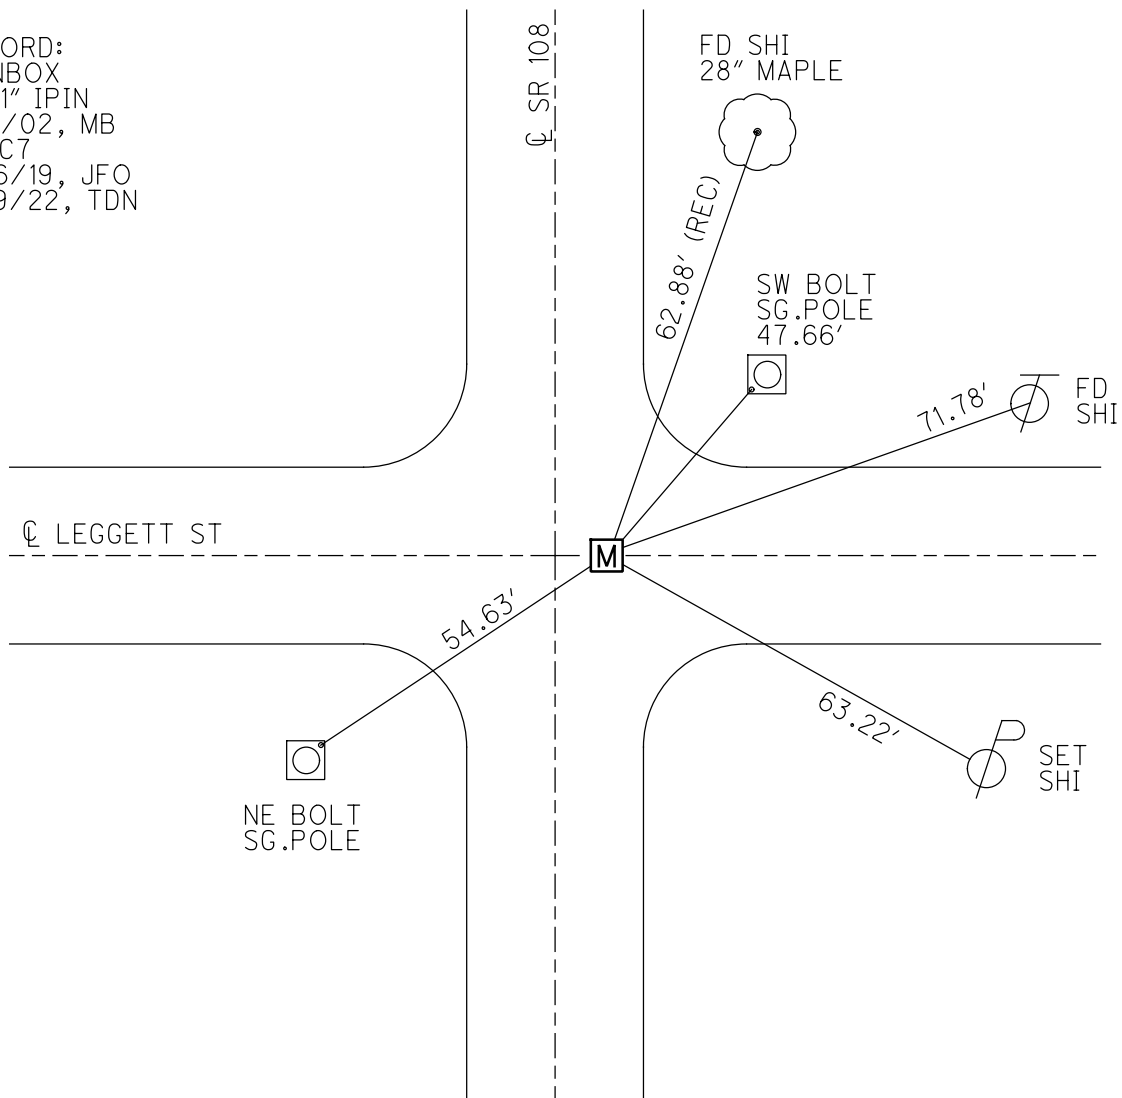

O.D.O.T. DISTRICT 2 SURVEY OFFICE (USE ONLY)

PERSONNEL

REFERENCE NO. 7 C

SHEET 14 OF 17

NOTES BARNHISEL

DATE 3/6/02

ROUTE SR 108

H.C. CANTERBURY

WEATHER SUNNY

COUNTY FULTON

R.C. MOSER

TEMP. 47°

TOWNSHIP CLINTON

SECTION 24

DWG BY NIESE PID _____

T 7 N R 6 E

TYPE MONUMENT MONBOX W/ 1" IPIN

~~ON SURFACE~~ - BELOW 0.2'

OFFSET \odot PAVEMENT 4.1' ~~LT~~ : RT

- TO - EDGE PAVEMENT


STATION: 212+25.6

HORZ.DATUM: _____


GEOID: _____

GRID: NORTHING: _____

EASTING: _____

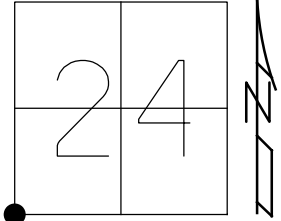

RECORD:
MONBOX
W/ 1" IPIN
3/6/02, MB

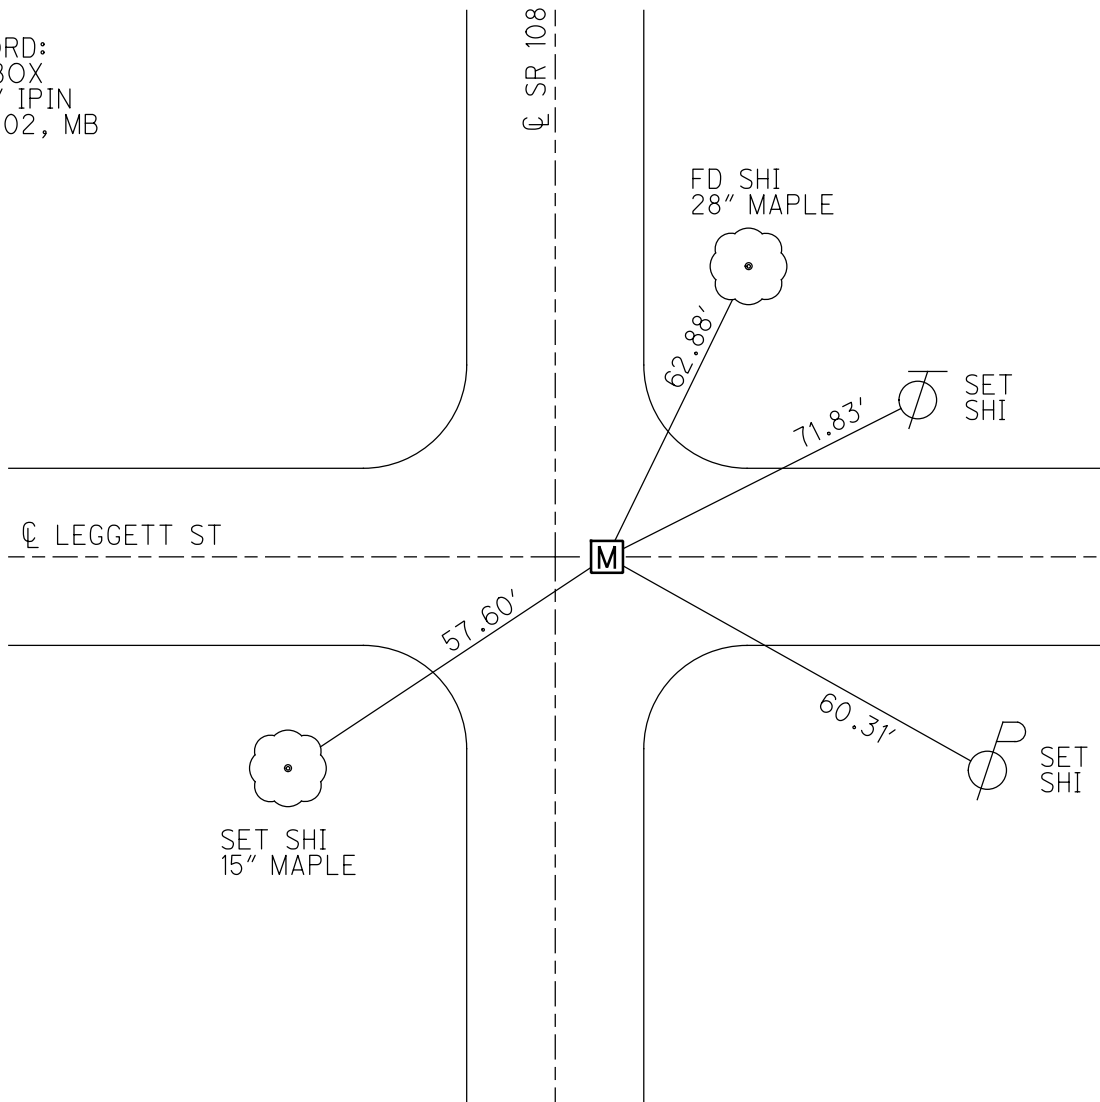

O.D.O.T. DISTRICT 2 SURVEY OFFICE

PERSONNEL _____

REFERENCE NO. 7C SHEET _____ OF _____

NOTES BARNHISEL

H.C. CANTERBURY

R.C. MOSEK

DATE 3-6-02

WEATHER SUNNY

TEMP. +47°

ROUTE 108

COUNTY FULTON

TOWNSHIP CLINTON

SECTION 23

T 7 N 6 R 6 E



TYPE MONUMENT Mon. Box 1" Rod

ON SURFACE - BELOW 0.2'

LEFT - ℄ PAV'T. - RIGHT 4.1'

℄ TO — EDGE PAVEMENT ON ℄ PART ℄℄





S.L.M. 212+25.60

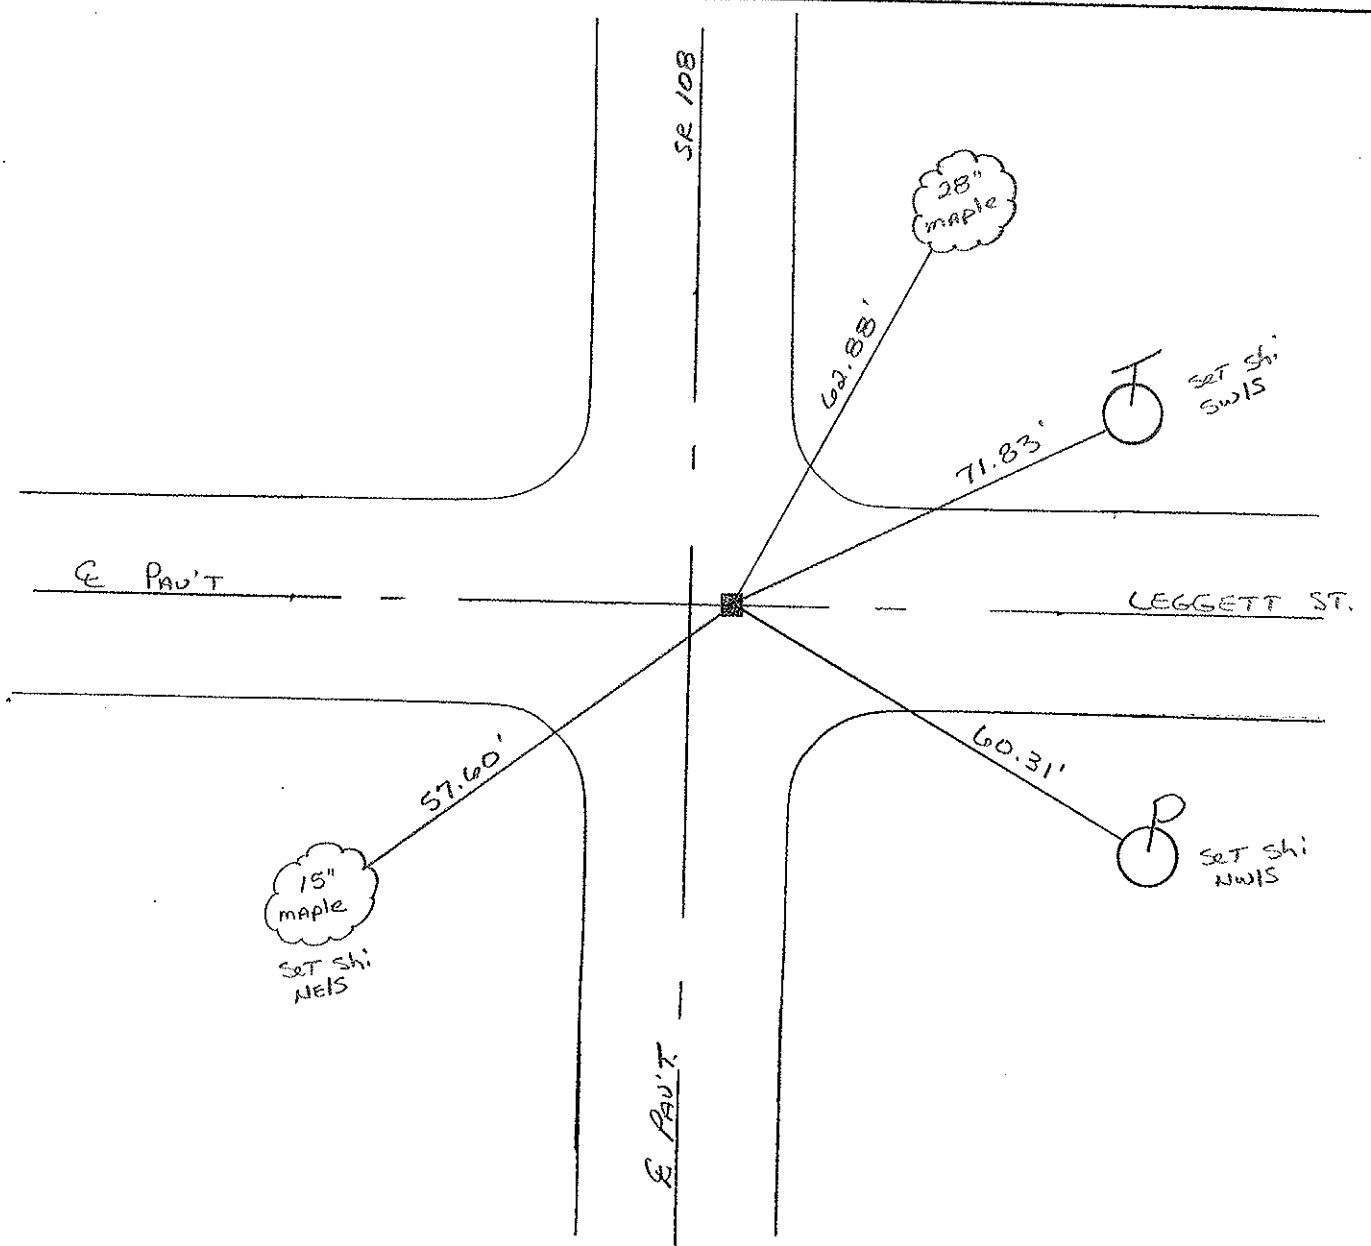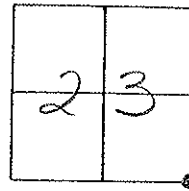


PERSONNEL TITLE PERSONNEL TITLE
 Red Beach
 Newcomb
 Knape
 Wise

COUNTY FULTON DATE 30 May 1970
 S. R. 108 WEATHER _____
 SEC Clinton Twp. T-7-N R-6E TEMP. _____

DESCRIPTION CONTROL POINTS JOB NO. _____

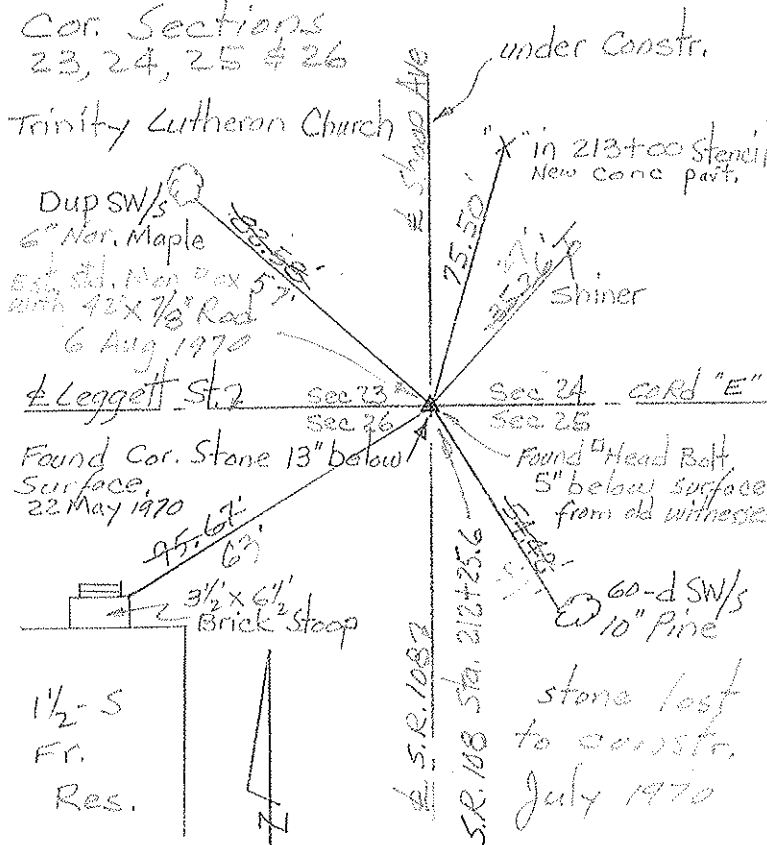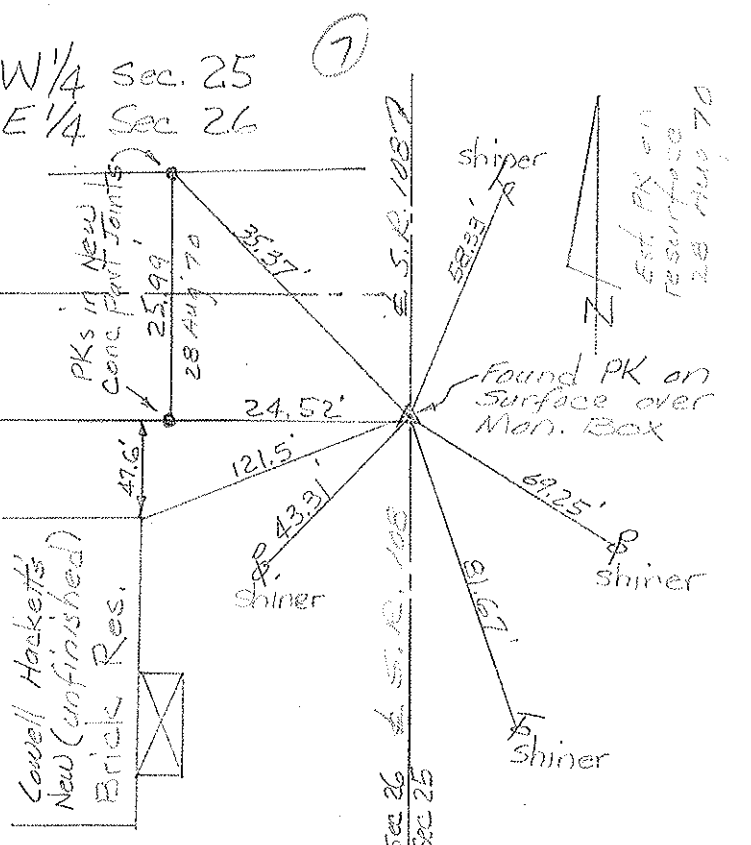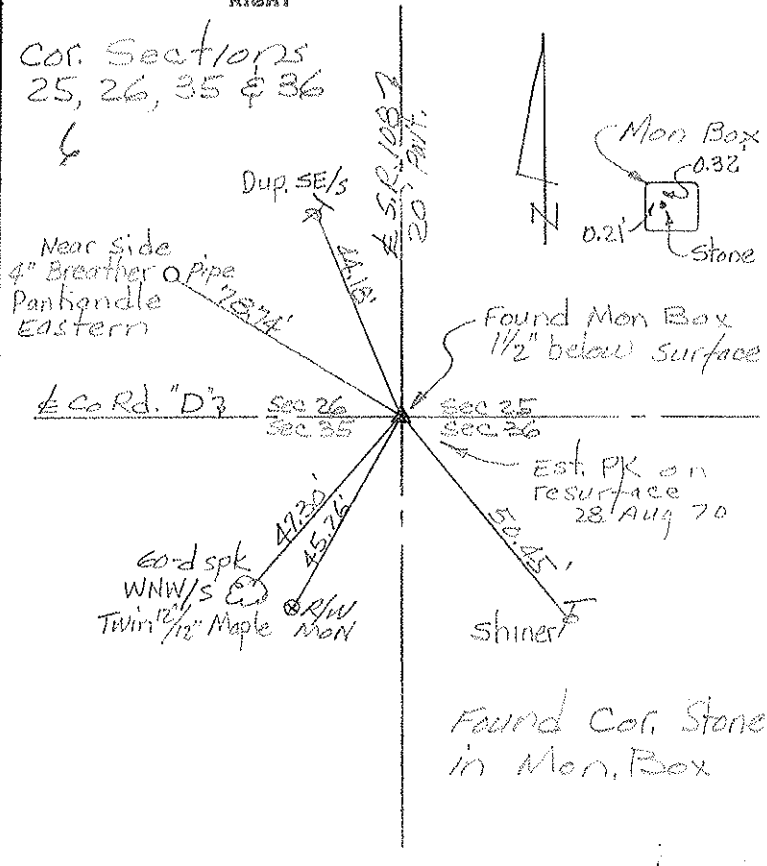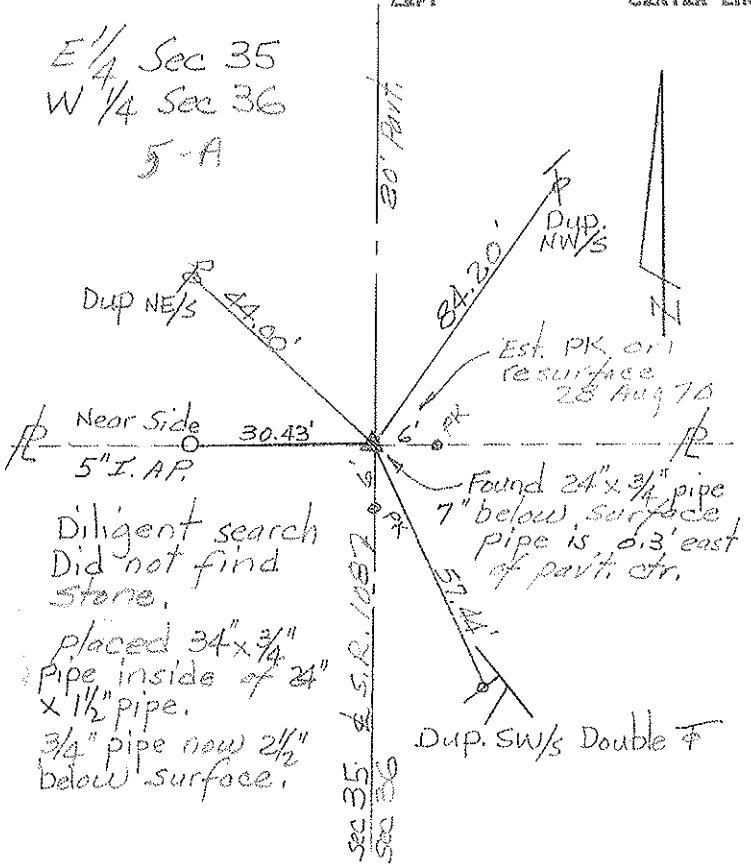


PERSONNEL	TITLE	PERSONNEL	TITLE	COUNTY	DATE
Longenbacher				Fulton	Aug. 12, 1958
Braese				S. R. 108 & 2	WEATHER Partly cloudy
Enyart				SEC. Wausau	TEMP. 80+
Robinson					
Williams					
DESCRIPTION	Center Line Survey				JOB NO. 02292

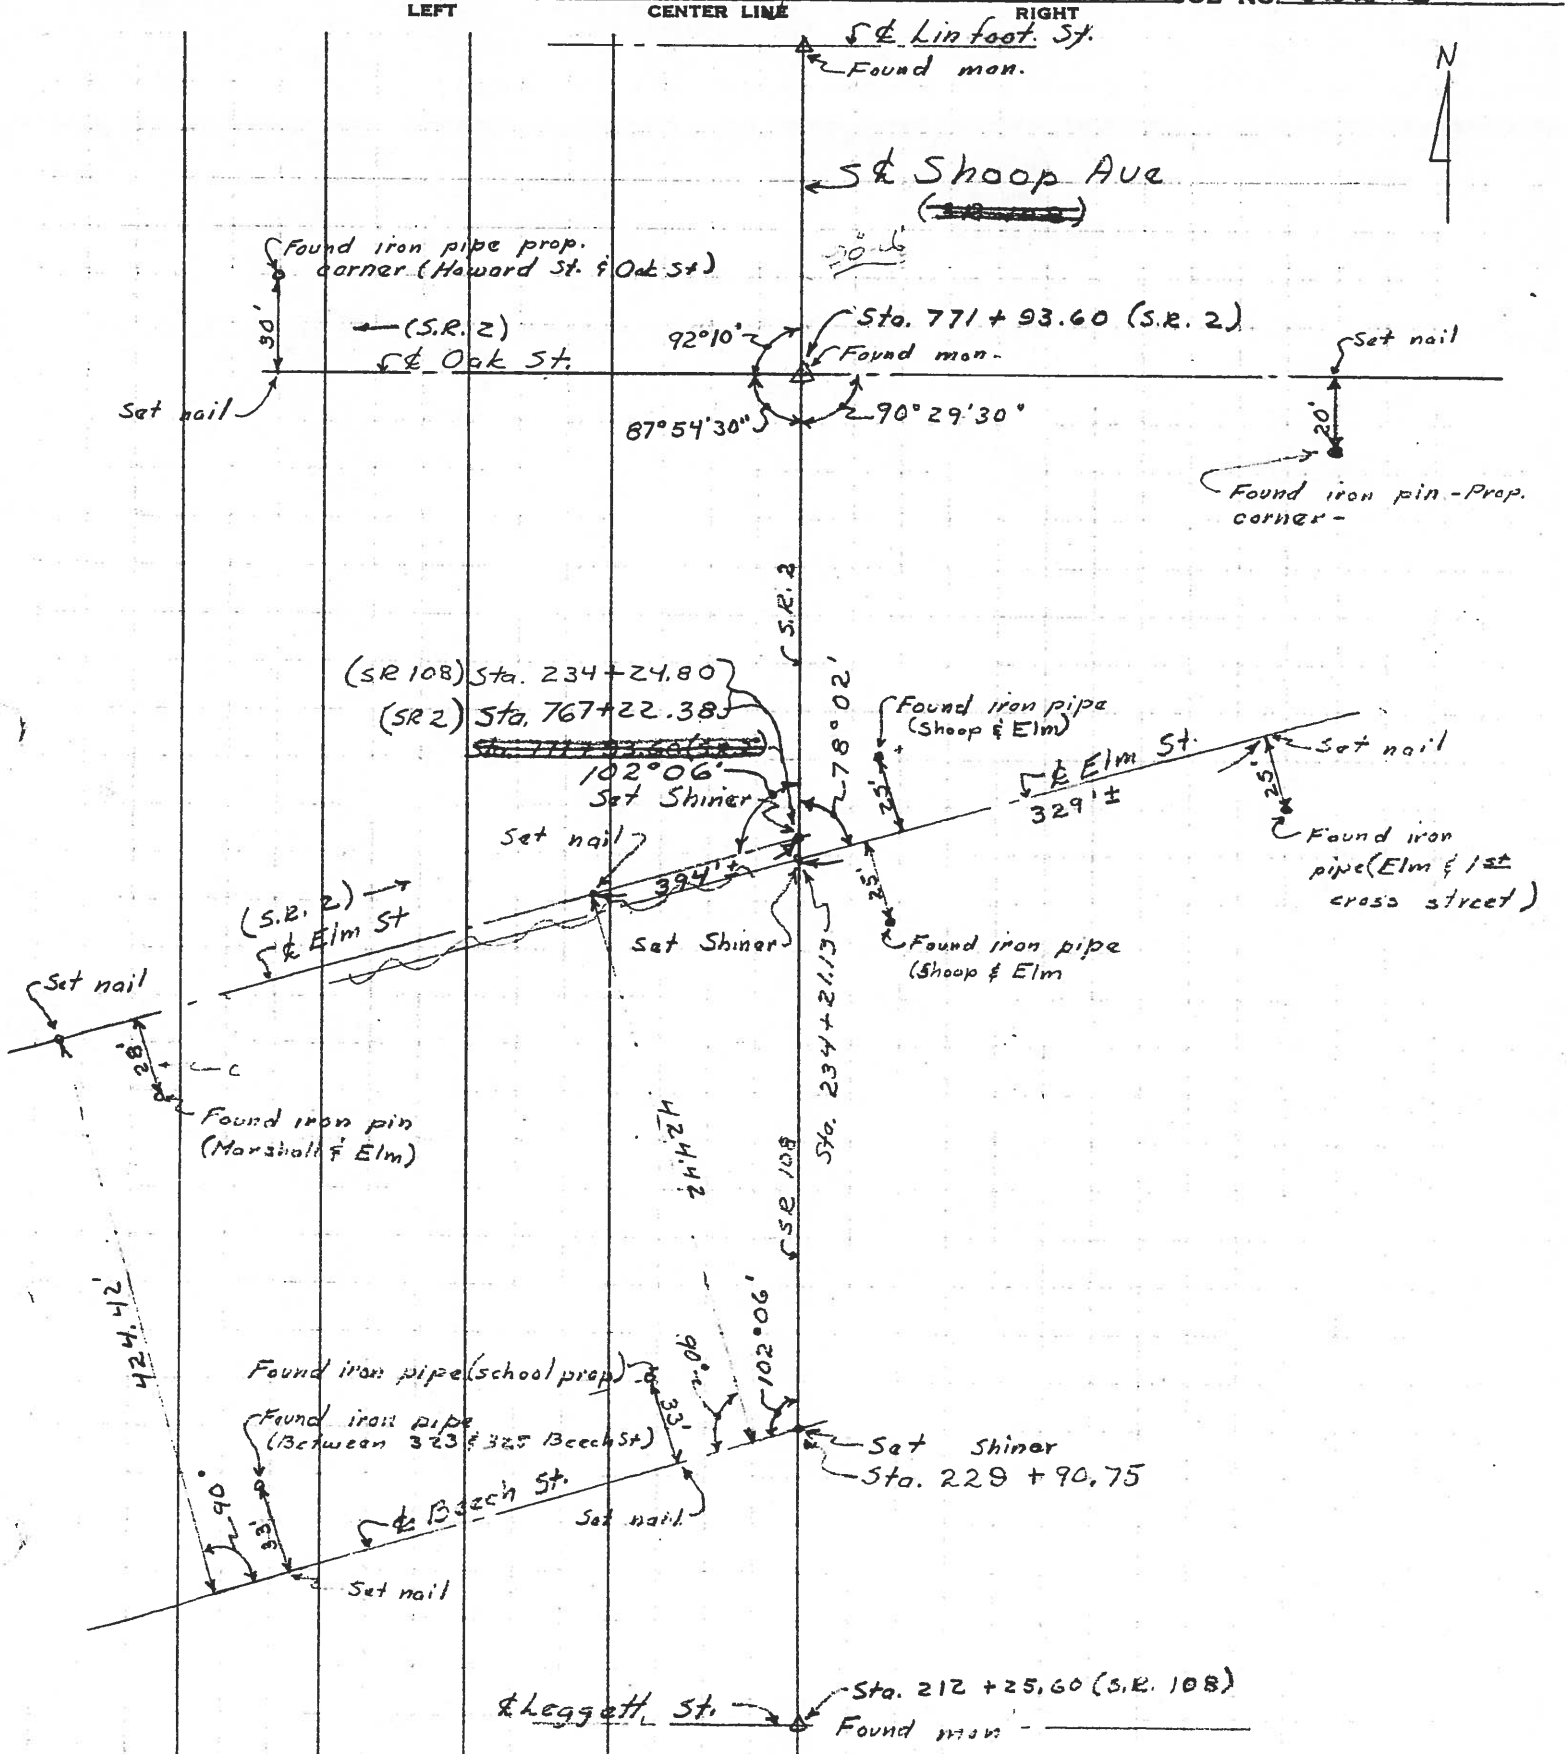

PERSONNEL	TITLE	PERSONNEL	TITLE	COUNTY	DATE
Longenderfer				Fulton	Aug. 11, 1958
Greese				S. R. 108 & 2	WEATHER Clear
Enyart				SEC. Wauseon	TEMP. 80°+
Robinson					
Williams					
DESCRIPTION	Men. References				JOB NO. 02292

LEFT CENTER LINE RIGHT

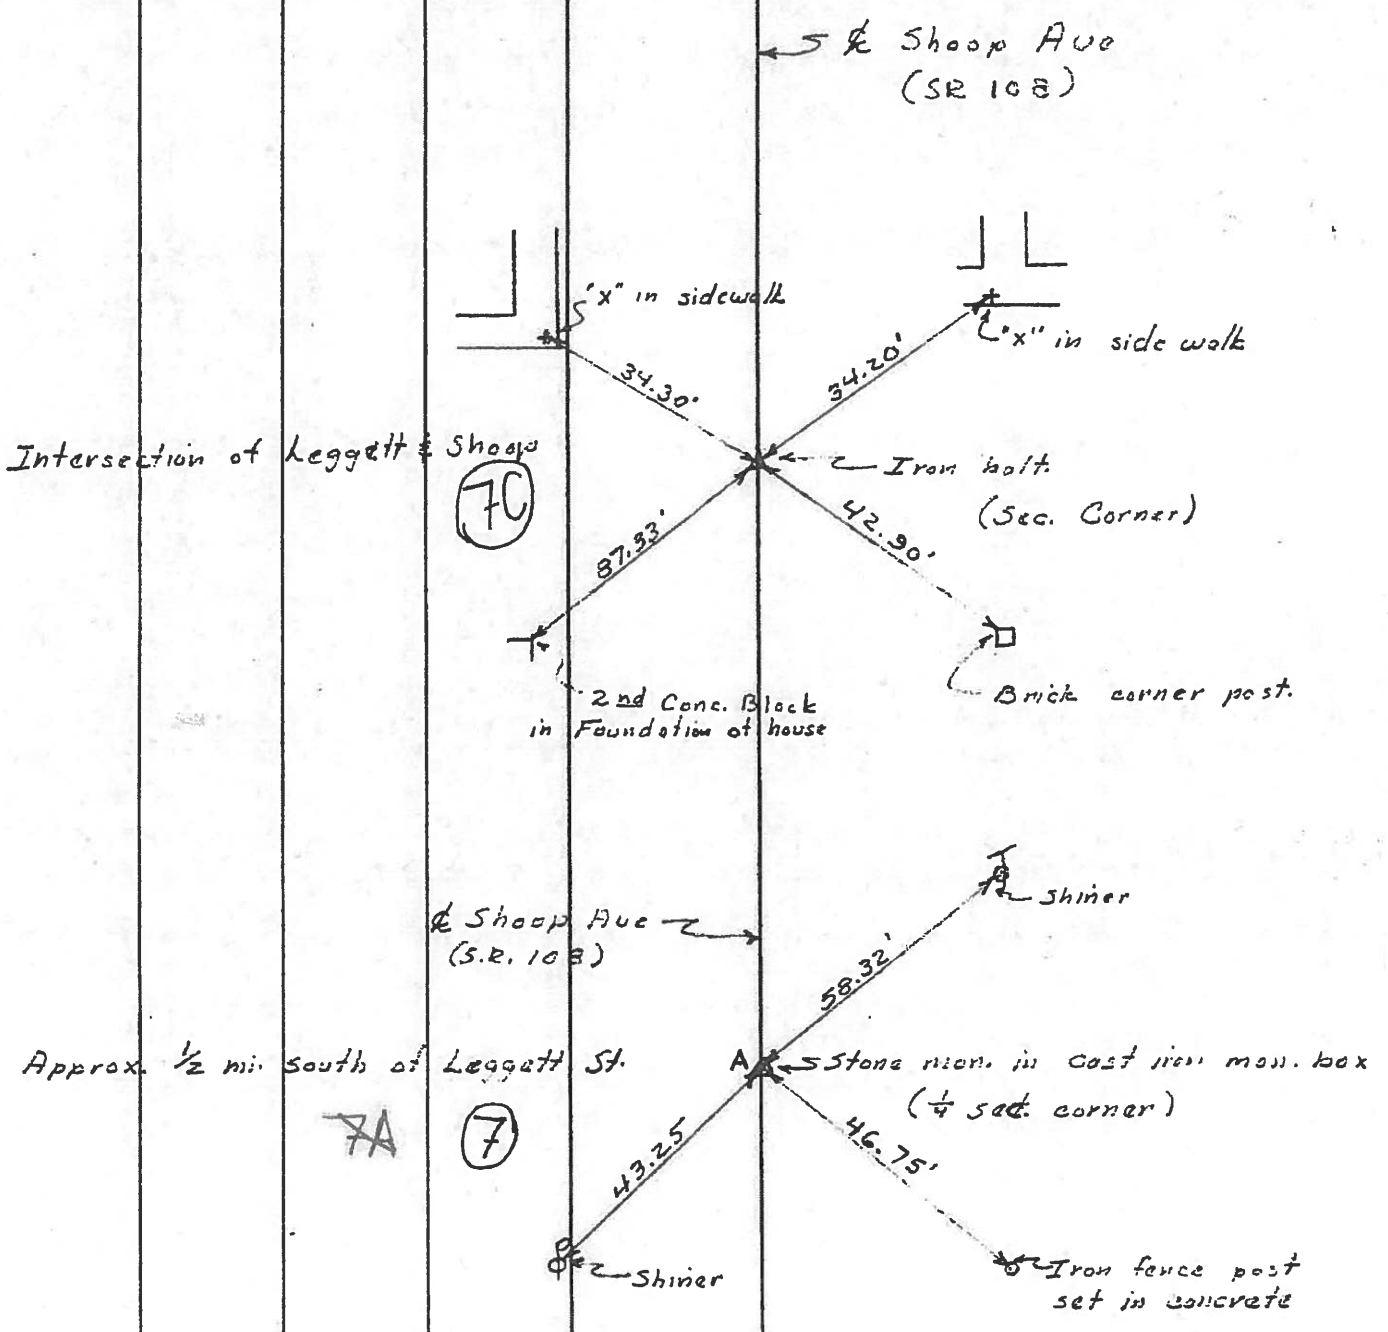

PERSONNEL	TITLE	PERSONNEL	TITLE	COUNTY	DATE
Langenderfer				Fulton	Aug. 11, 1958
Breese				S. R. 108 th	WEATHER Clear
Enyart				SEC. Wauseon	TEMP. 80 ⁺
Rabunian					JOB NO. 02292
Williams					

Mon. References

