

O.D.O.T. DISTRICT 2 SURVEY OFFICE (USE ONLY)

PERSONNEL \_\_\_\_\_

REFERENCE NO. 7 DE

SHEET 16 OF 17

NOTES BARNHISEL DATE 3/6/02  
 H.C. CANTERBURY WEATHER SUNNY  
 R.C. MOSER TEMP. 47°

ROUTE SR 108  
 COUNTY FULTON  
 TOWNSHIP CLINTON  
 SECTION 24  
 T 7 N R 6 E

DWG BY NIESE PID \_\_\_\_\_

TYPE MONUMENT P.K. NAIL

ON SURFACE - ~~BELOW~~ ON

OFFSET  $\varnothing$  PAVEMENT 4.0' ~~LT~~ : RT

- TO - EDGE PAVEMENT


STATION: 218+22.78

HORZ. DATUM: \_\_\_\_\_

GEOID: \_\_\_\_\_


GRID: NORTHING: \_\_\_\_\_

EASTING: \_\_\_\_\_

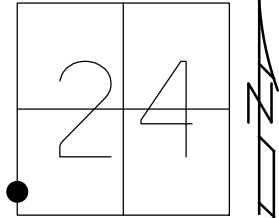

RECORD:  
 FD P.K. NAIL  
 3/6/02, MR  
 D.N.F.  
 9/16/19, JFO

DIST. 7D-7DE = 0.2'

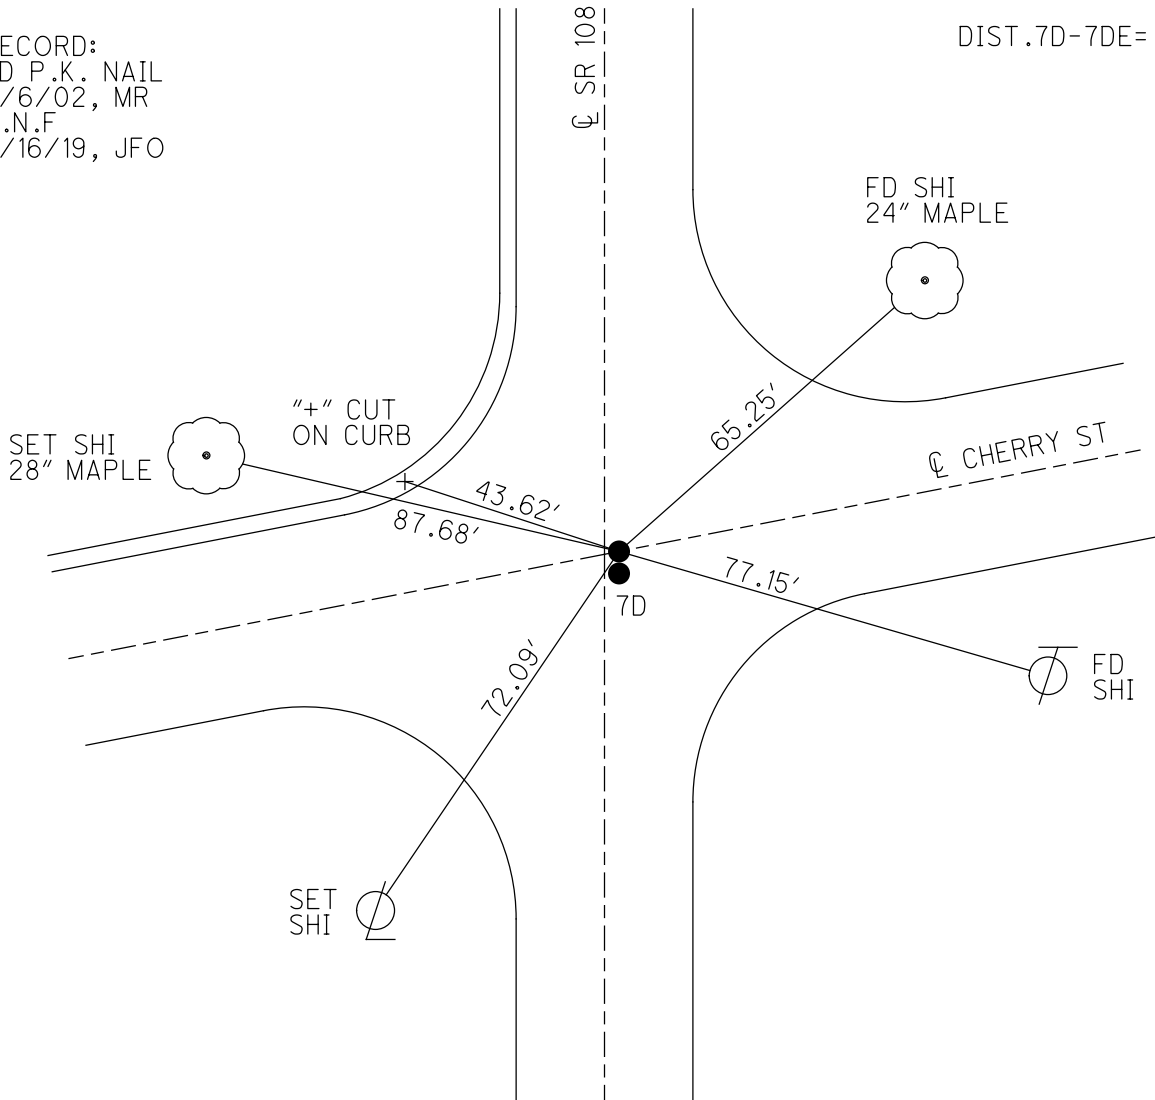

O.D.O.T. DISTRICT 2 SURVEY OFFICE (USE ONLY)

PERSONNEL \_\_\_\_\_

REFERENCE NO. 7 DE

SHEET 16 OF 17

NOTES BARNHISEL

DATE 3/6/02

ROUTE SR 108

H.C. CANTERBURY

WEATHER SUNNY

COUNTY FULTON

R.C. MOSE

TEMP. 47°

TOWNSHIP CLINTON

DWG BY NIESE PID \_\_\_\_\_

SECTION 24

T 7 N R 6 E

TYPE MONUMENT P.K. NAIL

ON SURFACE - ~~BELOW~~ ON \_\_\_\_\_


OFFSET  $\varnothing$  PAVEMENT 4.0' ~~LT~~ : RT

- TO - EDGE PAVEMENT

STATION: 218+22.78


HORIZ.DATUM: \_\_\_\_\_ GEOID: \_\_\_\_\_

GRID: NORTHING: \_\_\_\_\_ EASTING: \_\_\_\_\_

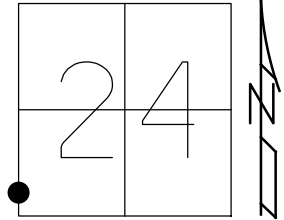

RECORD:  
FD P.K. NAIL  
3/6/02, MR

DIST. 7D-7DE = 0.2'

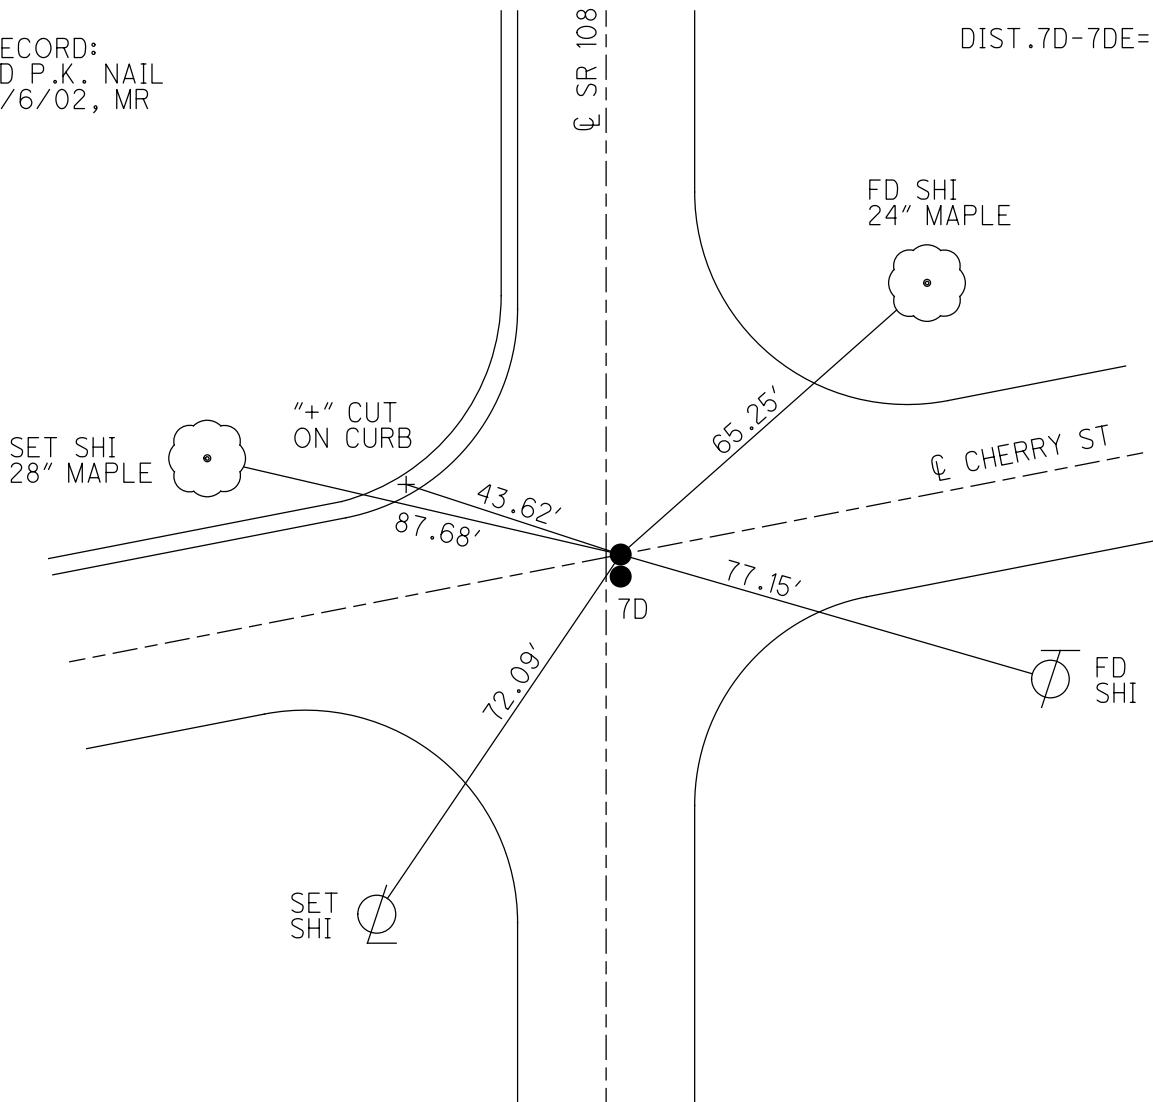

# O.D.O.T. DISTRICT 2 SURVEY OFFICE

PERSONNEL \_\_\_\_\_

REFERENCE NO. 70

SHEET \_\_\_\_\_ OF \_\_\_\_\_

NOTES BARNHISEL

H.C. CANTERBURY

DATE 3-6-02

ROUTE 108

R.C. MOSEL

WEATHER SUNNY

COUNTY FULTON

TEMP. +47°

TOWNSHIP CLINTON

SECTION 23

T 7 N R 6 E

TYPE MONUMENT PK NAILS

ON SURFACE - ~~BELOW~~ YES

~~LEFT~~ - E PAV'T. - RIGHT 4.0'

— TO — EDGE PAVEMENT

S.L.M. (A) = 218+22.78

