

O.D.O.T. DISTRICT 2 SURVEY OFFICE (USE ONLY)

PERSONNEL

REFERENCE NO. 7 E

SHEET 17 OF 17

NOTES BARNHESEL

DATE 3/5/02

ROUTE SR 108

H.C. CANTERBURY

WEATHER SUNNY

COUNTY FULTON

R.C. MOSER

TEMP. 32°

TOWNSHIP CLINTON

SECTION 24

DWG BY NIESE PID \_\_\_\_\_

T 7 N R 6 E

TYPE MONUMENT P.K. NAIL

ON SURFACE - ~~BELOW~~ ON

OFFSET Q PAVEMENT 4.0' ~~LT~~ : RT

- TO - EDGE PAVEMENT


STATION: 223+28.81

HORZ. DATUM: \_\_\_\_\_


GEOID: \_\_\_\_\_

GRID: NORTHING: \_\_\_\_\_

EASTING: \_\_\_\_\_

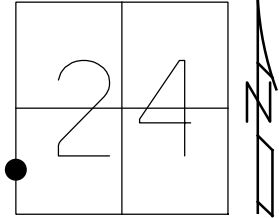

RECORD:  
FD P.K. NAIL  
3/5/02, KPM  
D.N.F.  
9/16/19, JFO

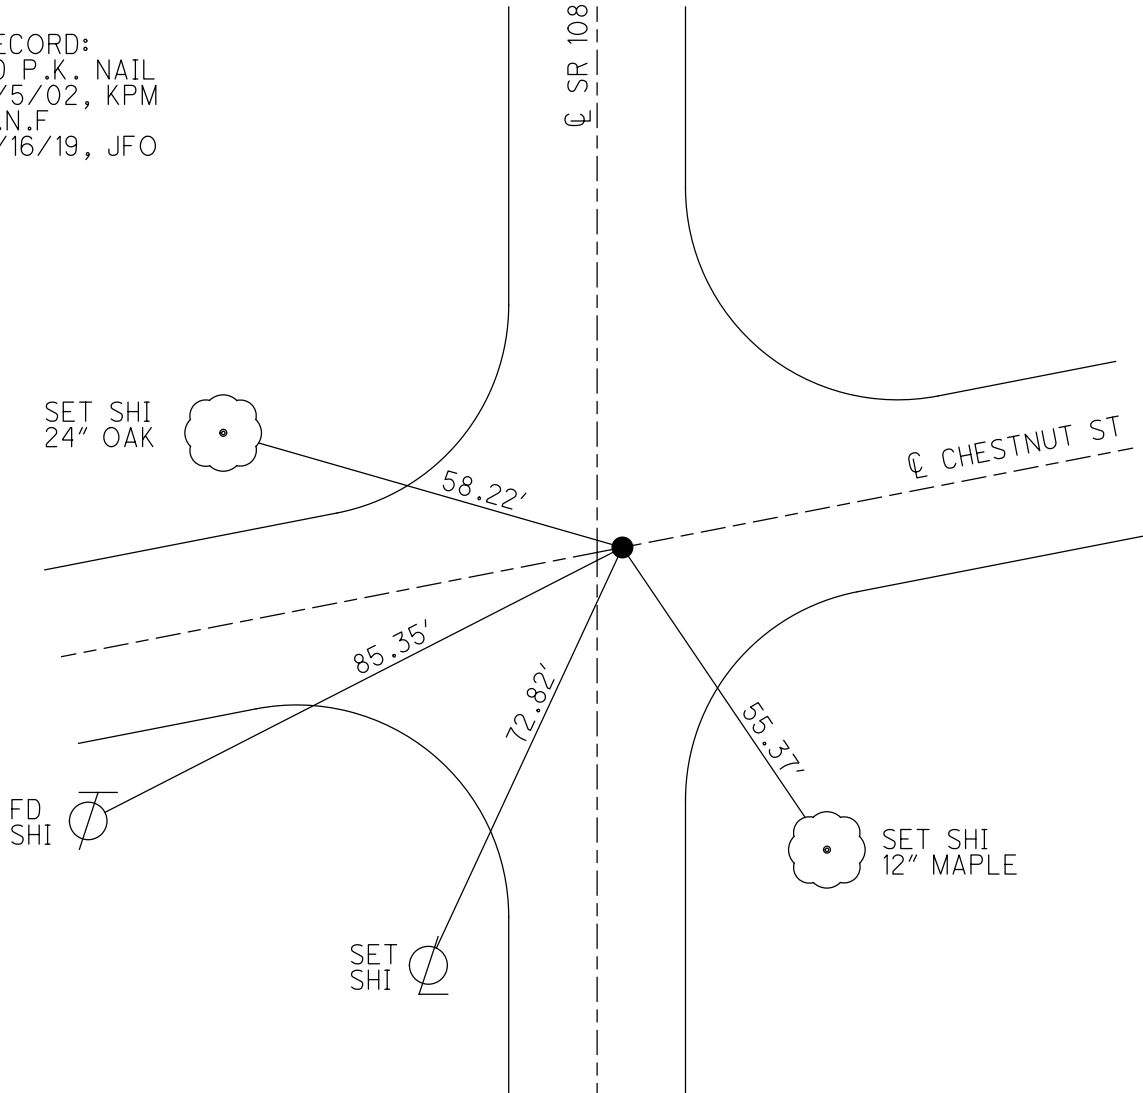

O.D.O.T. DISTRICT 2 SURVEY OFFICE (USE ONLY)

PERSONNEL

REFERENCE NO. 7 E

SHEET 17 OF 17

NOTES BARNHISEL DATE 3/5/02

H.C. CANTERBURY WEATHER SUNNY

R.C. MOSEER TEMP. 32°

ROUTE SR 108

COUNTY FULTON

TOWNSHIP CLINTON

SECTION 24

DWG BY NIESE PID \_\_\_\_\_

T 7 N R 6 E

TYPE MONUMENT P.K. NAIL

ON SURFACE - ~~BELOW~~ ON \_\_\_\_\_


OFFSET  $\odot$  PAVEMENT 4.0' ~~LT~~ : RT

- TO - EDGE PAVEMENT


STATION: 223+28.81

HORIZ. DATUM: \_\_\_\_\_ GEOID: \_\_\_\_\_

GRID: NORTHING: \_\_\_\_\_ EASTING: \_\_\_\_\_

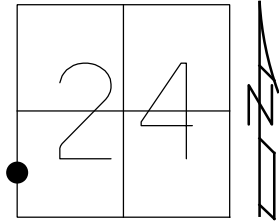

RECORD:  
FD P.K. NAIL  
3/5/02, KPM

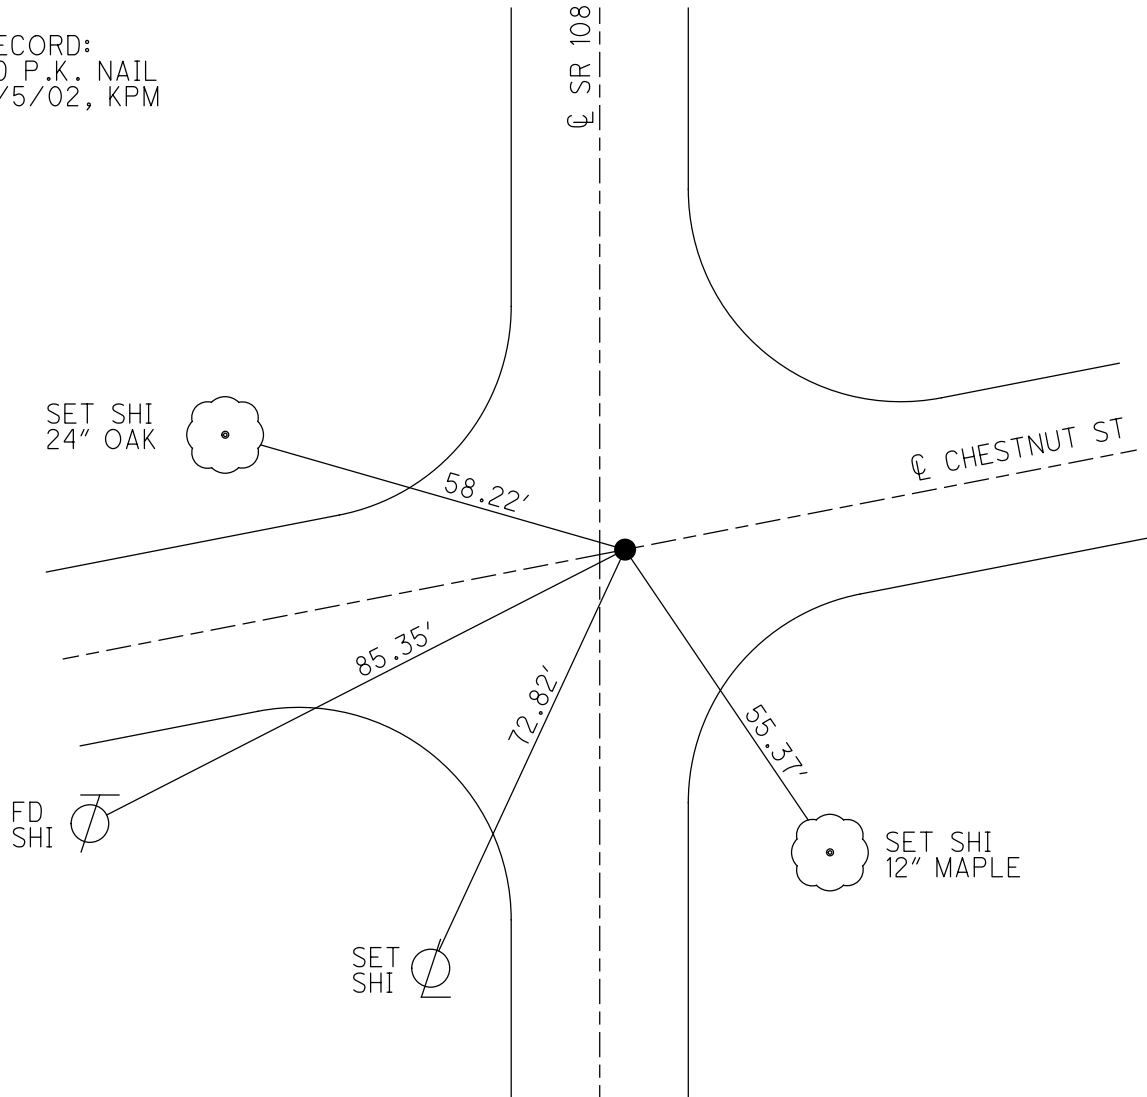

# O.D.O.T. DISTRICT 2 SURVEY OFFICE



PERSONNEL \_\_\_\_\_ REFERENCE NO. 7E SHEET \_\_\_\_\_ OF \_\_\_\_\_

NOTES BARNHISEL  
 H.C. CANTERBURY  
 R.C. MOSEK

DATE 3-5-02  
 WEATHER SUNNY  
 TEMP. +32°

ROUTE 108  
 COUNTY FULTON  
 TOWNSHIP CLINTON  
 SECTION 23  
 T 7 N 1 R 6 E

TYPE MONUMENT PK NAIL  
 ON SURFACE - ~~BELOW~~ YES  
~~LEFT - & PAV'T.~~ - RIGHT 4'  
TO - EDGE PAVEMENT ON E PAU'T E & W  
 S.L.M. 223+28.81

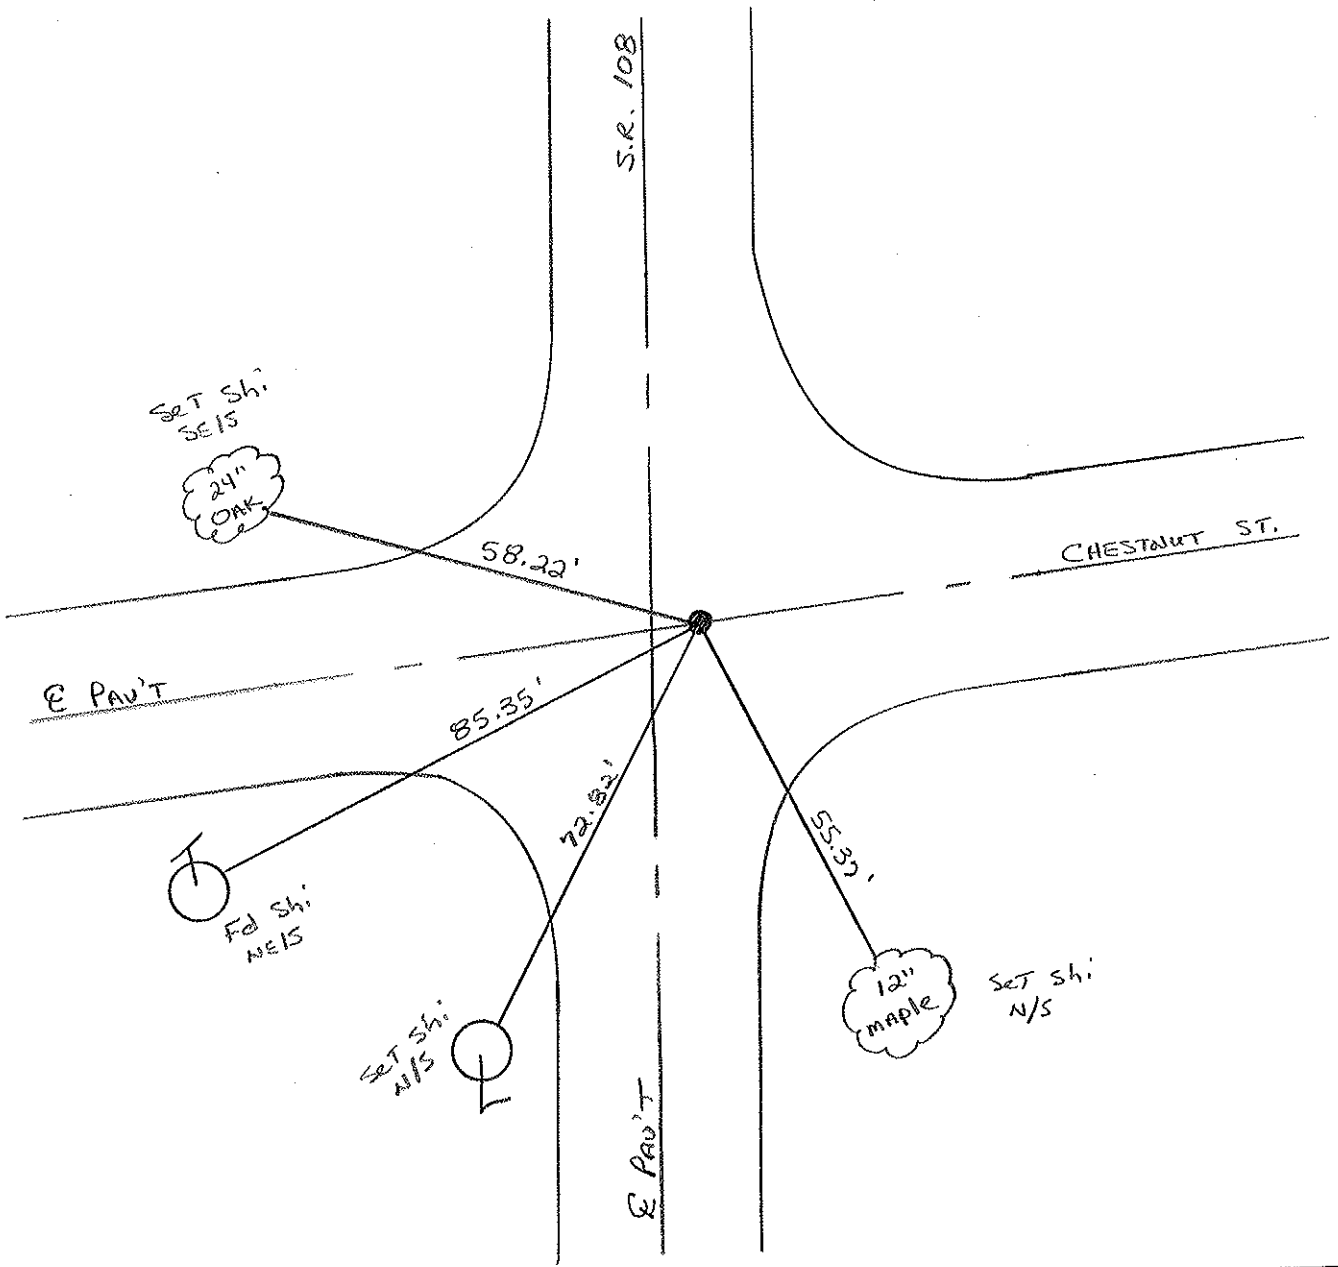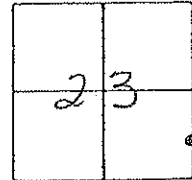

PERSONNEL	TITLE	PERSONNEL	TITLE	COUNTY	DATE
<u>Longenderfer</u>				<u>Fulton</u>	<u>Aug. 12, 1958</u>
<u>Braese</u>				S. R. <u>108 &amp; 2</u>	WEATHER <u>Partly cloudy</u>
<u>Enyart</u>				SEC. <u>Wauscan</u>	TEMP. <u>80+</u>
<u>Robinson</u>					
<u>Williams</u>					
DESCRIPTION	<u>Center Line Survey</u>				JOB NO. <u>02292</u>

